
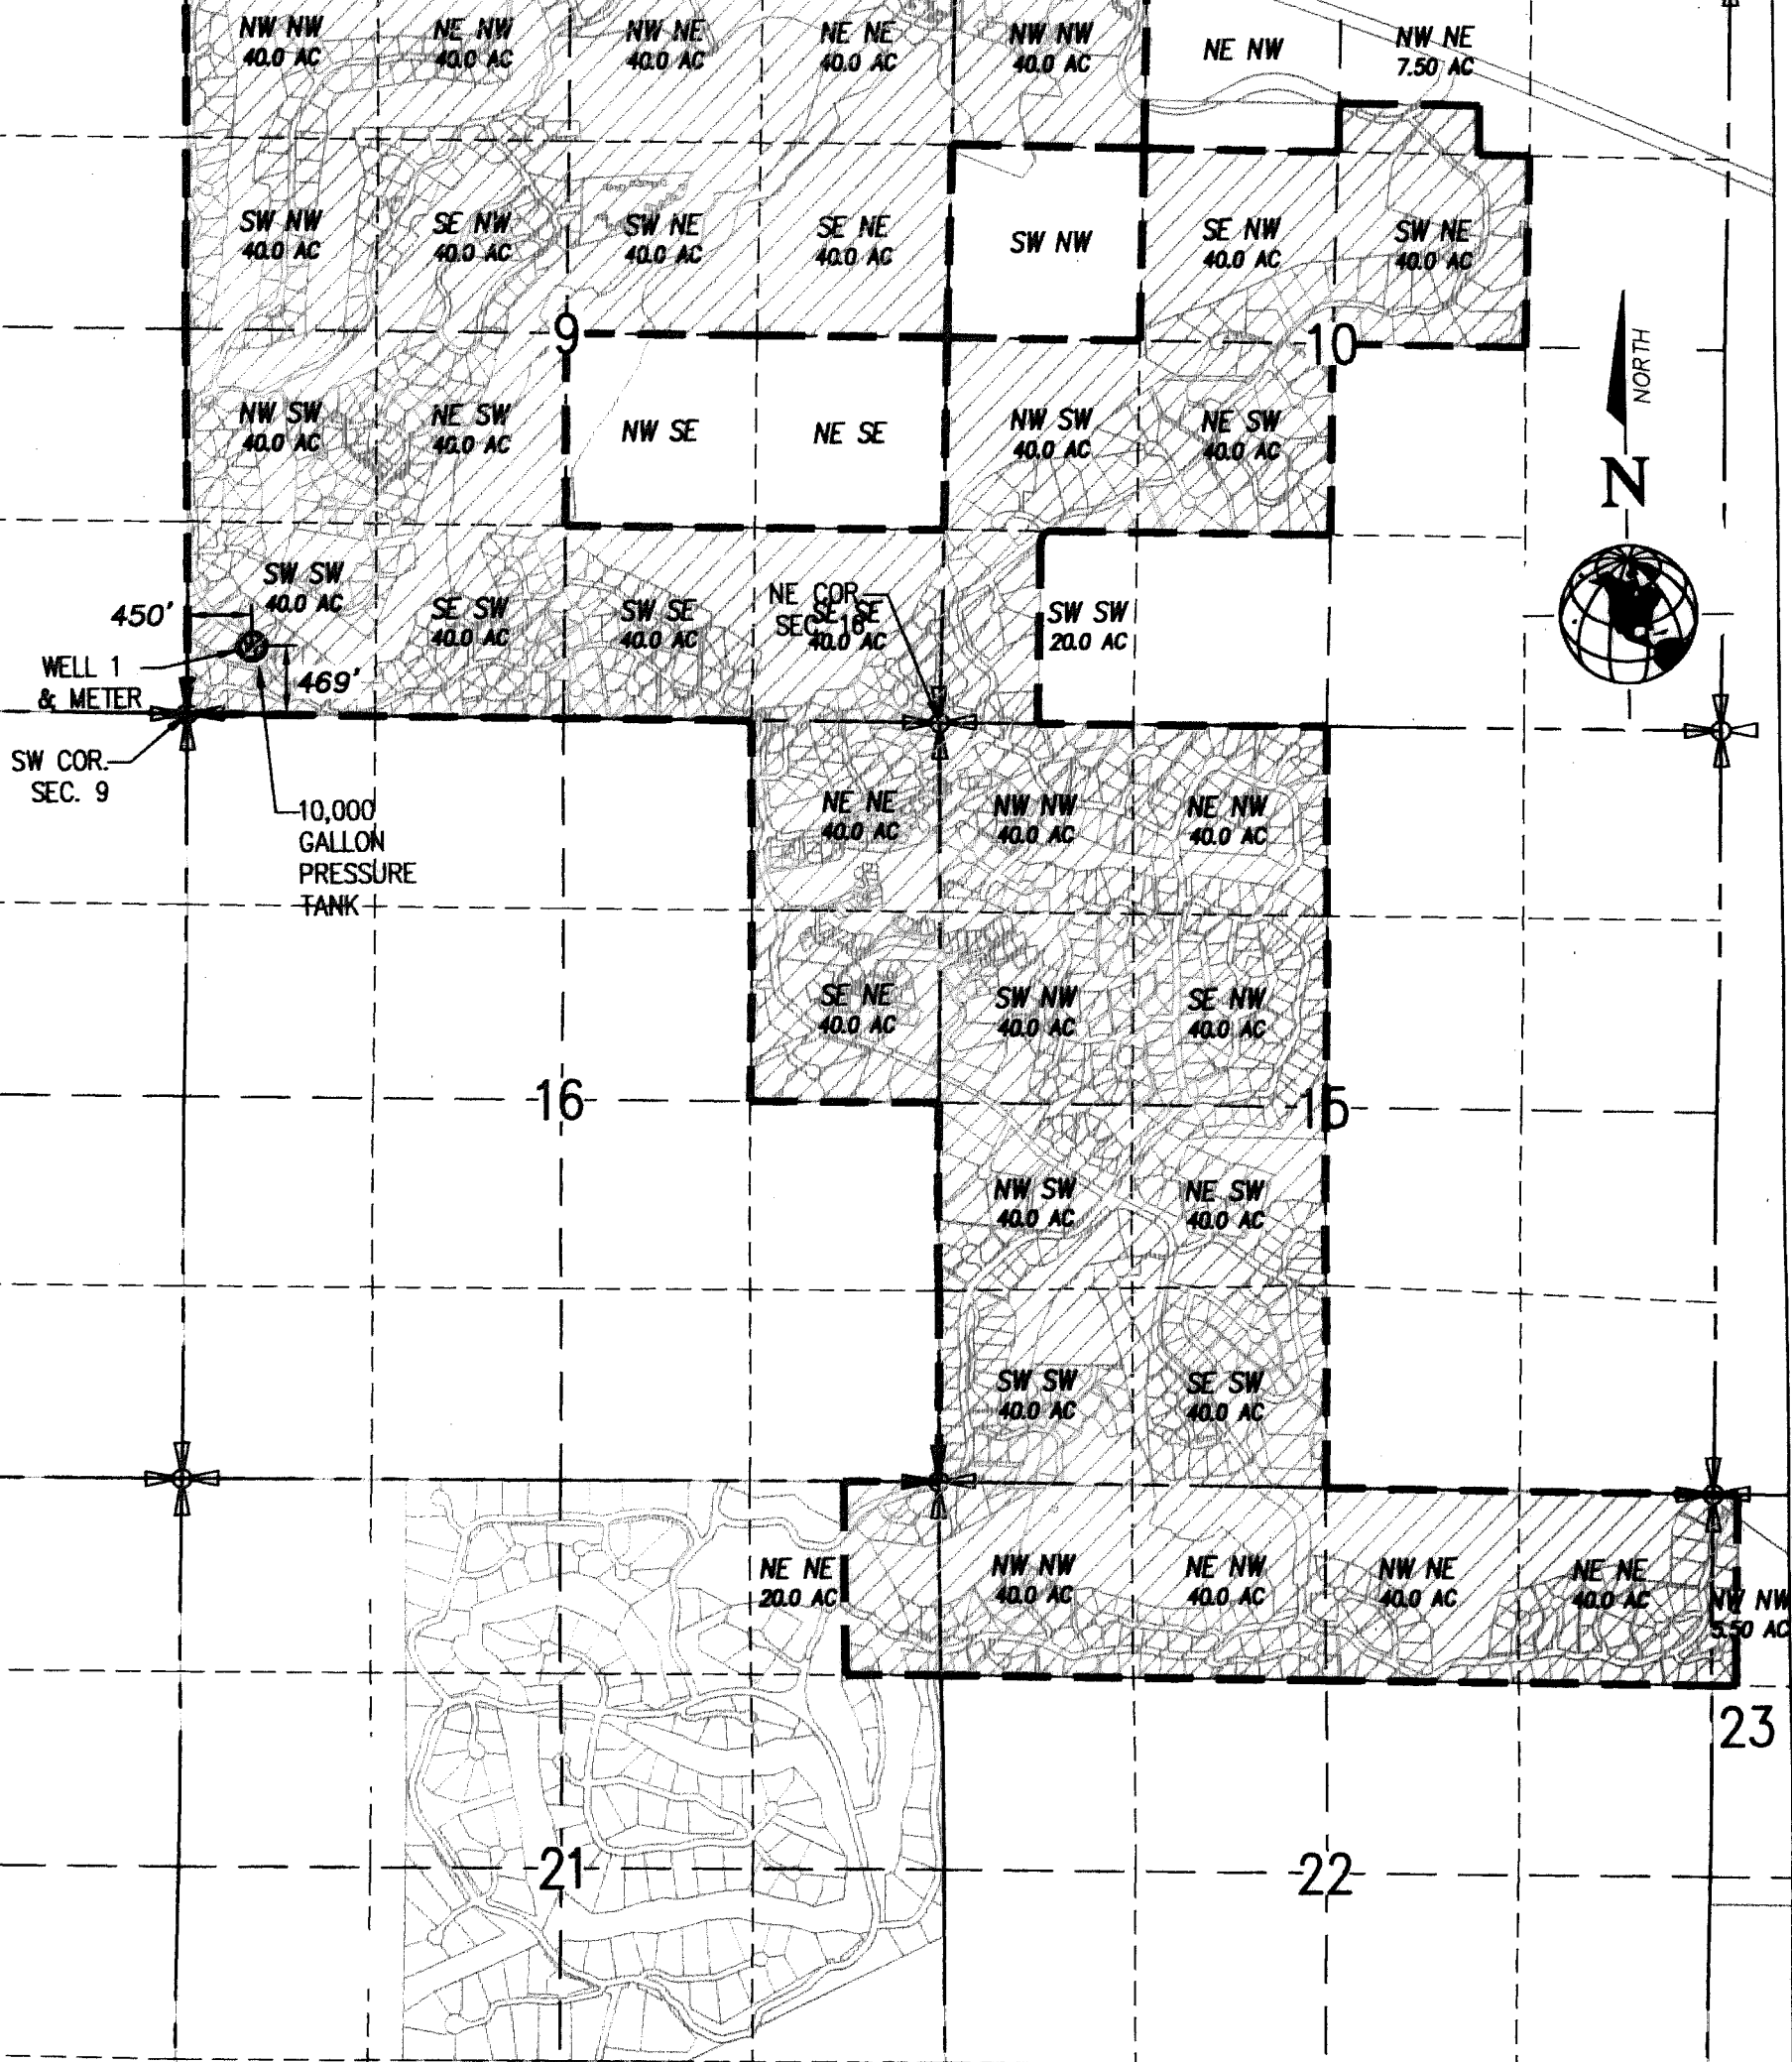


5

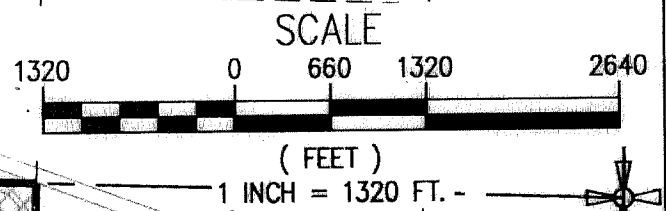


RECEIVED

NOV 16 2010

WATER RESOURCES DEPT
SALEM, OREGON

BLACK BUTTE RANCH ASSOCIATION
APPLICATION #G-7018
PERMIT #G-6797
T. 14S., R. 9E, W.M.

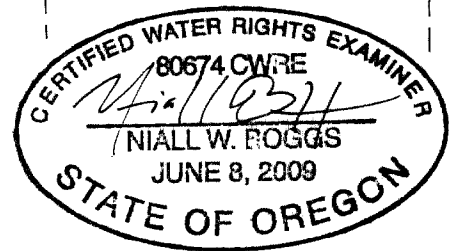

EXPIRES: 12-31-2011

THE PURPOSE OF THIS MAP IS TO IDENTIFY
THE LOCATION OF THE WATER RIGHTS.
THIS MAP IS NOT INTENDED TO PROVIDE
LEGAL DIMENSIONS OR LOCATIONS
OF PROPERTY OWNERSHIP LINES.

NOTES:

1. PERMIT G-6797 IS FOR DOMESTIC USE
2. FOR TAXLOT INFORMATION, SEE SUPPLEMENTAL TAX MAPS
3. FOR WATER LINE LAYOUT SEE SUPPLEMENTAL AS-BUILT MAP

SHEET NUMBER 1	CLAIM OF BENEFICIAL USE MAP APPLICATION G-7018, PERMIT G-6797 BLACK BUTTE RANCH PERMIT 6797 COBU		SHEET INFO		REVISIONS			
	PROJECT NUMBER 35602	DRAWING FILE NAME 35602-LAND-COBU MAP FOR PERMIT G-6797	DESIGNED NWB	DRAWN NWB	NO.	BY	DATE	REMARKS
		SCALE 1" = 1320'	CHECKED JEF	APPROVED JEF	1	NWB	11/10/10	REVISED PLACE OF USE
			LAST EDIT 11/8/2010	PLOT DATE 11/10/2010				
			SUBMITTAL					

WHPacific

123 SW Columbe Street
Bend, OR 97702
541-388-4255 Fax 541-388-4229
www.whpacific.com