


5

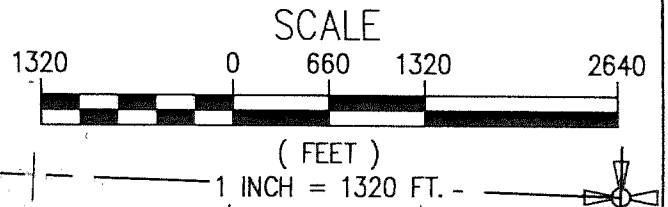

450'
WELL 1
& METER
SW COR.
SEC. 9
469'
10,000
GALLON
PRESSURE
TANK

NE COR.
SEC. 16

1530'

16

WELL 2
& METER
500,000
GALLON
RESERVOIR
& BOOSTER
PUMP
STATION

1236'

15

NE NW
33.9 AC

NE NE
20.0 AC

NW NE
40.0 AC

SE NW
33.9 AC

SW NE
40.0 AC

SE NE
40.0 AC

"FOURTH NINE"
DOMESTIC BOOSTER
PUMP STATION

23

NE SW
33.9 AC

NW SE
39.3 AC


NE SE
24.1 AC

22

RECEIVED

DEC 29 2009

WATER RESOURCES DEPT
SALEM, OREGON

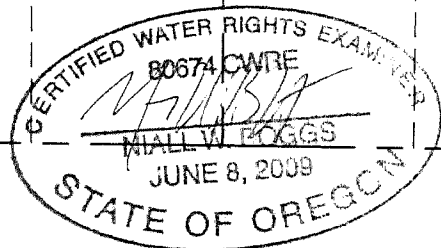

EXPIRES: 12/31/2009
RENEWS:

BLACK BUTTE RANCH ASSOCIATION
APPLICATION #G-9117
PERMIT #G-8501
T. 14S., R. 9E, W.M.

THE PURPOSE OF THIS MAP IS TO IDENTIFY
THE LOCATION OF THE WATER RIGHTS.
THIS MAP IS NOT INTENDED TO PROVIDE
LEGAL DIMENSIONS OR LOCATIONS
OF PROPERTY OWNERSHIP LINES.

NOTES:

1. PERMIT G-8501 IS FOR DOMESTIC USE
2. FOR TAXLOT INFORMATION, SEE SUPPLEMENTAL TAX MAPS
3. FOR WATER LINE LAYOUT SEE SUPPLEMENTAL AS-BUILT MAP

SHEET NUMBER 1 of 1	CLAIM OF BENEFICIAL USE MAP APPLICATION G-9117, PERMIT G-8501 BLACK BUTTE RANCH PERMIT 8501 COBU		SHEET INFO		REVISIONS			
	PROJECT NUMBER 35602	DRAWING FILE NAME 35602-LAND-COBU MAP FOR PERMIT G-8501	SCALE 1" = 1320'	DESIGNED BY: DRAWN NWB CHECKED JEF APPROVED JEF LAST EDIT 7/22/2009 PLOT DATE 10/27/2009 SUBMITTAL	NO.	BY	DATE	REMARKS

WHPacific

123 SW Columbia Street
Bend, OR 97702
541-388-4255 Fax 541-388-4229
www.whpacific.com