

RECEIVED

MAY 25 2005

WATER RESOURCES DEPT
SALEM, OREGON

CLAIM OF BENEFICIAL USE MAP

FOR T-9247

LOCATED WITHIN THE SE1/4 OF SECTION 21
AND WITHIN THE N1/2 OF SECTION 28
TOWNSHIP 27 SOUTH, RANGE 18 EAST, W.M.,
LAKE COUNTY, OREGON


FOR
RONALD AND JENNIFER SCHMIDT

WELL LOCATIONS

- LOCATED IN THE SW1/4SE1/4, SECTION 21
AND LOCATED 1317 FEET NORTH AND
1288 FEET EAST FROM THE 1/4 CORNER
COMMON TO SECTIONS 21 AND 28,
TOWNSHIP 27 SOUTH, RANGE 18 EAST, W.M.,
LAKE COUNTY, OREGON.


- LOCATED IN THE NW1/4NE1/4, SECTION 28
AND LOCATED 1314 FEET SOUTH AND
14 FEET EAST FROM THE 1/4 CORNER
COMMON TO SECTIONS 21 AND 28,
TOWNSHIP 27 SOUTH, RANGE 18 EAST, W.M.,
LAKE COUNTY, OREGON.

SCALE 1"=1320'

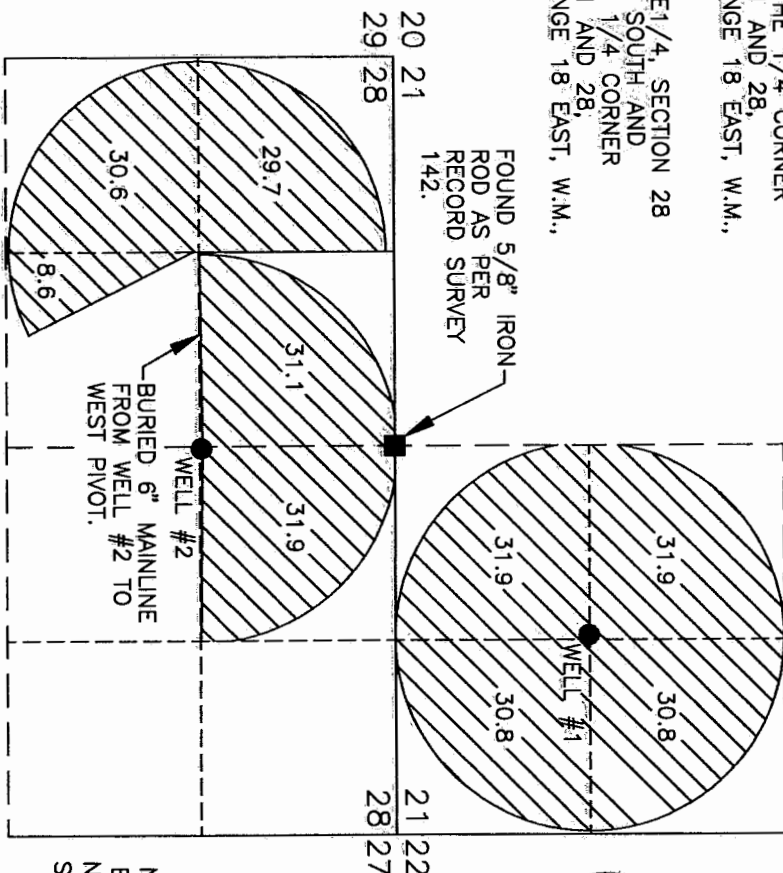

FOUND 5/8" IRON
ROD AS PER
RECORD SURVEY
142.

BURIED 6" MAINLINE
FROM WELL #2 TO
WEST PIVOT.

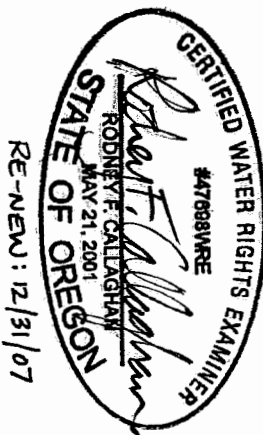

RE-NEW: 12/31/07

LEGEND

■ LAND SURVEY MONUMENT
FOUND AS NOTED.

● EXISTING WELL

257.3 ACRES BEING IRRIGATED
AS SHOWN AS PER T-9247.

TAX LOTS

SECTION 21
N1/2SE1/4- TAX LOT 27-18-6000
S1/2SE1/4- TAX LOT 27-18-6100

SECTION 28
N1/2NE1/4- TAX LOT 27-18-6700
E1/2NW1/4- TAX LOT 27-18-6800
NW1/4NW1/4- TAX LOT 27-18-6900
SW1/4NW1/4- TAX LOT 27-18-7000

THIS MAP IS FOR THE PURPOSE OF LOCATING
A WATER RIGHT ONLY AND HAS NO INTENT TO
PROVIDE LEGAL DIMENSIONS OR THE LOCATION
OF BOUNDARY LINES.

PREPARED BY:

CLS

CALLAGHAN LAND SURVEYING
427 SOUTH H STREET
LAKEVIEW, OR 97630
(541) 947-5841

DATE: 3/8/2005

DRAWING: 200515

RECEIVED

JAN 09 2006

RONALD AND JENNIFER SCHMIDT
P.O. BOX 925
CHRISTMAS VALLEY, OR 97601

WATER RESOURCES DEPT
SALEM, OREGON