


FOR:
JOHN MERWIN
J-SPEAR RANCH
22952 CLOVER FLAT ROAD
PAISLEY, OREGON 97636

SCALE: HORIZONTAL-1"=100' CONTOUR INTERVALS-2'

AS-BUILT AREA CAPACITY CURVE



Certified Water Right Examiner
 # 005
 Darryl J. Anderson
 Nov 19, 1987
 STATE OF OREGON
 RENEWAL 12/31/2001

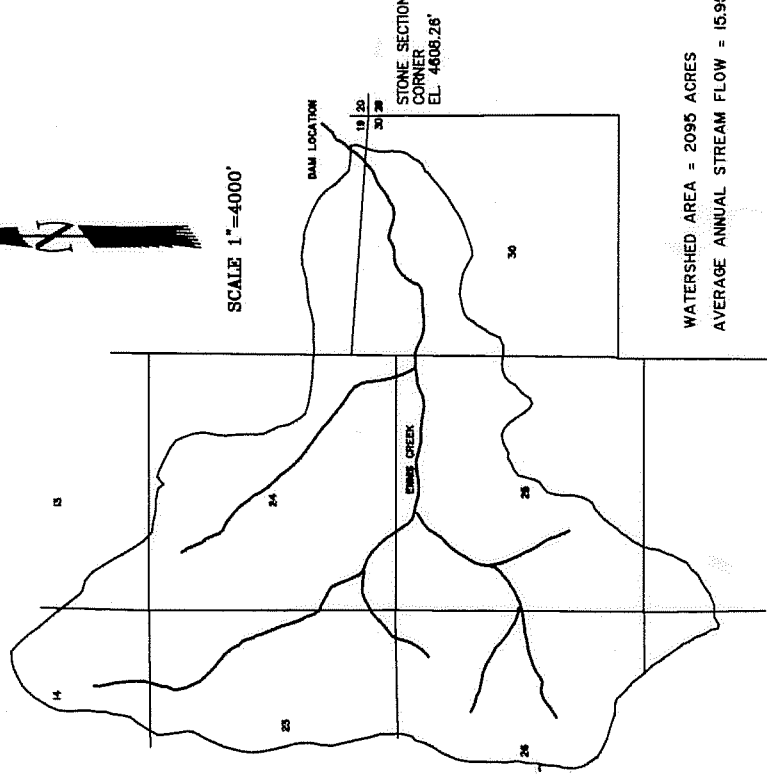

RECEIVED

NOTE: PREPARATION OF THIS MAP IS FOR IDENTIFYING PROPOSED WATER RIGHTS ONLY. IT HAS NO INTENT TO PROVIDE LOCATIONS OR DIMENSIONS OF PROPERTY BOUNDARIES

**WATER RESOURCES DEPT.
SALEM, OREGON**

WATERSHED AREA