


CLAIM OF BENEFICIAL USE MAP UNDER PERMIT S-52312


T. 40 S., R. 9 W., W. M., JOSEPHINE COUNTY

Section 25, S1/2 NE1/4

May 31, 2008

N
↑
1"=400'

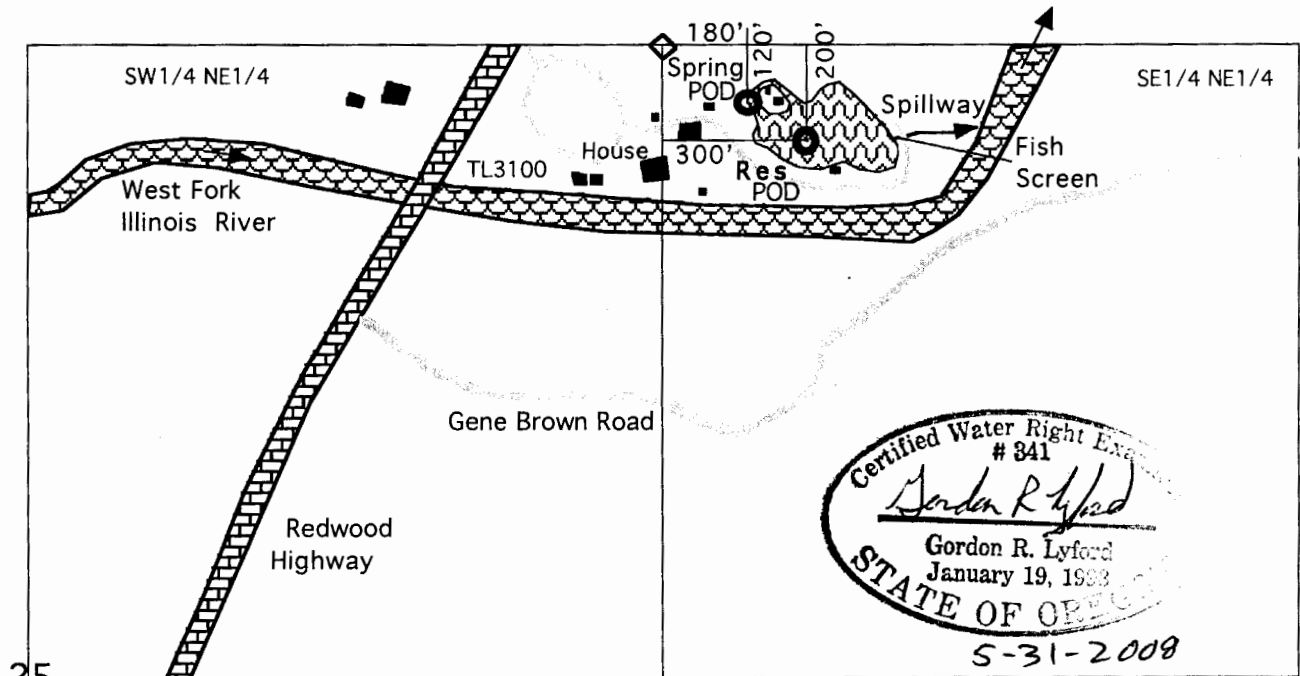

 Fish culture use from an unnamed spring and in an unnamed reservoir under Application S-70667 and Permit S-52312 with a priority of September 17, 1990. The unnamed reservoir was constructed under Application R-70668 and Permit R-11840.

 PODs for an unnamed spring and an unnamed reservoir.

 Dirt roads

 Buildings

RECEIVED

JUN 06 2008

**WATER RESOURCES DEPT
SALEM, OREGON**

This map was drawn by Gordon R. Lyford for Shalwa L. Nicolaw to support her Claim of Beneficial Use of water for fish culture from an unnamed spring and in an unnamed reservoir. Shalwa L. Nicolaw owns tax lot 3100.

This map was prepared for the purpose of identifying the location of water rights only and is not intended to provide legal dimensions or the location of property ownership lines.