


APPROXIMATE LOCATION
SW CORNER SECTION 30

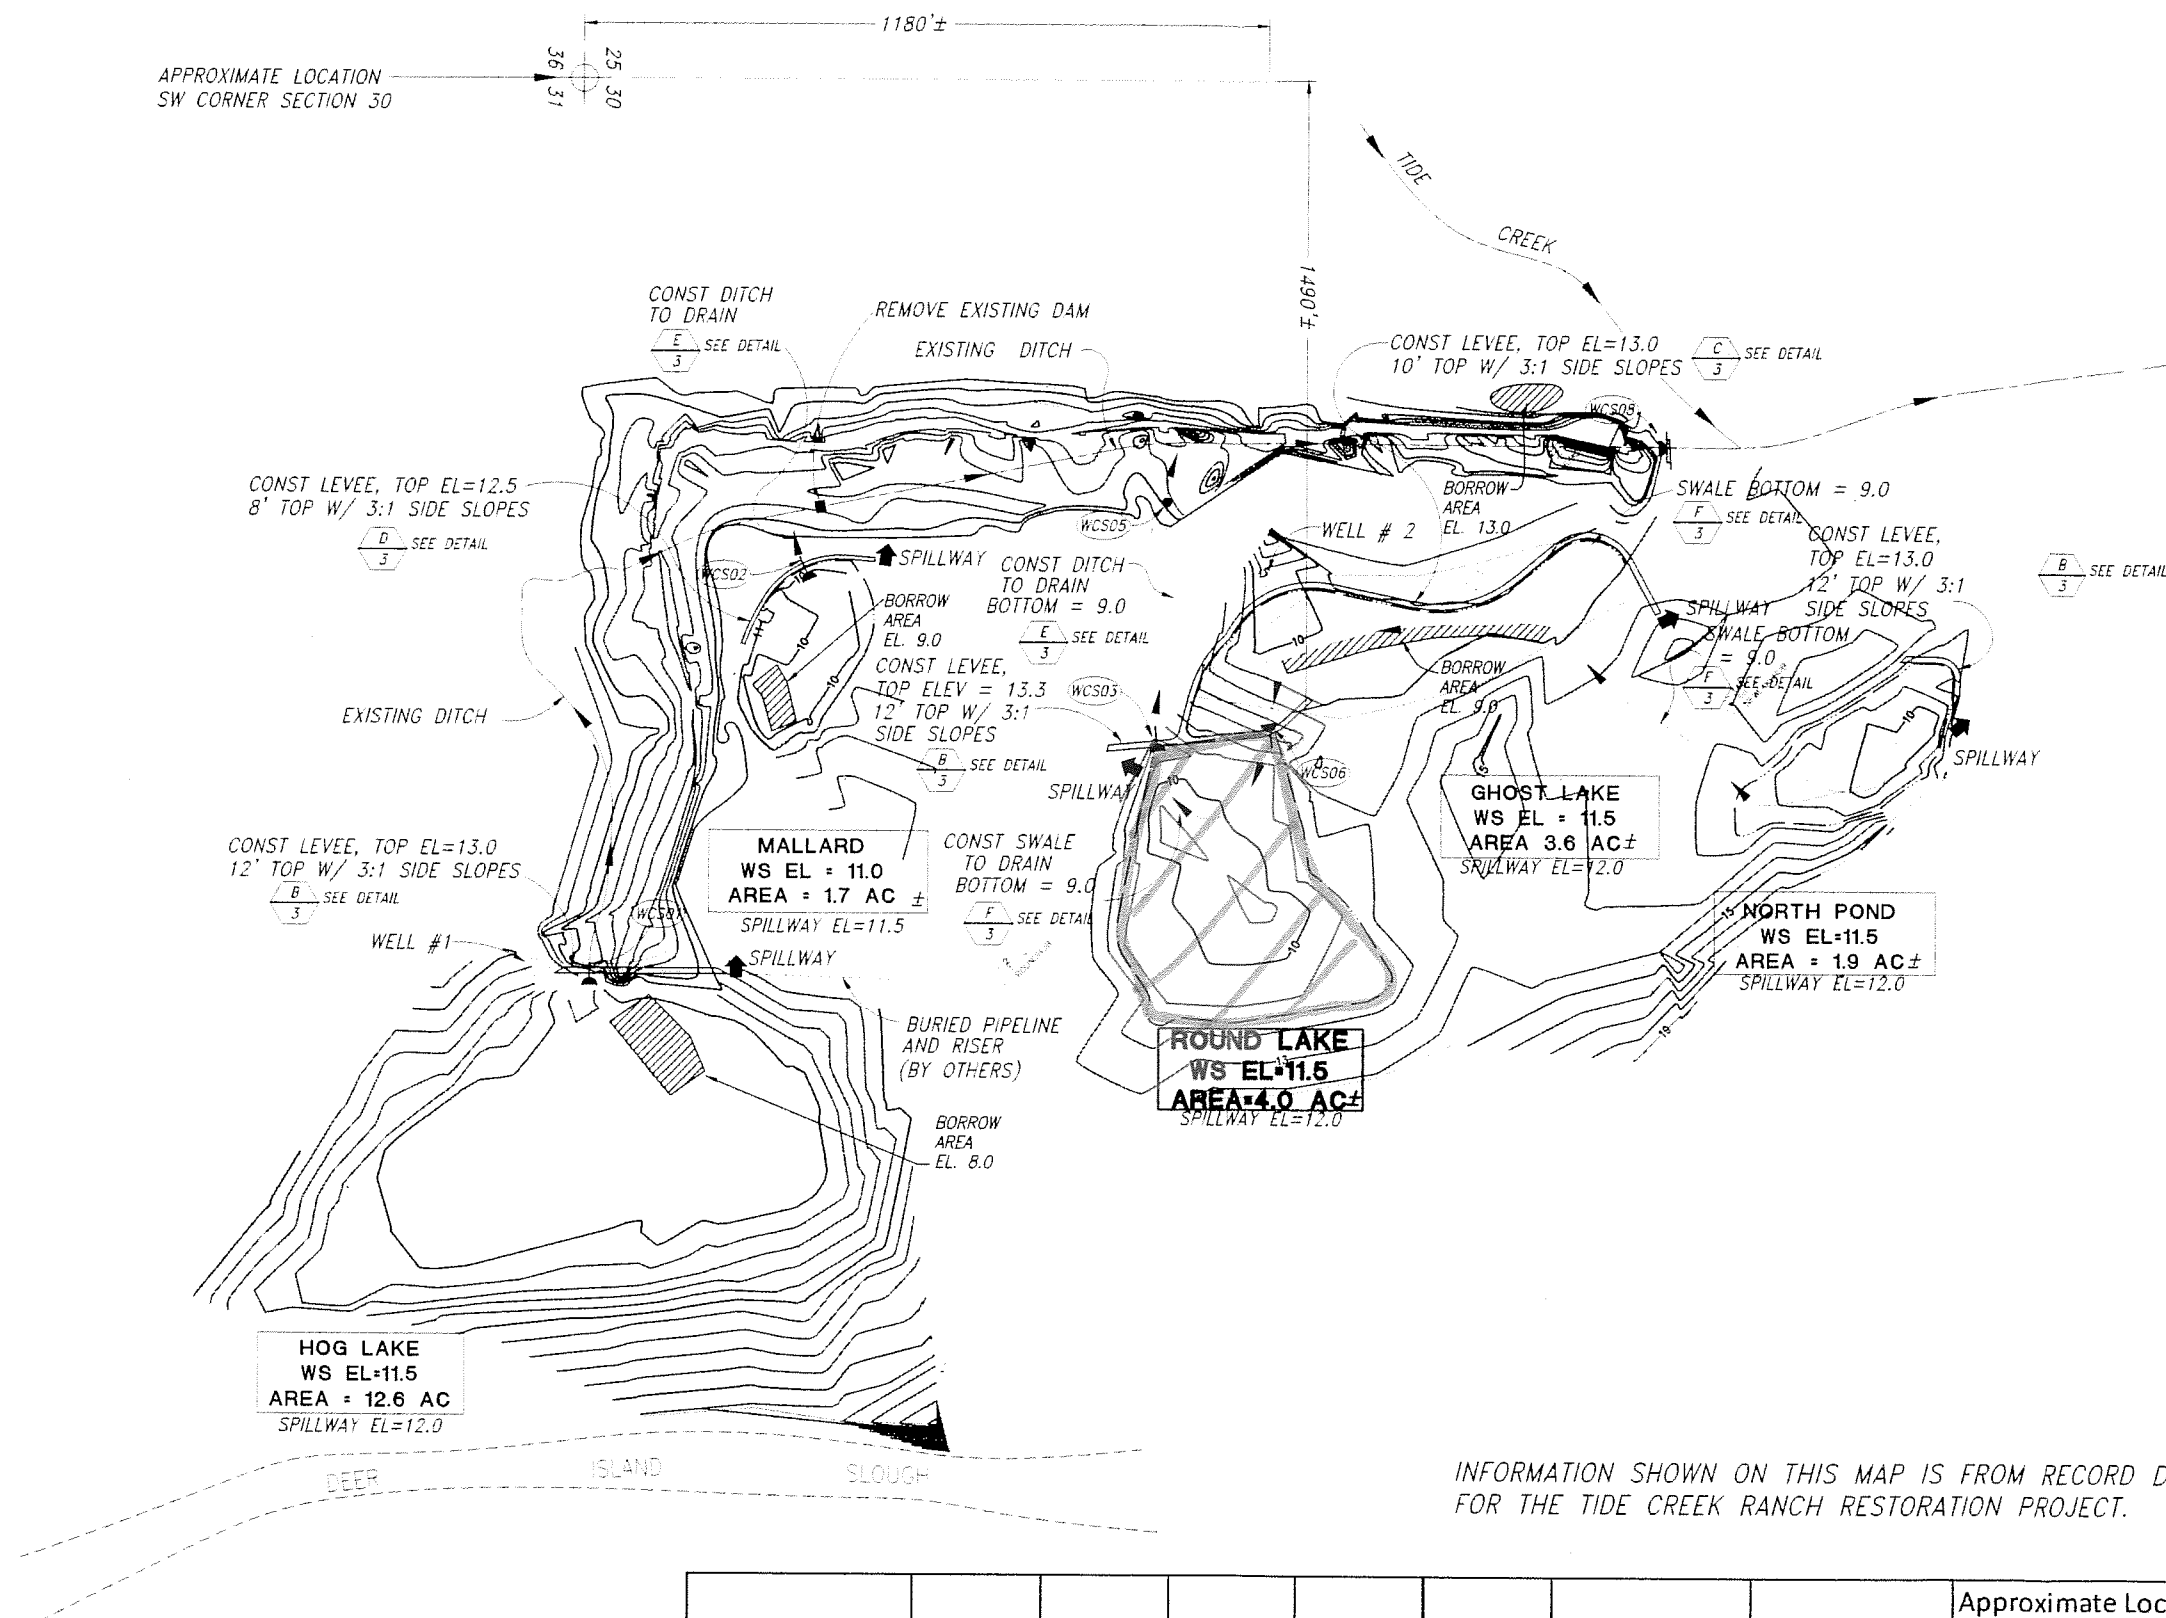

INFORMATION SHOWN ON THIS MAP IS FROM RECORD DRAWINGS
FOR THE TIDE CREEK RANCH RESTORATION PROJECT.

RECEIVED BY OWRD

DEC 23 2015

SALEM, OR

Storage Facility	Tax Lot	Township	Range	Meridian	Section	Quarter-Quarter	Area (Acres)	Approximate Location (Distances referenced from SW corner Section 30)	Maximum Water Surface Elev. (Feet, NAVD 88)	Maximum Storage Volume (AC-)
Round Reservoir	300	6N	17	W.M.	30	NW 1/4 SW 1/4	4.0	1180 feet north; 1490 feet east	11.5	6.4

TIDE CREEK Ranch 091615

Datum and Control:

Horizontal: Oregon State Plane North Zone NAD_83(2011)(EPOCH:2010.0000)

Vertical: NAVD 88 (Computed using GEOID12B)

Units: International Feet


Horizontal/Vertical Control by two 5+ hour GPS Static observations
submitted to NGS OPUS (Computed using GEOID12B)

Map amended by OWRD to identify
the correct range

ac 7-25-16

Unauthorized Changes & Uses

The engineer preparing these plans will not be responsible for, or liable for, unauthorized changes to or uses of these plans. All changes must be in writing and must be approved by the preparer of these plans.

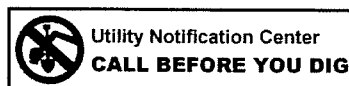

RECORD DRAWING

PROJECT NO. US-OR-41-1 DATE 12/1/2015 DESIGNED BY SWL

TIDE CREEK RANCH

ROUND RESERVOIR



DRAWN BY DMC

SURVEYED BY

CHECKED BY

SHEET NO.