


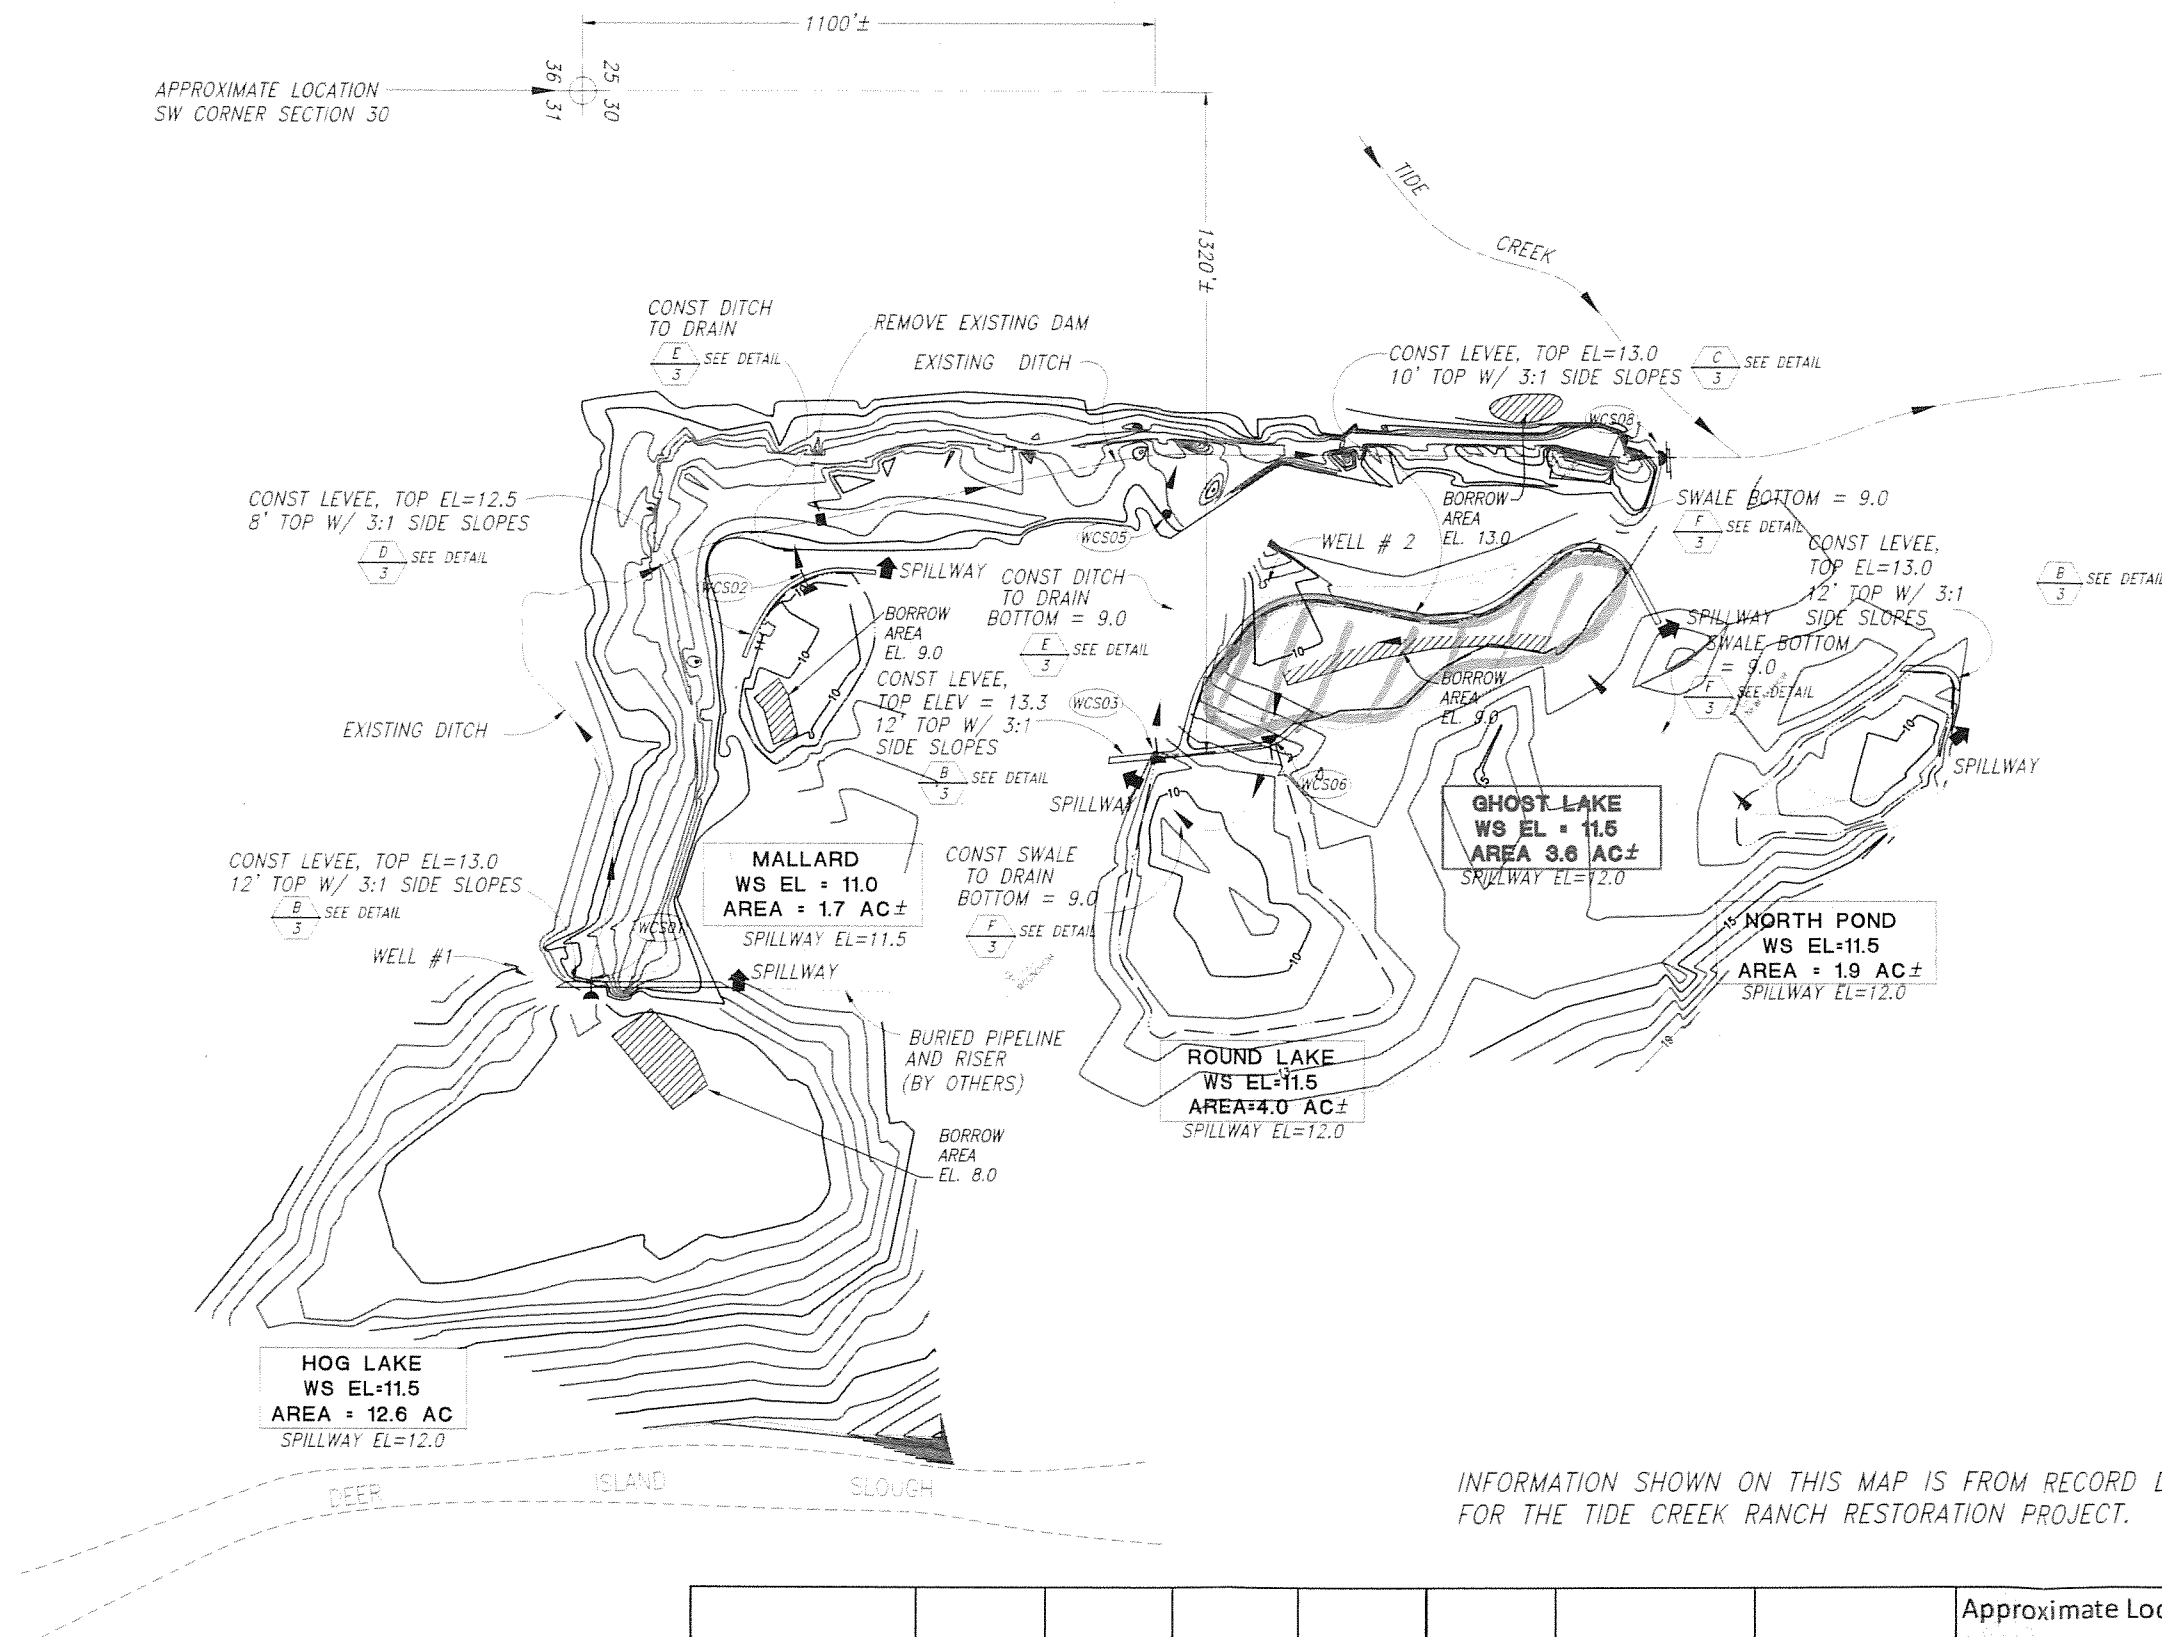

APPROXIMATE LOCATION
SW CORNER SECTION 30



RECEIVED BY OWRD

DEC 23 2015

SALEM, OR

INFORMATION SHOWN ON THIS MAP IS FROM RECORD DRAWINGS
FOR THE TIDE CREEK RANCH RESTORATION PROJECT.

Storage Facility	Tax Lot	Township	Range	Meridian	Section	Quarter-Quarter	Area (Acres)	Approximate Location (Distances referenced from SW corner Section 30)	Maximum Water Surface Elev. (Feet, NAVD 88)	Maximum Storage Volume (AC-
Ghost Reservoir	300	6N	12	W.M.	30	NW 1/4 SW 1/4	3.6	1100 feet north; 1320 feet east	11.5	7.2

TIDE CREEK Ranch 091615

Datum and Control:

Horizontal: Oregon State Plane North Zone NAD_83(2011)(EPOCH:2010.0000)

Vertical: NAVD 88 (Computed using GEOID12B)

Units: International Feet


Horizontal/Vertical Control by two 5+ hour GPS Static observations
submitted to NGS OPUS (Computed using GEOID12B)

Map amended by OWRD to identify
the correct range.

CC 7-25-16

Unauthorized Changes & Uses

The engineer preparing these plans will not be responsible for, or liable for, unauthorized changes to or uses of these plans. All changes must be in writing and must be approved by the preparer of these plans.

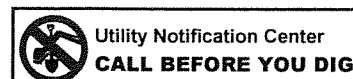

RECORD DRAWING

PROJECT NO. US-OR-41-1	DATE 12/1/2015	DESIGNED BY SWL
TIDE CREEK RANCH	DRAWN BY DMC	
GHOST RESERVOIR	SURVEYED BY	
	CHECKED BY	
	SHEET NO.	1 of 1

