


FINAL PROOF MAP R-12020  
SE1/4SW1/4 SECTION 28, T.34S., R.6W., W.M.  
JOSEPHINE COUNTY, OREGON  
FOR  
CALVIN D. AND PAMELA M. MORRIS  
6155 TUNNEL LOOP ROAD  
GRANTS PASS, OREGON 97526



Scale: 1"=400'  
Date: October 3, 2005  
August 9, 2006

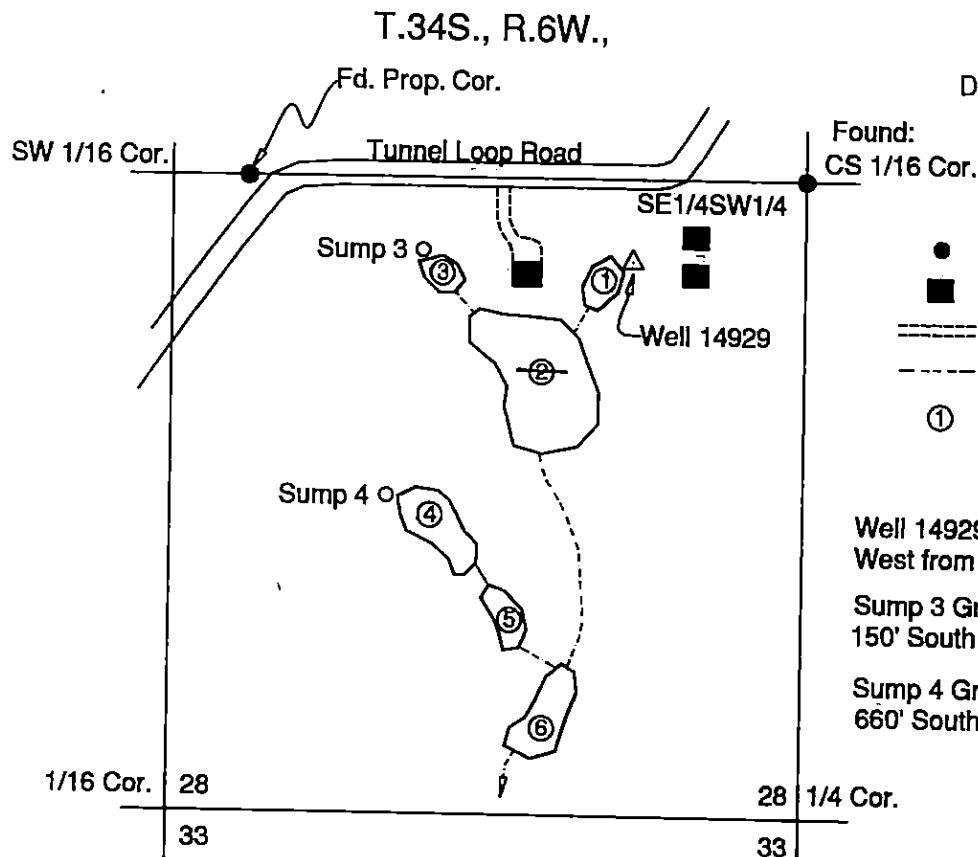

**LEGEND**

- Found Survey Monument
- Denotes Building
- ==== Denotes Driveway
- - - - Denotes Drainage
- ① Denotes Reservoir Number Refer to Permit R-12020

Well 14929 is situated 170' South & 360' West from CS 1/16 Cor. (NE Prop Cor.)


Sump 3 Ground Water Source is located: 150' South & 800' West from CS 1/16 Cor.

Sump 4 Ground Water Source is located: 660' South & 870' West from CS 1/16 Cor.

**R-12020  
AREA SUBMERGED/CAPACITY**

- |                                                                                                                                                                                                                                                                   |                                                                                                                                                                                                                                             |
|-------------------------------------------------------------------------------------------------------------------------------------------------------------------------------------------------------------------------------------------------------------------|---------------------------------------------------------------------------------------------------------------------------------------------------------------------------------------------------------------------------------------------|
| <p>① Reservoir 1<br/>Area = 0.30 acres<br/>Volume = 0.90 acre ft.</p> <p>② Reservoir 2<br/><del>Area = 0.63 acres</del><br/><del>Volume = 5.67 acre ft.</del></p> <p>③ Reservoir 3<br/>(Ground Water Source)<br/>Area = 0.03 acres<br/>Volume = 0.08 acre ft.</p> | <p>④ Reservoir 4<br/>(Ground Water Source)<br/>Area = 0.33 acres<br/>Volume = 2.00 acre ft.</p> <p>⑤ Reservoir 5<br/>Area = 0.05 acres<br/>Volume = 0.23 acre ft.</p> <p>⑥ Reservoir 6<br/>Area = 0.21 acres<br/>Volume = 1.47 acre ft.</p> |
|-------------------------------------------------------------------------------------------------------------------------------------------------------------------------------------------------------------------------------------------------------------------|---------------------------------------------------------------------------------------------------------------------------------------------------------------------------------------------------------------------------------------------|

This map was prepared for the purpose of identifying the location of a water right only and is not intended to provide legal dimensions or location of property ownership.

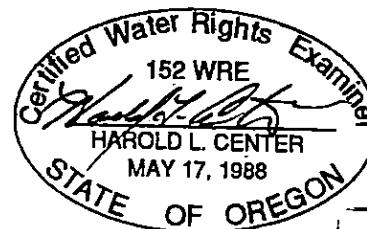

HAROLD L. CENTER  
2604 David Lane  
Medford, OR. 97504  
Phone 541-535-6108  
Oregon Certificate No. 152  
Certificate Renewal Date: 12/31/2007

**RECEIVED**

**DEC 13 2006**

WATER RESOURCES DEPT  
SALEM, OREGON