
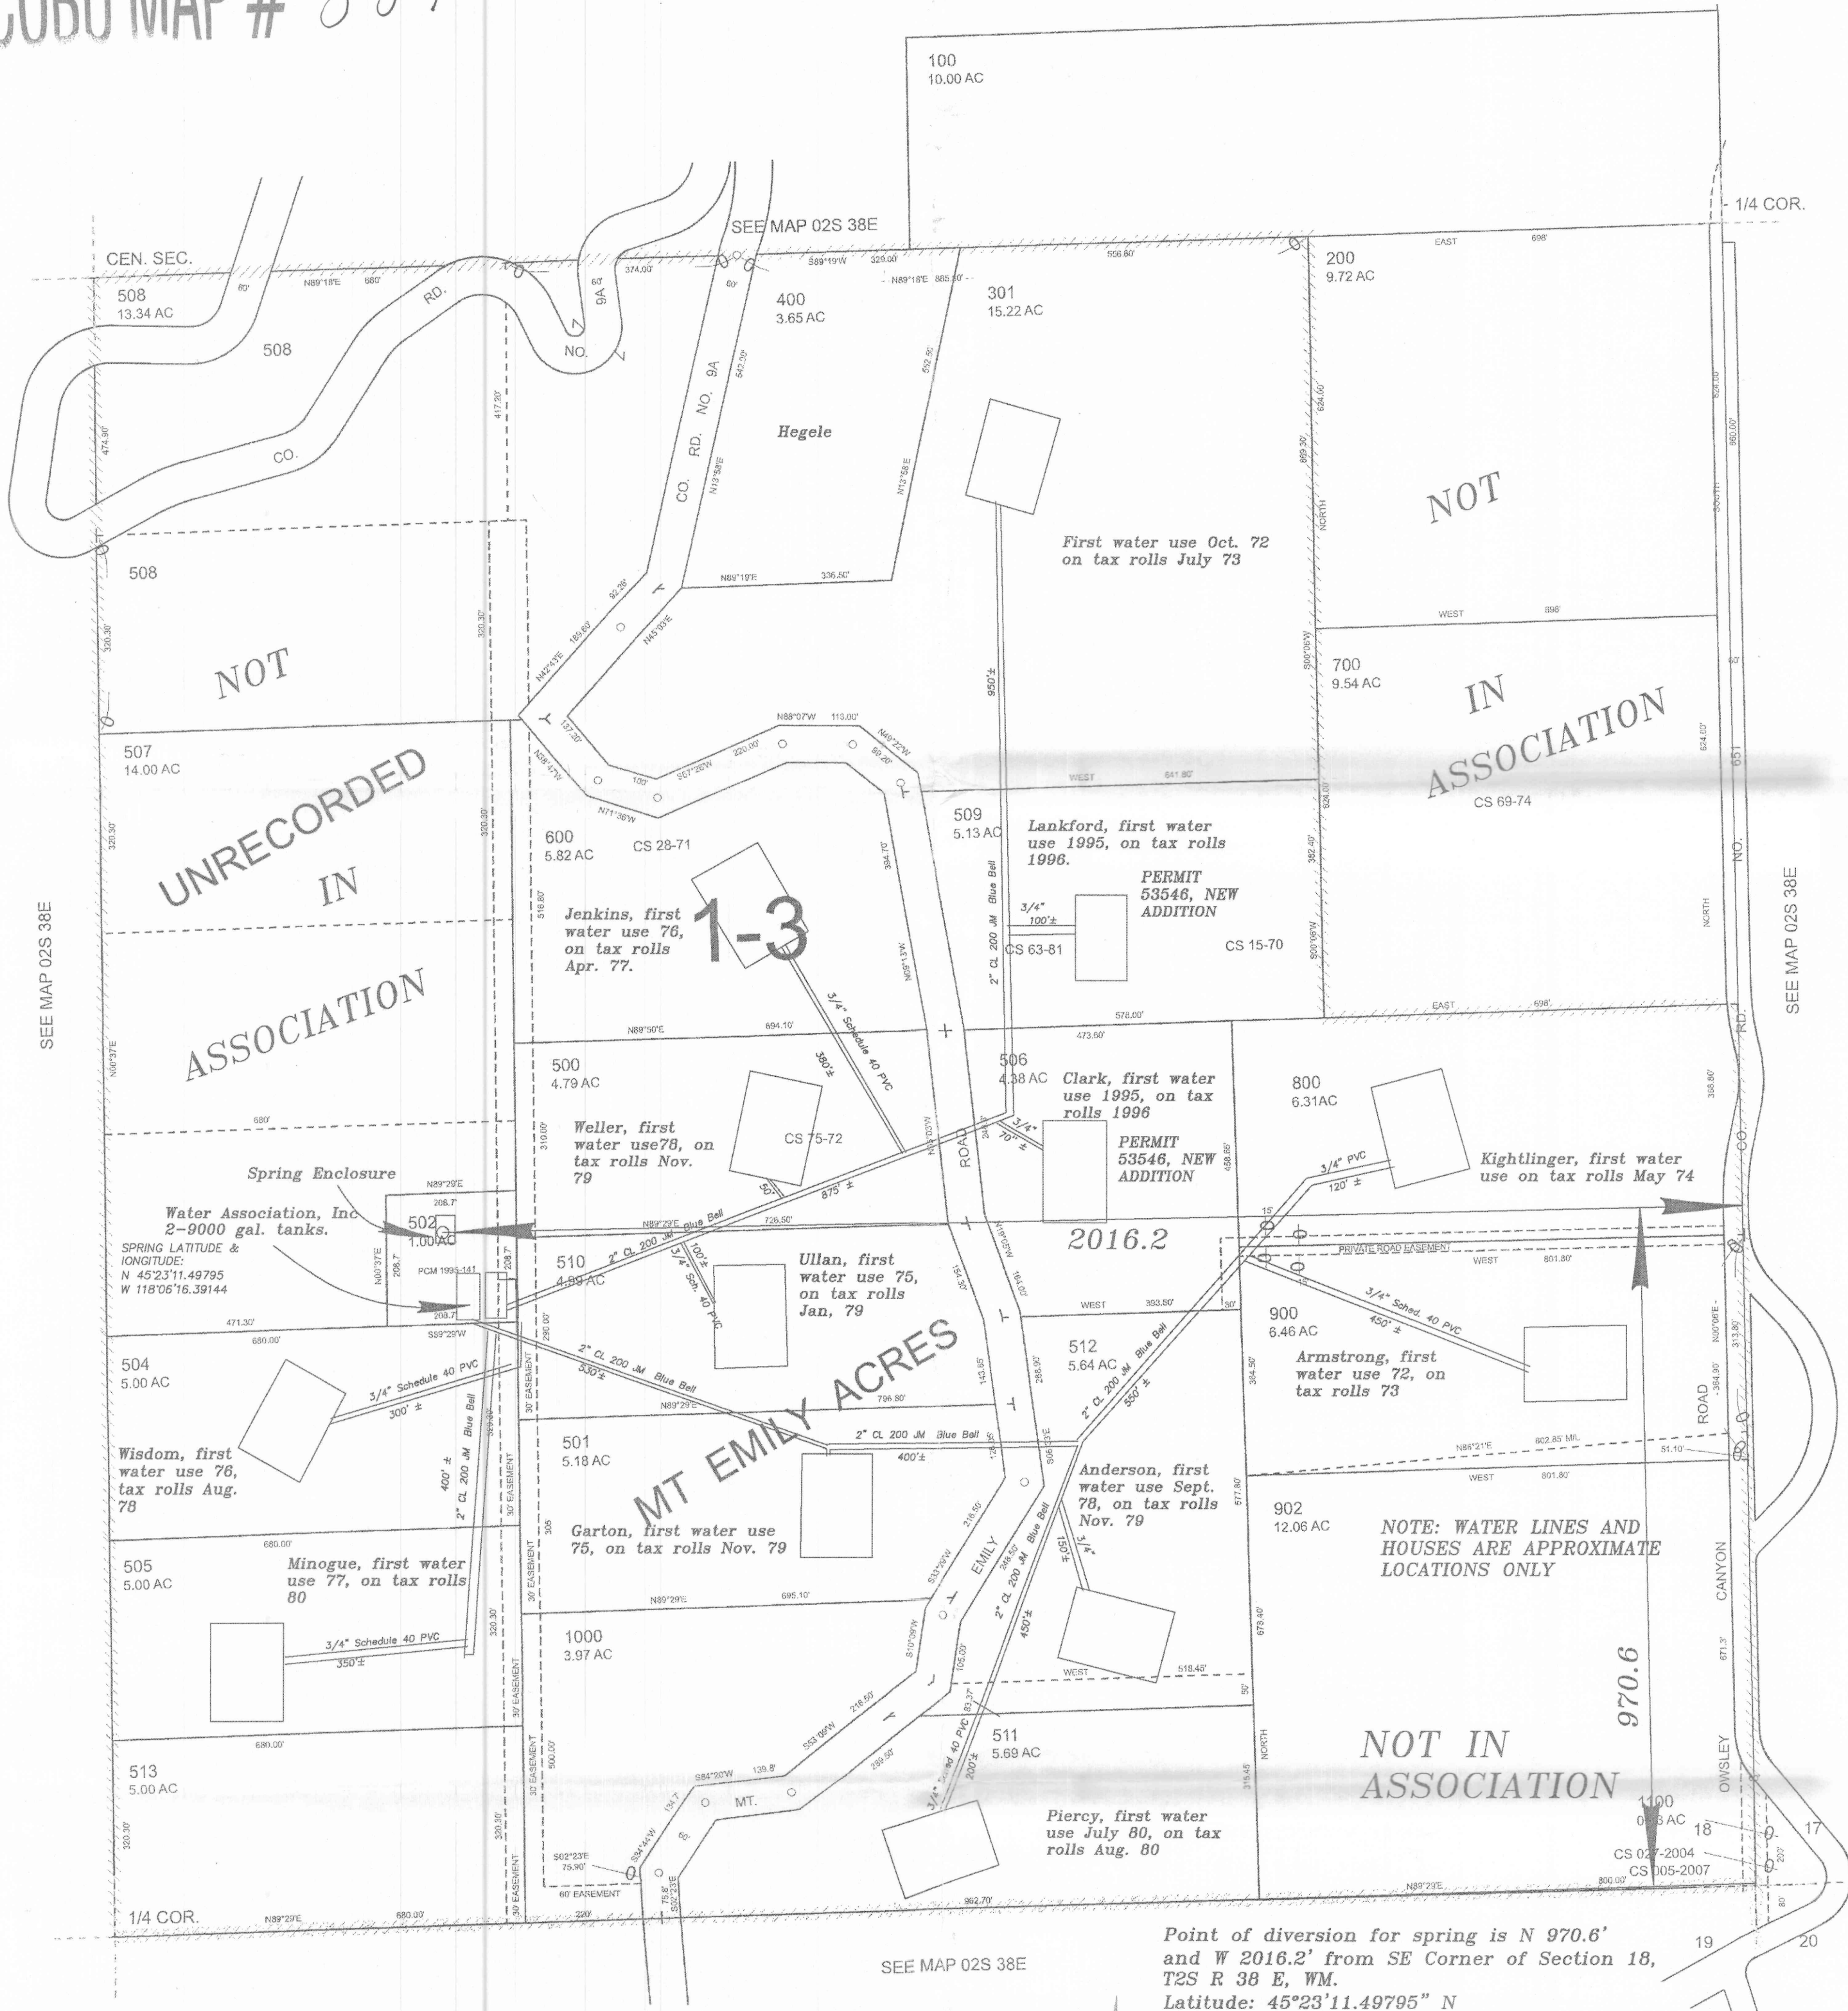


COBU MAP # 887

02S38E18D

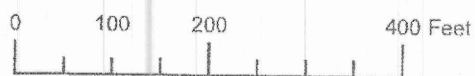

Point of diversion for spring is N 970.6' and W 2016.2' from SE Corner of Section 18, T2S R 38 E, WM.
Latitude: 45°23'11.49795" N
Longitude: 118°06'16.39144" W

RECEIVED BY OWRD

FEB 09 2015

SALEM, OR

JANUARY 12, 2015
CLAIM OF BENEFICIAL USE FOR
PERMIT 53546 FOR DOMESTIC USE FOR TWO
HOUSEHOLDS INCLUDING IRRIGATION OF LAWNS OR
NONCOMMERCIAL GARDEN NOT TO EXCEED 1/4 ACRES
FOR
MT. EMILY WATER ASSOCIATION, INC

BY
GREG BLACKMAN WATER RIGHTS
126 RIDGE DRIVE
LA GRANDE, OREGON 97850


APPLICATION NO. S-83816

PERMIT NUMBER 53546

NOTE: The lengths of the various water lines are scaled. The line sizes and type were taken from the original maps of the Mt. Emily Water Association furnished by Wade S. Hegele, President of the Association. The lengths of the pipe are approximate and were for the purpose of computations of flow. It seems that there are no surveyed lines so the distances are approximate. No as-built drawings are available. I also used a drawing furnished by Shad Hatten, Union County Water Master. This map is the best available evidence as to where and what the lines consist of.

This map is intended to show approximately where the houses and lines are located. No surveys were done to accurately locate the improvements. The map show the current owners as shown on the current tax records at the time this drawing was prepared. There are a total of 13 houses on this system with the completion of this application.

There are two houses included under Permit S-53546. The New houses are on Tax Lots 509, and 506 Map 2S 38 18D. The owners are Lankford and Clark respectively.

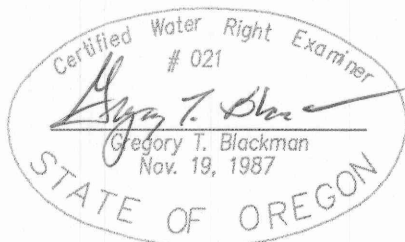

NOTE: The preparation of this map was for the purpose of identifying the location of the proposed water right and has no intent to provide dimensions or location of property ownership lines. Location information shown hereon was furnished by the applicant.

SCALE: 1"=200'