


Q:\BUREAU_OF_RECLAMATION\195-46 CC44 COBU 2018\SURVEY DATA\CIVIL3D\BOR CC44 COBU 120517.dwg, 2/14/2018 10:26:20 AM, \gprint64\

COBU MAP # 1128




NW COR SEC. 28
RECORD MONUMENT POSITION
CO. SURVEY 003-2001





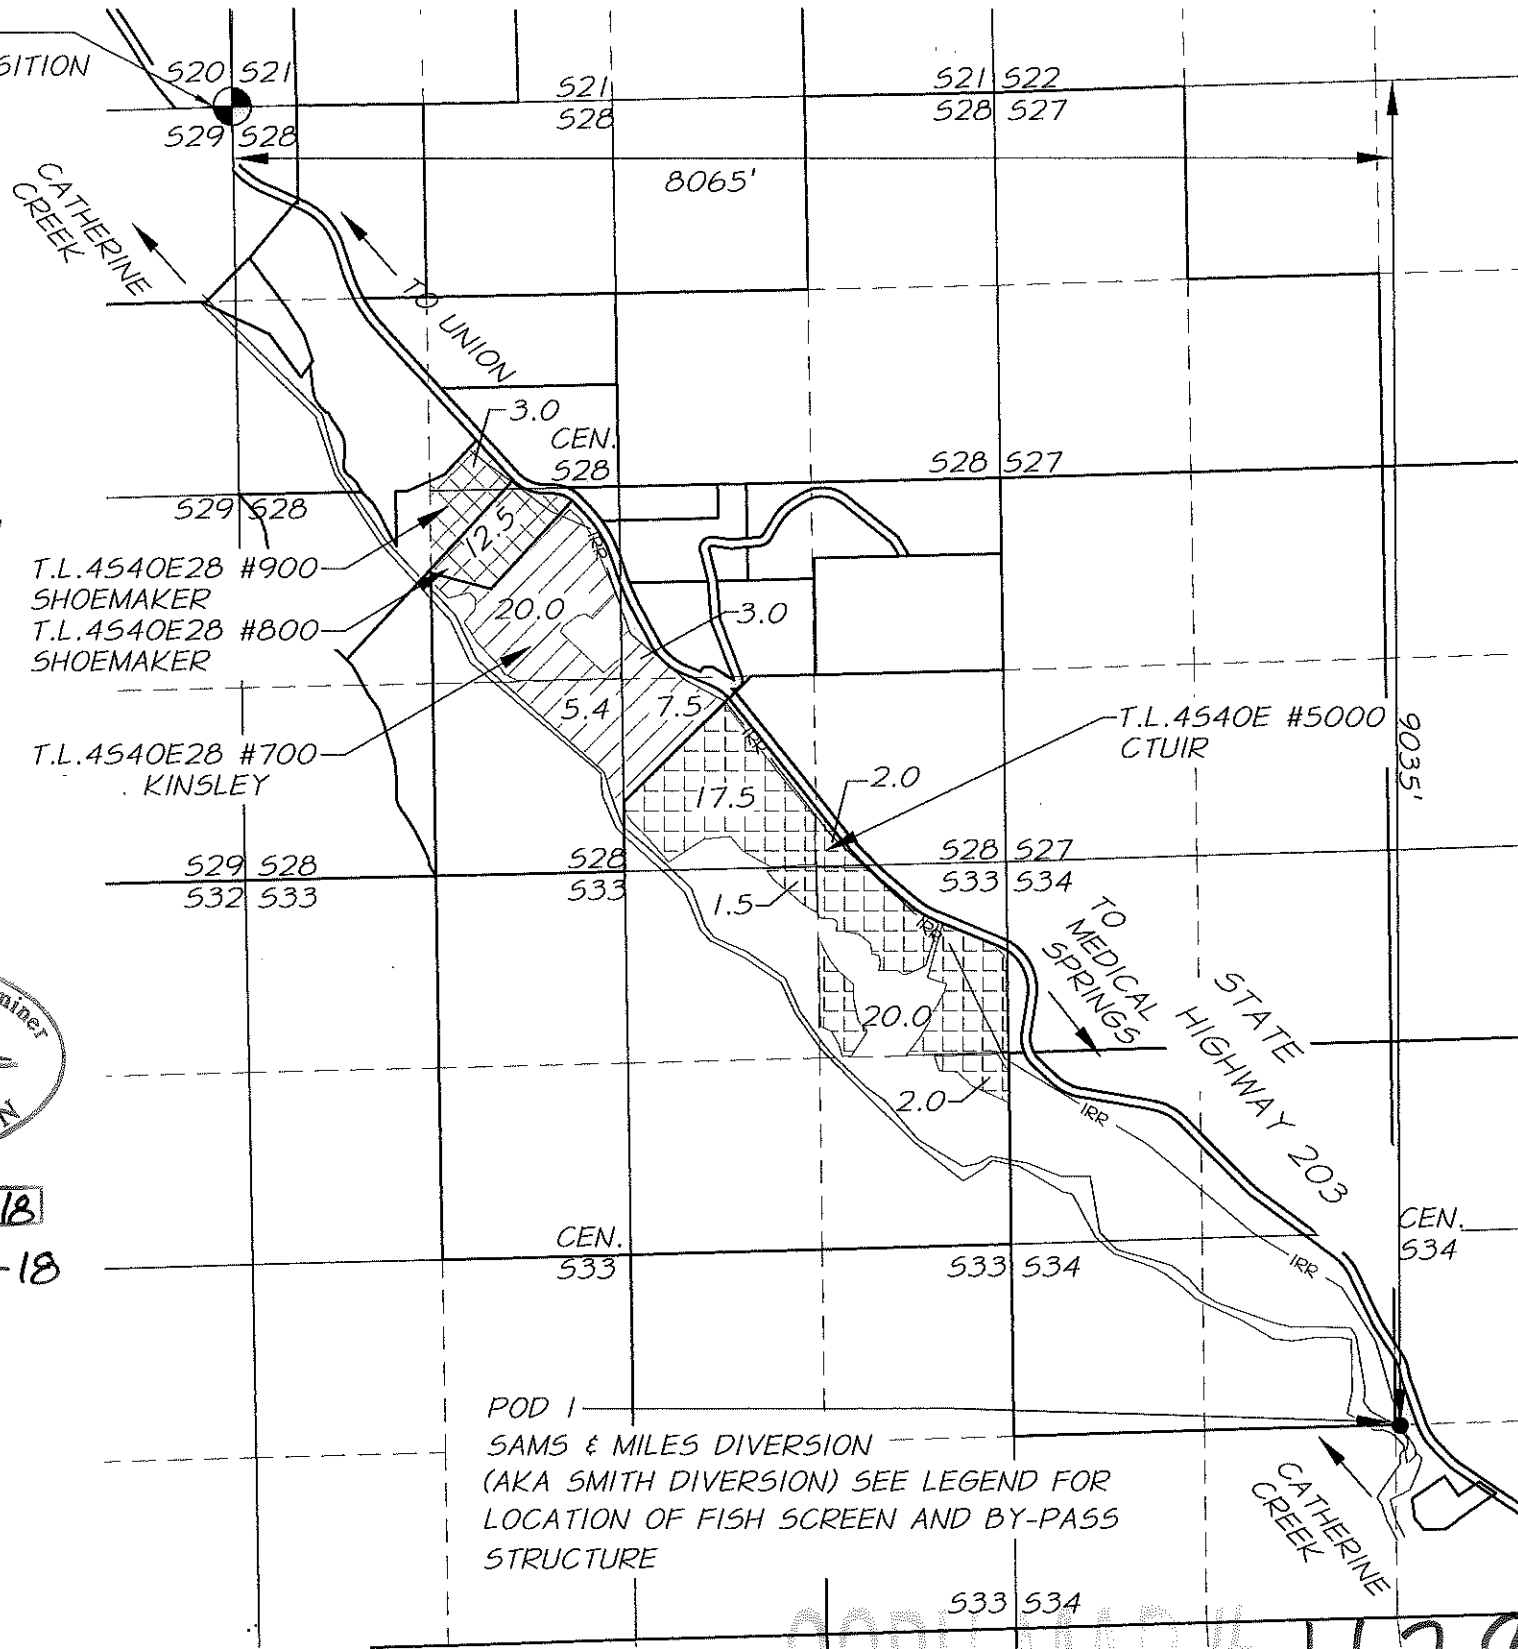

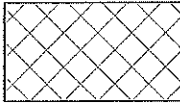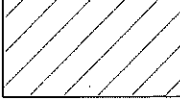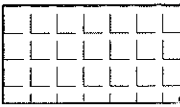

SCALE: 1" = 1320'
T. 4 S., R. 40 E., W.M.
UNION COUNTY, OREGON




LEGEND

-  CERT. #6602 - SHOEMAKER
SEC. 28
SE NW 3.0 AC.
NE SW 12.5 AC. - TOTAL 15.5 ACRES
-  CERT. #6587 - KINSLEY
SEC. 28
NE SW 20.0 AC.
SE SW 5.4 AC.
NW SE 3.0 AC.
SW SE 7.5 AC. - TOTAL 35.9 AC.
-  CERT. #6271 - CONFEDERATED TRIBES OF THE
UMATILLA INDIAN RESERVATION (CTUIR)
SEC. 28
SW SE 17.5 AC.
SE SE 2.0 AC.
SEC. 33
NE NE 20.0 AC.
NW NE 1.5 AC.
SE NE 2.0 - TOTAL 43.0 ACRES

-  SECTION AND 1/4 SECTION LINES
-  1/4 1/4 SECTION LINES
-  RECORD PROPERTY LINES
-  EXISTING IRRIGATION MAINLINE


-  RECORD SURVEY MONUMENT POSITION
-  POD 1 - SAMS & MILES DIVERSION (LOCALLY KNOWN AS SMITH DIVERSION) IS LOCATED WITHIN THE SE 1/4 OF THE SW 1/4 OF SECTION 34 AND IS LOCATED 8065' EAST AND 9035' SOUTH FROM THE NW COR. OF SECTION 28.
- THE PARSHALL FLUME, THE MEASURING DEVICE FOR THIS COBU, IS LOCATED 10' EAST AND 28' NORTH OF POD 1 ALONG THE SMITH DITCH.
- THE FISH SCREEN AND FISH BY-PASS STRUCTURE FOR THIS COBU, IS LOCATED 40' WEST AND 135' NORTH OF POD 1 ALONG THE SMITH DITCH.

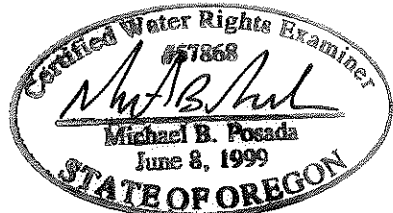

EXPIRATION DATE: 12-31-18

SIGNED: 02-14-18

RECEIVED
MAR 22 2018
OWRD

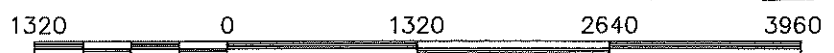

NOTE:
THIS MAP IS FOR THE PURPOSE OF
LOCATING A WATER RIGHT ONLY AND
IS NOT INTENDED TO PROVIDE LEGAL
DIMENSIONS OR LOCATIONS OF
PROPERTY LINES.

**BUREAU OF RECLAMATION
CATHERINE CREEK CC-44
RIVER RESTORATION PROJECT
2013-2016**

DATE OF SURVEY: OCT. 17, 2017 J# 195-46 (217)



CLAIM OF BENEFICIAL USE - TRANSFER T-11548
CTUIR, KINSLEY & SHOEMAKER
CTUIR: 46411 TIMINE WAY, PENDLETON OR. 97801
KINSLEY: P.O. BOX 634, ISLAND CITY, OR. 97883
SHOEMAKER: 1411 WASHINGTON AVE.
LA GRANDE, OR. 97850

FIGURE
1 OF 1

COBU MAP # 1128