


COBU MAP # 1021

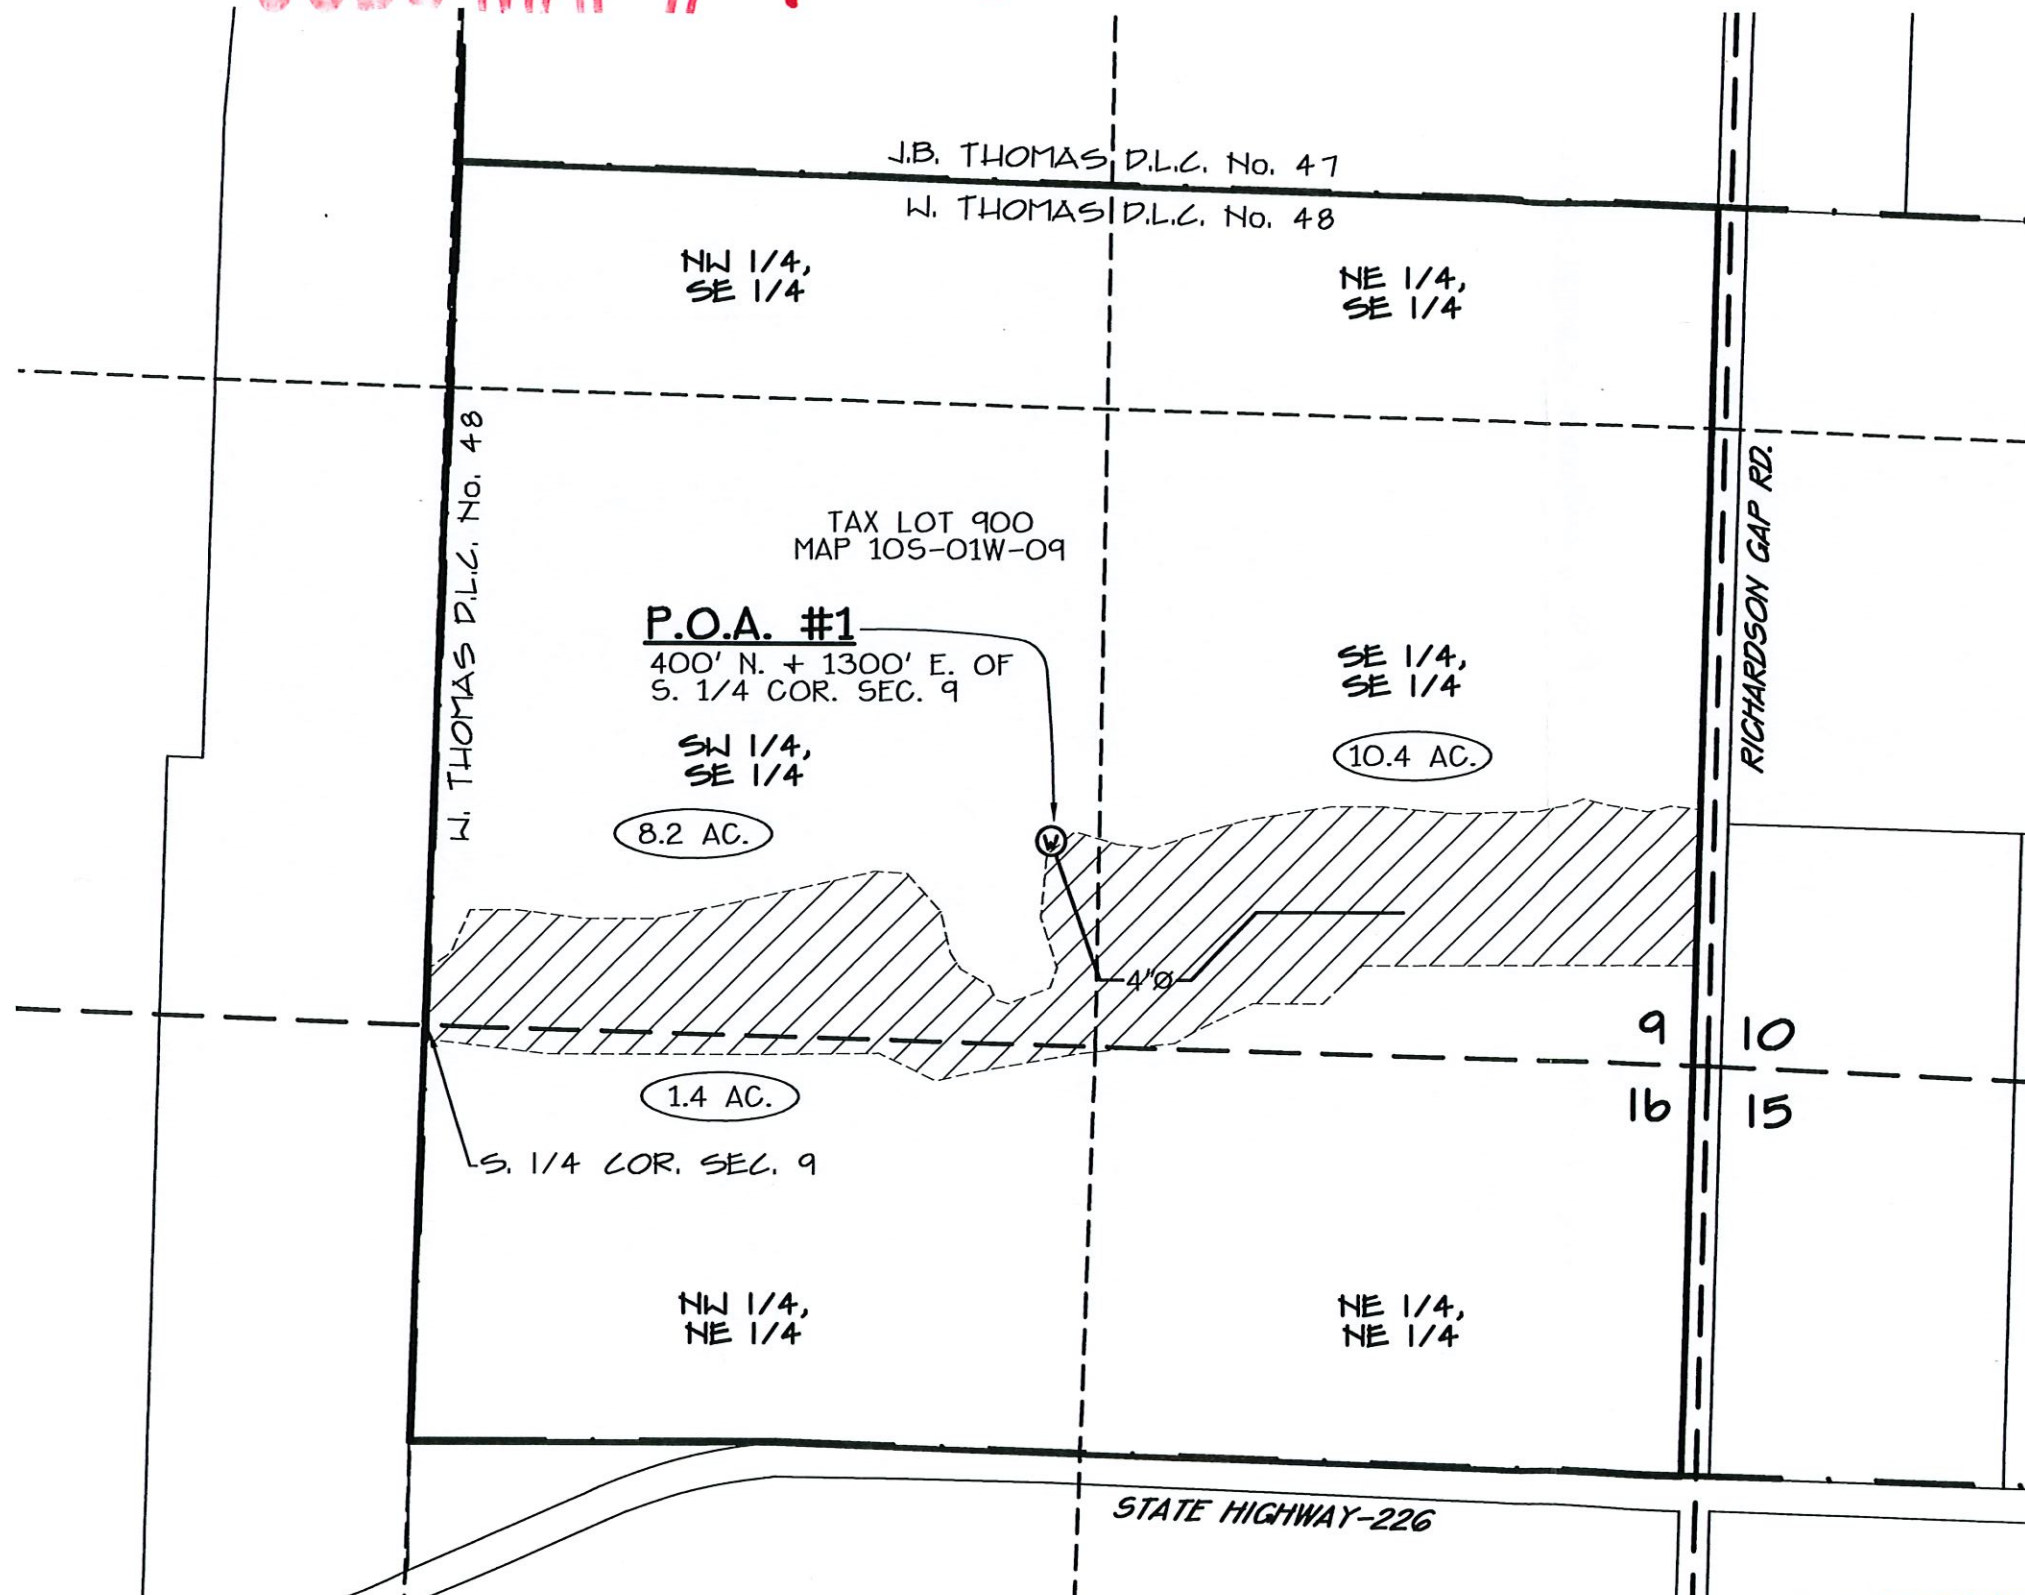

CLAIM OF BENEFICIAL USE MAP
FOR
JON CARTER

LOCATED IN

SE 1/4 SEC. 9, T. 10 S., R. 1 W., W.M.
NE 1/4 SEC. 16, T. 10 S., R. 1 W., W.M.
W. THOMAS D.L.C. No. 48
LINN COUNTY, OREGON

SEPTEMBER 1, 2016

APPLICATION G-15902
PERMIT G-15513

0 200 400 800 FT.

SCALE: 1" = 400'

COPY OF ORIGINAL



LEGEND:

- 1.2 AC. AMOUNT OF IRRIGATED LAND PER 1/4 1/4 SECTION
- ⊙ AUTHORIZED WELL - LINN 3782 WITH ATTACHED METER
- 4"Ø— BURIED 4" PVC MAIN LINE

IRRIGATION NOTE:

IRRIGATION IS DONE WITH MOVABLE "K-LINE" TYPE SPRINKLERS AND PIPING, THEREFORE THE LATERAL LINES ARE NOT SHOWN ON THE MAP, ONLY THE 4" MAINLINE IS PERMANENT.

NOTE:

THIS MAP IS NOT INTENDED TO PROVIDE LEGAL DIMENSIONS OR LOCATION OF PROPERTY OWNERSHIP. INFORMATION ON THIS MAP IS COMPILED FROM 2016 LINN COUNTY GIS DATA, AERIAL PHOTOGRAPHY AND OTHER RECORD SURVEY INFORMATION.

Date: 8/30/2016 Time: 8:33
View: VIEW Scale: 1=400(PS)
File: dwg\2016\16-100\16-100-cobu.dwg (lan)

K & D

K & D ENGINEERING, Inc.
276 N.W. Hickory Street P.O. Box 725
Albany, Oregon 97321
(541) 928-2583

RECEIVED

SEP 07 2016

WATER RESOURCES DEPT
SALEM, OREGON

SHEET 1 OF 1