

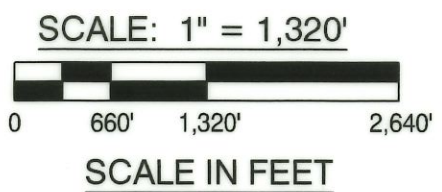


CLAIM OF BENEFICIAL USE MAP
NEWBILL CREEK RESERVOIR
APPLICATION NO. R - 87832
PERMIT NO. R - 15048
JEFFERSON COUNTY, OREGON

DISCLAIMER:
THIS MAP IS NOT INTENDED TO PROVIDE
LEGAL DIMENSIONS OR LOCATIONS OF
PROPERTY OWNERSHIP LINES

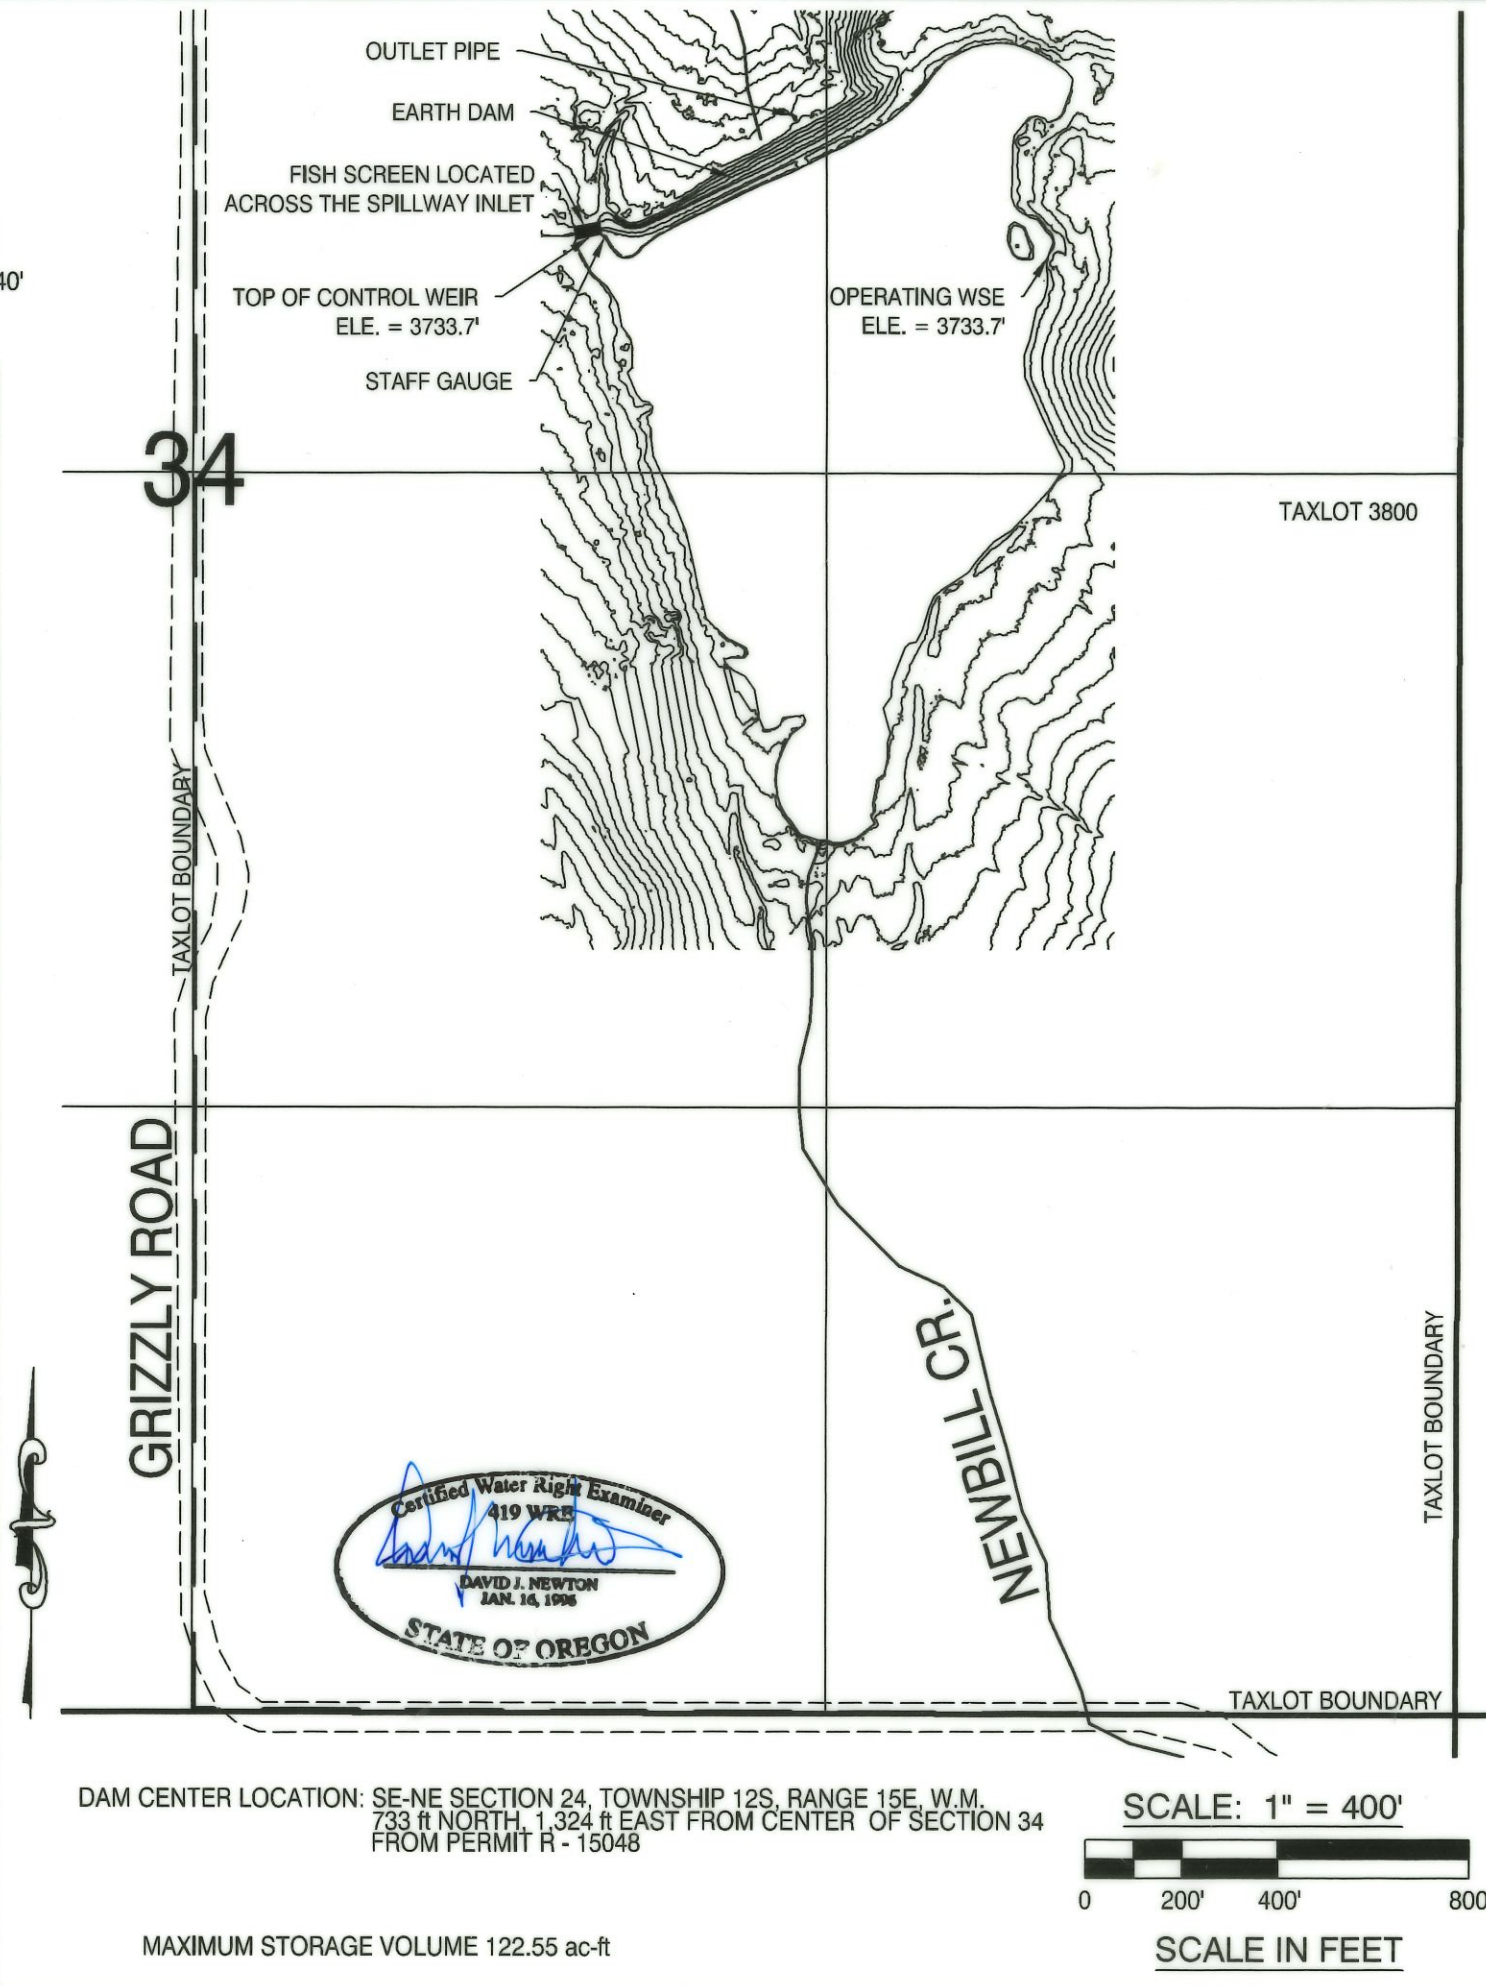

T12S, R15E

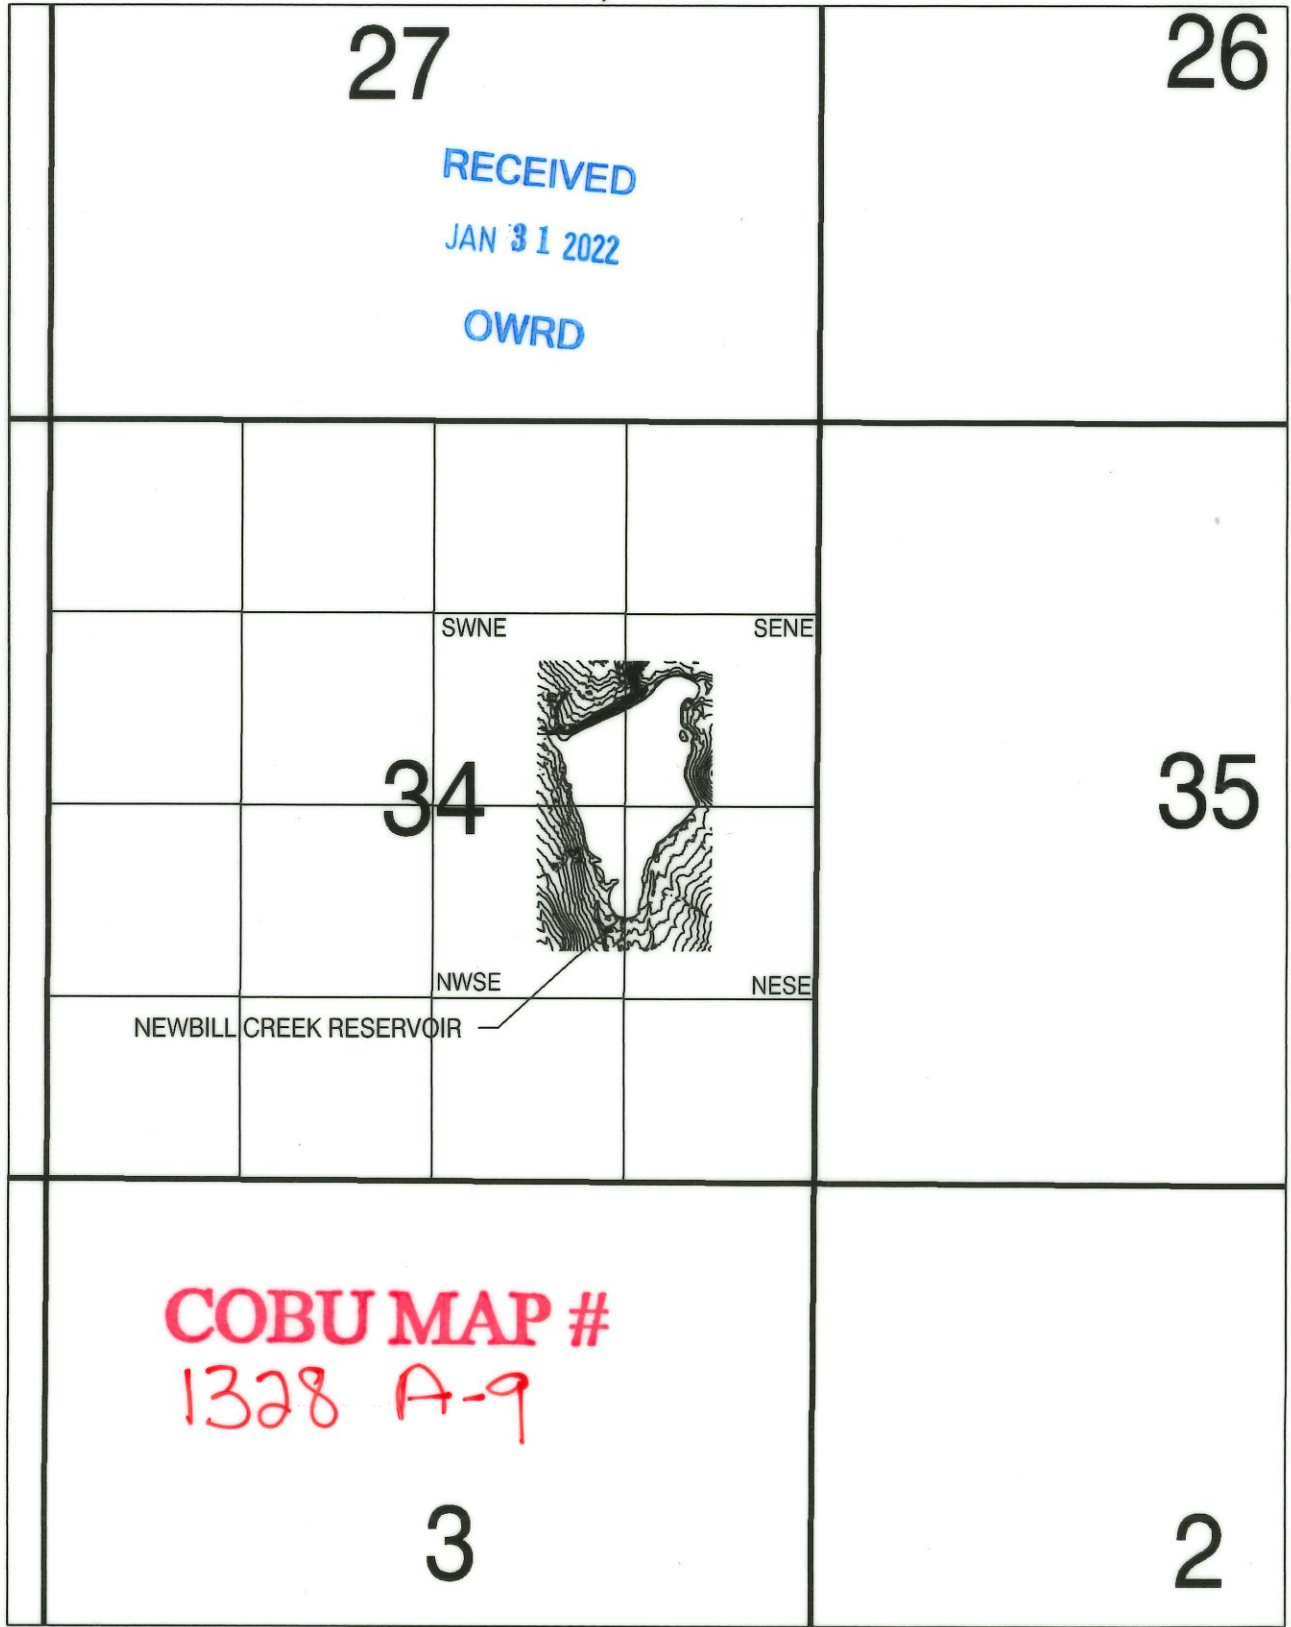

DRAWING STATUS:	DATE:	REVISION:	DATE:
AS-BUILT TOPO	4/26/19		

RSI Resource Specialists Inc.

1180 SW LAKE RD, STE 202
REDMOND, OR 97756

(541) 771-6911
gabe@rsiengr.com

PROJECT: NEWBILL CREEK RES.

PROJECT LOCATION: JEFFERSON COUNTY

CLIENT: KELLY BRUUN

DRAWN BY: GMW

SHEET TITLE: COBU MAP

DRAWING: NCR - 1