

Alternate Reservoir Application Map
Glasscock
T.25S. R.6W. Section 8
Douglas County

RECEIVED

FEB 02 2024

RECEIVED


OWRD

JAN 26 2023

OWRD



Scale: 1" = 800'

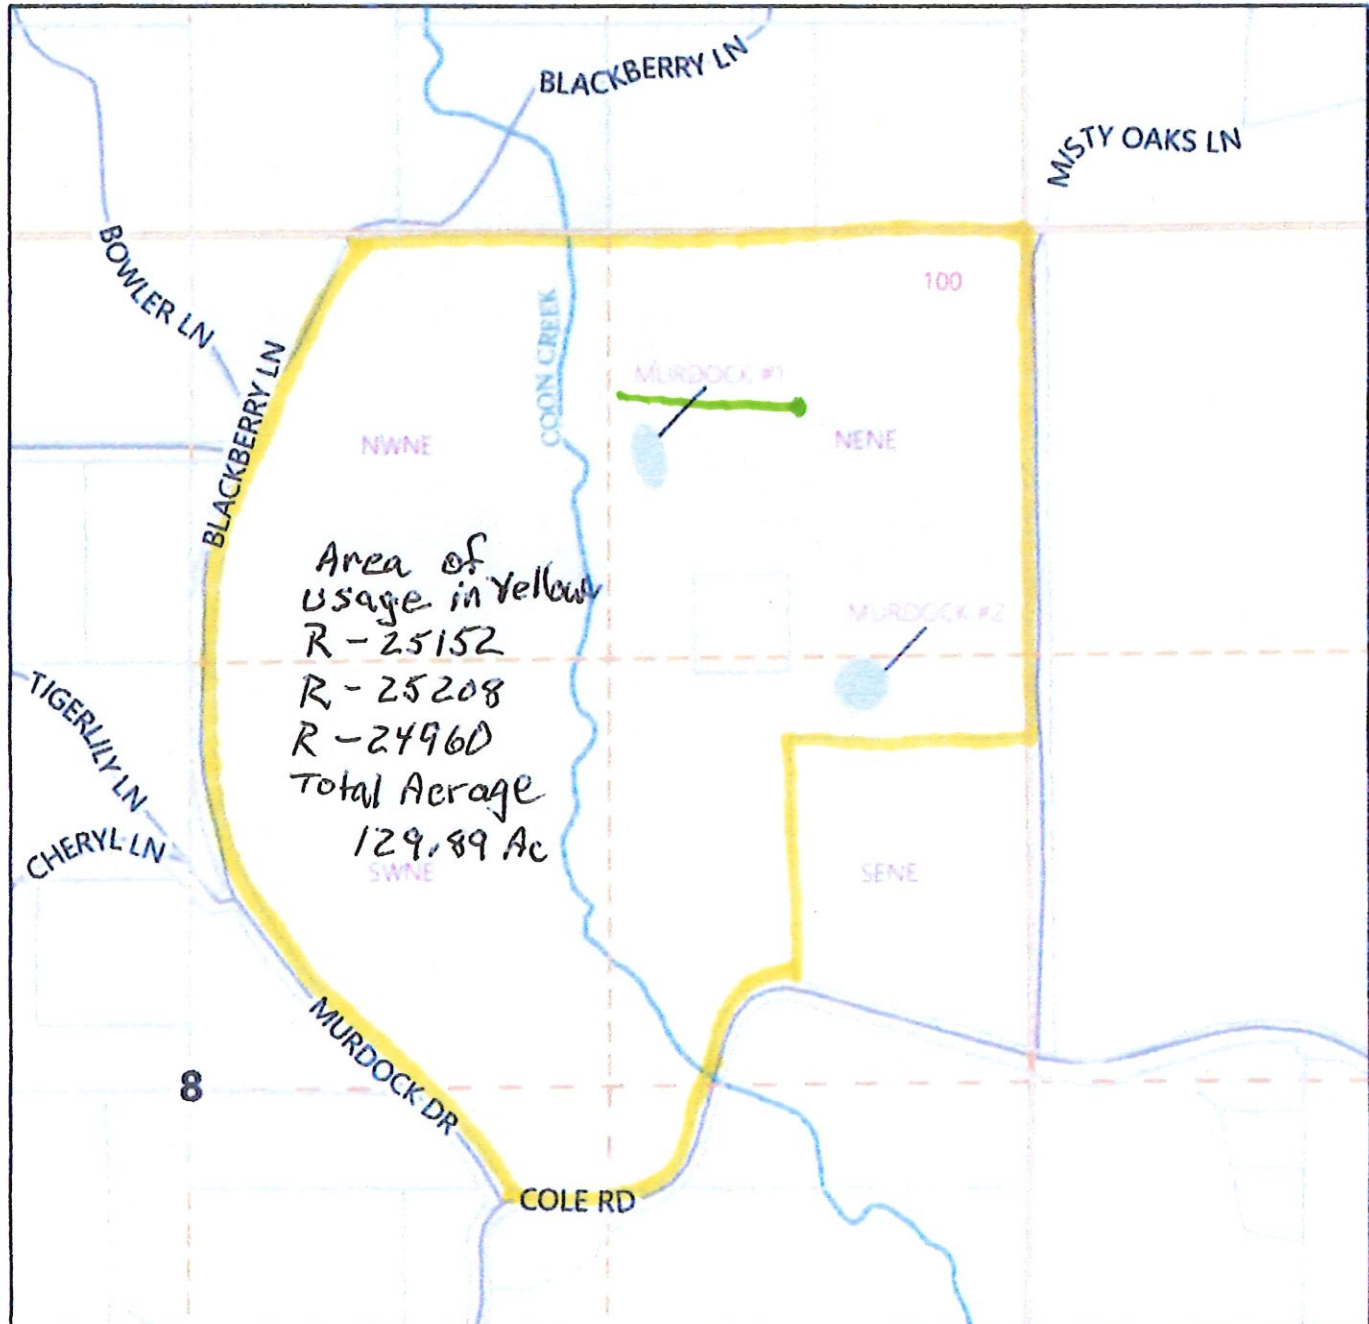

MURDOCK # 1 is ⁷⁰⁶~~972~~ ft. South and ¹¹⁸³~~1625~~ ft. West from the NE Section Corner 8

MURDOCK # 2 is 1950 ft. South and 709 ft. West from the NE Section Corner 8

The purpose of this map is to identify
the location of a Water Right.

Not intended to show property ownership.