


EAGLE CREST AS-BUILT WATER PLAN


PREPARED BY W & H PACIFIC
PREPARED 7/1/93



LEGEND:

- WATER LINE
- - - BIKE PATH / JOGGING TRAIL
- ⊕ WATER VALVE
- ⊕ FIRE HYDRANT

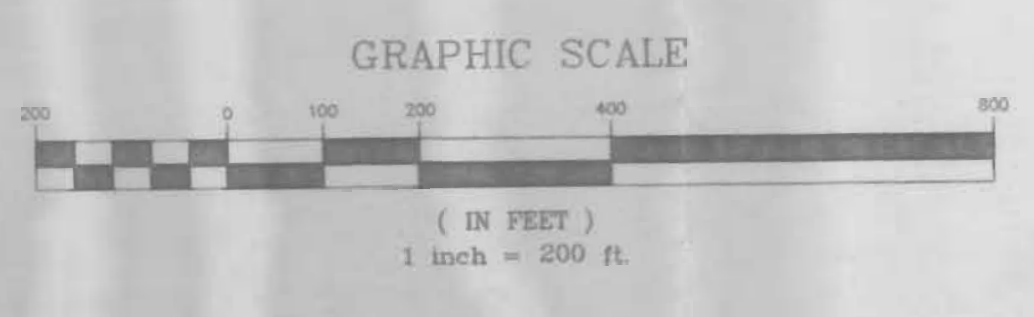

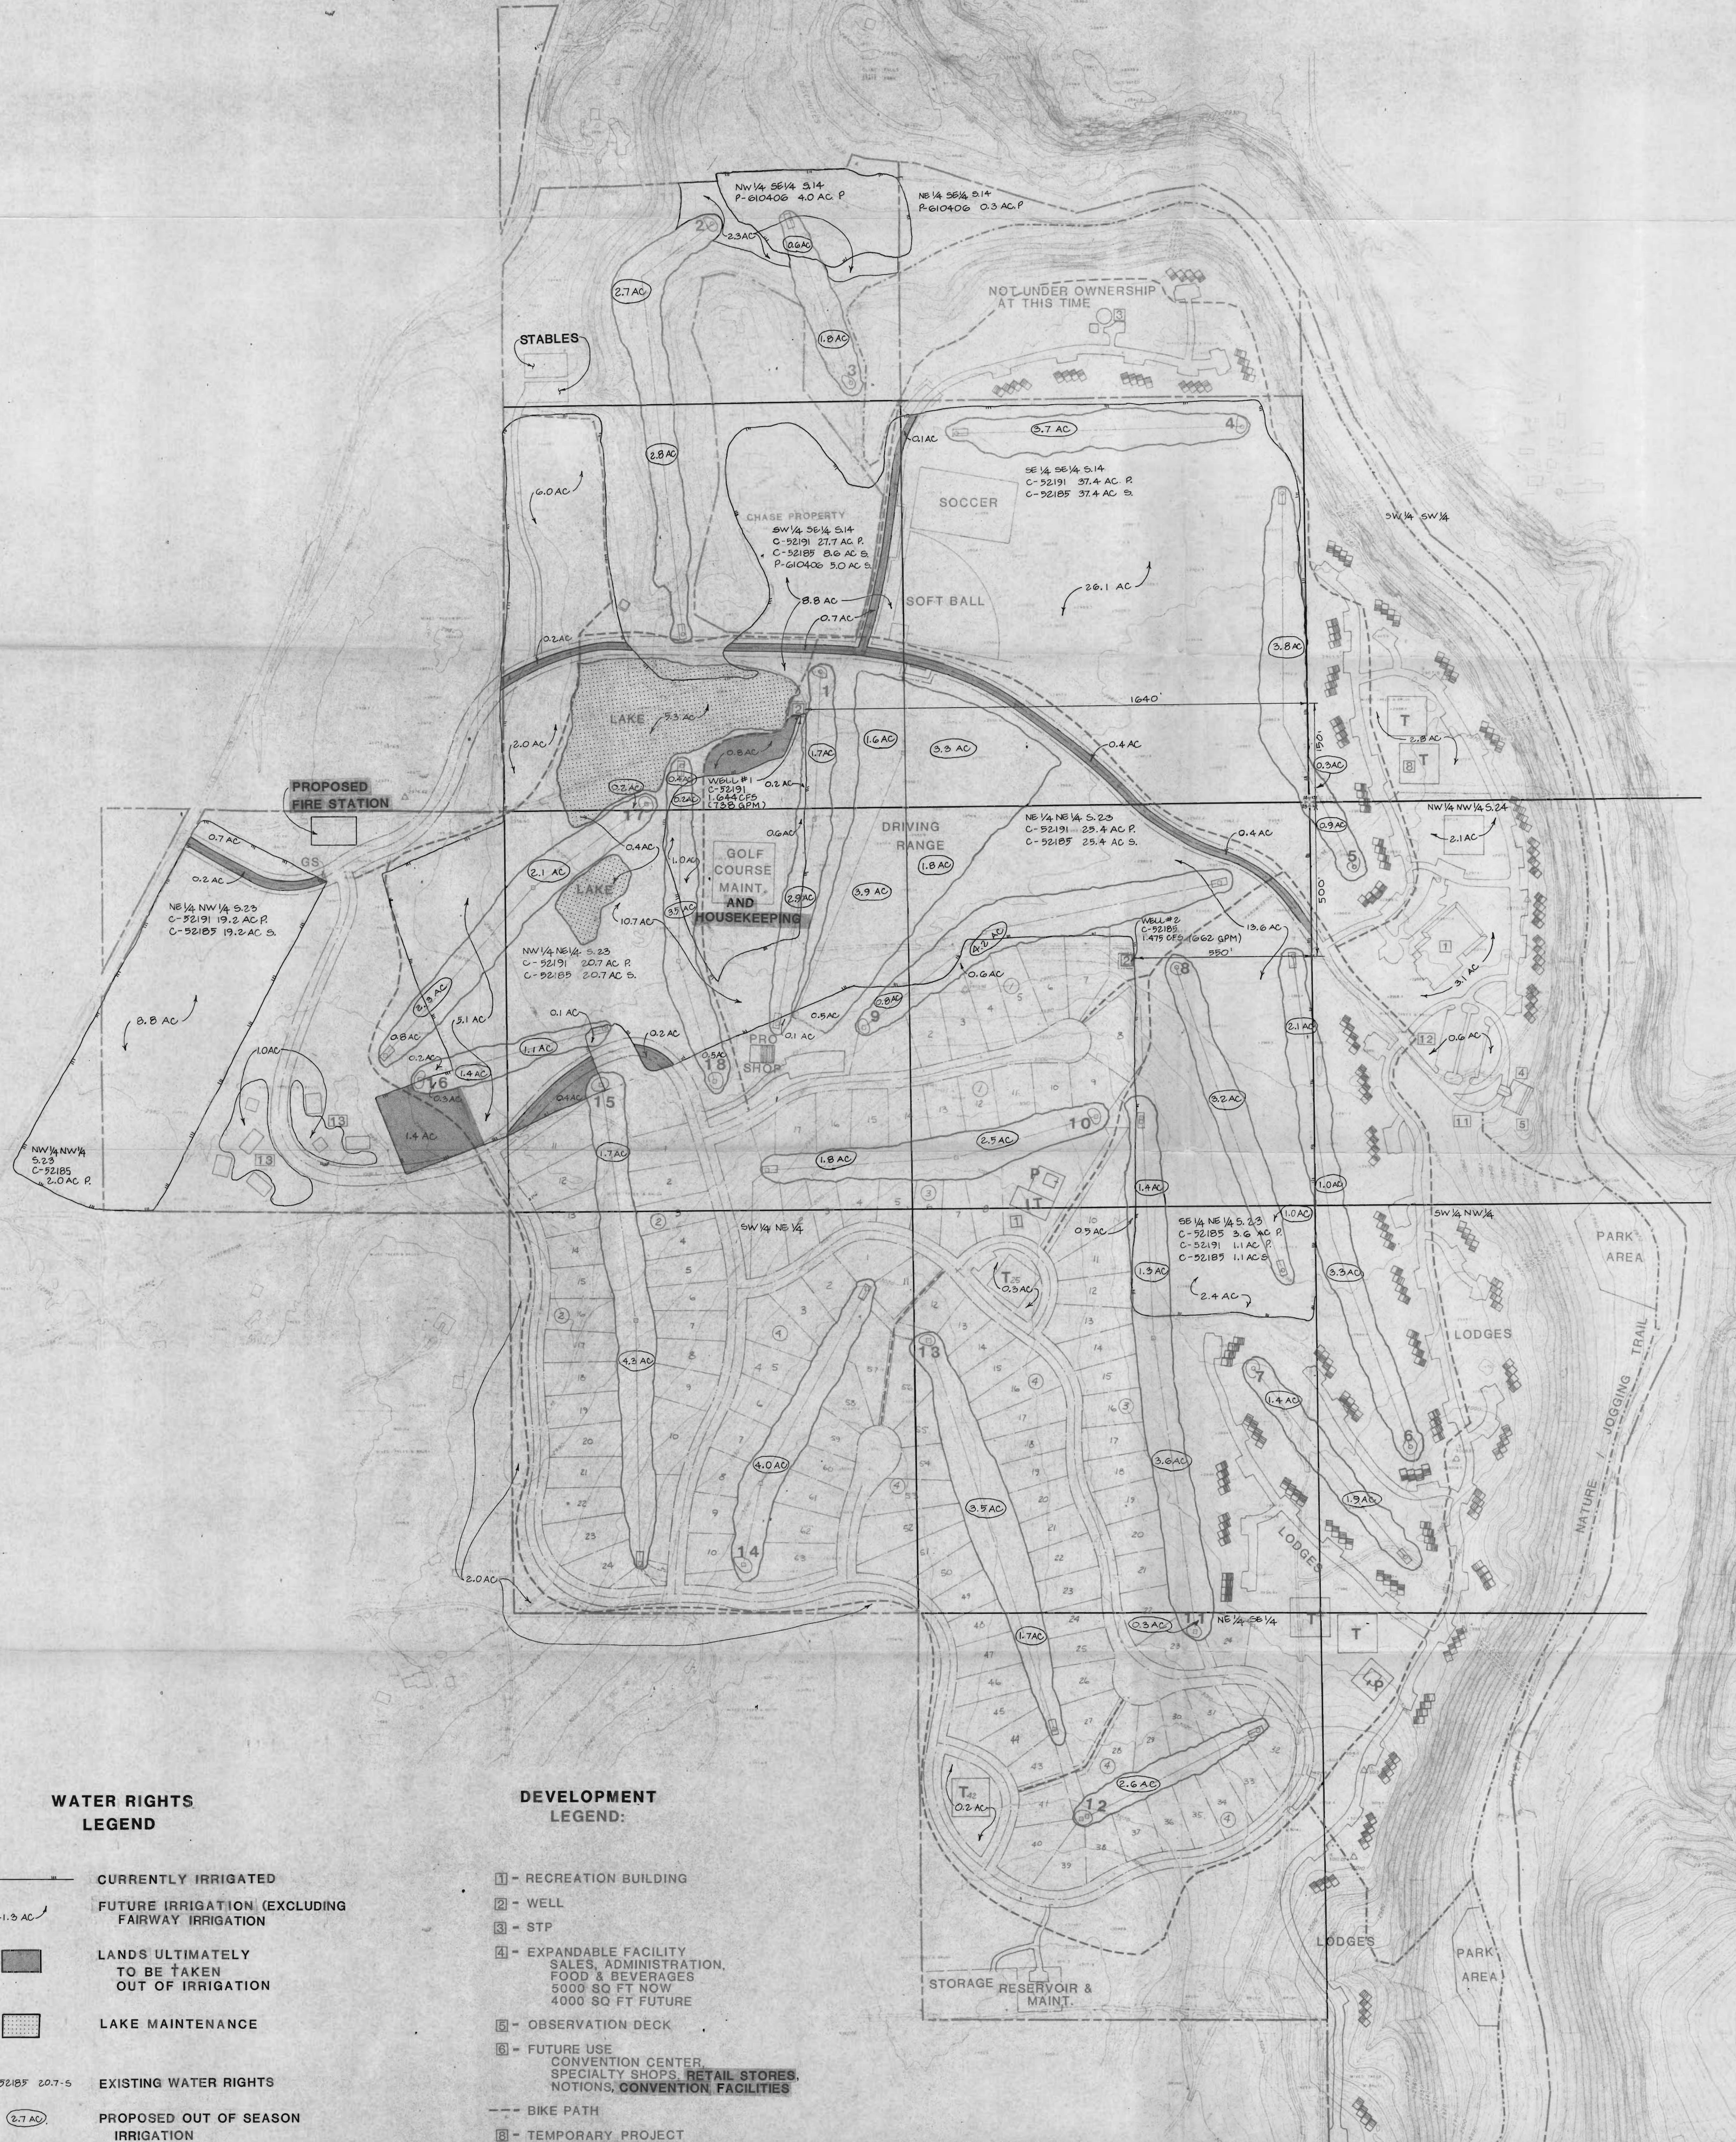

WATER RIGHTS LEGEND

- CURRENTLY IRRIGATED
- FUTURE IRRIGATION (EXCLUDING FAIRWAY IRRIGATION)
- LANDS ULTIMATELY TO BE TAKEN OUT OF IRRIGATION
- LAKE MAINTENANCE
- EXISTING WATER RIGHTS
- PROPOSED OUT OF SEASON IRRIGATION

DEVELOPMENT LEGEND:

- RECREATION BUILDING
- WELL
- STP
- EXPANDABLE FACILITY SALES, ADMINISTRATION, FOOD & BEVERAGES 5000 SQ FT NOW 4000 SQ FT FUTURE
- OBSERVATION DECK
- FUTURE USE CONVENTION CENTER SPECIALTY SHOPS, RETAIL STORES, NOTIONS, CONVENTION FACILITIES
- BIKE PATH
- TEMPORARY PROJECT ADMINISTRATION MOBILE UNITS
- PASSAGE WAY
- CHILDRENS PLAY AREA
- 5 MIN PARKING
- LANDSCAPED AREA
- POOL
- TENNIS COURTS
- INDOOR TENNIS COURTS
- COMMERCIAL USE AREA: (CONVENIENCE GROCERY SPECIALTY RETAIL, RESTAURANT, SERVICE STATION, ETC.)

GENERAL NOTES:
 1. FAIRWAY ACREAGE IS BASED UPON A PROPOSED AVERAGE WIDTH OF 100 FEET.
 2. A STANDARD DOMESTIC WATER SUPPLY SYSTEM WILL BE CONSTRUCTED AND WILL INCLUDE FIRE HYDRANTS THROUGHOUT THE PROJECT.
 3. PROJECT WELLS WILL BE UTILIZED FOR LAKE MAINTENANCE.
 4. 332 DWELLINGS ARE EXPECTED IN ADDITION TO THE NOTED COMMERCIAL AND RECREATIONAL FACILITIES.
 5. THE PROJECT IS EXPECTED TO BE COMPLETED IN SEVEN PHASES OVER A 6 1/2 YEAR PERIOD. THE POPULATION IS EXPECTED TO GROW TO 1000 PEOPLE IN THIS 6 1/2 YEAR PERIOD.

PROPOSED WATER RIGHT ALLOCATION & TRANSFER SUMMARY

TOWNSHIP 15 S RANGE 12 E
APRIL 1985
 (REVISED MAY 21, 1985)

Application No. **D-11387**
 Permit No. **G10530**



CONTROL BY
CENTURY WEST ENGINEERING CORPORATION
 BEND, OREGON
 HORIZONTAL DATUM LOCAL
 VERTICAL DATUM U.S.C.B.S.
 DATE OF SURVEY SEPT. 1983



EAGLE CREST DEVELOPMENT

REDMOND, OREGON
 PORTIONS OF SECTIONS 13, 14, 23, & 24 T15S, R12E W.M.
 SCALE IN FEET
 CONTOUR INTERVAL 2'

NPAS INC.
 NORTH PACIFIC AERIAL SURVEYS INC.
 PREPARED BY STEREO PHOTOGRAMMETRIC METHODS NOV 1983 FROM PHOTOGRAPHS DATED 9-21-83

RECEIVED
 MAY 22 1985
 WATER RESOURCES
 BUREAU, OREGON