


SOUTH BEND
 BROSTERHOUS ROAD
 WATER MAIN

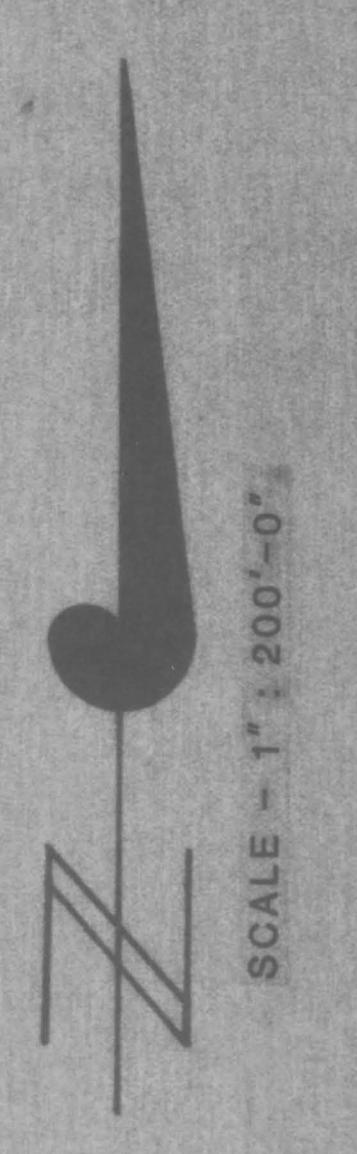

SCALE = 1" = 200'-0"

J.L. WARD CO.
 61045 BROSTERHOUS ROAD
 BEND, OREGON 97702

ROATS WATER SYSTEM
 AS-BUILT
 SOUTH BEND



File 2-1001


STAFF STATION
METERS



SCALE = 1" = 200'-0"

J.L. WARD CO.
61045 BROSTERHOUS ROAD
BEND, OREGON 97701

ROATS WATER SYSTEM
AS-BUILT
SOUTH BEND

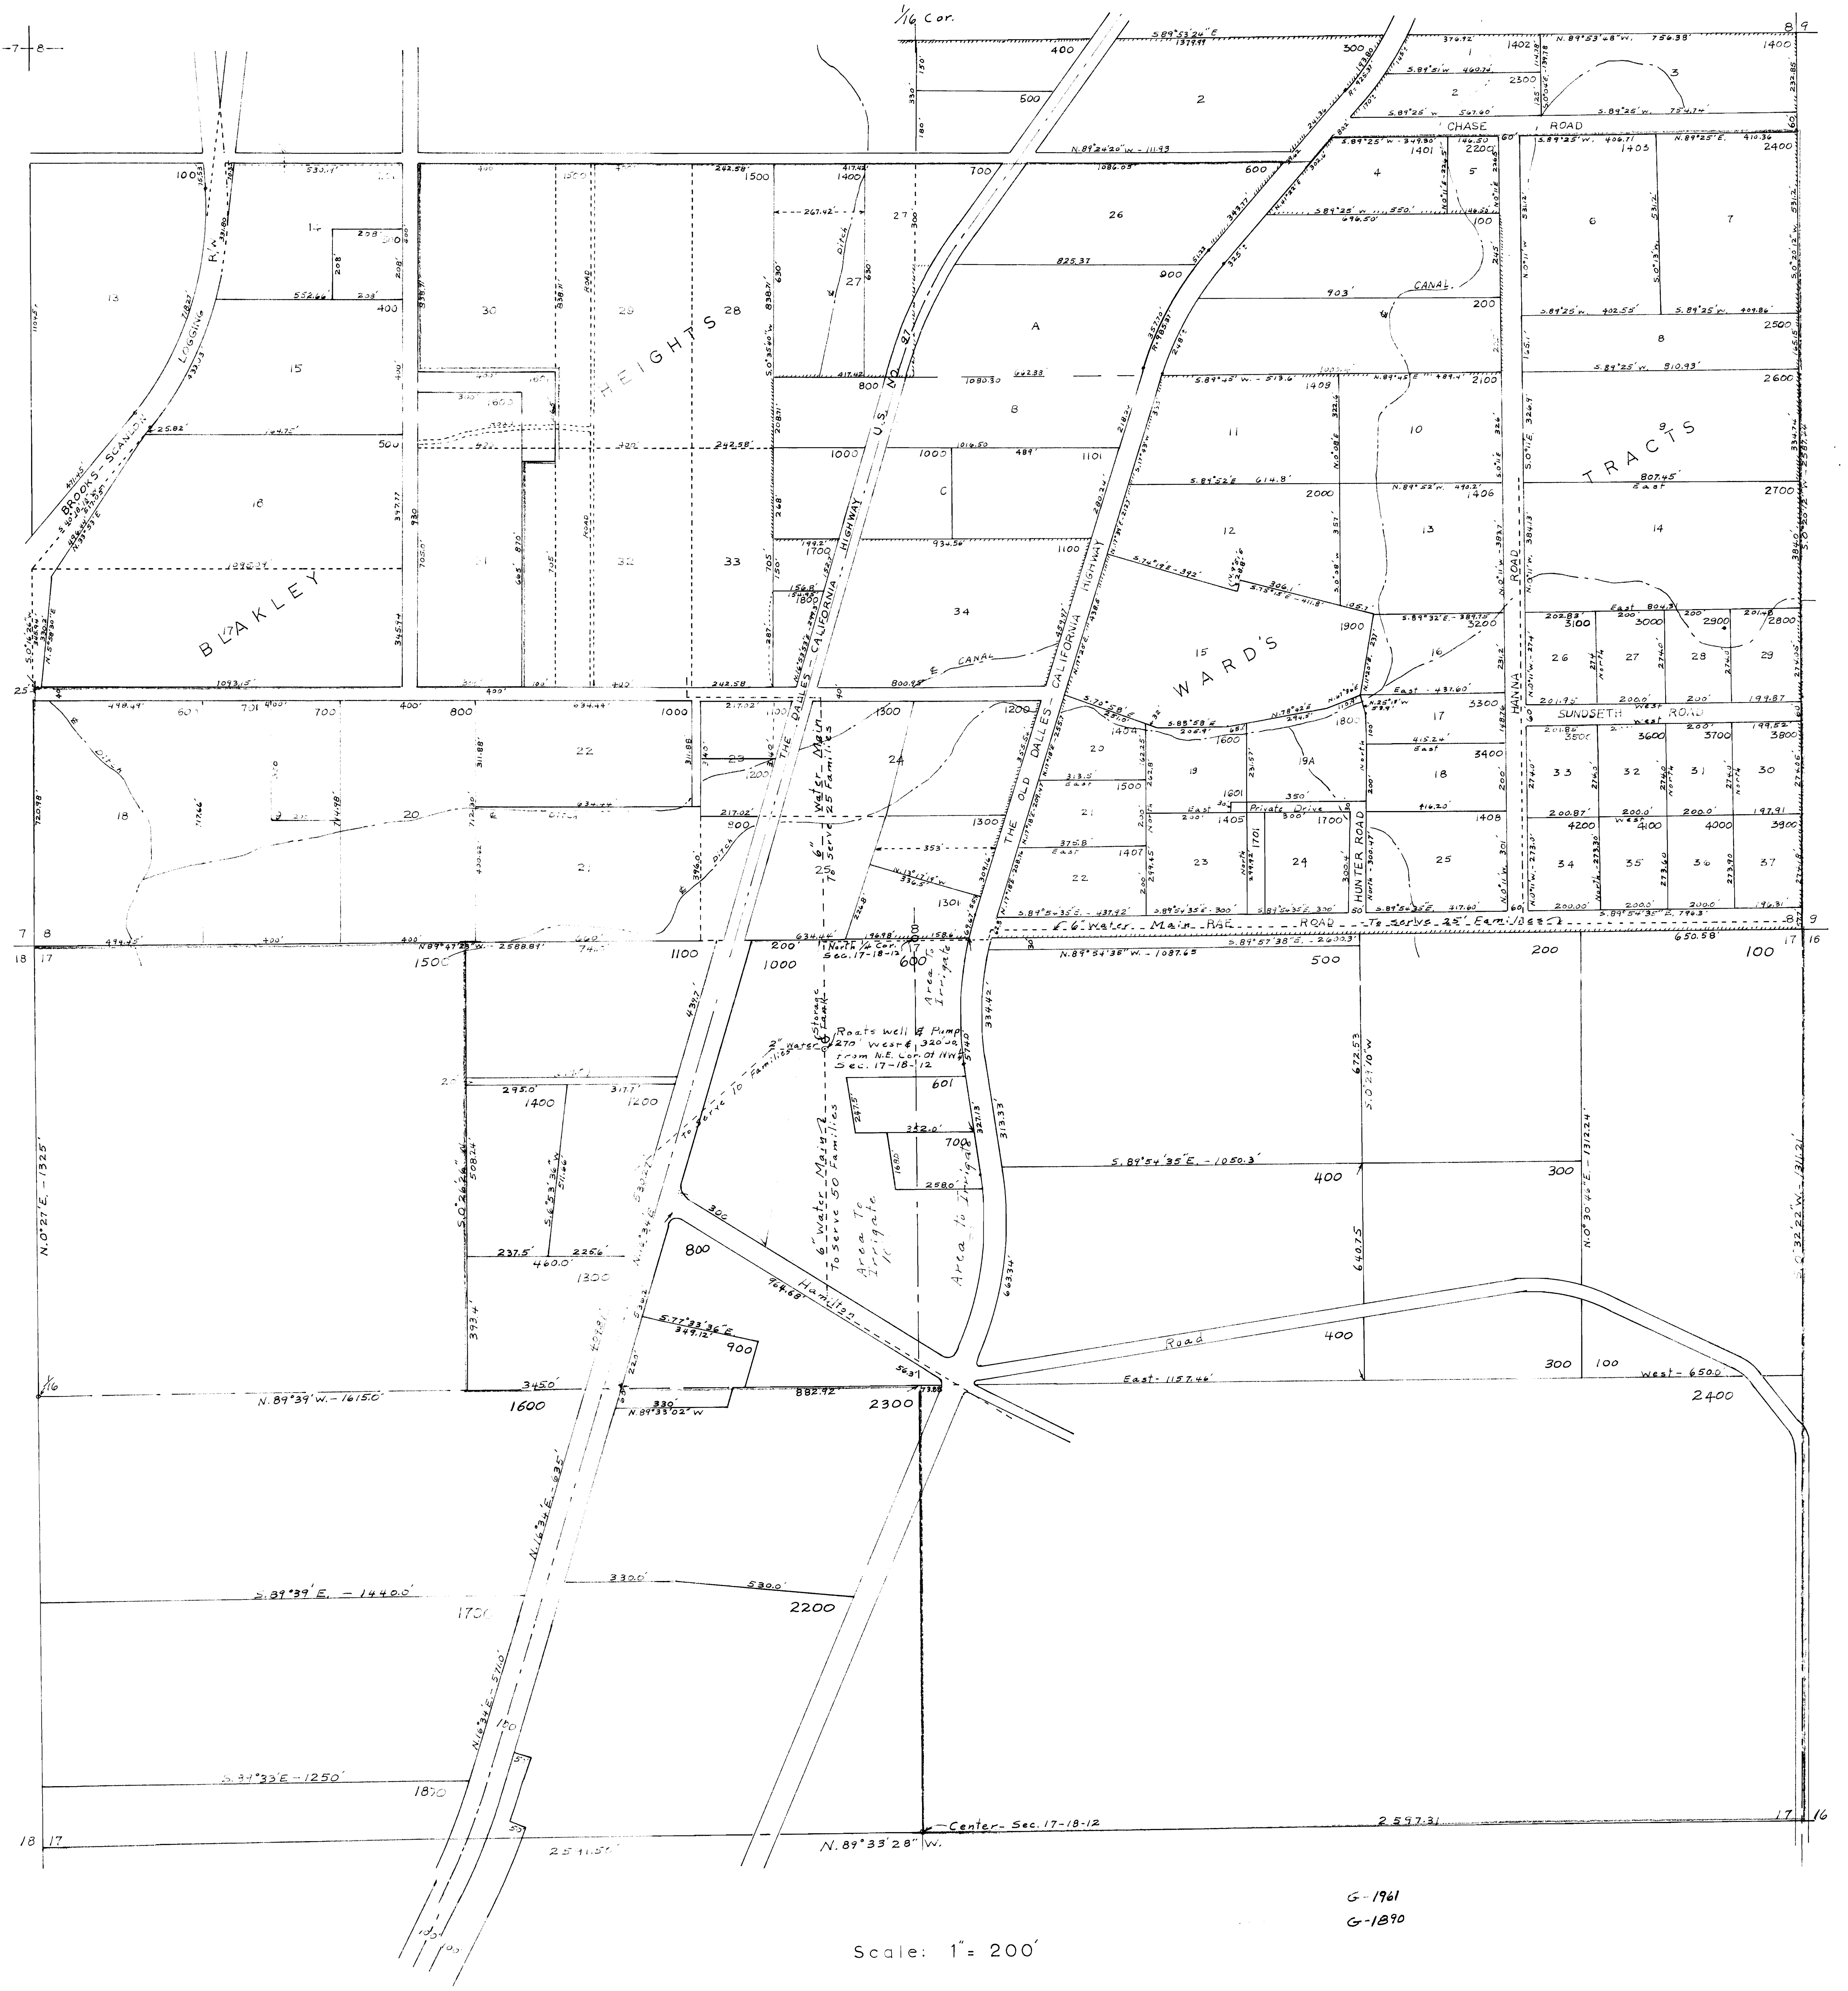

G-1961
G-1890