


T.15S. R.10E. W.M.

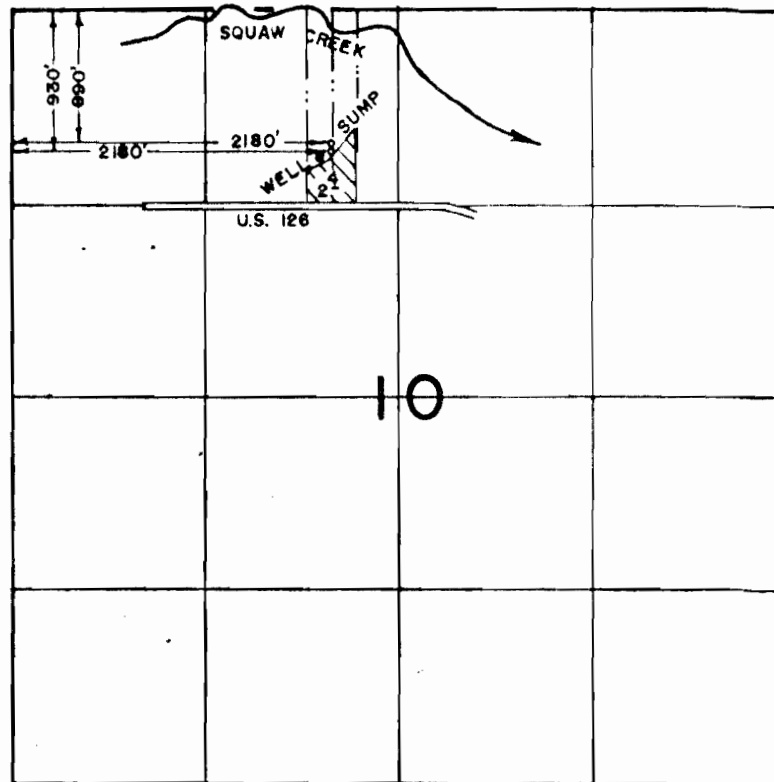

**FINAL PROOF SURVEY**  
UNDER

G-7554                      G-7209  
Application No. ~~G-8675~~ Permit No. ~~G-7959~~.....  
IN NAME OF

.....LESTER & WILLARD CURTIS.....

Surveyed MAY 23, 1980., by L.H. NUNN.....

Section 10, T.15S. R.10E.W.M.  
DESCHUTES COUNTY

1" = 400'

Location of pond for which water right application is being made.


Lester R Curtis

I own only the western 5 Acres but the sump pond lies on both Lester Curtis & my land. Curtis prop. and eventually shall furnish water to both pieces.

Application No. G-~~8675~~  
Permit No. G-~~7959~~

RECEIVED  
SEP 1 1976  
WATER RESOURCES DEPT  
SALEM, OREGON

RECEIVED  
OCT 21 1976  
WATER RESOURCES DEPT  
SALEM, OREGON

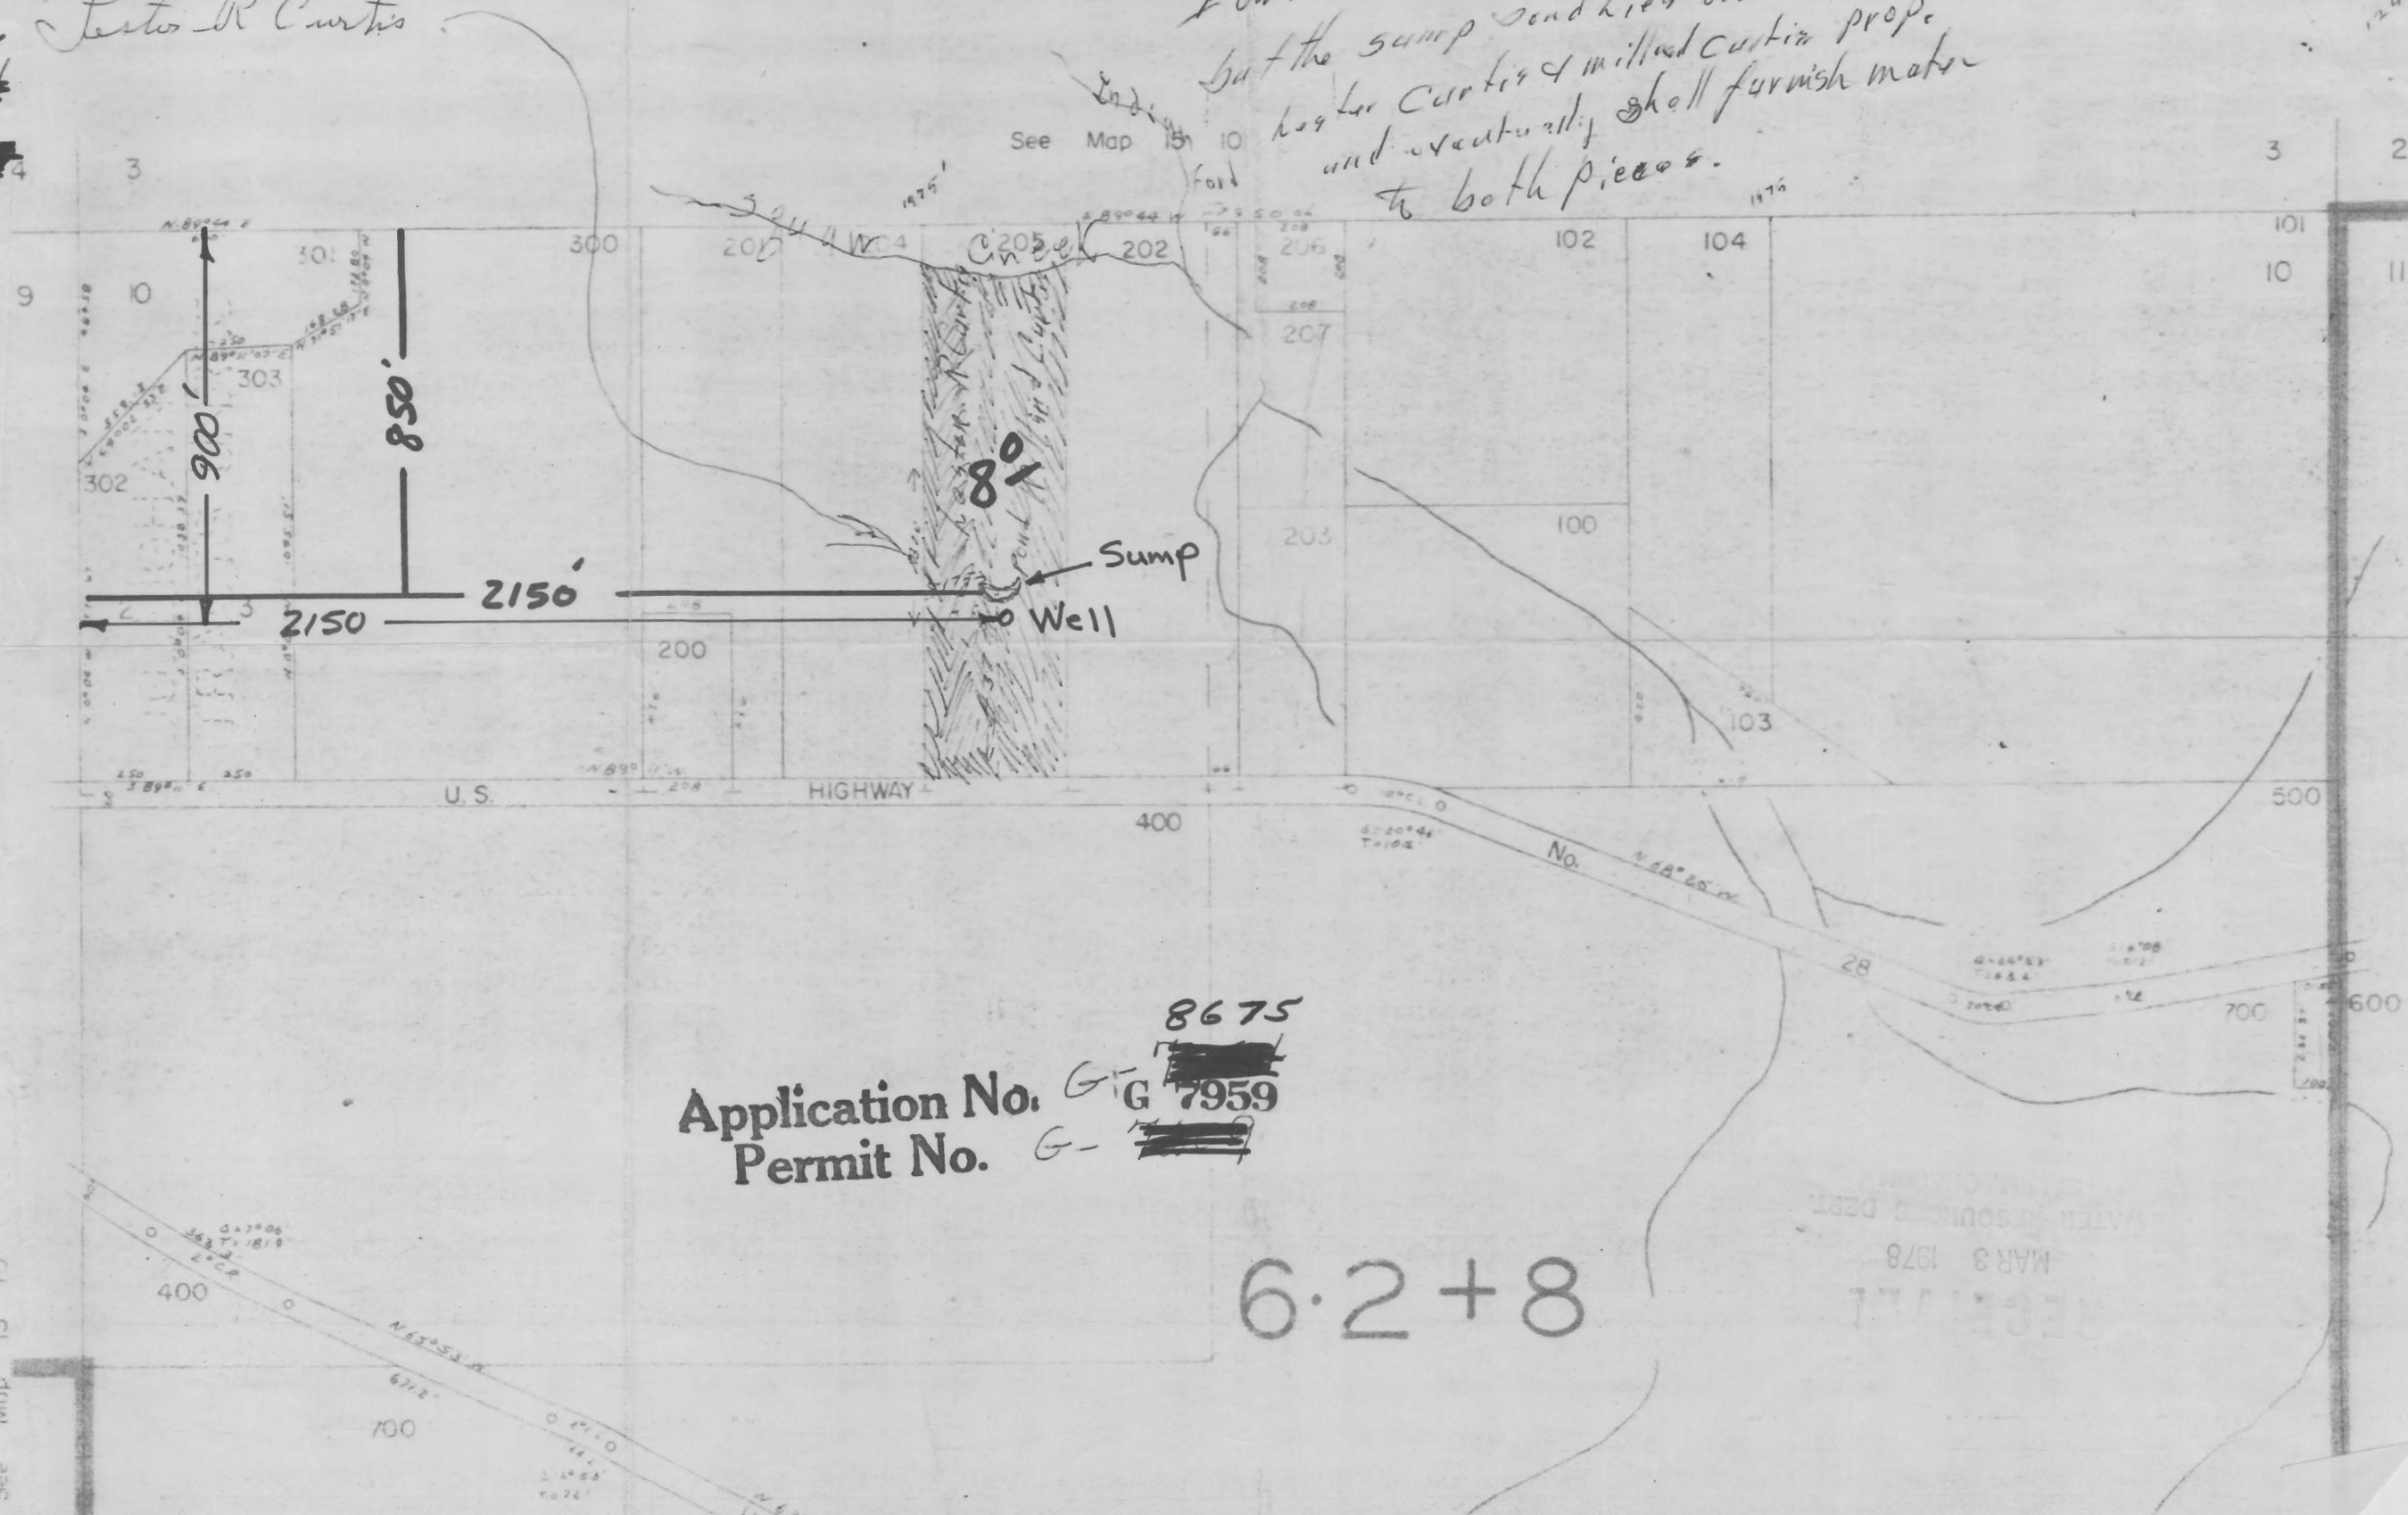

Application No. G-~~8675~~ 7959  
Permit No. G-~~7959~~

6-2+8

RECEIVED  
MAR 3 1978  
WATER RESOURCES DEPT