


SE 1/4 SEC 36 T36S R6W WM.
JOSEPHINE COUNTY
1" = 400'

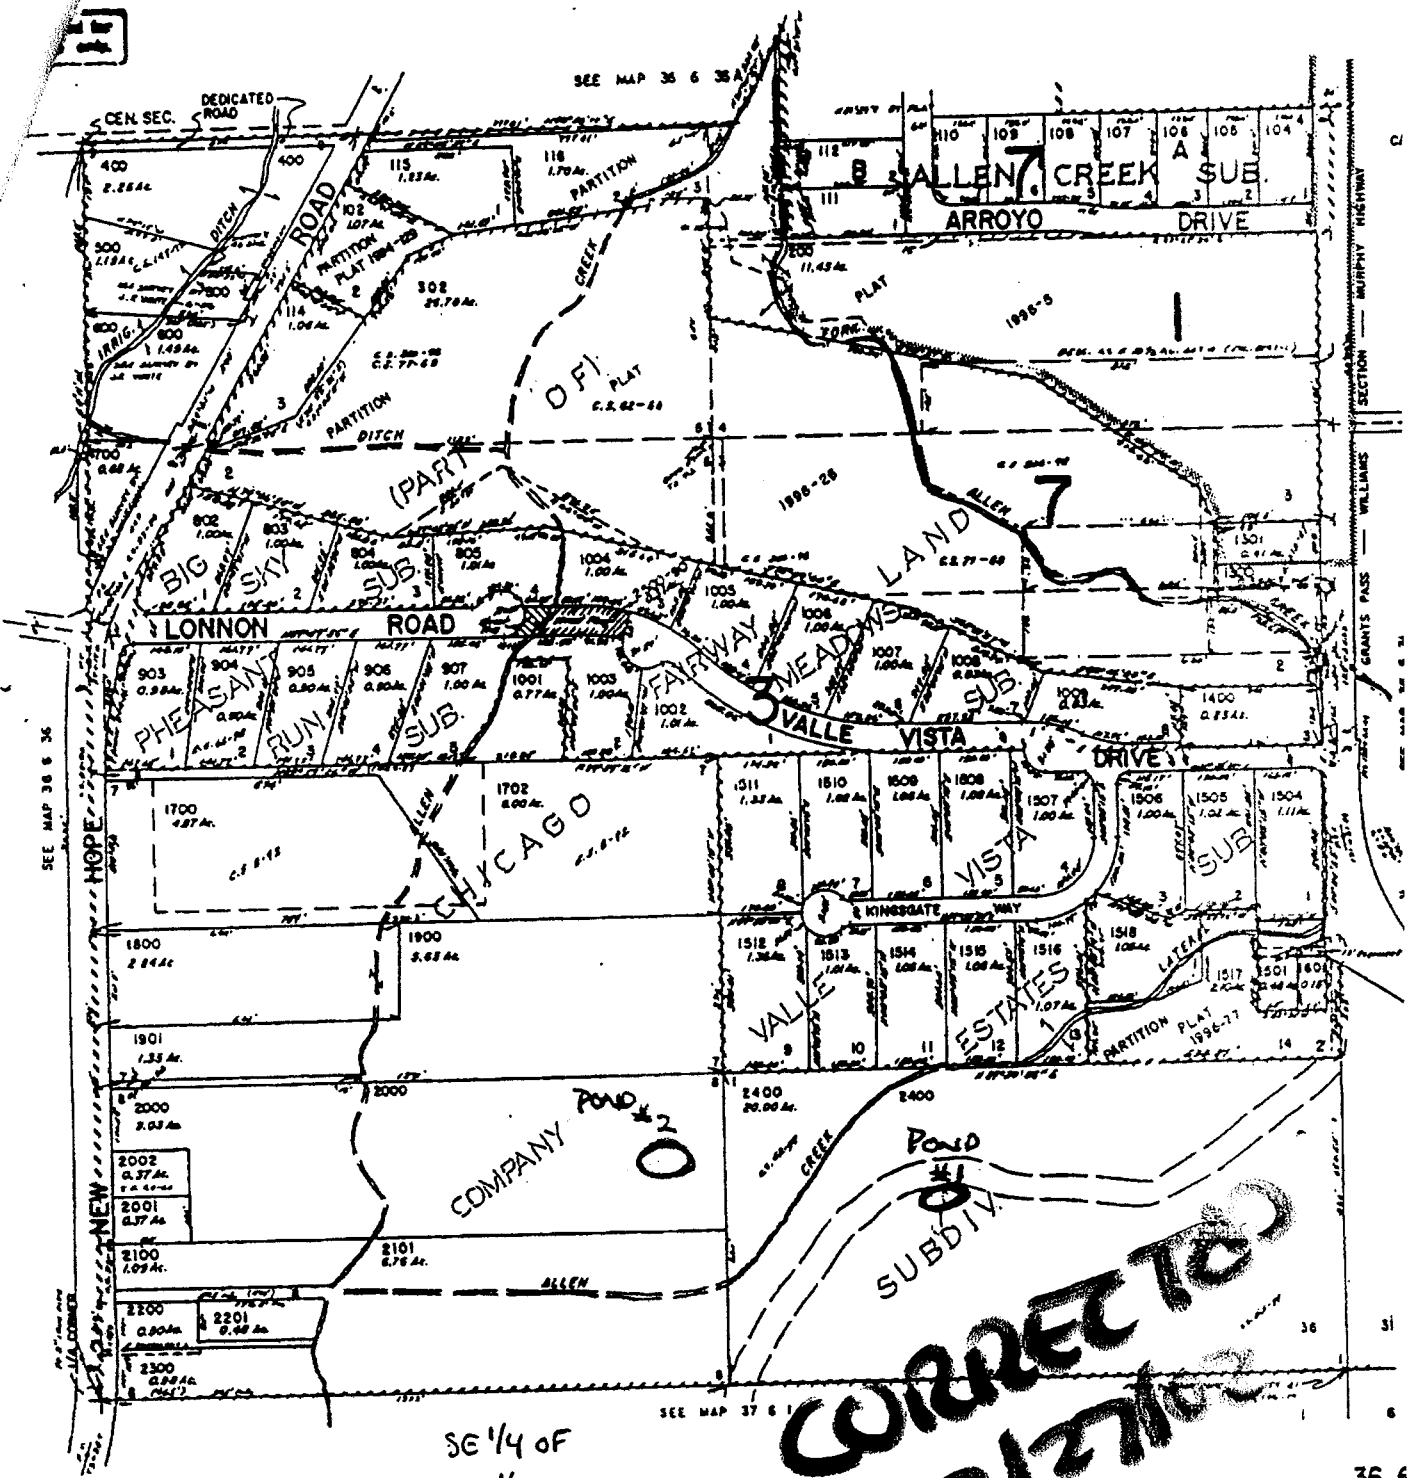

SE 1/4 OF
SE 1/4

**CORRECTED
PLAT**

APPLICATION MAP
FOR CLIFF WOODRUFF CONST.

36S 6W 36 DO T2 2000

36S 6W 36 DO T2 2400

POND #1
400' N BK
860' W & ~~1780' N~~ 1927/02
FROM SEC. CORNER
36 31.6.1

POND #2
500' N BK
1470' W & ~~1840' N~~ 1212/02
FROM SEC CORNER
36 31.6.1

APP # R-85389
Permit # R-13642