


SE 1/4 SEC 36 T36S R6W W.M.
JOSEPHINE COUNTY
1" = 400'

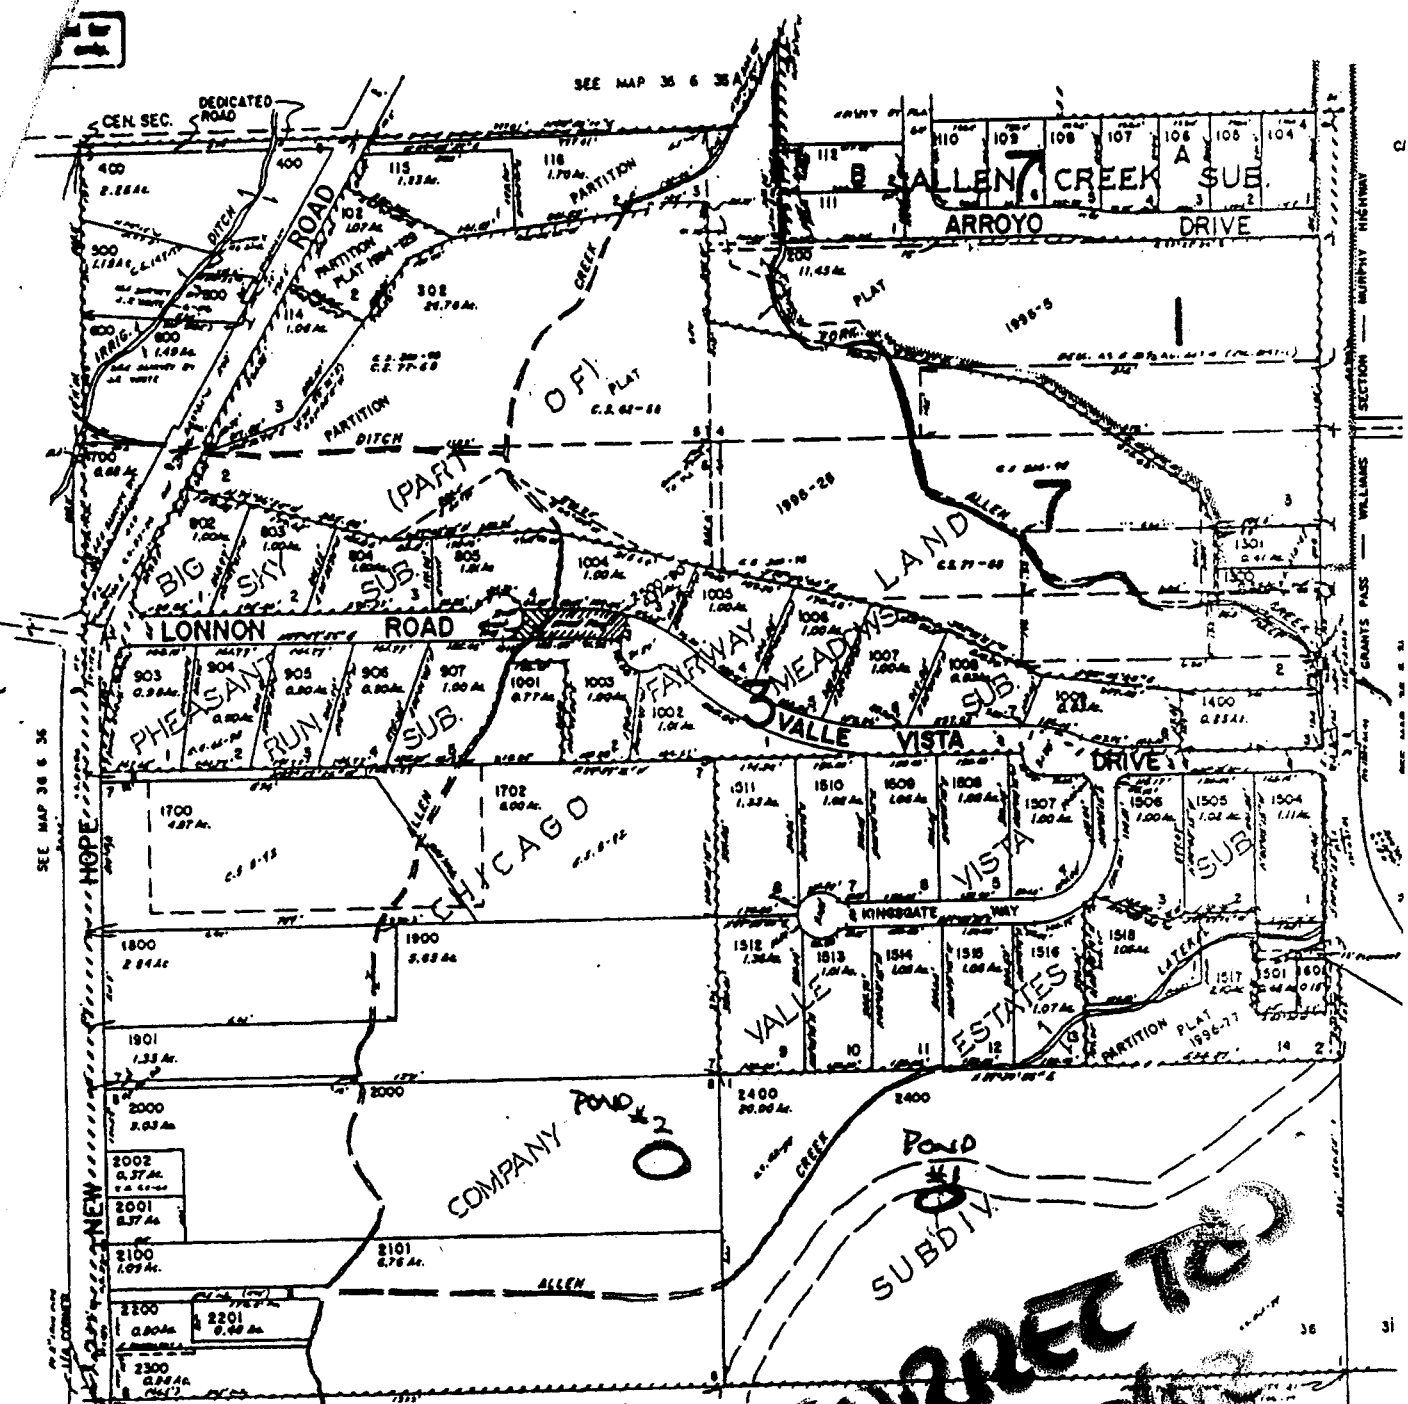

SE 1/4 of
SE 1/4

**CORRECTED
PLAT**

APPLICATION MAP
FOR CLIFF WOODRUFF CONST.

36S 6W 36 DO TL 2000
 POND #1
 400' N BK 1427102
 860' W & ~~1700'~~
 FROM SEC. CORNER
 36 21.6.1

POND #2
 36S 6W 36 DO TL 2400
 500' N BK
 1470' W & ~~1840'~~ 12127102
 FROM SEC CORNER app# R-85390
 36 21.6.1 Permit # R-13643