



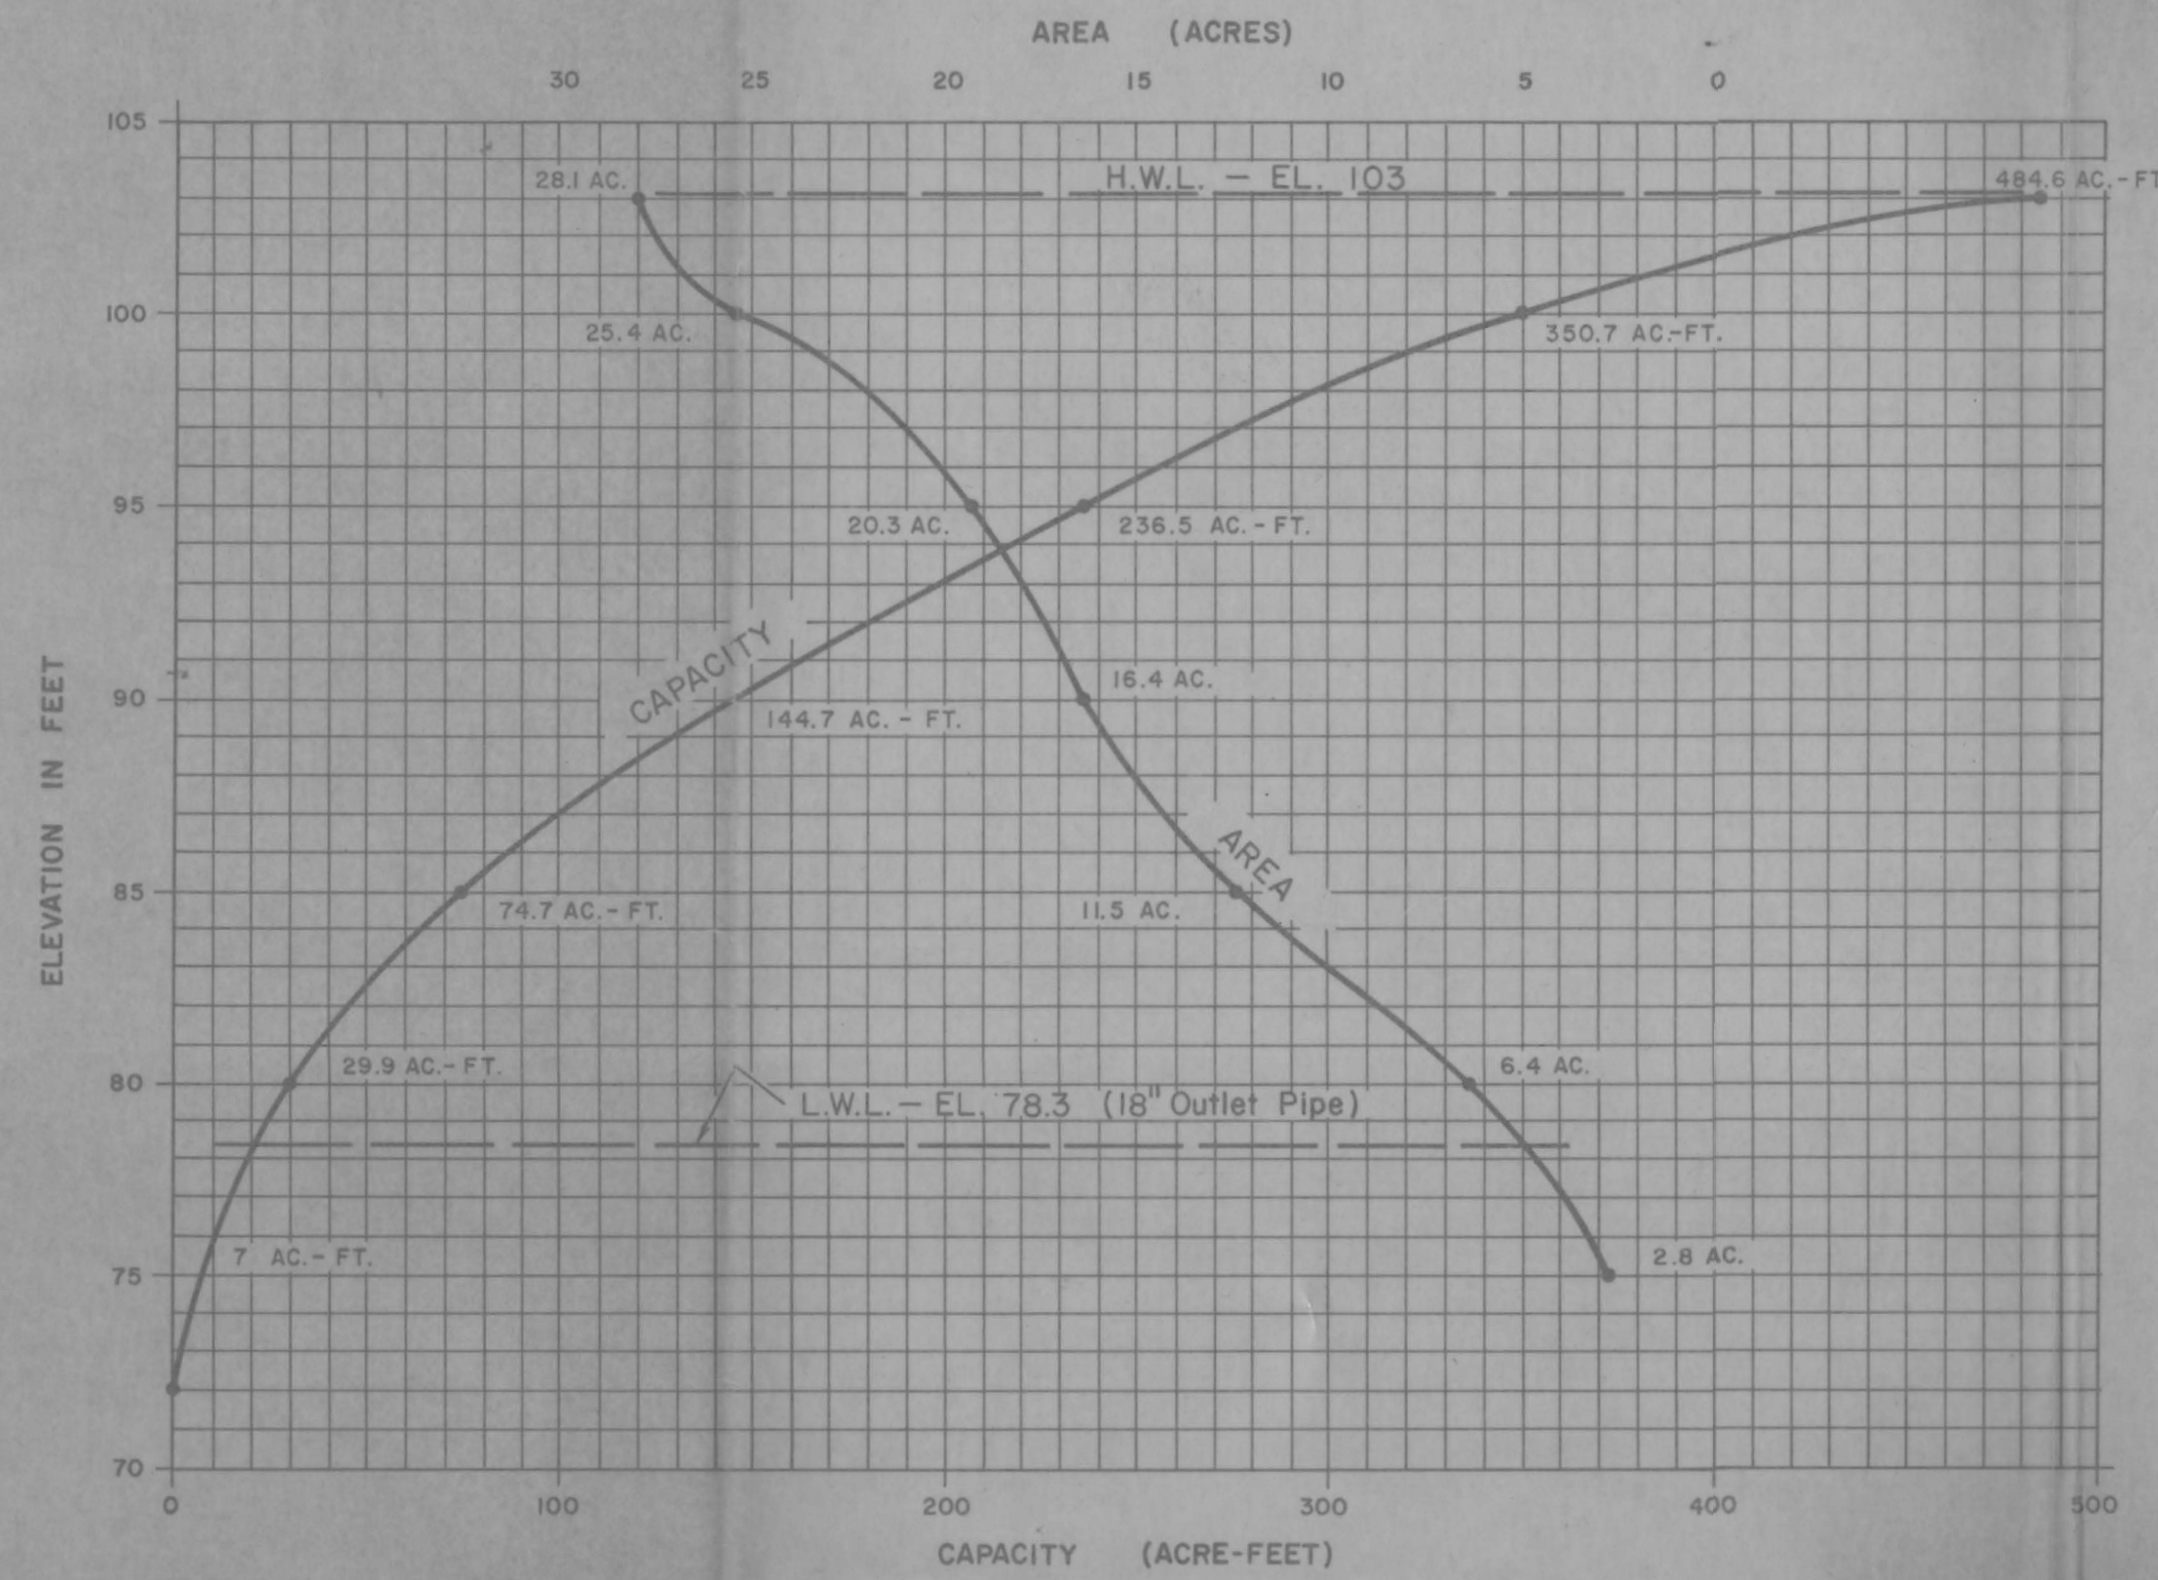


AREA AND CAPACITY CURVES

SPILLWAY PROFILE

SCALE: 1" = 5' VERT.
1" = 100' HOR.

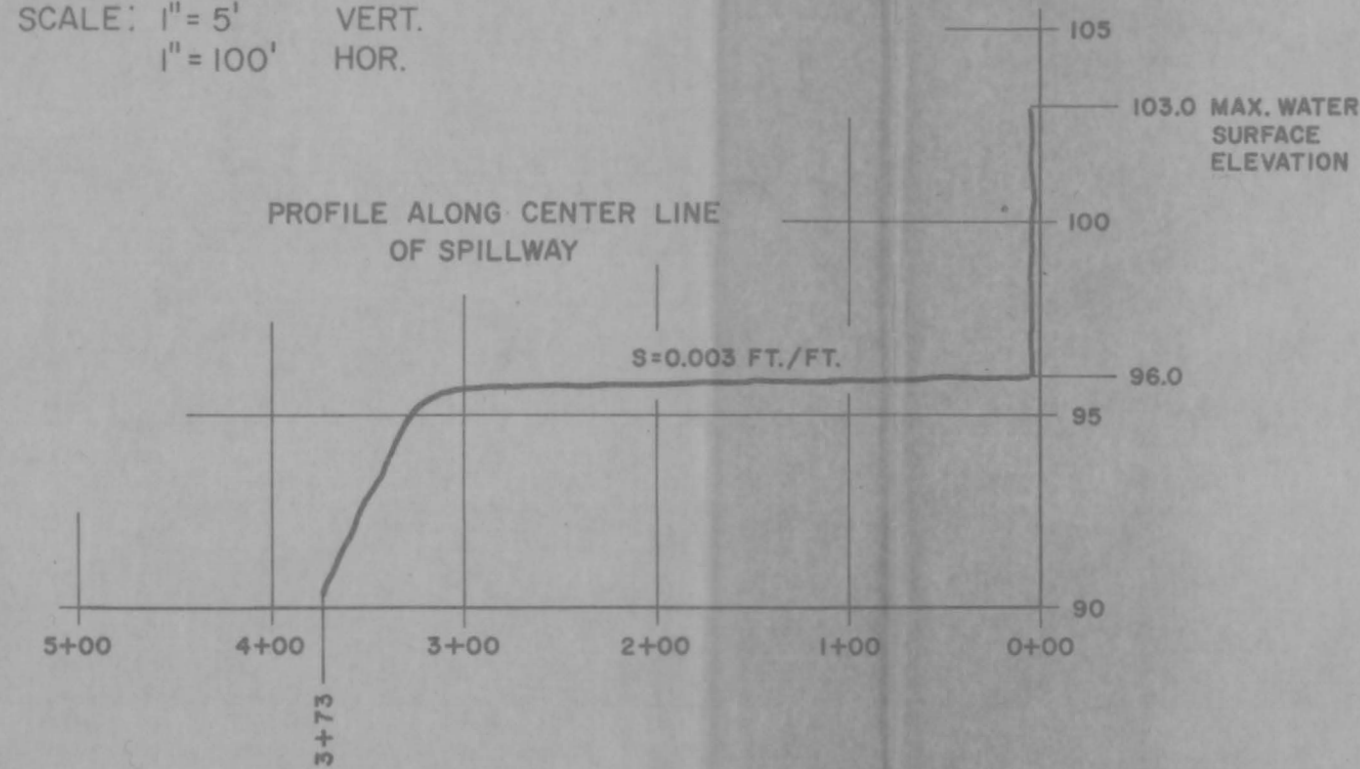


SCALE - 1" = 100'

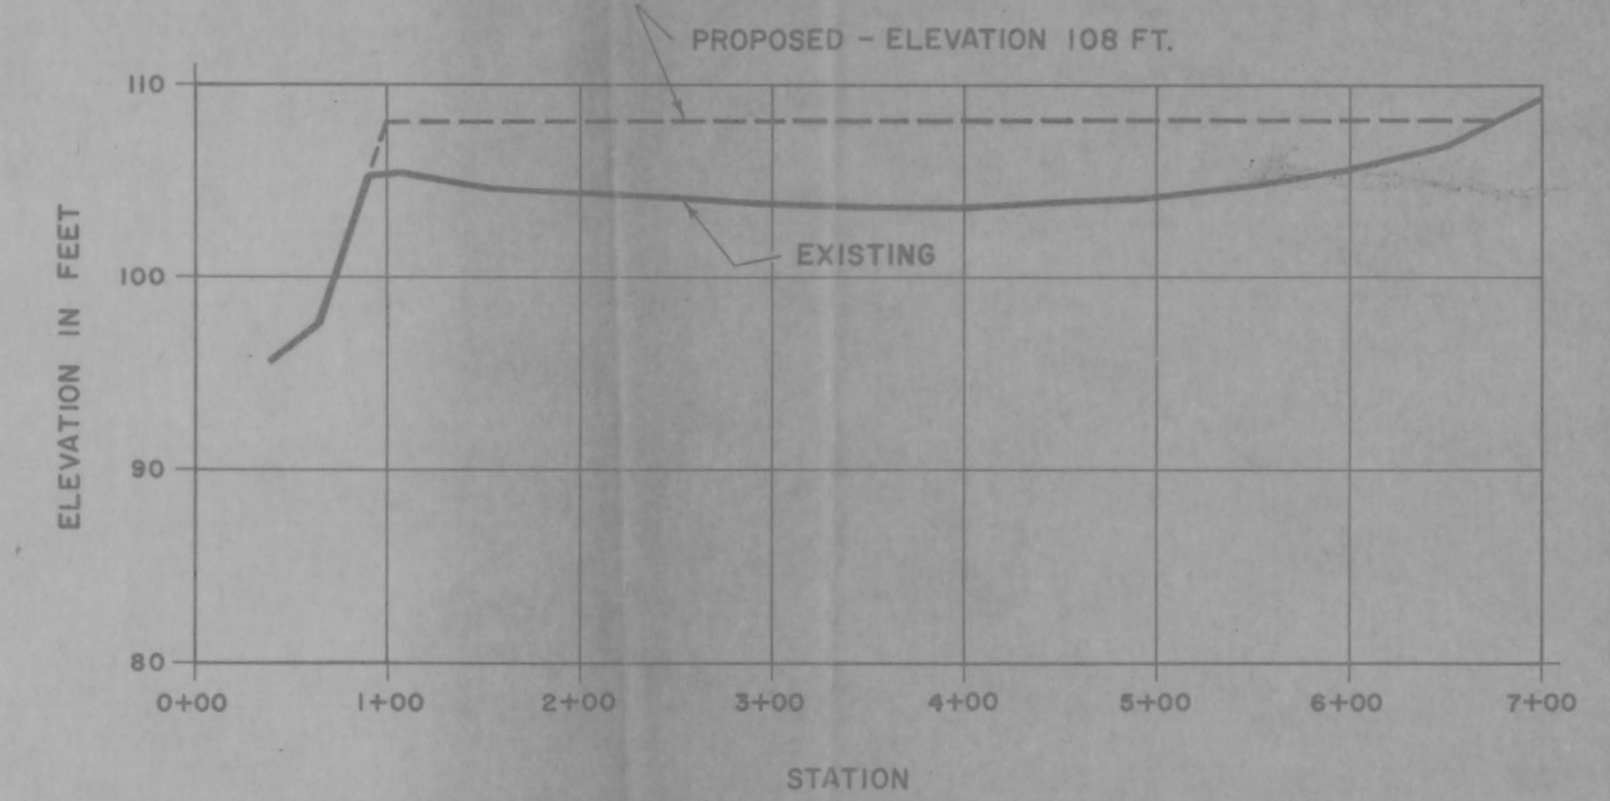

PROFILE OF EXISTING & PROPOSED CREST OF DAM

SCALE: 1" = 10' VERT.
1" = 100' HOR.

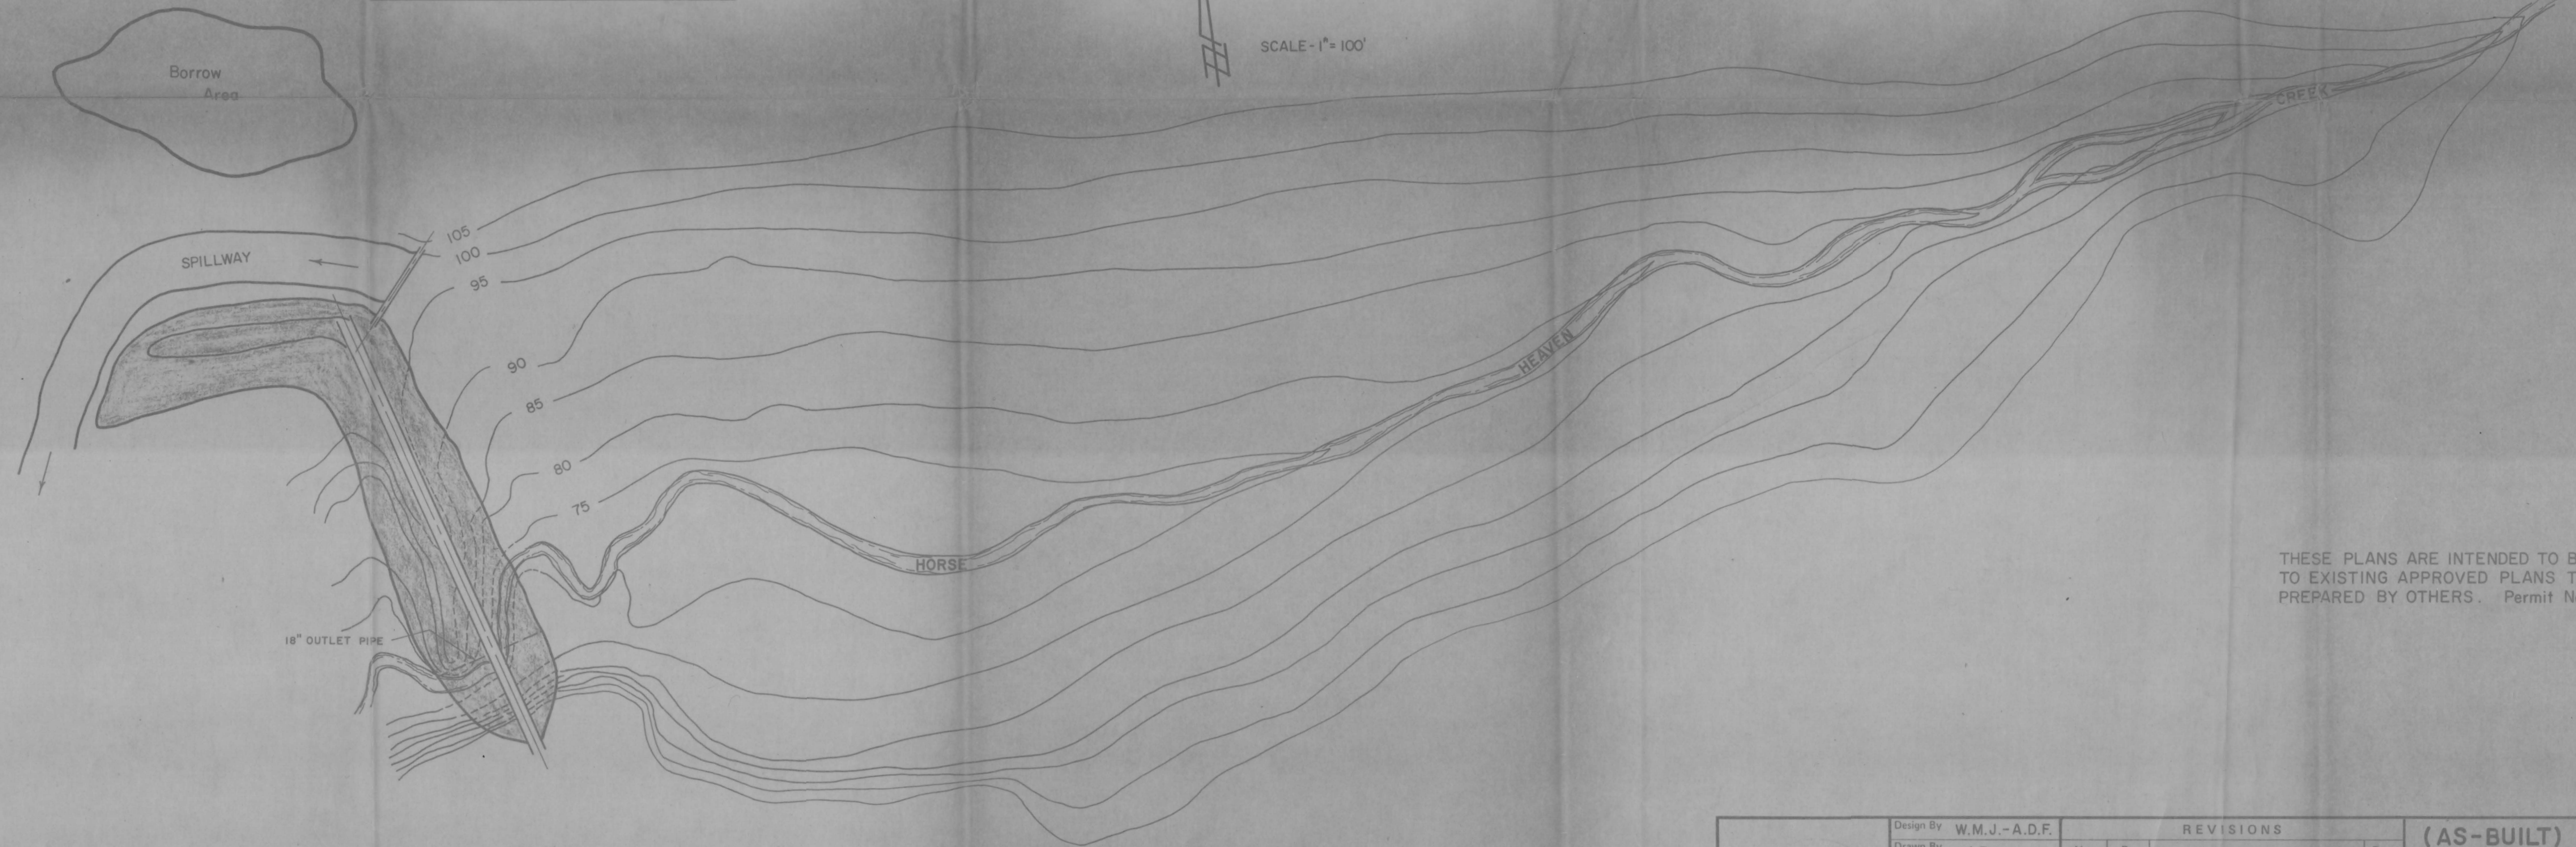

THESE PLANS ARE INTENDED TO BE SUPPLEMENTAL TO EXISTING APPROVED PLANS TO BONNY VIEW DAM PREPARED BY OTHERS. Permit No. R 1130 and 20200

NOTE: INFORMATION FOR TOPOGRAPHICAL MAP OBTAINED FROM MAP PREVIOUSLY SUBMITTED ON JULY 5, 1950 AND APPROVED BY THE WATER RESOURCES DIVISION.

Design By	W.M.J.-A.D.F.	REVISIONS			
Drawn By	J.R.	No.	By	Date	
Checked By	Jm4	①	J.E.	NOTE REVISION	12-1-76
Approved By					
Date	12-1-76				
Scale	AS SHOWN				
Project No.	1262				
Work Order No.	1240				

(AS-BUILT) MODIFICATION OF BONNY VIEW DAM

LOCATED IN SECTION 16, TOWNSHIP 16 SOUTH, RANGE 19 EAST OF THE WILLAMETTE MERIDIAN, CROOK COUNTY, OREGON

for
Bonny View Ranch, Inc.
J.S. Parker - Owner