


# WATER RIGHTS SURVEY

LOCATED IN GOVERNMENT LOTS 2,3, & 4  
A PORTION OF THE NORTH HALF  
OF SECTION 6, TOWNSHIP 25 SOUTH,  
RANGE 11 WEST, W. M.,  
COOS COUNTY, OREGON

SCALE: 1" = 100' APRIL 30, 1976

FOR: RALPH R. THRIFT, SR.,  
BOX 248  
ALLEGANY, OREGON 97407

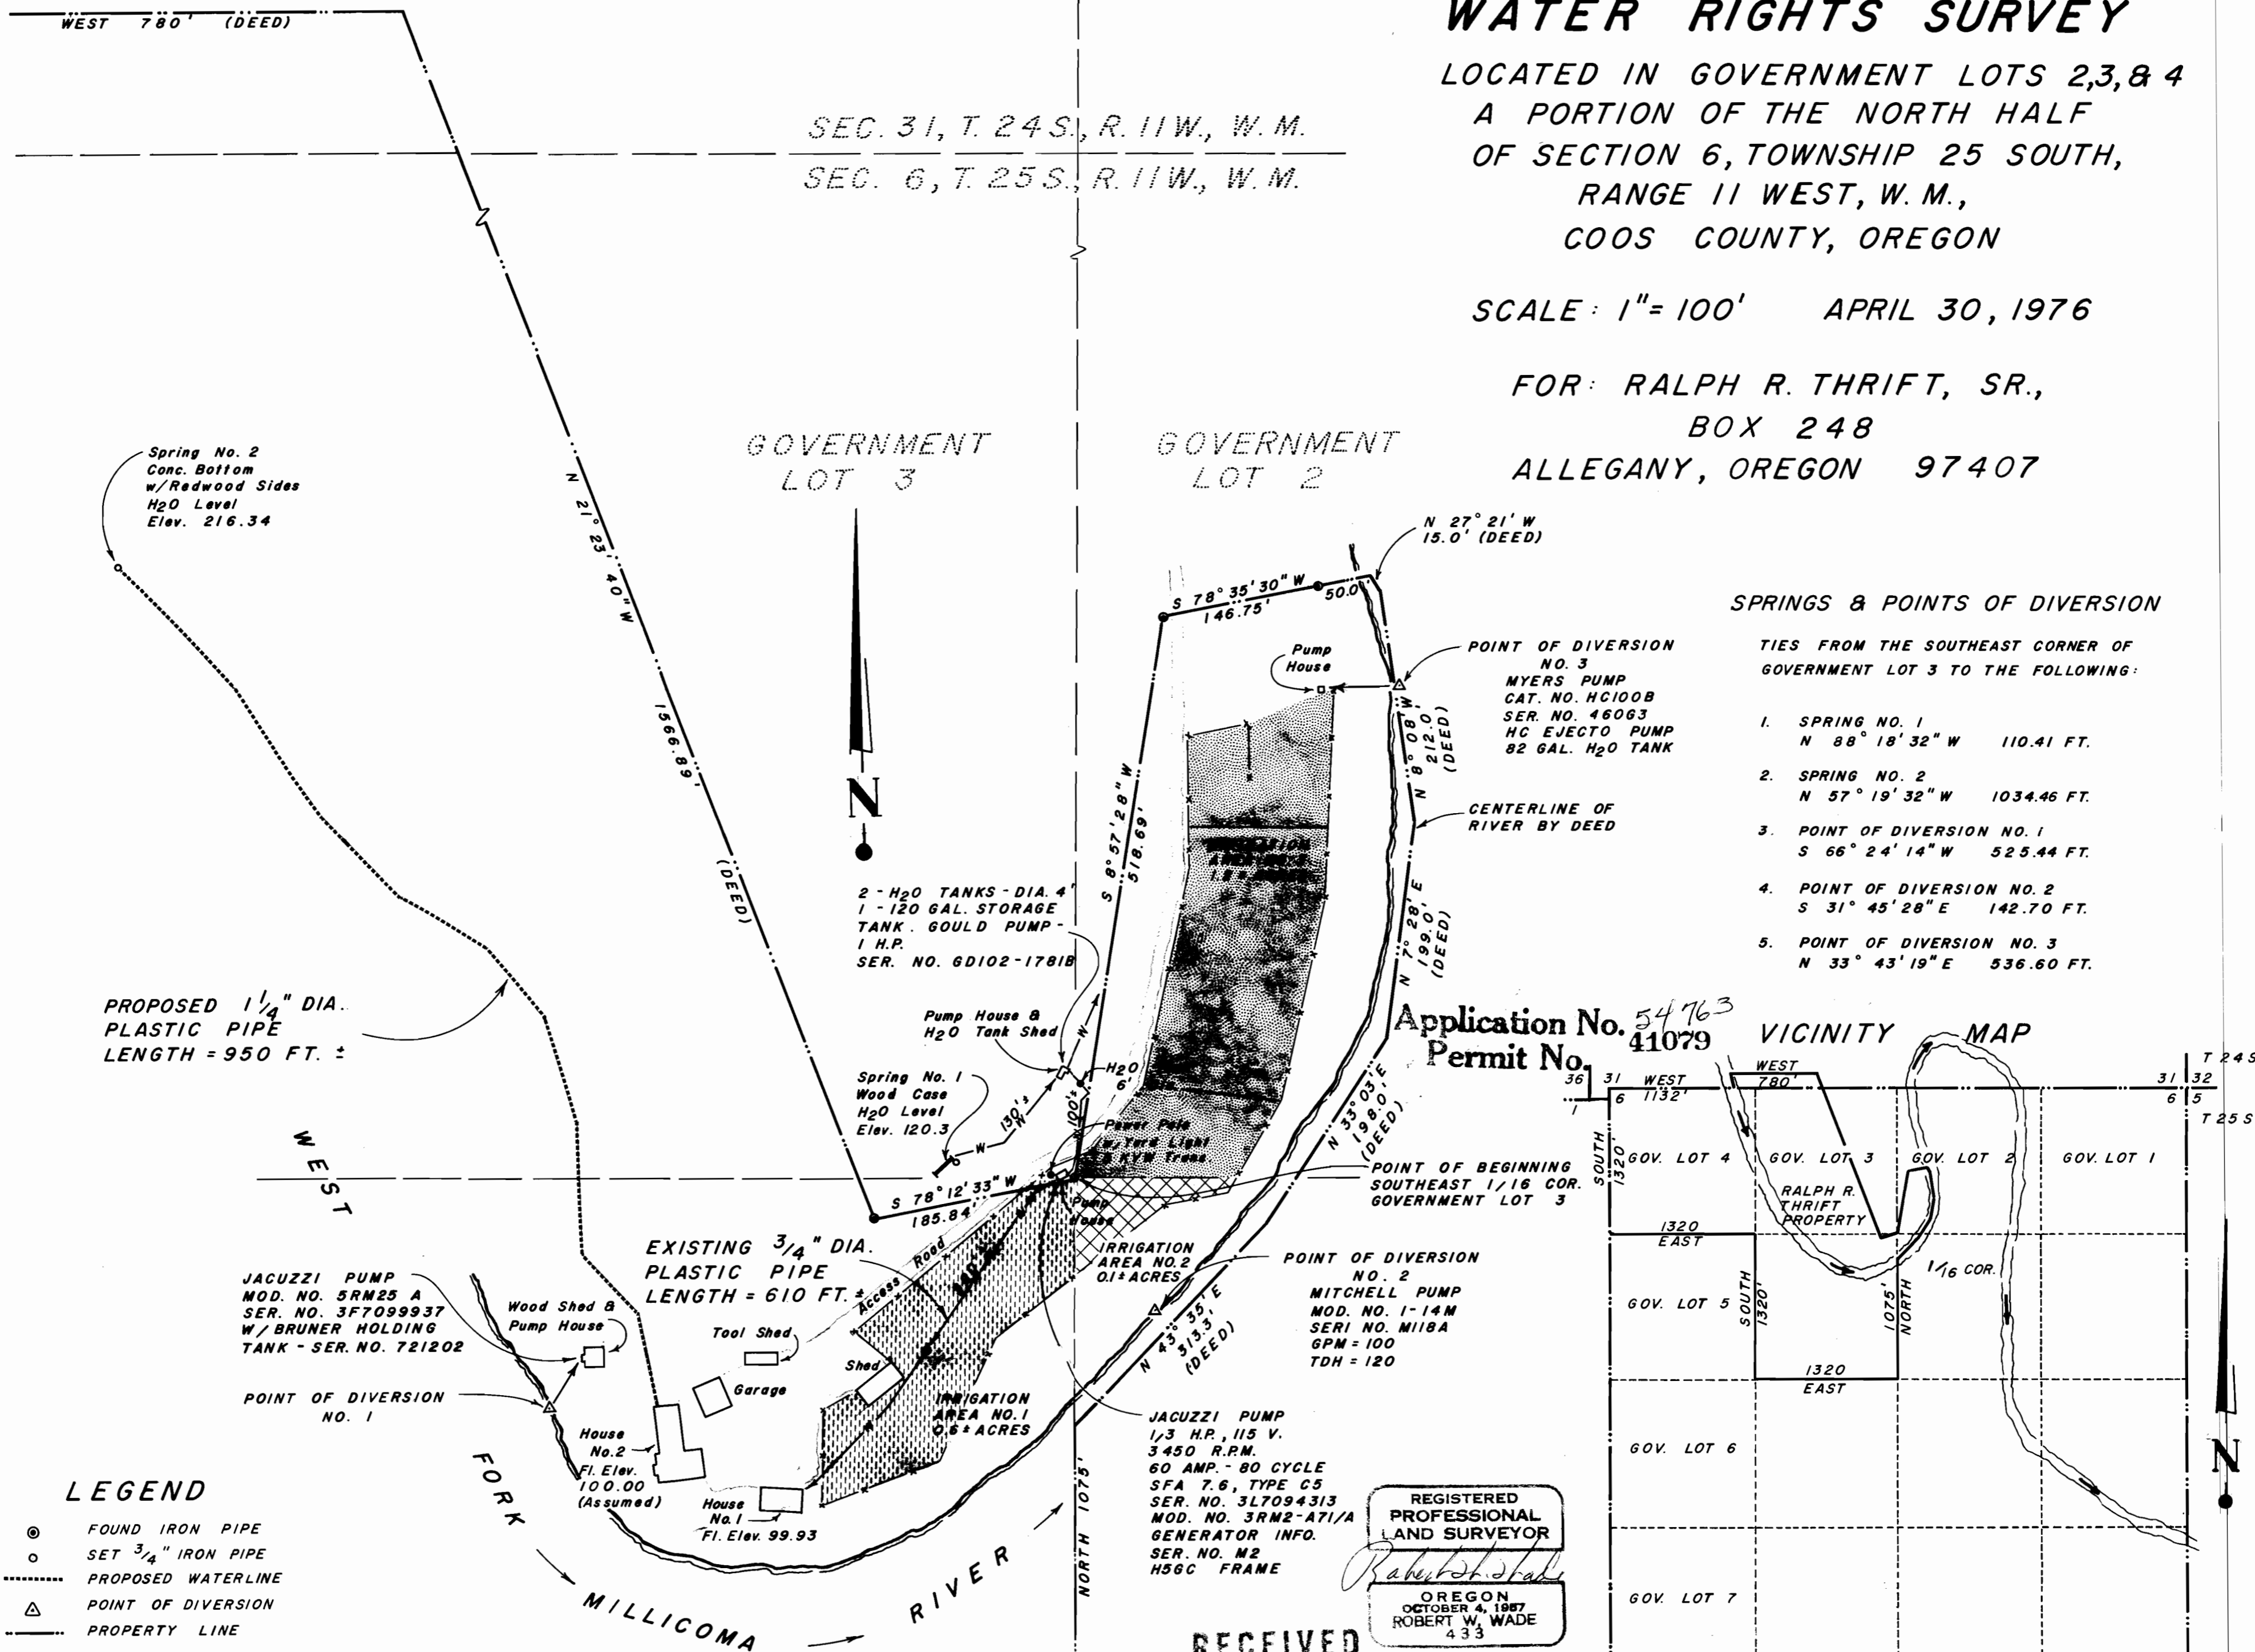


### SPRINGS & POINTS OF DIVERSION

TIES FROM THE SOUTHEAST CORNER OF GOVERNMENT LOT 3 TO THE FOLLOWING:

1. SPRING NO. 1  
N 88° 18' 32" W 110.41 FT.
2. SPRING NO. 2  
N 57° 19' 32" W 1034.46 FT.
3. POINT OF DIVERSION NO. 1  
S 66° 24' 14" W 525.44 FT.
4. POINT OF DIVERSION NO. 2  
S 31° 45' 28" E 142.70 FT.
5. POINT OF DIVERSION NO. 3  
N 33° 43' 19" E 536.60 FT.

Application No. 54763  
Permit No. 41079

### VICINITY MAP

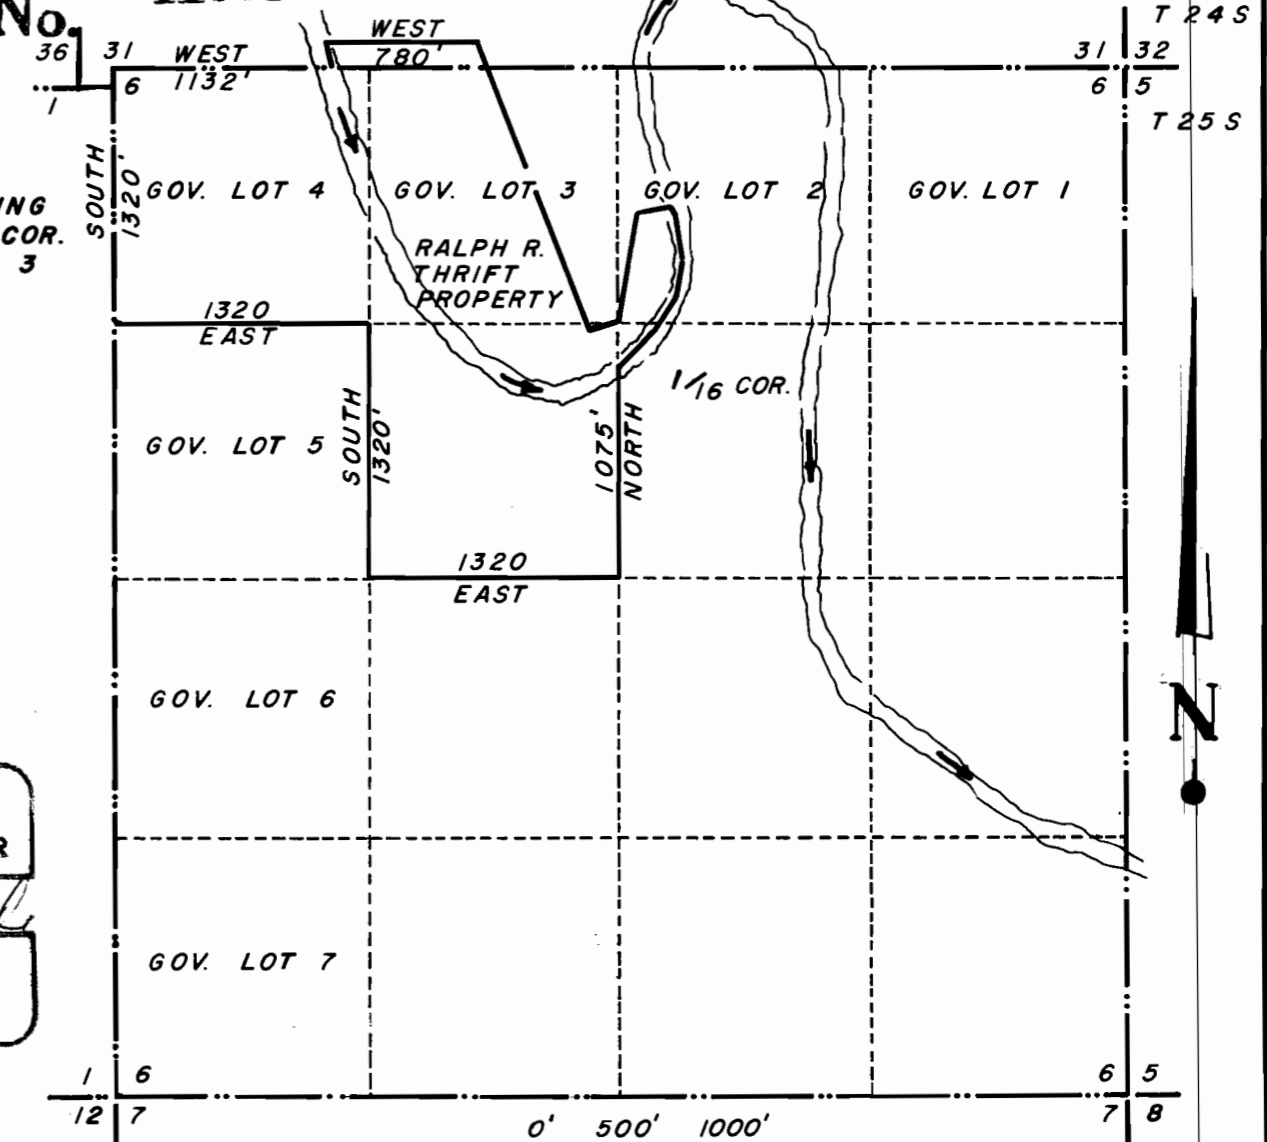

### LEGEND

- FOUND IRON PIPE
- SET 3/4" IRON PIPE
- PROPOSED WATERLINE
- △ POINT OF DIVERSION
- PROPERTY LINE

RECEIVED  
SEP 10 1976

WATER RESOURCES DEPT  
Salem, Oregon

REGISTERED  
PROFESSIONAL  
LAND SURVEYOR

*Robert W. Wade*

OREGON  
OCTOBER 4, 1967  
ROBERT W. WADE  
433