


Sec. 26

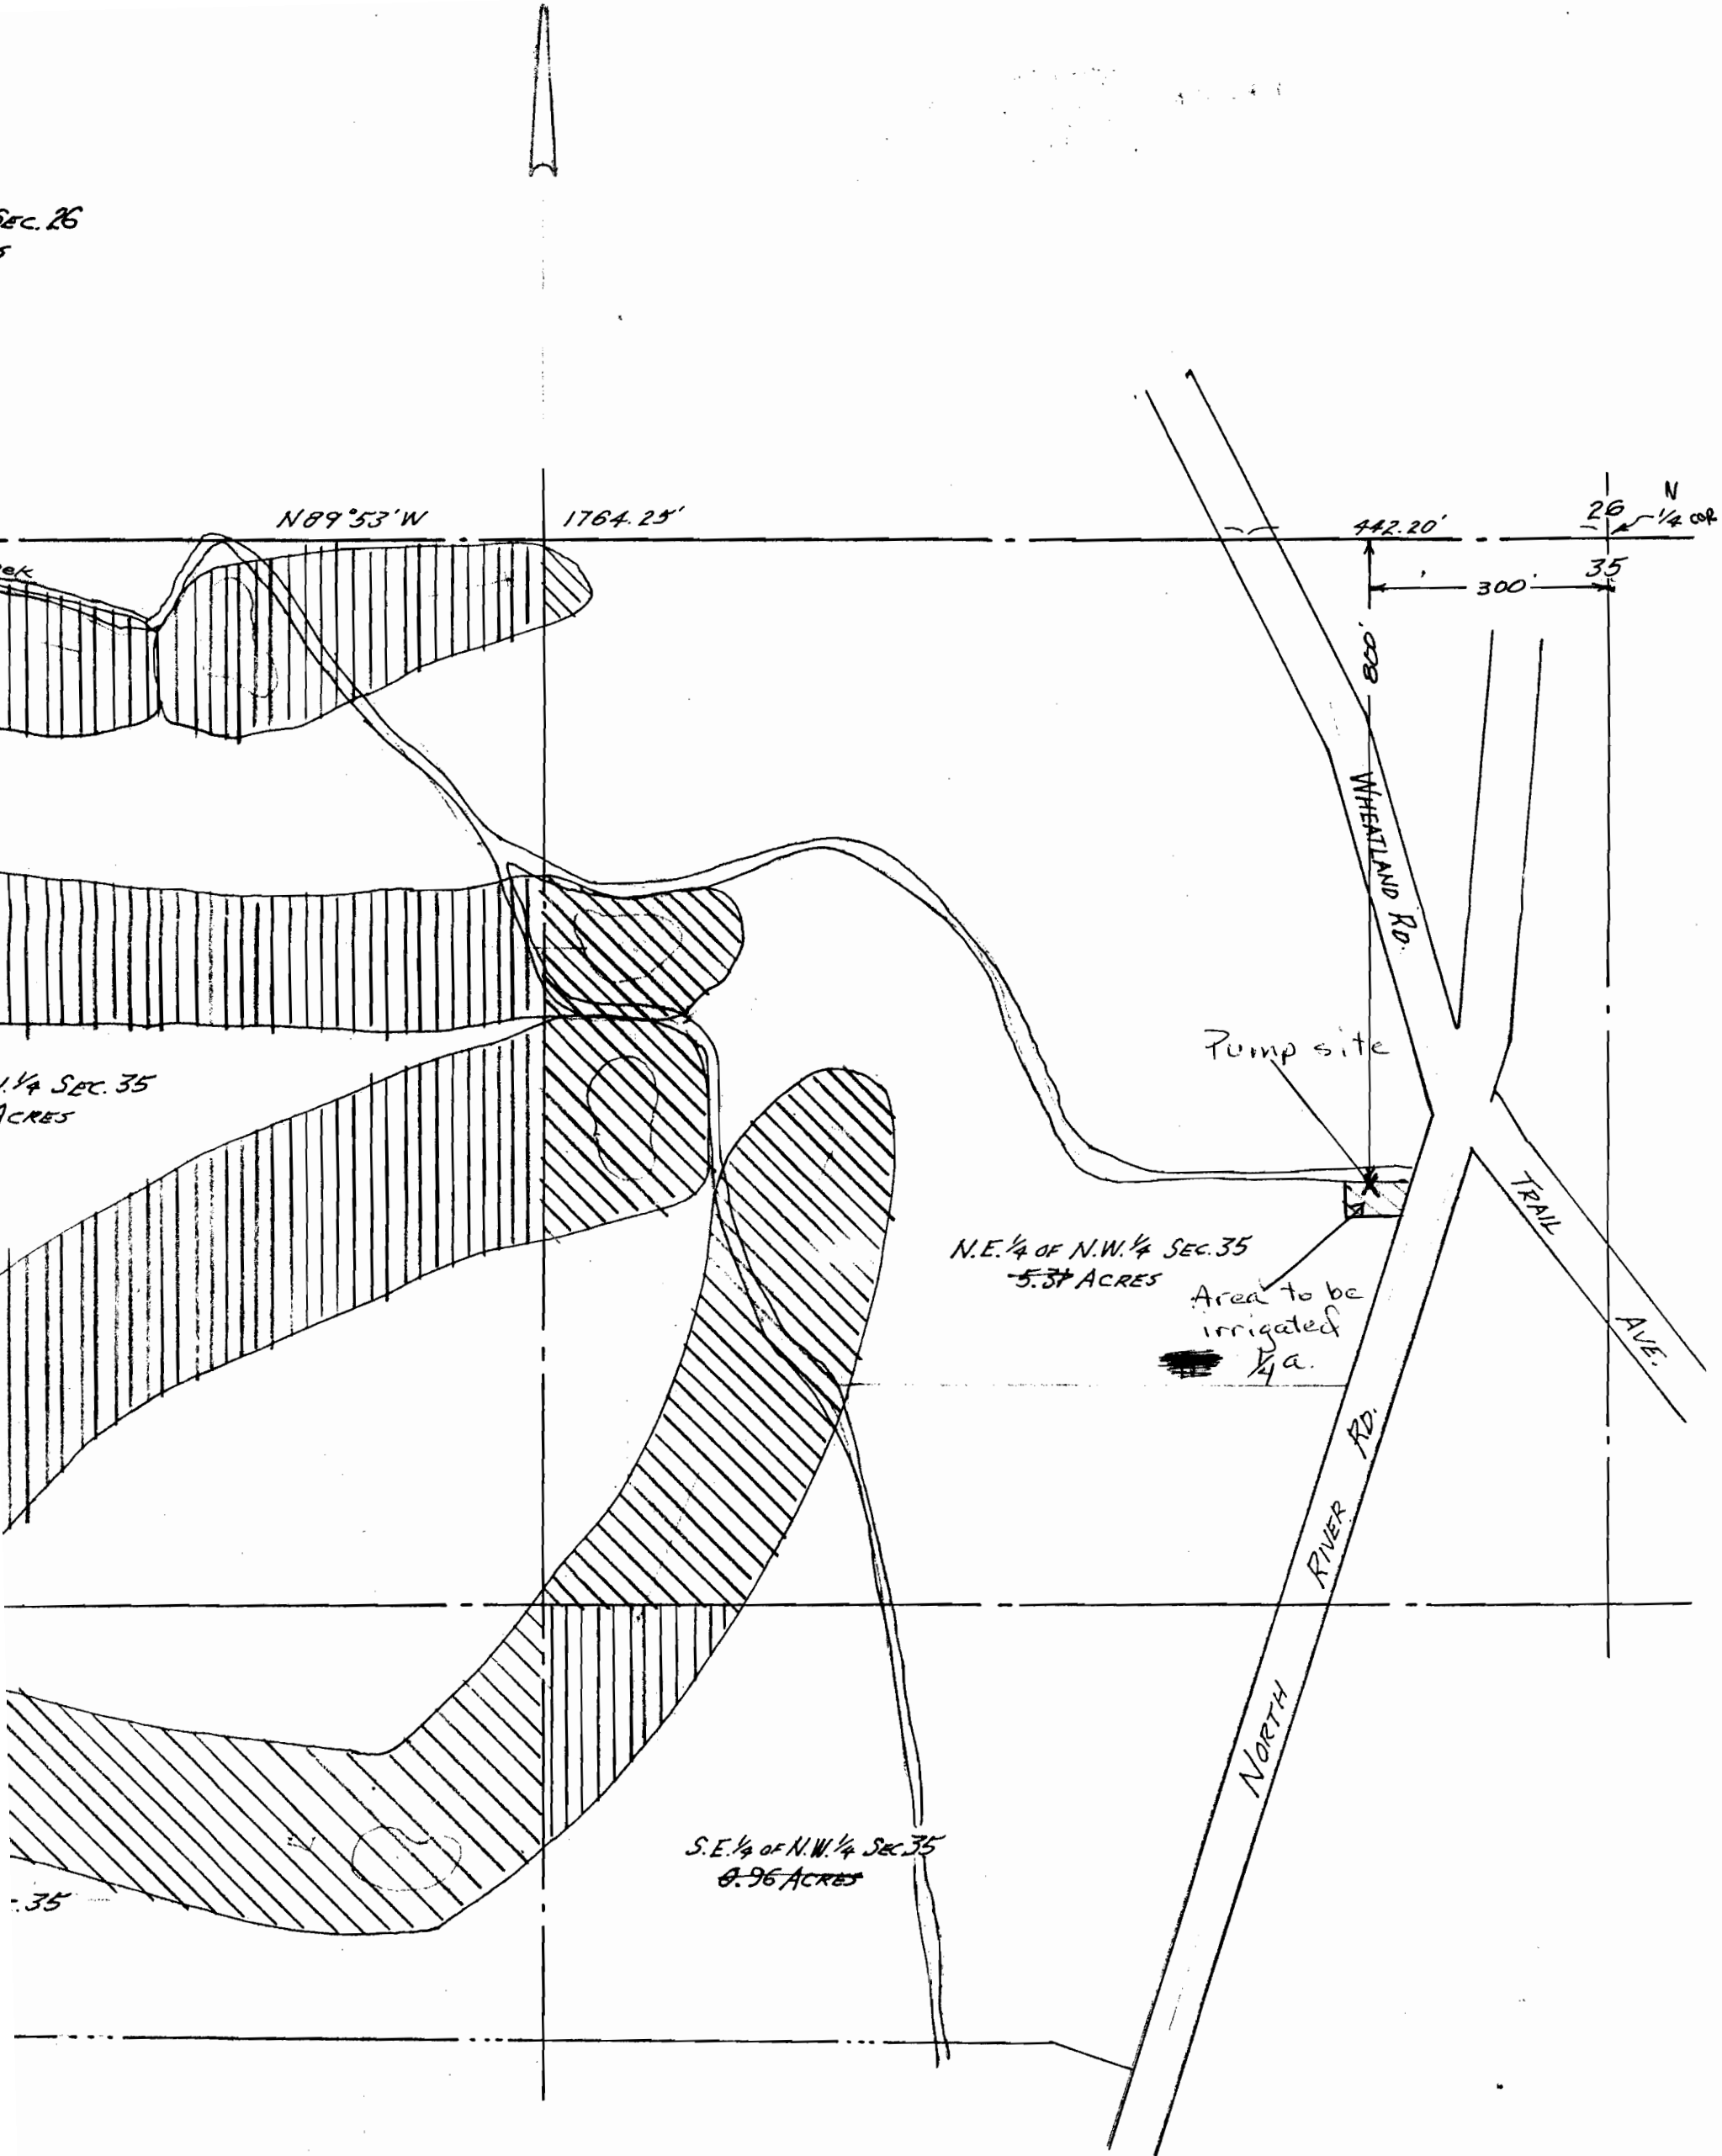

WATER RIGHTS MAP
 FOR IRRIGATION OF McNARY GOLF COURSE
 SECTIONS 26, 27, 34 & 35 T. 6.S., R. 3W. W. M. MARION CO. OREGON
 SCALE: 1" = 200'
 FEB. 22, 1965

Application No. ~~42219~~
 Permit No. ~~36277~~

Application No. 56256
 Permit No. 42219