


Superseded

T.18S.R.2W.W.M.

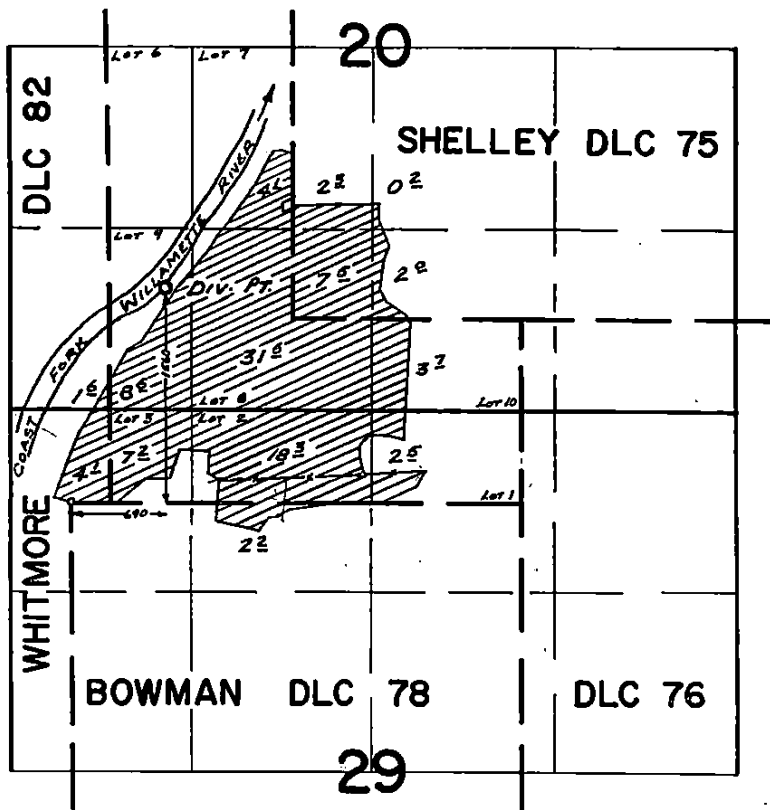

Application No. 84064

Permit No.

FINAL PROOF SURVEY  
UNDER

84064

Application No. ~~84064~~ Permit No. ~~84064~~  
IN NAME OF

STEVE J. HILGER

Surveyed APR. 30, 1969, by W. RUPPERT.

RECEIVED


FEB 10 1999

WATER RESOURCES DEPT.  
SALEM, OREGON

MINOR  
 MAJOR

# partition

lane county


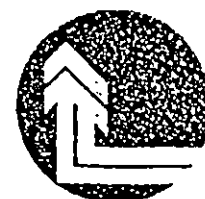


## RECEIVED

FEB 10 1999

Application No. S-8406  
Permit No. 5366

WATER RESOURCES DEPT.  
SALEM, OREGON

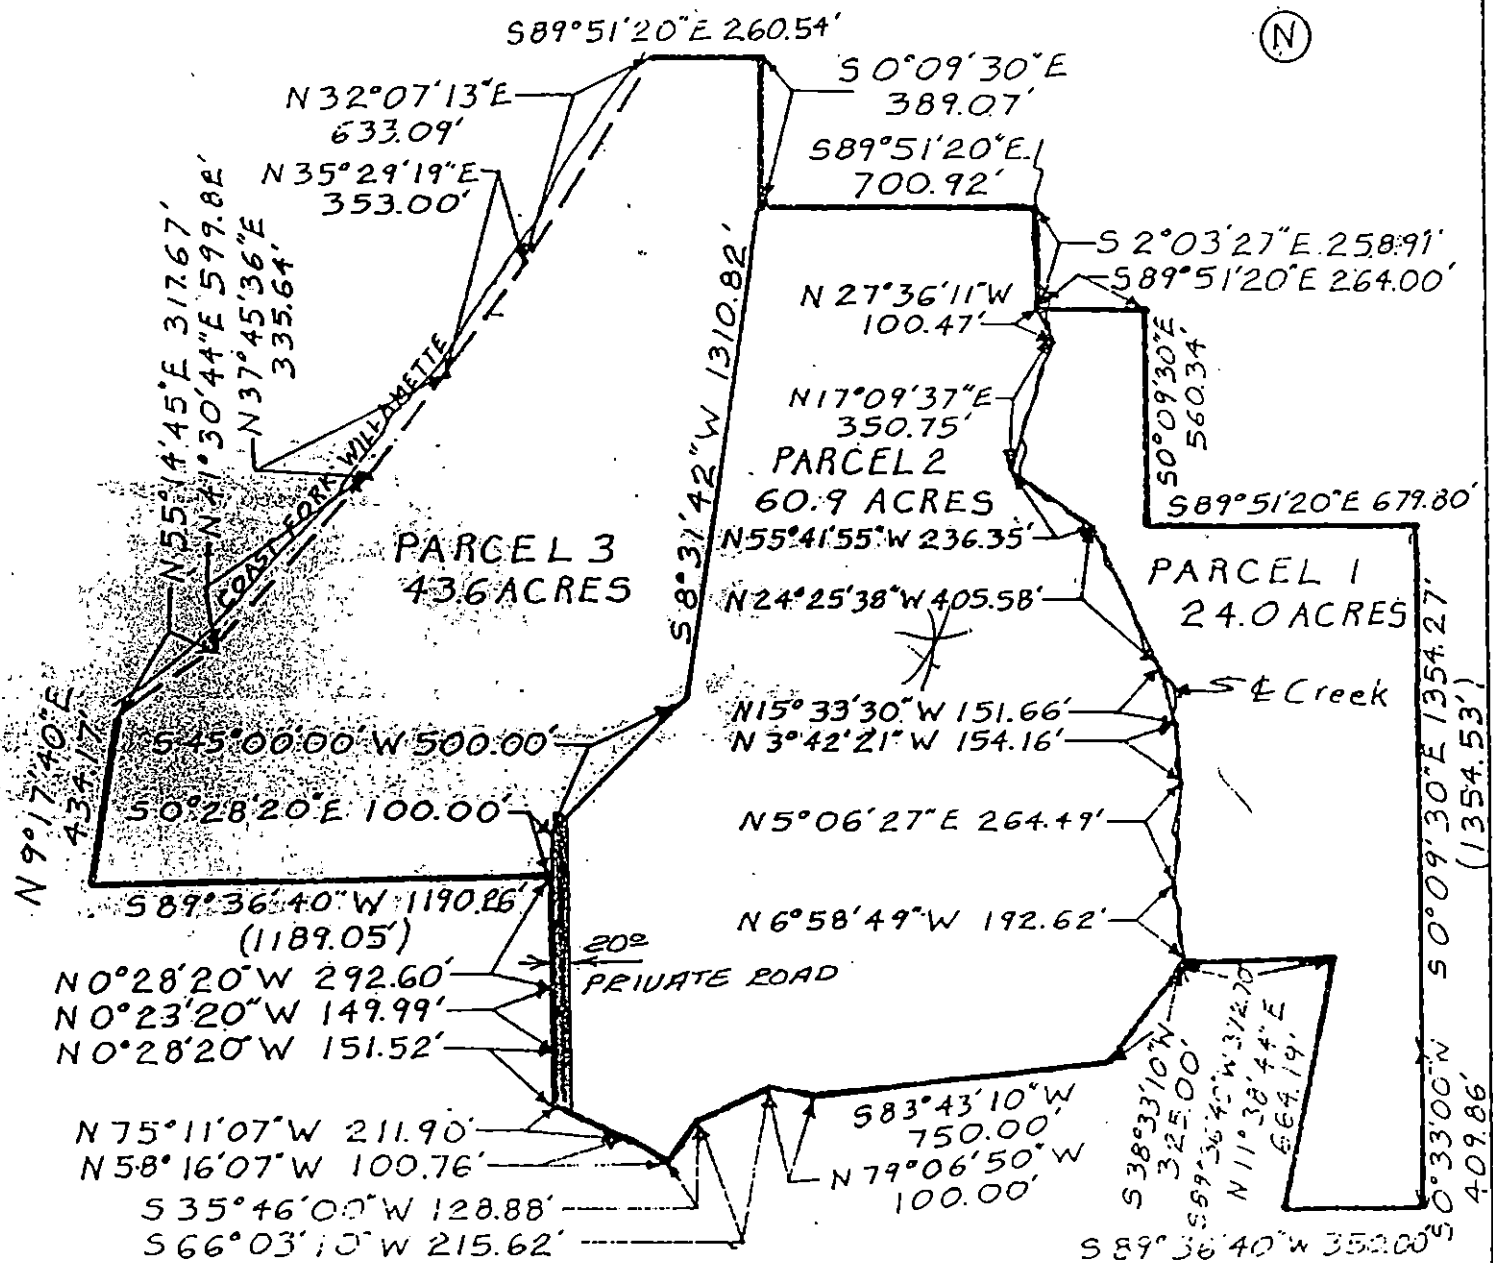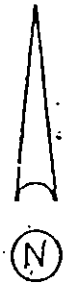

Scale: 1" = 500'

FILE NO.