


~~North 425'~~
~~West 800'~~
 500' from River
 South 425'
 West 800'
 from NW cor DLC 51

T17S, R3W Section 24

3³ ac in SE, NW
 4⁷ ac in NE, SW
 Tax lot 00400
 Tax Map 170324 31

OLD
 POD 90' N & 1015' W from WNW cor DLC 51

S-87674
 PROPOSED POA
 425' S &
 800' W from
 WNW cor DLC 51
 McSilvers 3289 16th, Springfield, OR 97777

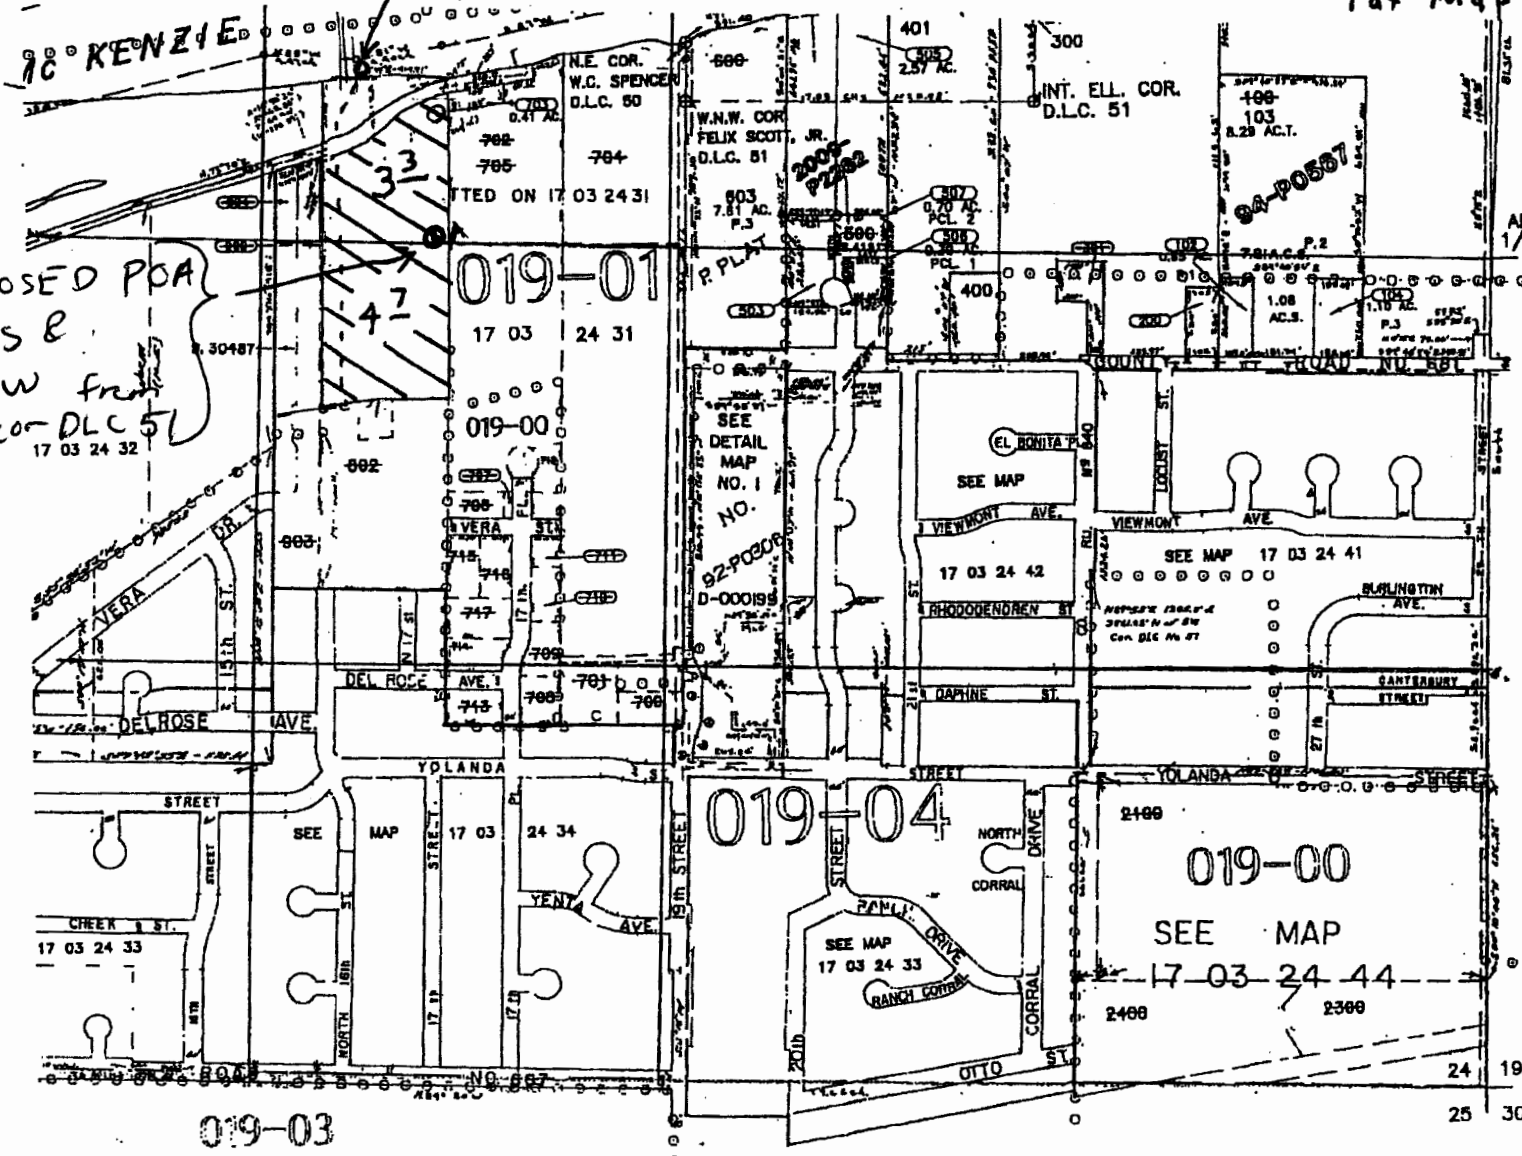

SALEM, OR
 ↑ N ↓
 1" = 600'

RECEIVED BY OWRD

AUG 25 2014

WATER RESOURCES DEPT
 SALEM, OREGON

RECEIVED

JAN 08 2011

12 of 14