




All in Sec 2
 Twp 18 S R 10 W M
 Scale 1 in = 2 ch

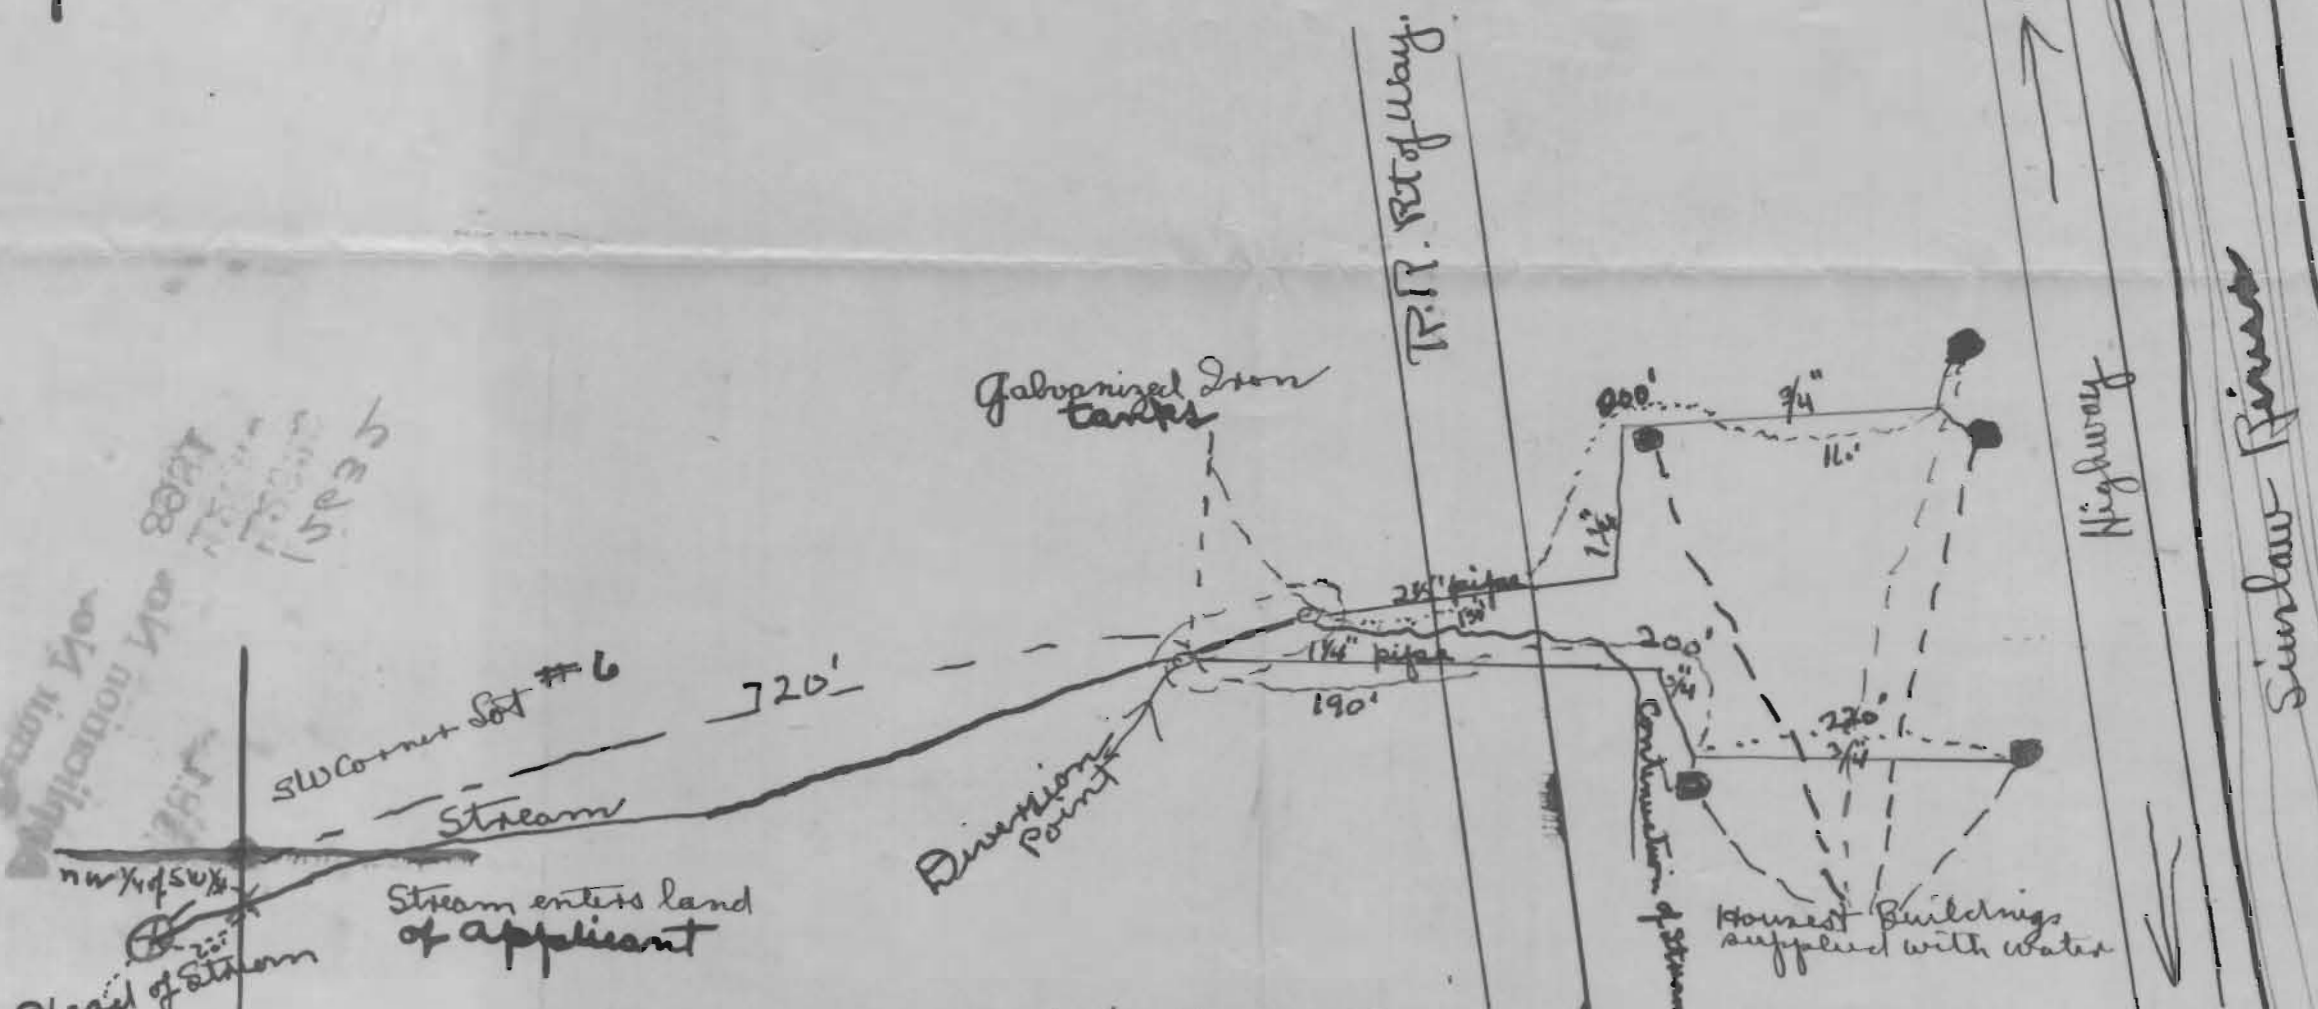

8088
 5.235
 158
 158
 158

Head of Stream is approximately 1 ch. South and 1 ch. West of S.W. Co. of Lot # 6
 Diversion point is approximately 10 ch. North 77° 50' East of

From head of stream to point of diversion is 720 feet
 Stream has no name.

Red lines indicate pipe lines.

R.R. Rty of way

Eugene

Highway

Simlaw River

containing