

STATE ENGINEER
Salem, Oregon

Well Record

STATE WELL NO. 1N/3-34A
COUNTY Multnomah
APPLICATION NO. GR-1589

MULT
001426

GR- 1537

OWNER: City of Wood Village


MAILING ADDRESS: Wood Village City Hall

LOCATION OF WELL: Owner's No. _____

CITY AND STATE: Troutdale, Oregon

NE 1/4 NE 1/4 Sec. 34 T. 1 N. R. 3 E. W.M.

Bearing and distance from section or subdivision corner 1225' W. & 580' S. from NE cor. Sec. 24

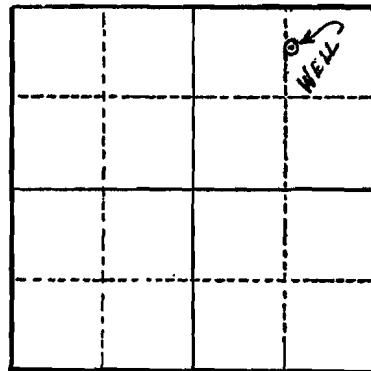

Altitude at well 168'

Section 34

TYPE OF WELL: Drilled Date Constructed 1942

Depth drilled 360' Depth cased 355'

CASING RECORD:

- 10" from 0 to 170 ft.
- 8" from 170 to 355 ft.

FINISH:

- Perforated from: 170 to 180 ft.
- 284 to 294 ft.
- 340 to 355 ft.

AQUIFERS:

WATER LEVEL:

65'

PUMPING EQUIPMENT: Type Pomona deep well turbine H.P. 20
Capacity 200 G.P.M.

WELL TESTS:

Drawdown 100 ft. after _____ hours 200 G.P.M.

Drawdown _____ ft. after _____ hours _____ G.P.M.

USE OF WATER Municipal Temp. _____ °F. _____, 19____

SOURCE OF INFORMATION GR Record

DRILLER or DIGGER R. J. Strasser

ADDITIONAL DATA:

Log _____ Water Level Measurements _____ Chemical Analysis _____ Aquifer Test _____

REMARKS:

- Log: Top soil 0 to 15 ft.
- Gravel & boulders 15 to 40 ft.
- Boulders 40 to 83 ft.
- Cemented gravel 83 to 103 ft.
- Cemented gravel 103 to 290 ft.
- Loose gravel 290 to 294 ft.
- Sandstone 294 to 330 ft.
- Gray sandstone 330 to 350 ft.
- Sandstone 350 to 360 ft. State Printing 88318

RECEIVED BY OWRD

JUN 13 2013

1011617 SALEM, OR

A first copy of this report
is filed with the
SOURCES DEPARTMENT,
SALEM, OREGON 97310
within 30 days of the date
of well completion.

S & M DRILLING CANBY
WATER WELL REPORT
MAR 1980
STATE OF OREGON
(Please type or print)
(Do not write above this line)

WOODVILLE WELL
State Well No. _____
State Permit No. _____

See Correspondence from S & M Drilling

OWNER:
Name City of Wood Village
Address Multnomah County, Oregon

(2) TYPE OF WORK (check):
New Well Deepening Reconditioning Abandon
If abandonment, describe material and procedure in Item 12.

(3) TYPE OF WELL: Rotary Driven
Cable Jetted
Aug Bored
(4) PROPOSED USE (check): Domestic Industrial Municipal
Irrigation Test Well Other

(5) CASING INSTALLED: Threaded Welded
12" Diam. from 0 ft. to 200 ft. Gage 375
" Diam. from " ft. to " ft. Gage "
" Diam. from " ft. to " ft. Gage "

(6) PERFORATIONS: Perforated? Yes No.
Type of perforator used _____
Size of perforations in. by in.
perforations from " ft. to " ft.
perforations from " ft. to " ft.
perforations from " ft. to " ft.

SCREENS: Well screen installed? Yes No
Manufacturer's Name JOHNSON
Type stainless steel Model No. _____
Diam. 1 1/2 Slot size .250 Set from 200 ft. to 230 ft.
Diam. 1 1/2 Slot size .250 Set from 245 ft. to 255 ft.
2 1/2 Slot size .250 Set from 270 ft. to 280 ft.

(7) WELL TESTS: Drawdown is amount water level is lowered below static level.
Was a pump test made? Yes No If yes, by whom? Aqua Pump
Field: 250 gal./min. with 20 ft. drawdown after 1/2 hrs.
" 350 " " 26 " " 1/2 " "
" 500 " " 51 " " 24 hrs.
Flow test gal./min. with " ft. drawdown after hrs.
Artesian flow r.p.m.
Temperature of water Depth artesian flow encountered ft.

(8) CONSTRUCTION: Well seal—Material used cement
Well sealed from land surface to 22 inch 25 feet ft.
Diameter of well bore to bottom of seal 12 inch 25 feet ft. & 16 in
Diameter of well bore below seal 12 in.
Number of sacks of cement used in well seal 56 sacks
How was cement grout placed? pressure pumped

Drive shoe used? Yes No Plugs _____ Size: location _____ ft.
Do any strata contain unusable water? Yes No
Type of water? _____ depth of strata 011617
Method of sealing strata off _____
Is well gravel packed? Yes No Size of gravel: _____

(10) LOCATION OF WELL:
County Multnomah Driller's well number D 260-80
N E 1/4 S E 1/4 Section 27 T.15 R.3E W.X
Bearing and distance from section or subdivision corner.
1510 feet N. 1290 feet W of SE corner

(11) WATER LEVEL: Completed well
Depth at which water was first found 15 ft.
Static level 98 ft. below land surface. Date 4/8/80
Artesian pressure lbs. per square inch. Date _____

(12) WELL LOG: Diameter of well below casing 12
Depth drilled 300 ft. Depth of completed well 300 ft.
Formation: Describe color, texture, grain size and structure of materials; and show thickness and nature of each stratum and aquifer penetrated, with at least one entry for each change of formation. Report each change in position of Static Water Level and indicate principal water-bearing strata.

MATERIAL	From	To	SWL
topsoil	0	2	
clay brown & sandy	2	14	
gravel water bearing	14	16	
gravel cemented	16	28	
gravel, sand boulders	28	60	
gravel & sand cemented	60	110	
sand & gravel	110	135	
gravel & sand water/r	135	230	
sand brown water bearing	230	245	
gravel & sand water/r	245	257	
sand brown fine	257	270	
claystone gray water/r	270	285	
clay gray	285	300	

Work started 1/3/80 19 _____ Completed 3/28/80 19 _____
Date well drilling machine moved off of well 4/8/80 19 _____

Drilling Machine Operator's Certification:
This well was constructed under my direct supervision. Materials used and information reported above are true to my best knowledge and belief.
[Signed] W. J. [Signature] Date 4/8/80 19 _____
(Drilling Machine Operator) License No. 1306

Water Well Contractor's Certification:
This well was drilled under my jurisdiction and this report is true to the best of my knowledge and belief.
Name S & M Drilling & Supply Inc.
(Person, firm or corporation) (Type or print)
Address 399 S E Walnut Canby, Ore 97013
[Signed] W. J. [Signature]
(Water Well Contractor)


JUN 13 2013
SALEM, OR

RECEIVED BY OWRD

JUN 13 2013

WELL #2

SALEM, OR

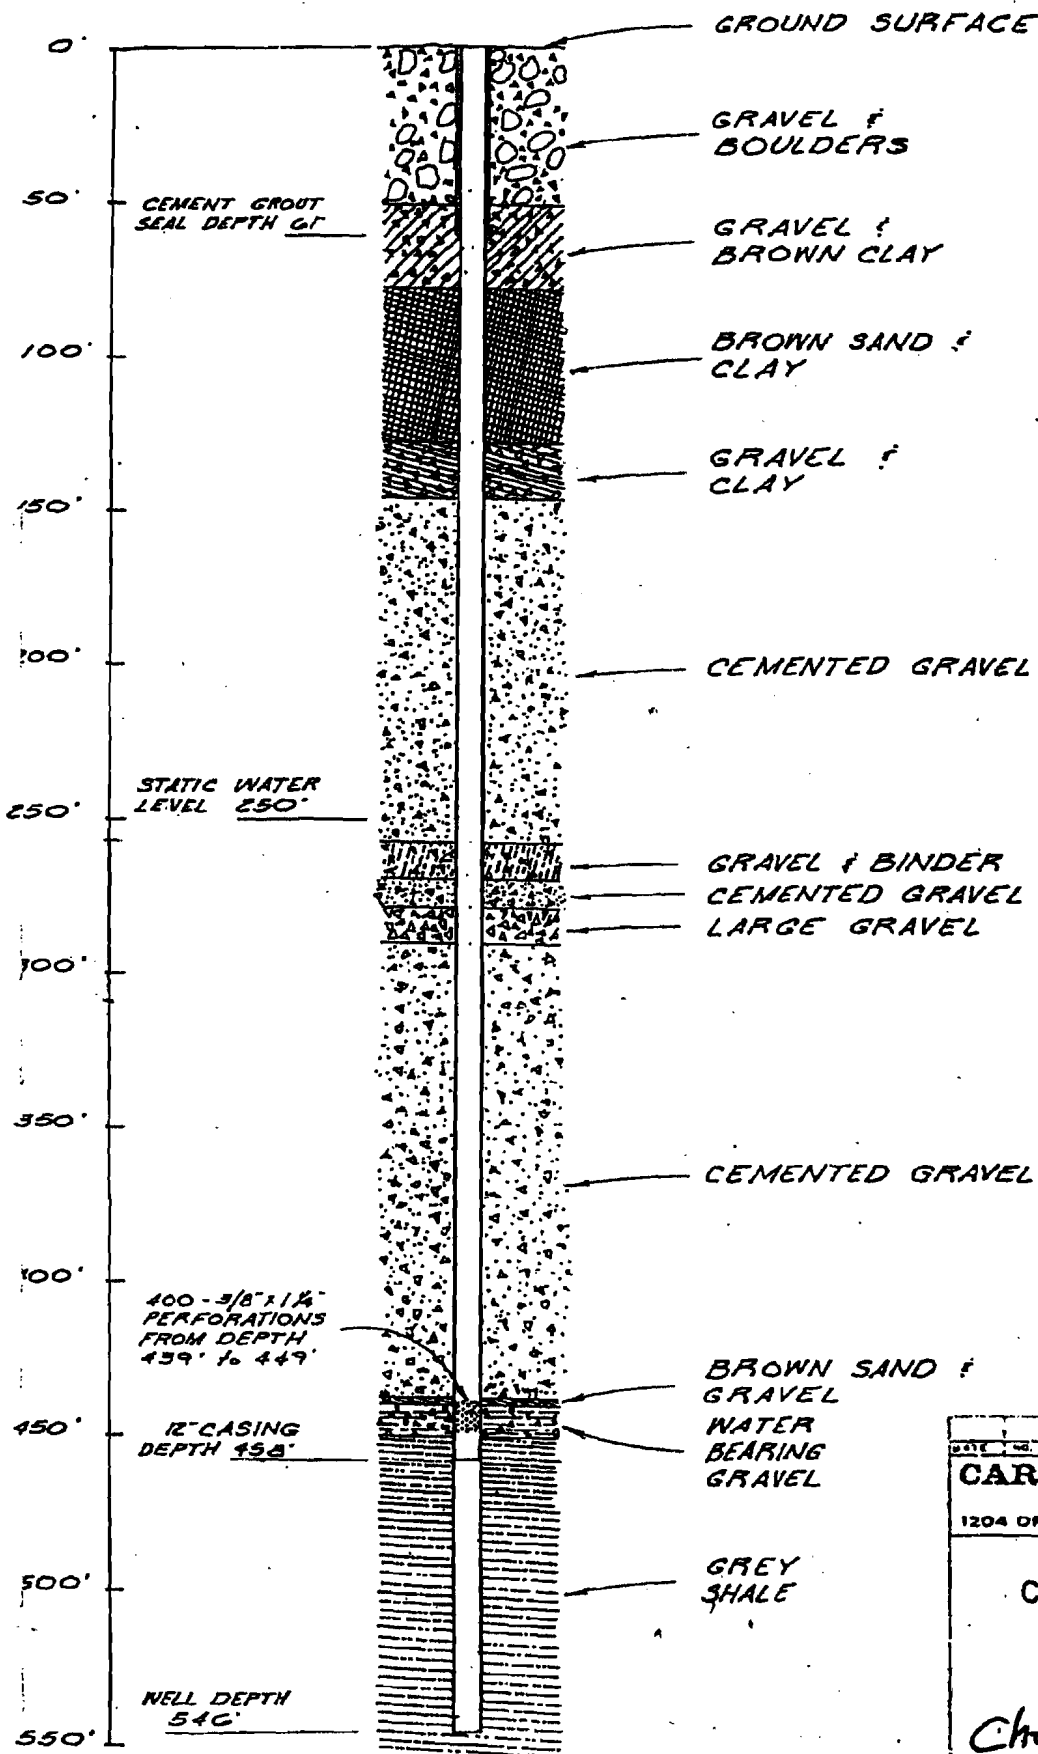

100 - 3/8" x 1 1/4" PERFORATIONS FROM DEPTH 439' to 449'

12" CASING DEPTH 454'

WELL DEPTH 546'

T011617

DATE	NO.	REVISION
CARTER, BRINGLE & ASSOC. CONSULTING ENGINEERS 1204 OREGON BANK BLDG. PORTLAND, OREGON		
CITY OF WOOD VILLAGE		
WELL No. 2 LOG <i>Cherry Park Road</i>		
DESIGNED BY	APPROVED BY	DATE
Checked H. P.	SCALE 1" = 60' Vertical	
DRAWN BY	DATE Feb. 1970	NO. 940235

NOTICE TO WATER WELL CONTRACTOR

The original and first copy of this report are to be filed with the

STATE ENGINEER, SALEM, OREGON within 30 days from the date of well completion.

RECEIVED
 FEB 5 1970
 STATE ENGINEER
 SALEM, OREGON

WATER WELL REPORT
 (Please type or print)
 Do not write above this line

MULT
001431

State Well No. 1N/3-356d
 State Permit No. _____

(1) OWNER:

Name CITY OF WOOD VILLAGE
 Address 2055 NE 238TH DR. TROUTDALE, ORE.

(2) TYPE OF WORK (check):

New Well Deepening Reconditioning Abandon
 If abandonment, describe material and procedure in Item 12.

(3) TYPE OF WELL:

Rotary Driven
 Cable Jetted
 Dug Bored

(4) PROPOSED USE (check):

Domestic Industrial Municipal
 Irrigation Test Well Other

CASING INSTALLED:

Threaded Welded
12" Diam. from 0 ft. to 458 ft. Gage 330
 " Diam. from _____ ft. to _____ ft. Gage _____
 " Diam. from _____ ft. to _____ ft. Gage _____

PERFORATIONS:

Perforated? Yes No.
 Type of perforator used STAR
 Size of perforations 3/8 in. by 1/4 in.
400 perforations from 439 ft. to 449 ft.
 _____ perforations from _____ ft. to _____ ft.
 _____ perforations from _____ ft. to _____ ft.
 _____ perforations from _____ ft. to _____ ft.
 _____ perforations from _____ ft. to _____ ft.

(7) SCREENS:

Well screen installed? Yes No
 Manufacturer's Name _____
 Type _____ Model No. _____
 Diam. _____ Slot size _____ Set from _____ ft. to _____ ft.
 Diam. _____ Slot size _____ Set from _____ ft. to _____ ft.

(8) WATER LEVEL: Completed well.

Static level 250 ft. below land surface Date 12/29/69
 Man pressure _____ lbs. per square inch Date _____

(9) WELL TESTS:

Drawdown is amount water level is lowered below static level
 Was a pump test made? Yes No If yes, by whom? STRASSER
 Yield: 213 gal./min. with 83 ft. drawdown after 24 hrs.
200 " 57 " 25 "
2nd TEST 490 " 166 " 8 "
 Baller test _____ gal./min. with _____ ft. drawdown after _____ hrs.
 Artesian flow _____ g.p.m. Date _____
 Temperature of water 54 Was a chemical analysis made? Yes No

(10) CONSTRUCTION:

Well seal—Material used CEMENT GROUT
 Depth of seal FROM SURFACE TO 61 ft.
 Diameter of well bore to bottom of seal 16 in.
 Were any loose strata cemented off? Yes No Depth _____
 Was a drive shoe used? Yes No
 Did any strata contain unusable water? Yes No
 Type of water? _____ depth of strata _____
 Method of sealing strata off _____
 Was well gravel packed? Yes No Size of gravel: _____
 Gravel placed from _____ ft. to _____ ft.

(11) LOCATION OF WELL:

County MULT. Driller's well number 5231
SE 1/4 NW 1/4 Section 35 T. 1N. R. 3E. W.M.
 Bearing and distance from section or subdivision corner _____

(12) WELL LOG:

Diameter of well below casing 12
 Depth drilled 546 ft. Depth of completed well 458 ft.
 Formation: Describe color, texture, grain size and structure of materials; and show thickness and nature of each stratum and aquifer penetrated, with at least one entry for each change of formation. Report each change in position of Static Water Level as drilling proceeds. Note drilling rates.

MATERIAL	From	To	SWL
GRAVEL AND BOULDERS	0	51	
GRAVEL AND BROWN CLAY	51	78	
BROWN SAND AND CLAY	78	128	
GRAVEL AND CLAY	128	146	
CEMENTED GRAVEL	146	258	
GRAVEL, SOME BINDER	258	270	
CEMENTED GRAVEL	270	279	
LARGE GRAVEL	279	291	
CEMENTED GRAVEL	291	438	
BROWN SAND AND GRAVEL	438	440	
WATER BEARING GRAVEL	440	450	
GREY SHALE	450	546	

RECEIVED BY OWARD

JUN 13 2013

SALEM, OR

Work started SEPT 18 1969 Completed FEB 2 1970
 Date well drilling machine moved off of well FEB 3 1970

Drilling Machine Operator's Certification:

This well was constructed under my direct supervision. Materials used and information reported above are true to my best knowledge and belief.

[Signed] Donald Johnson Date FEB 4, 1970
 (Drilling Machine Operator)

Drilling Machine Operator's License No. 56

Water Well Contractor's Certification:

This well was drilled under my jurisdiction and this report is true to the best of my knowledge and belief.

NAME RJ STRASSER DRILLING CO
 (Person, firm or corporation) (Type or print)

Address 8110 SE SUNSET LAKE PORTLAND ORE

[Signed] Robert L. Strasser
 (Water Well Contractor)

Contractor's License No. 10 Date FEB 4 1970