

STATE ENGINEER
Salem, Oregon

MULT
001426

Well Record

GR- 1537

STATE WELL NO. 1N/3-34A
COUNTY Multnomah
APPLICATION NO. GR-1589

OWNER: City of Wood Village

MAILING ADDRESS: Wood Village City Hall


LOCATION OF WELL: Owner's No. _____

CITY AND STATE: Trousdale, Oregon

NE ¼ NE ¼ Sec. 34 T. 1 N. R. 3 E., W.M.

Bearing and distance from section or subdivision

corner 1225' W. & 580' S. from NE cor. Sec. 24

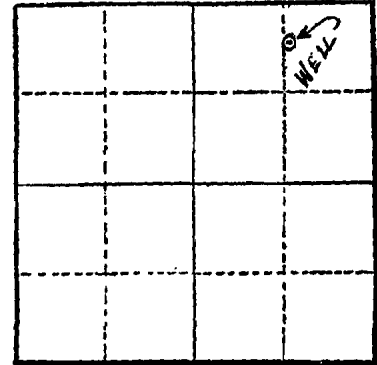

Section 34

Altitude at well 168'

TYPE OF WELL: Drilled Date Constructed 1942

Depth drilled 360' Depth cased 355'

CASING RECORD:

10" from 0 to 170 ft.

8" from 170 to 355 ft.

FINISH:

Perforated from: 170 to 180 ft.

284 to 294 ft.

340 to 355 ft.

AQUIFERS:

WATER LEVEL:

65'

PUMPING EQUIPMENT: Type Pomona deep well turbine H.P. 20

Capacity 200 G.P.M.

WELL TESTS:

Drawdown 100 ft. after _____ hours 200 G.P.M.

Drawdown _____ ft. after _____ hours _____ G.P.M.

USE OF WATER Municipal Temp. _____ °F. _____, 19____

SOURCE OF INFORMATION GR Record

DRILLER or DIGGER R. J. Strasser

ADDITIONAL DATA:

Log _____ Water Level Measurements _____ Chemical Analysis _____ Aquifer Test _____

REMARKS:

Log: Top soil	0 to 15 ft.
Gravel & boulders	15 to 40 ft.
Boulders	40 to 83 ft.
Cemented gravel	83 to 103 ft.
Cemented gravel	103 to 290 ft.
Loose gravel	290 to 294 ft.
Sandstone	294 to 330 ft.
Gray sandstone	330 to 350 ft.
Sandstone	350 to 360 ft.

RECEIVED BY OW

JUN 13 2013

SALEM, OR

T011618

NOTICE TO WATER WELL CONTRACTOR
The original and first copy of this report are to be filed with the

STATE ENGINEER, SALEM, OREGON
within 30 days from the date of well completion.

RECEIVED
FEB 5 1970
STATE ENGINEER
SALEM, OREGON

WATER WELL REPORT
DATE OF OREGON
(Please type or print)
Do not write above this line

MULT

001431

State Well No. 1N/3-356d
State Permit No.

(1) OWNER:
Name CITY OF WOOD VILLAGE
Address 2055 NE 238th DR, TROUTDALE, ORE.

(2) TYPE OF WORK (check):
New Well Deepening Reconditioning Abandon
If abandonment, describe material and procedure in Item 12.

(3) TYPE OF WELL: (4) PROPOSED USE (check):
Rotary Driven Domestic Industrial Municipal
Cable Jetted Irrigation Test Well Other
Dug Bored

CASING INSTALLED: Threaded Welded
12" Diam. from 0 ft. to 458 ft. Gage 330
" Diam. from ft. to ft. Gage
" Diam. from ft. to ft. Gage

PERFORATIONS: Perforated? Yes No.
Type of perforator used STAR
Size of perforations 3/8 in. by 1/4 in.
400 perforations from 439 ft. to 449 ft.
perforations from ft. to ft.
perforations from ft. to ft.
perforations from ft. to ft.
perforations from ft. to ft.

(7) SCREENS: Well screen installed? Yes No
Manufacturer's Name
Type Model No.
Diam. Slot size Set from ft. to ft.
Diam. Slot size Set from ft. to ft.

(8) WATER LEVEL: Completed well.
Static level 250 ft. below land surface Date 12/29/69
Dian pressure lbs. per square inch Date

(9) WELL TESTS: Drawdown is amount water level is lowered below static level
Was a pump test made? Yes No If yes, by whom? STRASSER
Yield: 313 gal./min. with 83 ft. drawdown after 24 hrs.
200 " 57 " 25 "
490 " 166 " 8 "
Bailer test gal./min. with ft. drawdown after hrs.
Artesian flow g.p.m. Date
Temperature of water 54 Was a chemical analysis made? Yes No

(10) CONSTRUCTION:
Well seal—Material used CEMENT GROUT
Depth of seal FROM SURFACE TO 61 ft.
Diameter of well bore to bottom of seal 16 in.
Were any loose strata cemented off? Yes No Depth
Was a drive shoe used? Yes No
Did any strata contain unusable water? Yes No
Type of water? depth of strata
Method of sealing strata off
Was well gravel packed? Yes No Size of gravel:
Gravel placed from ft. to ft.

(11) LOCATION OF WELL:
County MULT. Driller's well number 5231
SE 1/4 NW 1/4 Section 35 T. 1N. R. 3E. W.M.
Bearing and distance from section or subdivision corner

(12) WELL LOG: Diameter of well below casing 12
Depth drilled 546 ft. Depth of completed well 458 ft.
Formation: Describe color, texture, grain size and structure of materials; and show thickness and nature of each stratum and aquifer penetrated, with at least one entry for each change of formation. Report each change in position of Static Water Level as drilling proceeds. Note drilling rates.

MATERIAL	From	To	SWL
GRAVEL AND BOULDERS	0	51	
GRAVEL AND BROWN CLAY	51	78	
BROWN SAND AND CLAY	78	128	
GRAVEL AND CLAY	128	146	
CEMENTED GRAVEL	146	258	
GRAVEL, SOME BINDER	258	270	
CEMENTED GRAVEL	270	279	
LARGE GRAVEL	279	291	
CEMENTED GRAVEL	291	438	
BROWN SAND AND GRAVEL	438	440	
WATER BEARING GRAVEL	440	450	
GREY SHALE	450	546	

RECEIVED BY OWRD

JUN 13 2013

SALEM, OR

Work started SEPT 18 1969 Completed FEB 2 1970
Date well drilling machine moved off of well FEB 3 1970

Drilling Machine Operator's Certification:
This well was constructed under my direct supervision. Materials used and information reported above are true to my best knowledge and belief.
[Signed] Donald J. Johnson Date FEB 4, 1970
(Drilling Machine Operator)

Drilling Machine Operator's License No. 56


Water Well Contractor's Certification:
This well was drilled under my jurisdiction and this report is true to the best of my knowledge and belief.
NAME R. J. STRASSER DRILLING CO
(Person, firm or corporation) (Type or print)
Address 8110 SE SUNSET LANE PORTLAND OR
[Signed] Robert J. Strasser
(Water Well Contractor)

Contractor's License No. 10 Date FEB 4, 1970

RECEIVED BY OWRD

WELL #2

JUN 13 2013

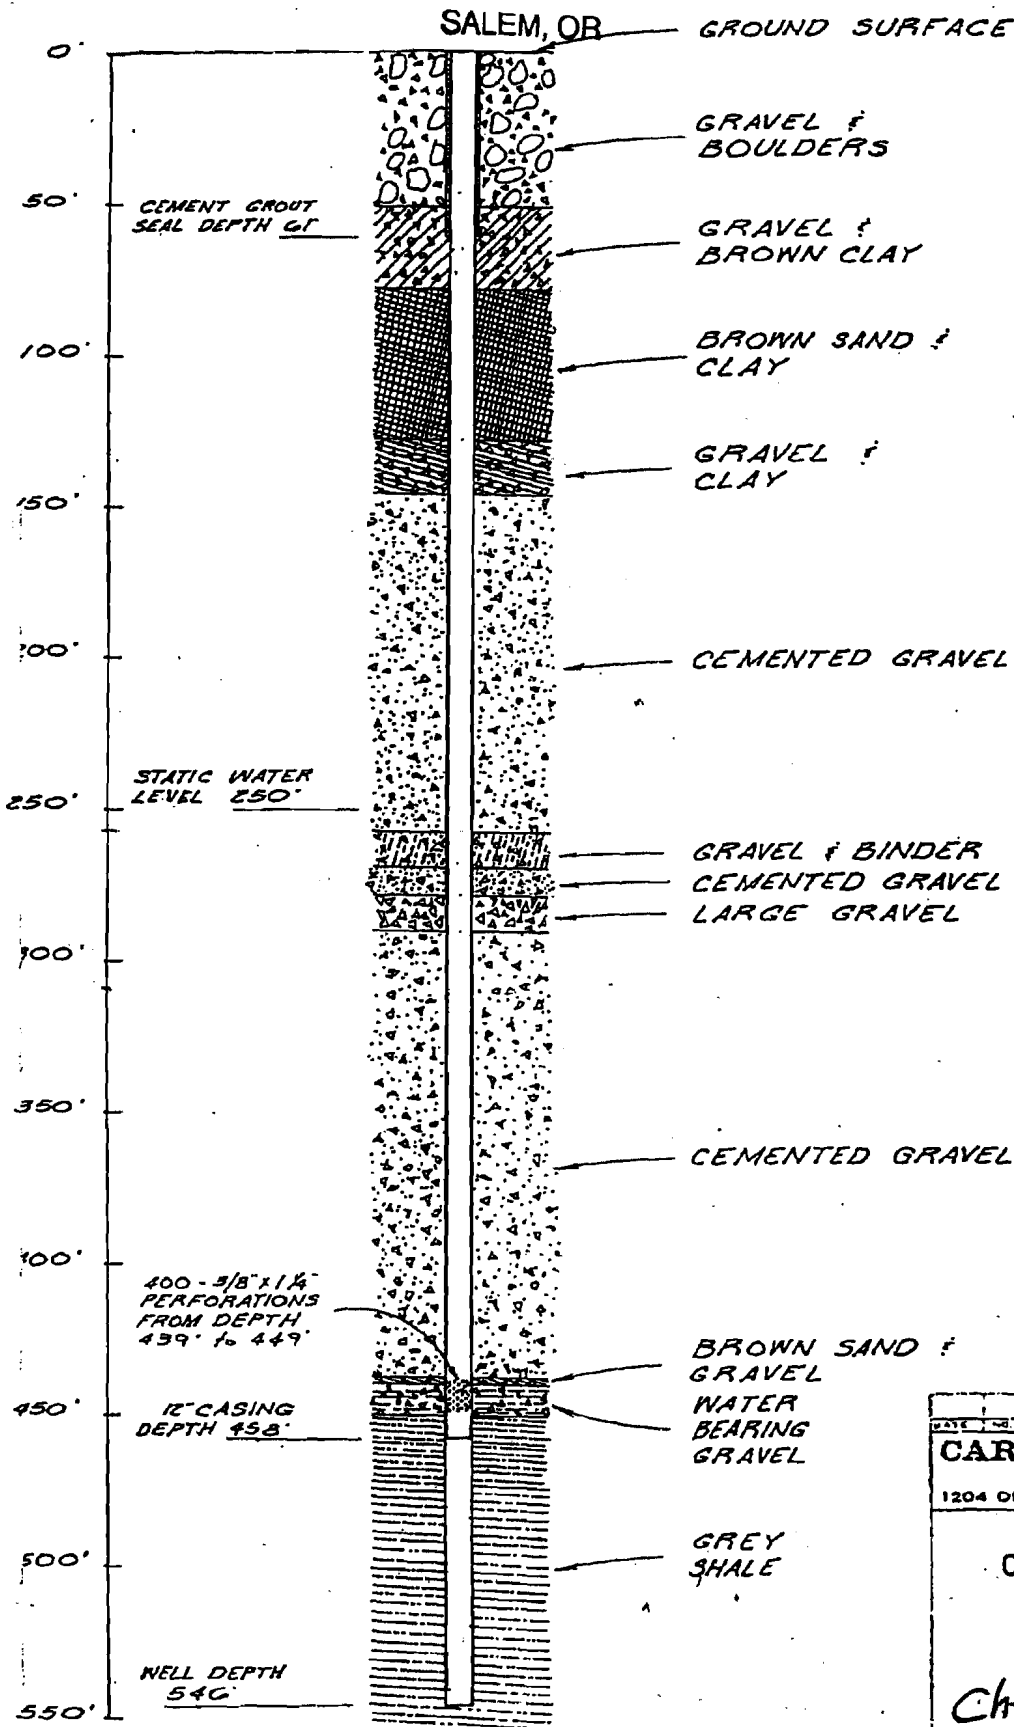

T011618

DATE	REVISION
CARTER, BRINGLE & ASSOC. CONSULTING ENGINEERS 1204 OREGON BANK BLDG. PORTLAND, OREGON	
CITY OF WOOD VILLAGE	
WELL No. 2 LOG <i>Cherry Park Road</i>	
DESIGNED BY <i>H. P.</i>	INVESTIGATED BY <i>T. Co. Vertical</i>
DRAWN BY	DATE <i>Feb. 1970</i> REF. 940235

A first copy of this report
is filed with the
SOURCES DEPARTMENT,
SALEM, OREGON 97310
within 30 days from the date
of well completion.

S & M DRILLING COMPANY
MAR 1980 WATER WELL REPORT
STATE OF OREGON
(Please type or print)
(Do not write above this line)

WOODVILLE WELLS

State Well No. _____
State Permit No. _____

See Correspondence from SEM
Drilling

OWNER:
Name City of Wood Village
Address Multnomah County, Oregon

(10) LOCATION OF WELL:
County Multnomah Driller's well number D 260-60
N E 1/4 S E 1/4 Section 27 T. 15 R. 3E W.M.

(2) TYPE OF WORK (check):
New Well Deepening Reconditioning Abandon
If abandonment, describe material and procedure in Item 12.

Bearing and distance from section or subdivision corner.
1510 feet N. 1290 feet W of SE corner

(3) TYPE OF WELL: Rotary Driven
Cable Jetted
Aug Bored
(4) PROPOSED USE (check): Domestic Industrial Municipal
Irrigation Test Well Other

(11) WATER LEVEL: Completed well
Depth at which water was first found 15 ft.
Static level 95 ft. below land surface. Date 4/8/80
Artesian pressure _____ lbs. per square inch. Date _____

(5) CASING INSTALLED: Threaded Welded
12 " Diam. from 0 ft. to 200 ft. Gage 375
" Diam. from _____ ft. to _____ ft. Gage _____
" Diam. from _____ ft. to _____ ft. Gage _____

(12) WELL LOG: Diameter of well below casing 12
Depth drilled 300 ft. Depth of completed well 300 ft.
Formation: Describe color, texture, grain size and structure of materials;
and show thickness and nature of each stratum and aquifer penetrated,
with at least one entry for each change of formation. Report each change in
position of Static Water Level and indicate principal water-bearing strata.

(6) PERFORATIONS: Perforated? Yes No.
Type of perforator used _____
Size of perforations in. by in.
_____ perforations from _____ ft. to _____ ft.
_____ perforations from _____ ft. to _____ ft.
_____ perforations from _____ ft. to _____ ft.

MATERIAL	From	To	SWL
topsoil	0	2	
clay brown & sandy	2	14	
gravel water bearing	14	16	
gravel cemented	16	22	
gravel, sand boulders	22	60	
gravel & sand cemented	60	110	
sand & gravel	110	135	
gravel & sand water/b	135	230	
sand brown water bearing	230	245	
gravel & sand water/b	245	257	
sand brown fine	257	270	
claystone gray water/b	270	285	
clay gray	285	300	

SCREENS: Well screen installed? Yes No
Manufacturer's Name J. J. JOHNSON
Type stainless steel Model No. _____
Diam. 10P Slot size 250 Set from 200 ft. to 230 ft.
Diam. 10P Slot size 250 Set from 245 ft. to 255 ft.
Diam. 10P Slot size 250 Set from 270 ft. to 280 ft.

(7) WELL TESTS: Drawdown is amount water level is
lowered below static level.
Was a pump test made? Yes No If yes, by whom? Aqua Pump
Field: 250 gal./min. with 20 ft. drawdown after 1/2 hrs.
" 350 " " 26 " " 1/2 " "
" 500 " " 57 " " 24 hrs.
Packer test gal./min. with ft. drawdown after hrs.
Artesian flow g.p.m.
Temperature of water Depth artesian flow encountered ft.

RECEIVED BY OWNER
JUN 13 2013
SALEM, OR
Work started 1/3/80 19 Completed 3/28/80 19
Date well drilling machine moved off of well 4/8/80 19

(8) CONSTRUCTION: cement
Well seal—Material used 22 inch 25 feet
Well sealed from land surface to 16 inch 25 feet ft.
Diameter of well bore to bottom of seal 12 in. & 16 in
Diameter of well bore below seal 12 in.
Number of sacks of cement used in well seal 58 sacks
How was cement grout placed? pressure pumped

Drilling Machine Operator's Certification:
This well was constructed under my direct supervision.
Materials used and information reported above are true to my
best knowledge and belief.
[Signed] Walter Mack Date 4/8/80 19
(Drilling Machine Operator)
Drilling Machine Operator's License No. 1306

Drive shoe used? Yes No Plugs _____ Size: location _____ ft.
Any strata contain unusable water? Yes No
Type of water? _____ depth of strata _____
Method of sealing strata off _____
Is well gravel packed? Yes No Size of gravel: _____

Water Well Contractor's Certification:
This well was drilled under my jurisdiction and this report is
true to the best of my knowledge and belief.
Name S & M Drilling & Supply Inc.
(Person, firm or corporation) (Type or print)
Address 399 S E Walnut Canby, Ore 97013
[Signed] Walter Mack
(Water Well Contractor)
1011618