

LEGEND

- LINE TYPES
- TAX LOT BOUNDARY OLD PROPERTY LINE
 - ROAD RIGHT-OF-WAY VACATED RIGHT-OF-WAY
 - RAILROAD RAILROAD RIGHT-OF-WAY
 - STREAK LINE, ETC. STREAK LINE, ETC.
 - TAX LOT BOUNDARY NON-BOUNDARY
 - SUBVISION BOUNDARY PARTITION PLAT BKT.
 - TAX CORNER BOUNDARY EMBAYMENT

SYMBOL TYPES

- DLC
- CONTROL POINTS
- SURVEY MONUMENTS
- CLD CORNERS
- SECTION 1/4 SEC. 1/4 SEC. 1/4 SEC.

NUMBERS


- TAX CODE NO.
- 000 00 00 0

NOTICE: This map was created for Assessor's Office use ONLY.



SCALE 1" = 400'
OF 1:400

Plot file created: December 31, 1997

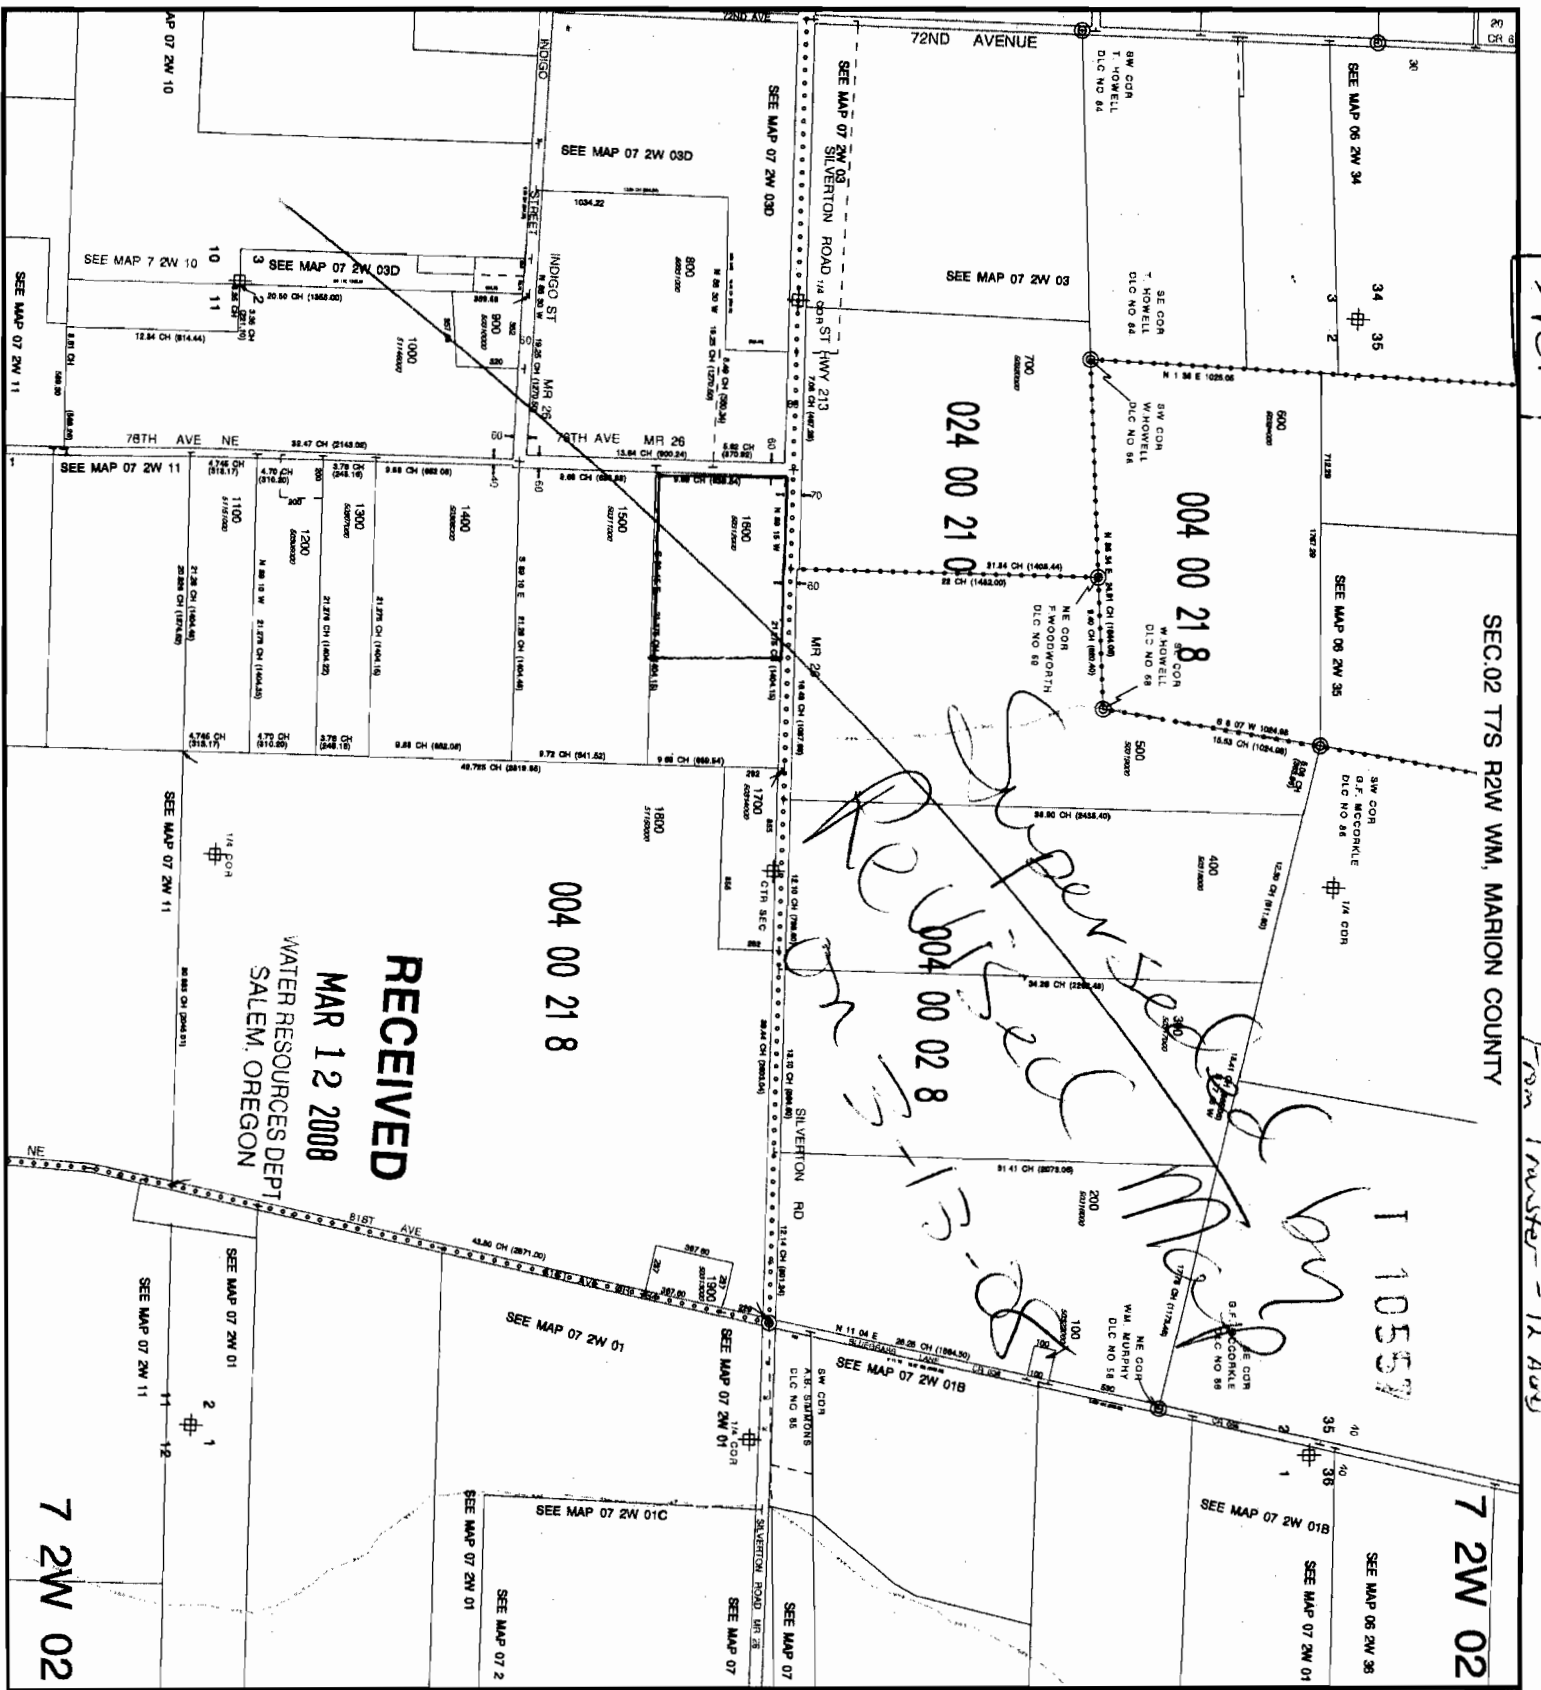

From

From Transfer - 12 Ave

SEC.02 T7S R2W WM, MARION COUNTY

10557

Handwritten signature and scribbles over the map.

RECEIVED

MAR 12 2008


WATER RESOURCES DEPT
SALEM, OREGON

7 2W 02

7 2W 02

T7S R2W WM

"FROM" Map.
Superseeded on
3-13-08
by Revised Map
- due to
Scale

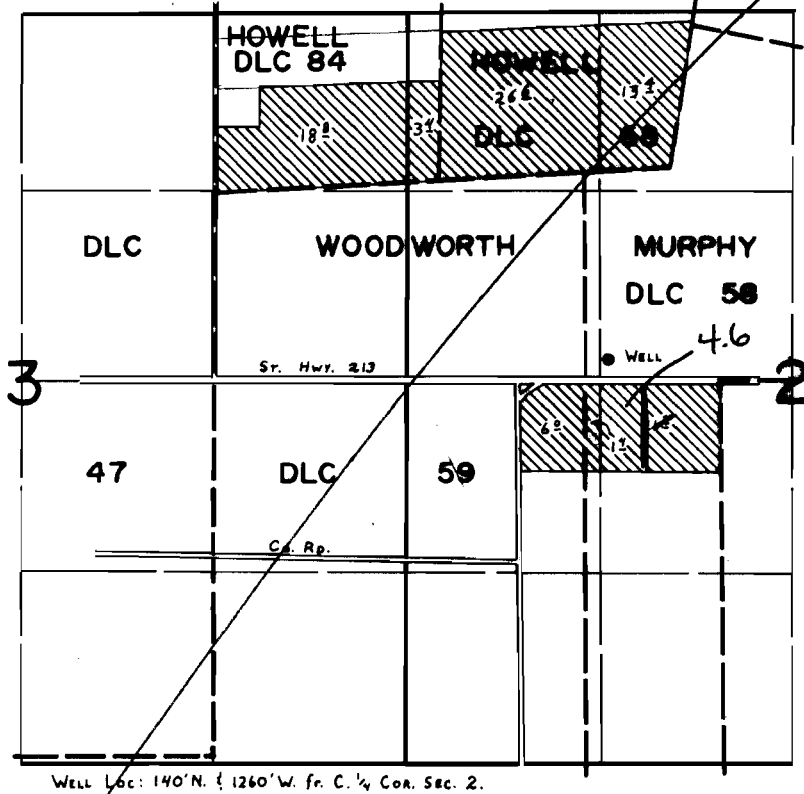

FINAL PROOF SURVEY
UNDER

Application No. **G-8554** Permit No. **G-7867...**
IN NAME OF

EDWARD A. HARI

Surveyed May 2, 1989, by C. L. HARRIS

RECEIVED


MAR 12 2008

WATER RESOURCES DEPT
SALEM, OREGON

1 10557

Marion County Map

T. 6S, R. 2W
Marion
10557 Co.

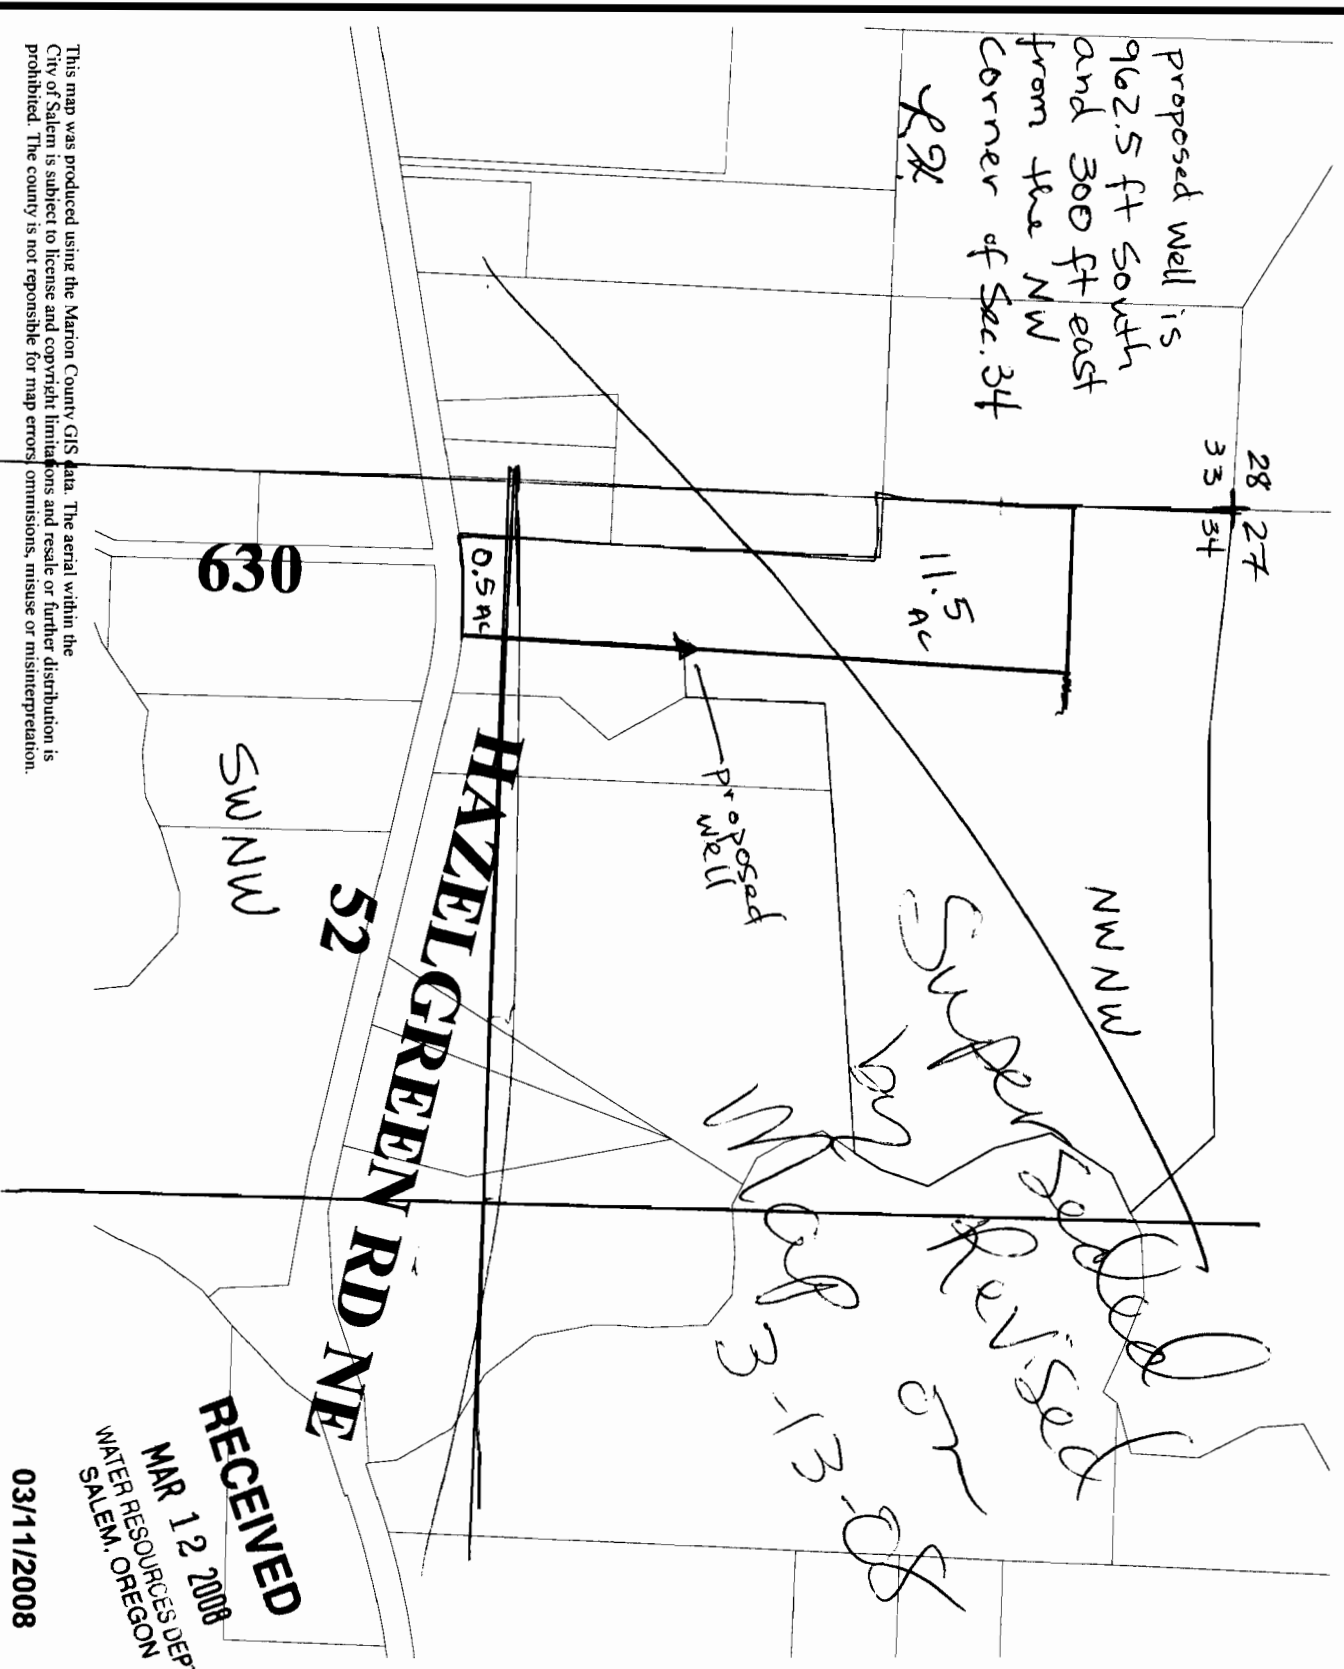


This map was produced using the Marion County GIS data. The aerial within the City of Salem is subject to license and copyright limitations and resale or further distribution is prohibited. The county is not responsible for map errors, omissions, misuse or misinterpretation.

- Legend**
- CITY LIMITS
 - COUNTY
 - GEOHAZARD
 - STATE HWY
 - TAXLOTS
 - ZONING
 - CC
 - IUC
 - IUC-LU
 - C
 - I
 - UT-20-IND
 - IP-IND
 - A
 - A
 - A
 - A
 - N
 - <100'

1 in. = 350ft.

Vicinity

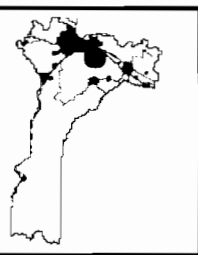

LEGEND

- LINE TYPES
- TAX LOT BOUNDARY
- ROAD BERTH-OF-WAY
- RAILROAD
- STEAK LAKE, ETC.
- STATION BOUNDARY
- TAX CODE BOUNDARY
- OLD PROJECT LINE
- VACATED RIGHT-OF-WAY
- RAILROAD RIGHT-OF-WAY
- STEAK LAKE, ETC.
- PARTITION PLAT BDT.
- EXHIBIT

SYMBOL TYPES

- DLG
- CONTROL POINTS
- SURVEY MONUMENTS
- CLD CORNERS
- 1/4 SEC
- 1/8 SEC
- 1/2 SEC
- 1/4 COR
- 1/8 COR

NUMBERS

TAX CODE NO. 000 00 00 0

APPLICABLE - ALL APPLICABLE INCLUDING MAP PORTION THAT MAY BE WITHIN THE INDICATED PUBLIC RIGHT OF WAY.


TRICK MARKS - WHEN A TRICK MARK IS DISPLAYED ON THE EXTENSION OF A LINE THEN THE DIMENSION GIVEN TO THE TRICK MARK GENERALLY THIS IS USED WHEN DIMENSIONS GO INTO PUBLIC RIGHT OF WAY.

ABBREVS ARE USED WITH DIMENSIONS IN AREA OF GREATER COMPLEXITY.

NOTICE: This map was created for Assessor's Office use ONLY.



SCALE 1" = 400' of 1:4000 Plot file created: March 10, 2005

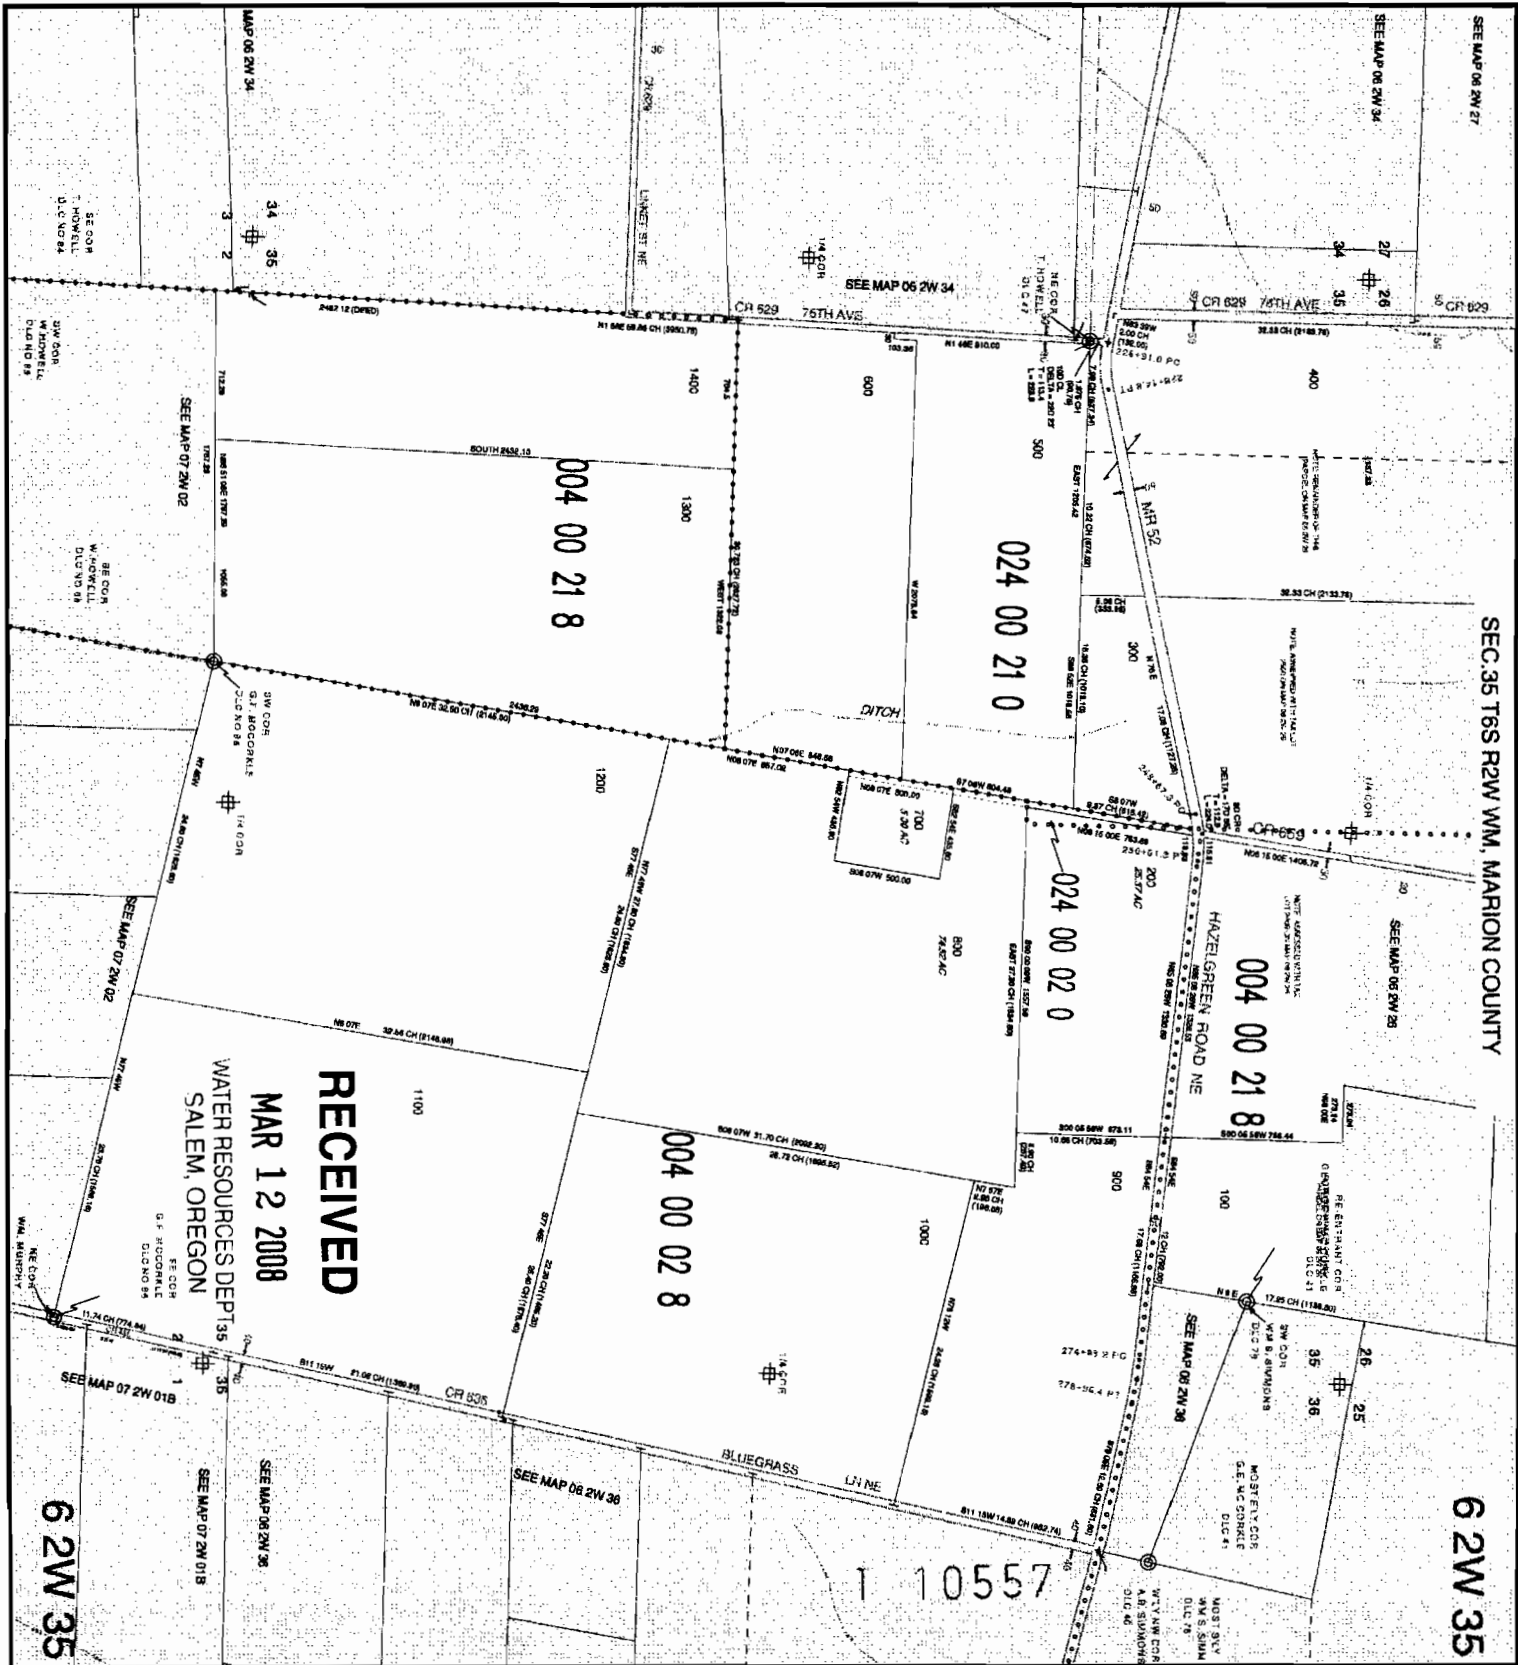


"From"
Map

T7S R2W WM

RECEIVED

MAR 13 2008

WATER RESOURCES DEPT
SALEM, OREGON

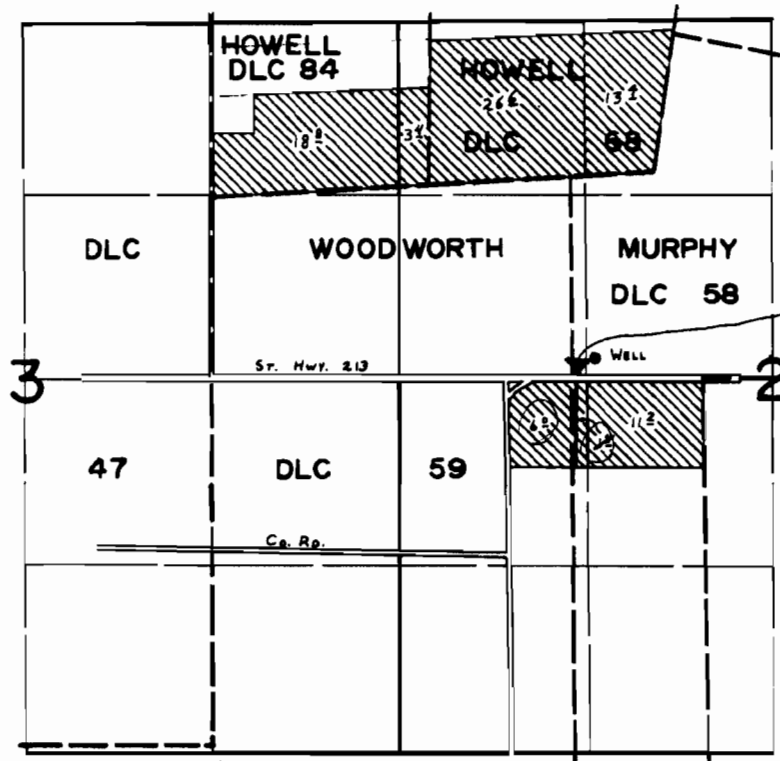

0.27 AC transferred
(Remain 1.13 AC)

R.H. 3/13/08

Well Loc: 140' N. & 1260' W. fr. C. 1/4 Cor. Sec. 2.

FINAL PROOF SURVEY
UNDER

Application No. ~~G-8554~~ Permit No. ~~G-7867~~
IN NAME OF

.....**EDWARD A. HARI**.....

Surveyed ~~MAY 2~~ 19.88, by ~~C. HARRIS~~.....

I 10557

7S R. 2W

RECEIVED

MAR 12 2008

WATER RESOURCES DEPT
SALEM, OREGON

2005

Aerial
photo

