

R.R. VID - Antelope


Instream Lease Naumes Inc.

T 36 S, R 1 E, Section 19, 1W

Instream lease of
 Certificate 80569 Primary (43.2 ac)
~~Certificate 80569 Supplemental (14.0 ac)~~
~~Certificate 80571 Supplemental (57.2 ac)~~ 43.2
~~Certificate 80574 Supplemental (57.2 ac)~~

Address
 PO Box 996
 Medford, OR 97501



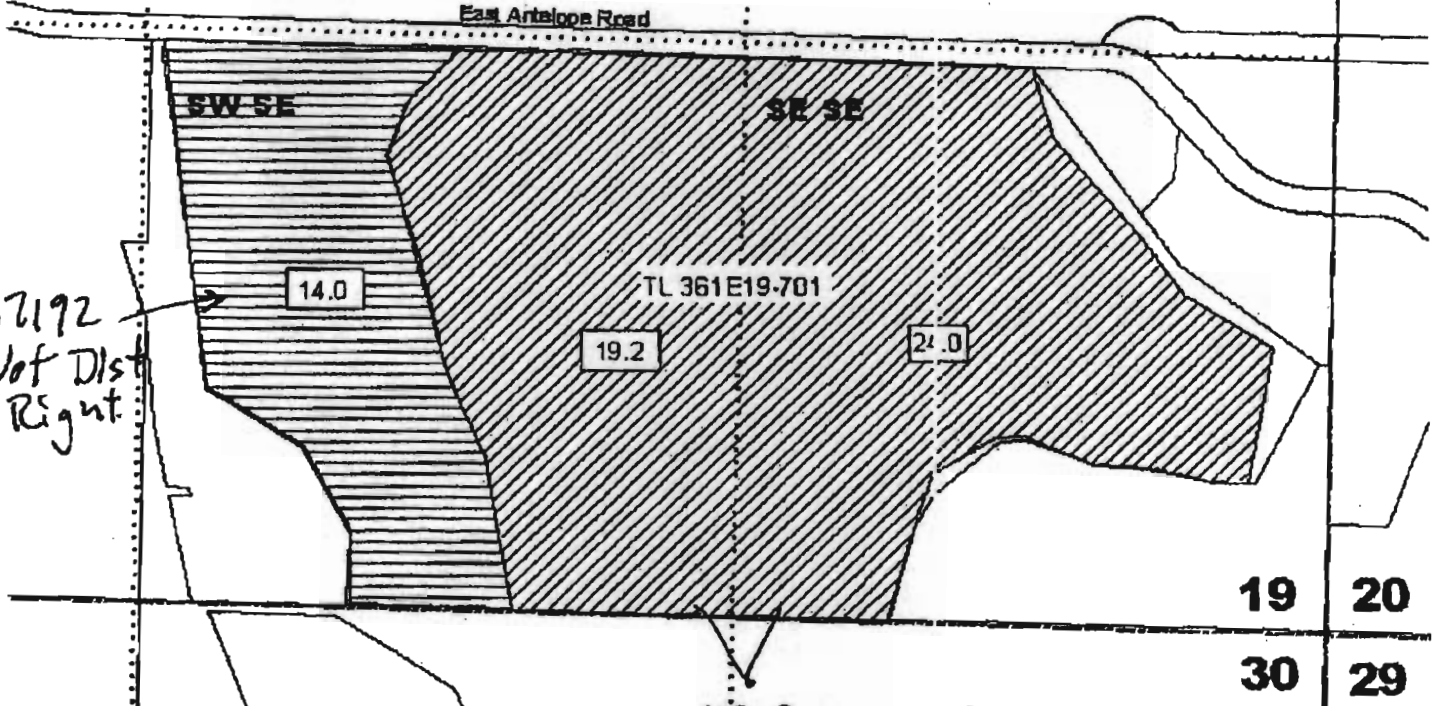

Phone
 511-608-1732



17192
Not Dist
Right

43.2 acres
to lease

Legend

-  Cert 80569 primary
-  Cert 80569 Supplemental
-  Section Line
-  Quarter-quarter line



Scale 1" = 400'