


1N-10E-02
SW 1/4 ~~X~~

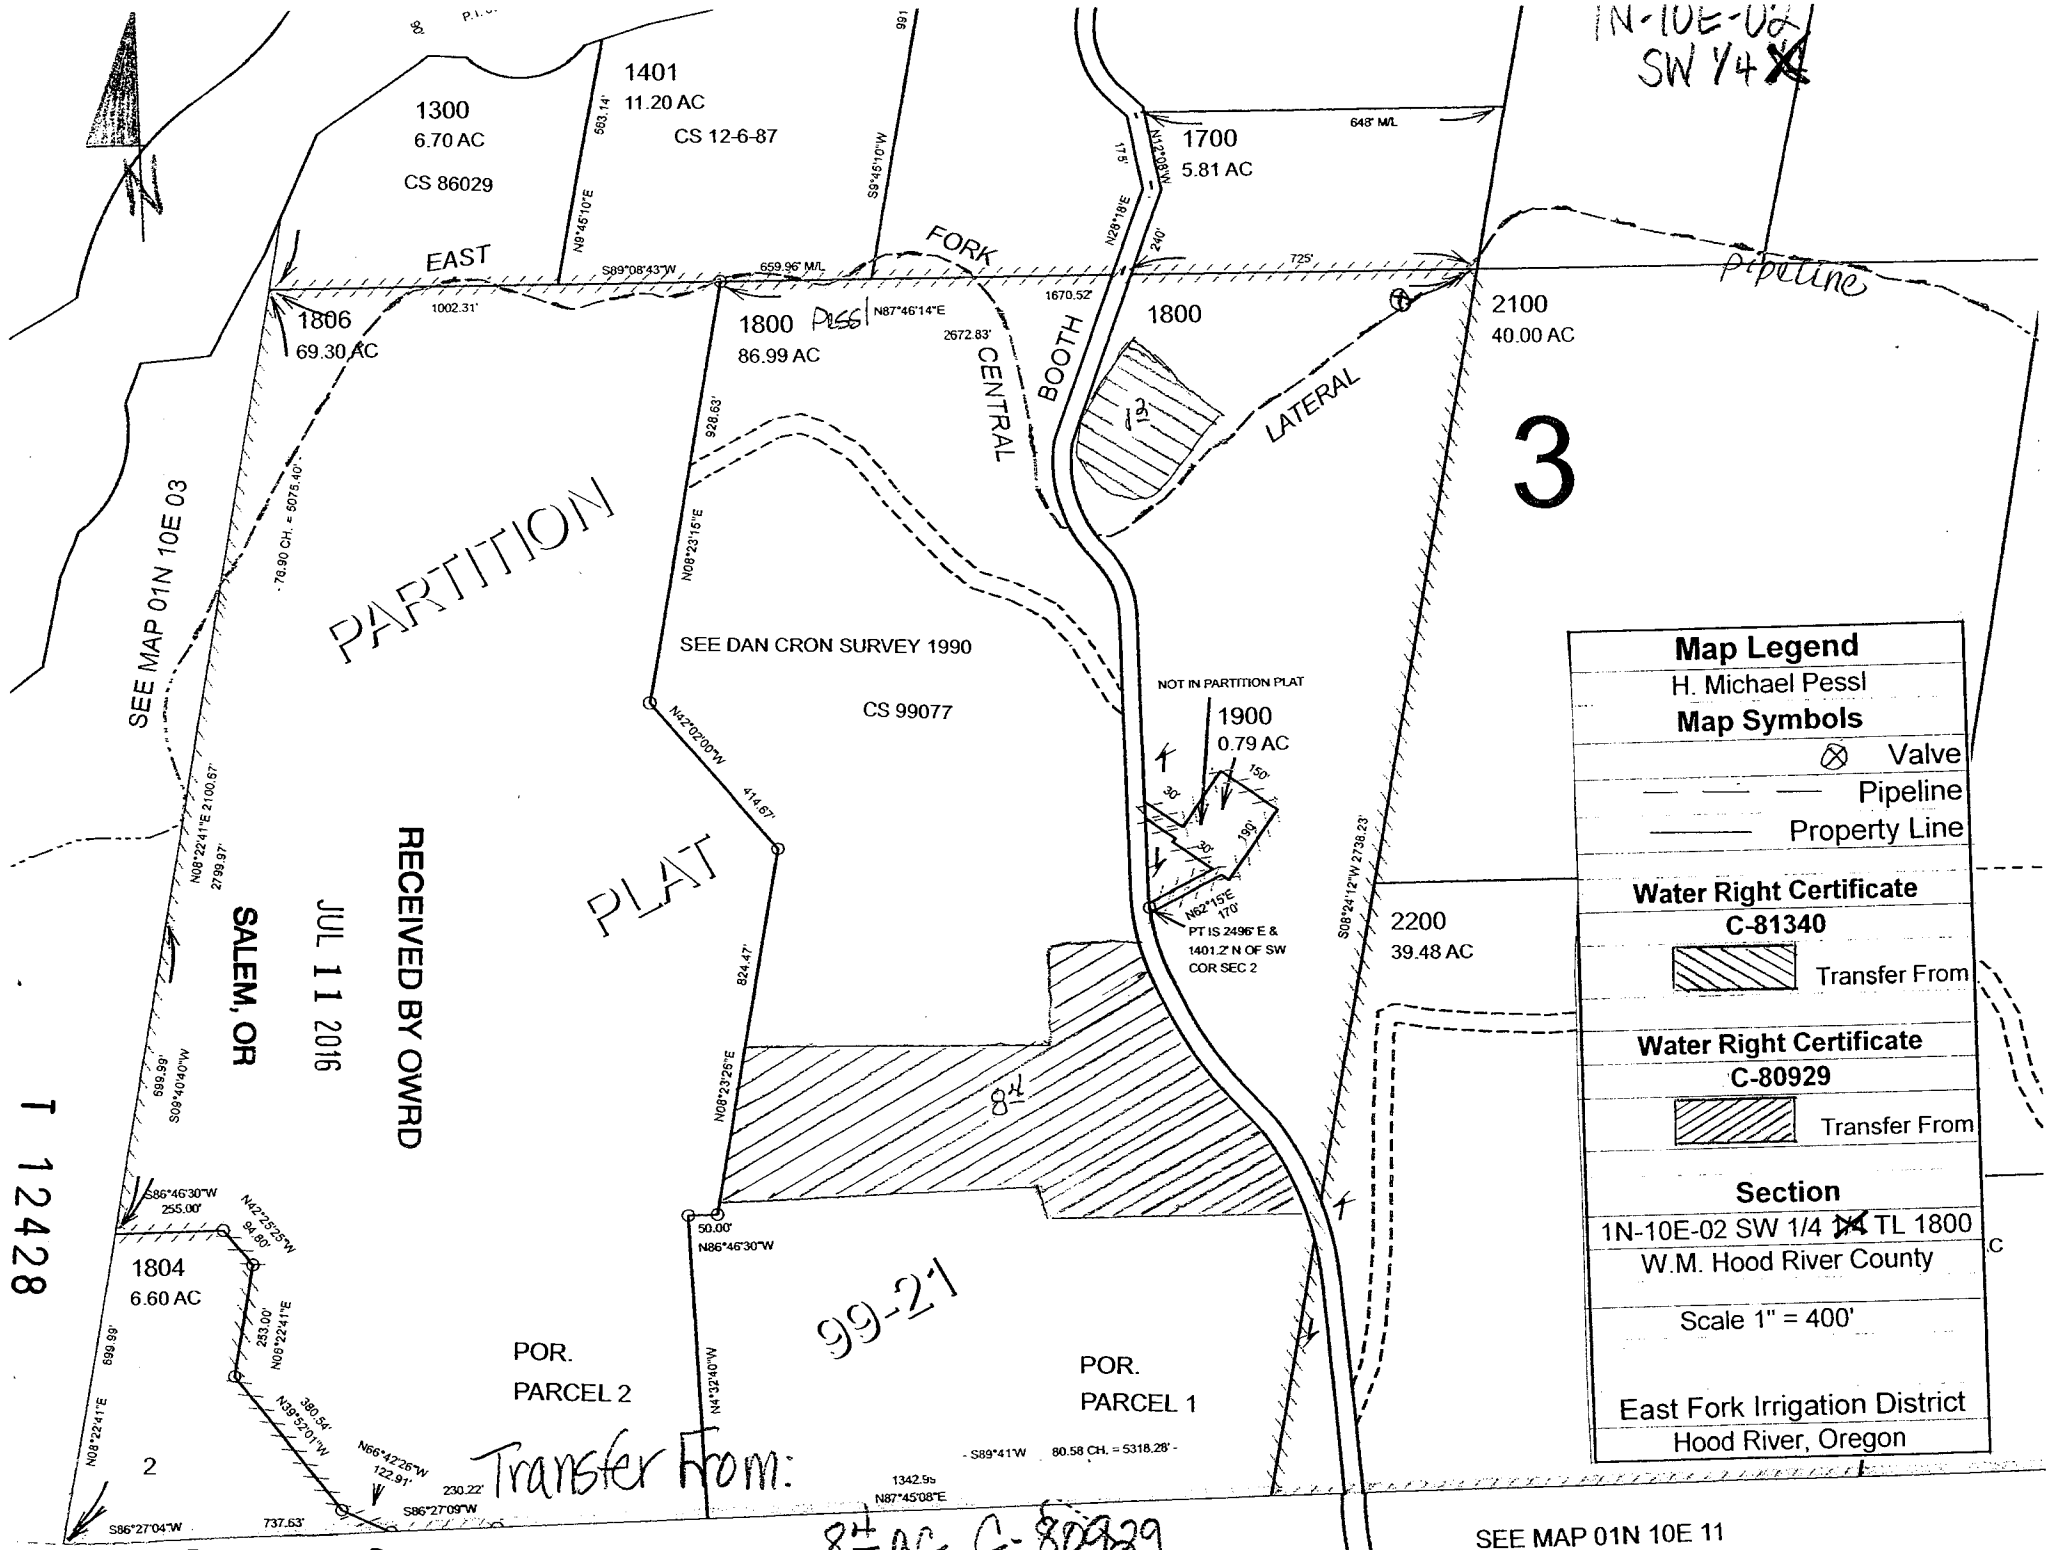

3

Map Legend	
H. Michael Pessl	
Map Symbols	
	Valve
	Pipeline
	Property Line
Water Right Certificate	
C-81340	
	Transfer From
Water Right Certificate	
C-80929	
	Transfer From
Section	
1N-10E-02 SW 1/4 X TL 1800	
W.M. Hood River County	
Scale 1" = 400'	
East Fork Irrigation District Hood River, Oregon	

PARTITION

PLAT

RECEIVED BY OWRD
JUL 11 2016
SALEM, OR

Transfer From:


99-21

84 ac C-80929

SEE MAP 01N 10E 11

T 12428

T-12428

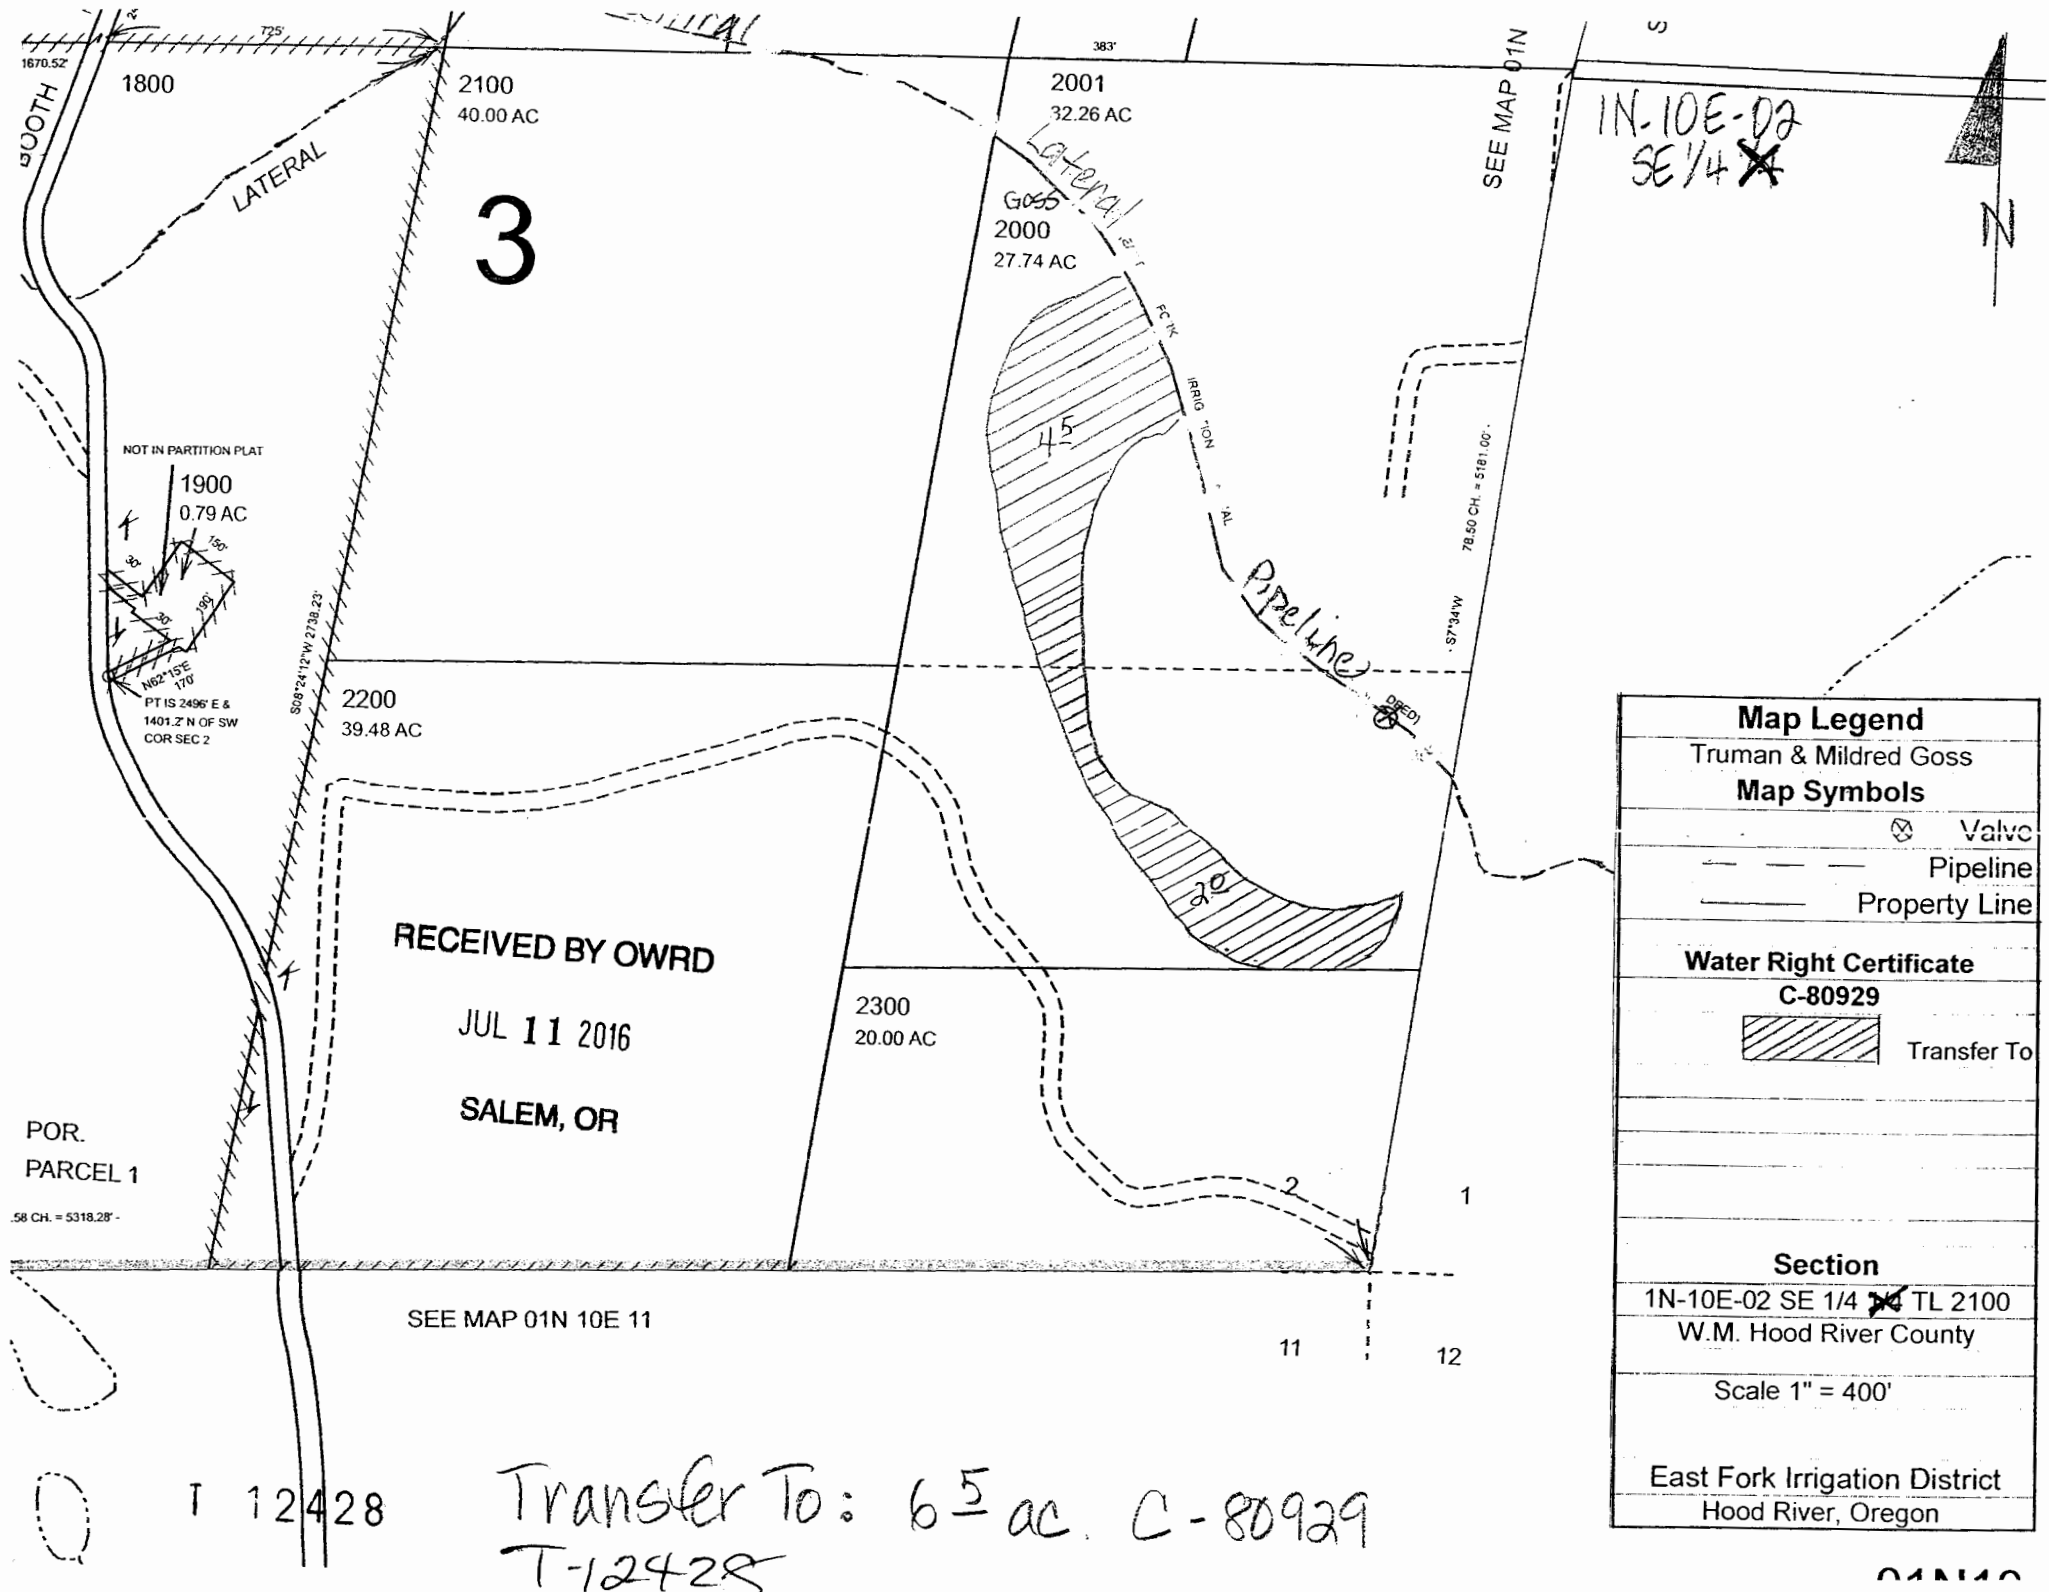

IN-10E-02
SE 1/4 ~~X~~

SEE MAP 01N

Map Legend	
Truman & Mildred Goss	
Map Symbols	
	Valve
	Pipeline
	Property Line
Water Right Certificate	
C-80929	
	Transfer To
Section	
1N-10E-02 SE 1/4 X TL 2100	
W.M. Hood River County	
Scale 1" = 400'	
East Fork Irrigation District	
Hood River, Oregon	

RECEIVED BY OWRD
JUL 11 2016
SALEM, OR

SEE MAP 01N 10E 11

Transfer To: 6⁵ ac. C-80929
T-12428

T 12428