


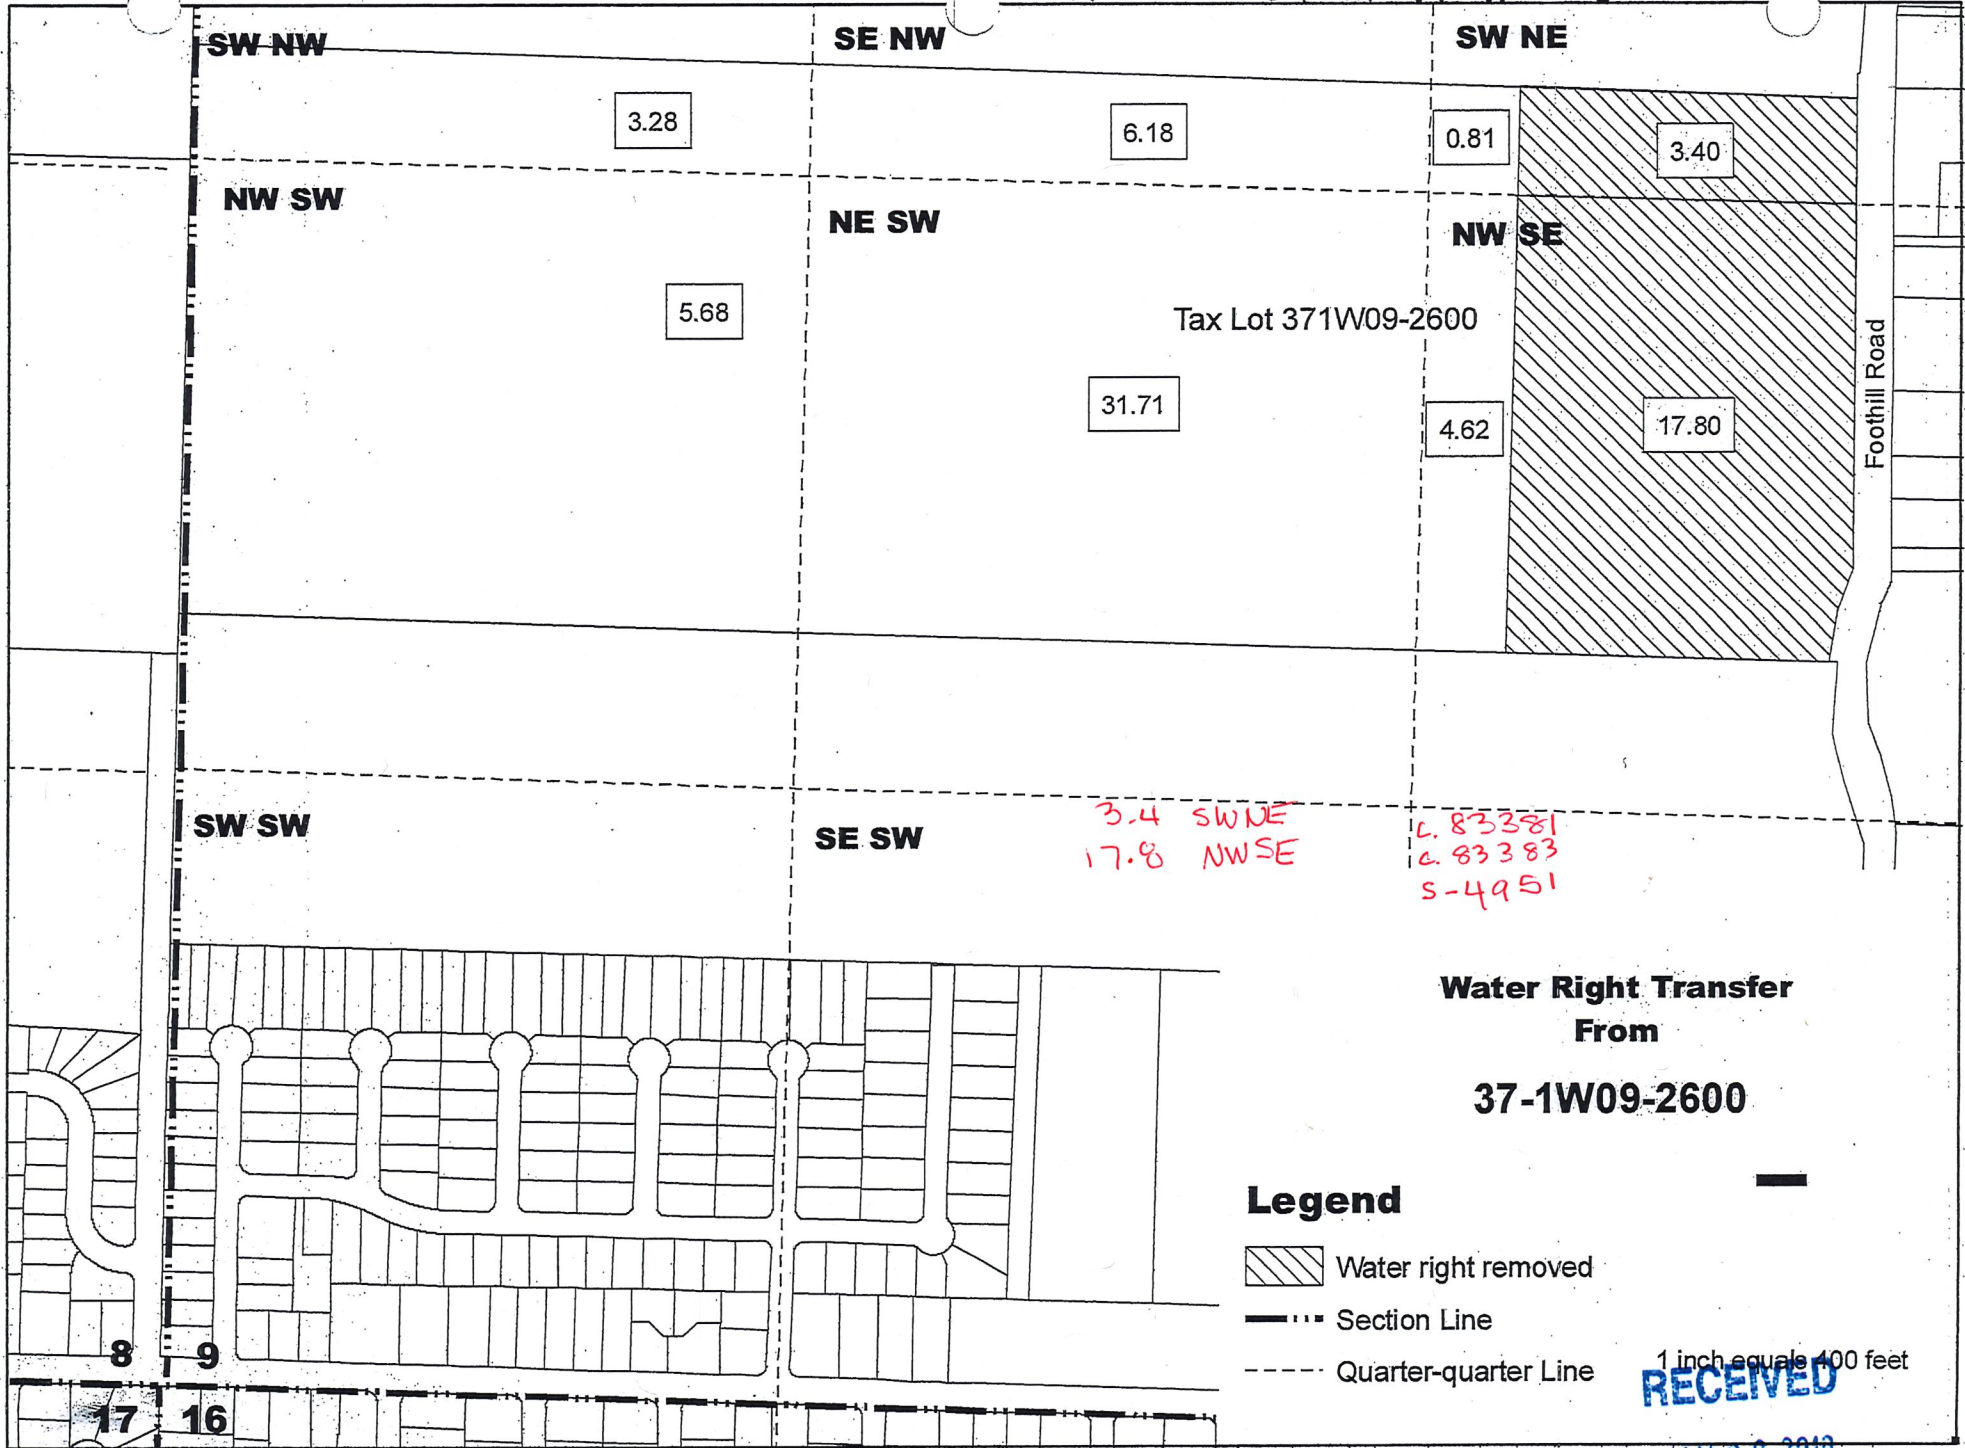

RECEIVED

JAN 08 2010

WATER RESOURCES DEPT

Triple Springs Ranch LLC
Water Right Transfer
T36S, R1E, Section 18
Tax Lot 900

RECEIVED


JAN 08 2010

WATER RESOURCES DEPT
SALEM, OREGON

ON

08-01

Proposed Place of Use

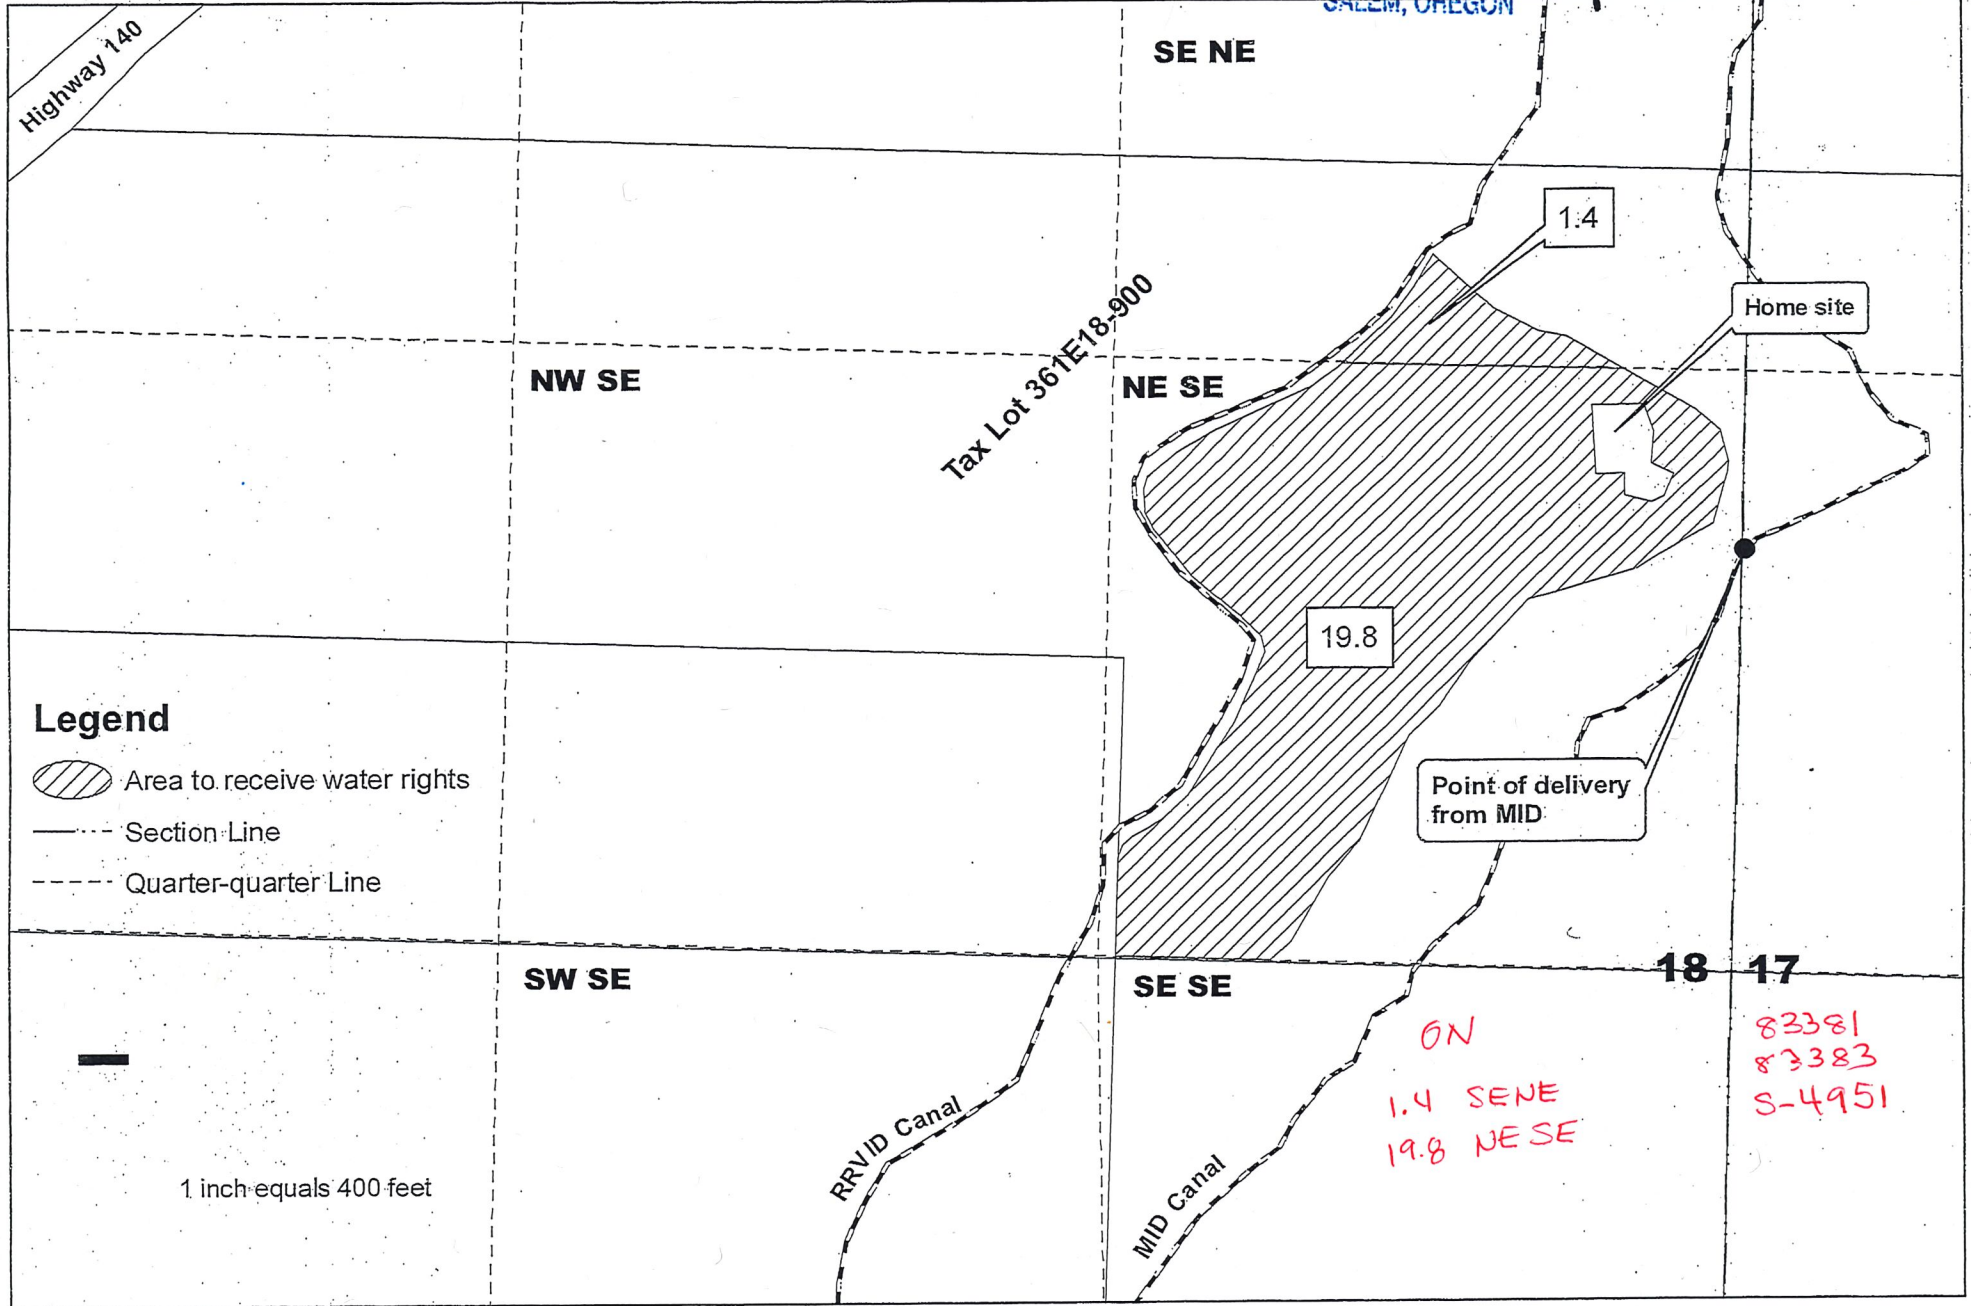


Medford Irrigation District

OFF

Authorized Place of Use
08-02

371W09 tax lot 2700 SWSE

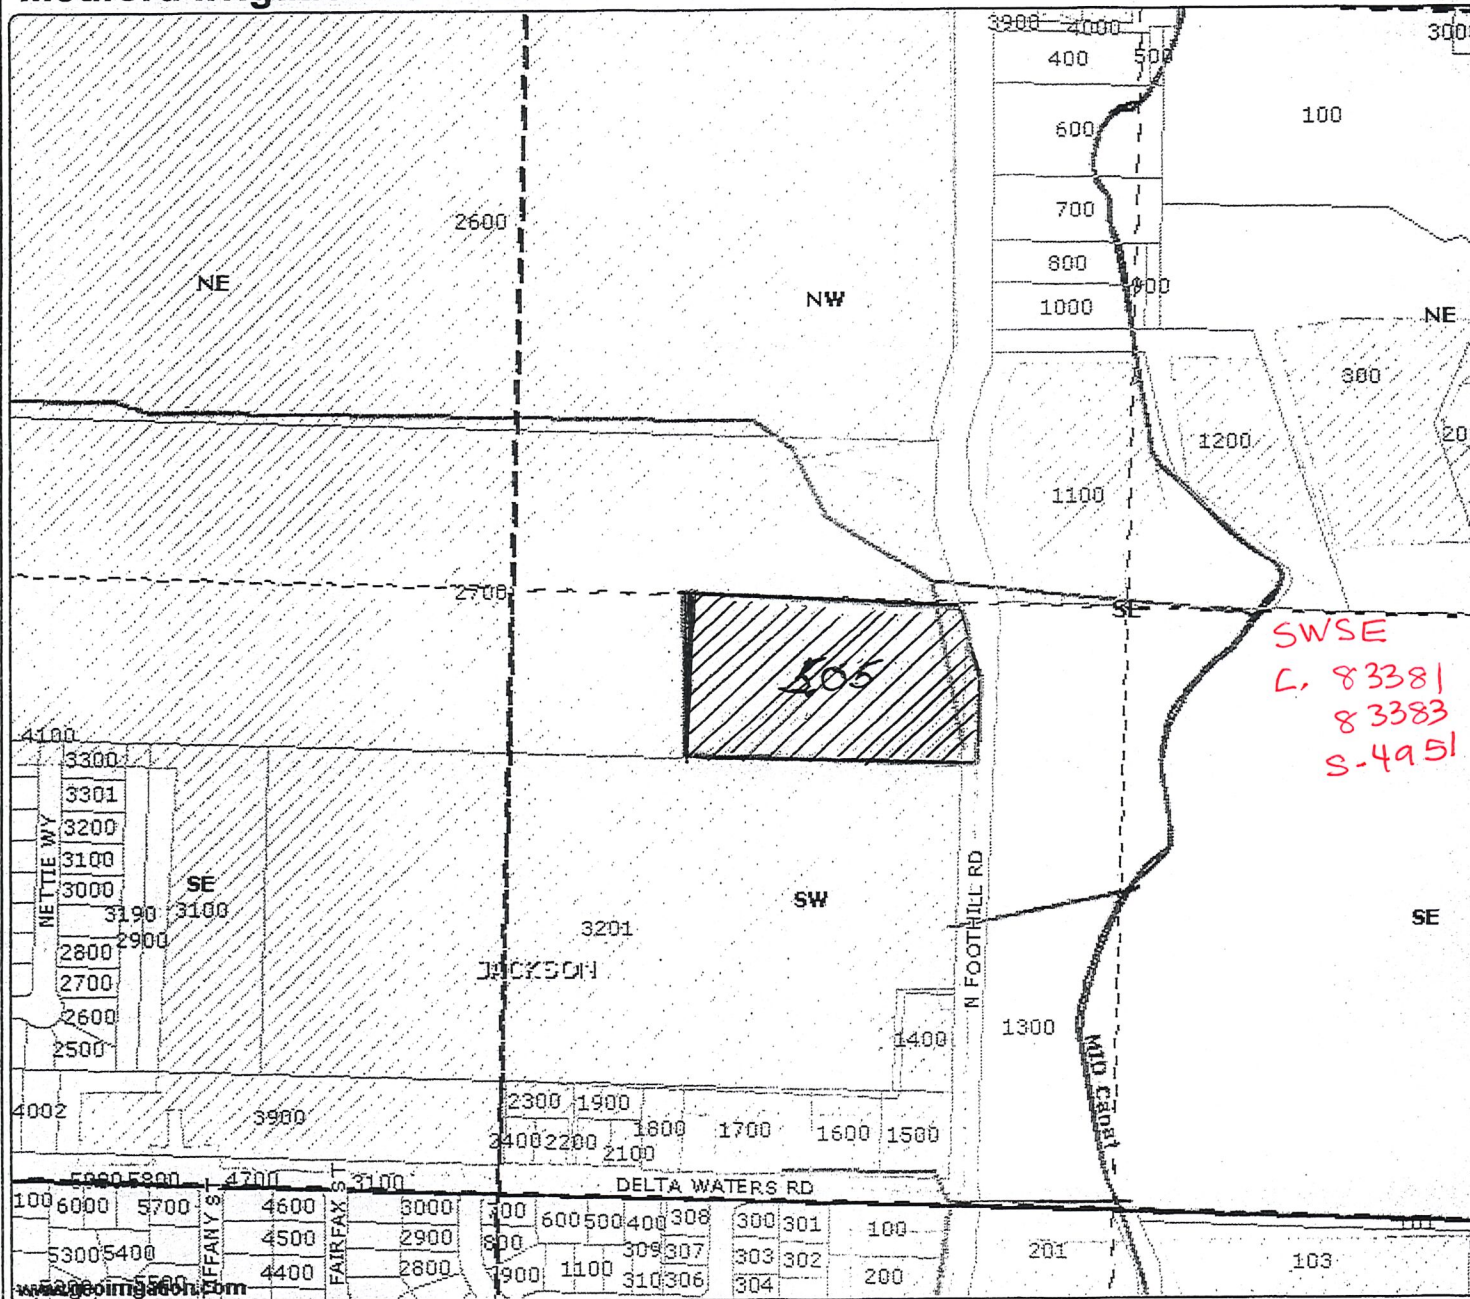

- District Boundary USBR
- County Boundary
- Road Labels
- Township Range
- Sections
- Section Labels
- Quarters
- Quarter Labels
- Quarter Quarters
- Quarter Quarters Labels
- Lot Labels
- Taxlots
- Canal All
- POU District Primary
- Irrigation Ditches JACK CO
- RMCOG Laterals

5.05 AC
To Transfer
OFF



Scale 1" = 400'
Created: 4/20/2009

RECEIVED

JAN 08 2010

WATER RESOURCES DEPT

DISCLAIMER: This map is intended for display purposes only and is not intended for any legal representations. There are no warranties, expressed or implied, that accompany this product.

OFF

08-18 Transfer From:
Medford Irrigation District

37 South, Range 1 West,
Section 21 SWNW 1.95 Acres
Tax Lots 2000, 2001
2002, 2300, 2600

- ☐ District Boundary USBR
- ☐ Road Labels
- ☐ Township Range
- ☐ Sections
- ☐ Section Labels
- ☐ Quarters
- ☐ Quarter Labels
- ☐ Quarter Quarters
- ☐ Quarter Quarters Labels
- ☐ Taxlots
- ☒ Waterbodies JACK CO
- ☐ Irrigation Ditches JACK CO
- ☐ R/COG Laterals
- ☐ Place of Use WORKING

Transfer From
AC
21 BC 2000 - 1.95
21 BC 2300 - .55
21 BC 2600 - .46

RECEIVED

JAN 08 2010
Scale 1" = 400.00'
created: 6/16/2006
WATER RESOURCES DEPT
SALEM, OREGON



www.geolrrigation.com


DISCLAIMER: This map is intended for display purposes only and is not intended for any legal representations.
There are no warranties, expressed or implied, that accompany this product.

Powered By
geolrrigation

JAN 08 2010

WATER RESOURCES DEPT
SALEM, OREGON

Proposed Place of Use
ON 08-02

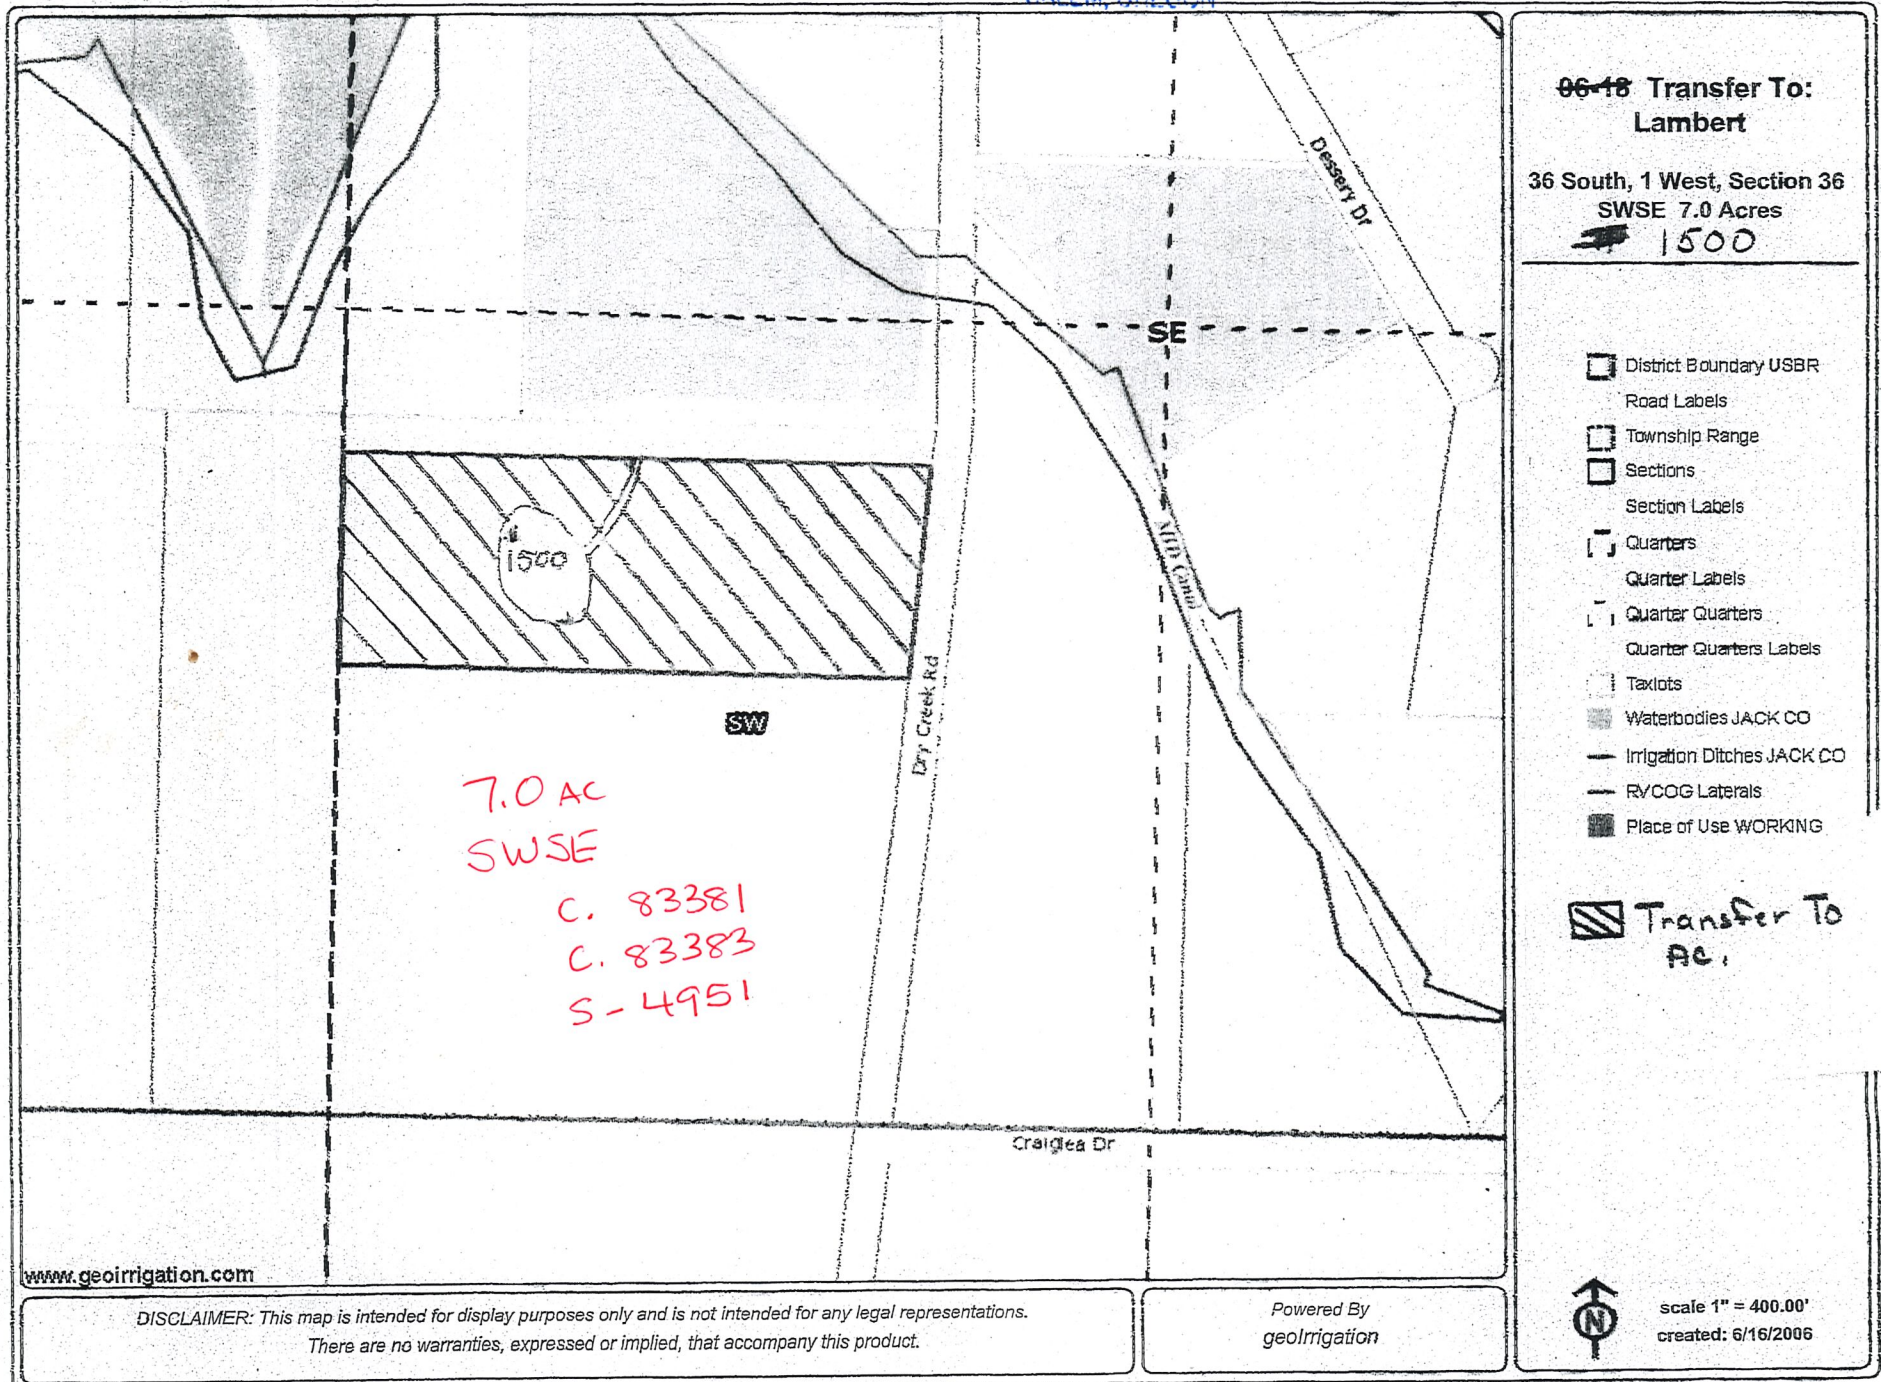

08-03
Authorized Place of Use



Powered By
geolrrigation

WATER RESOURCES DEPT
SALEM, OREGON



scale 1" = 400.00'
created: 3/27/2006

6N

08-03

Proposed
Place of Use

Transfer To:
RIBAL

37S 2W 20 AA TL 300
NENE
300

- District Boundary USBR
- Road Labels
- Township Range
- Sections
- Section Labels
- Quarters
- Quarter Labels
- Quarter Quarters
- Quarter Quarters Labels
- Lot Labels
- Taxlots
- Waterbodies JACK CO
- Irrigation Ditches JACK CO
- Place of Use WORKING

2.54 Irr. ACs

RECEIVED

JAN 08 2010

WATER RESOURCES DEPT
SALEM, OREGON




scale 1" = 400.00'
created: 3/27/2006



OFF

08-04

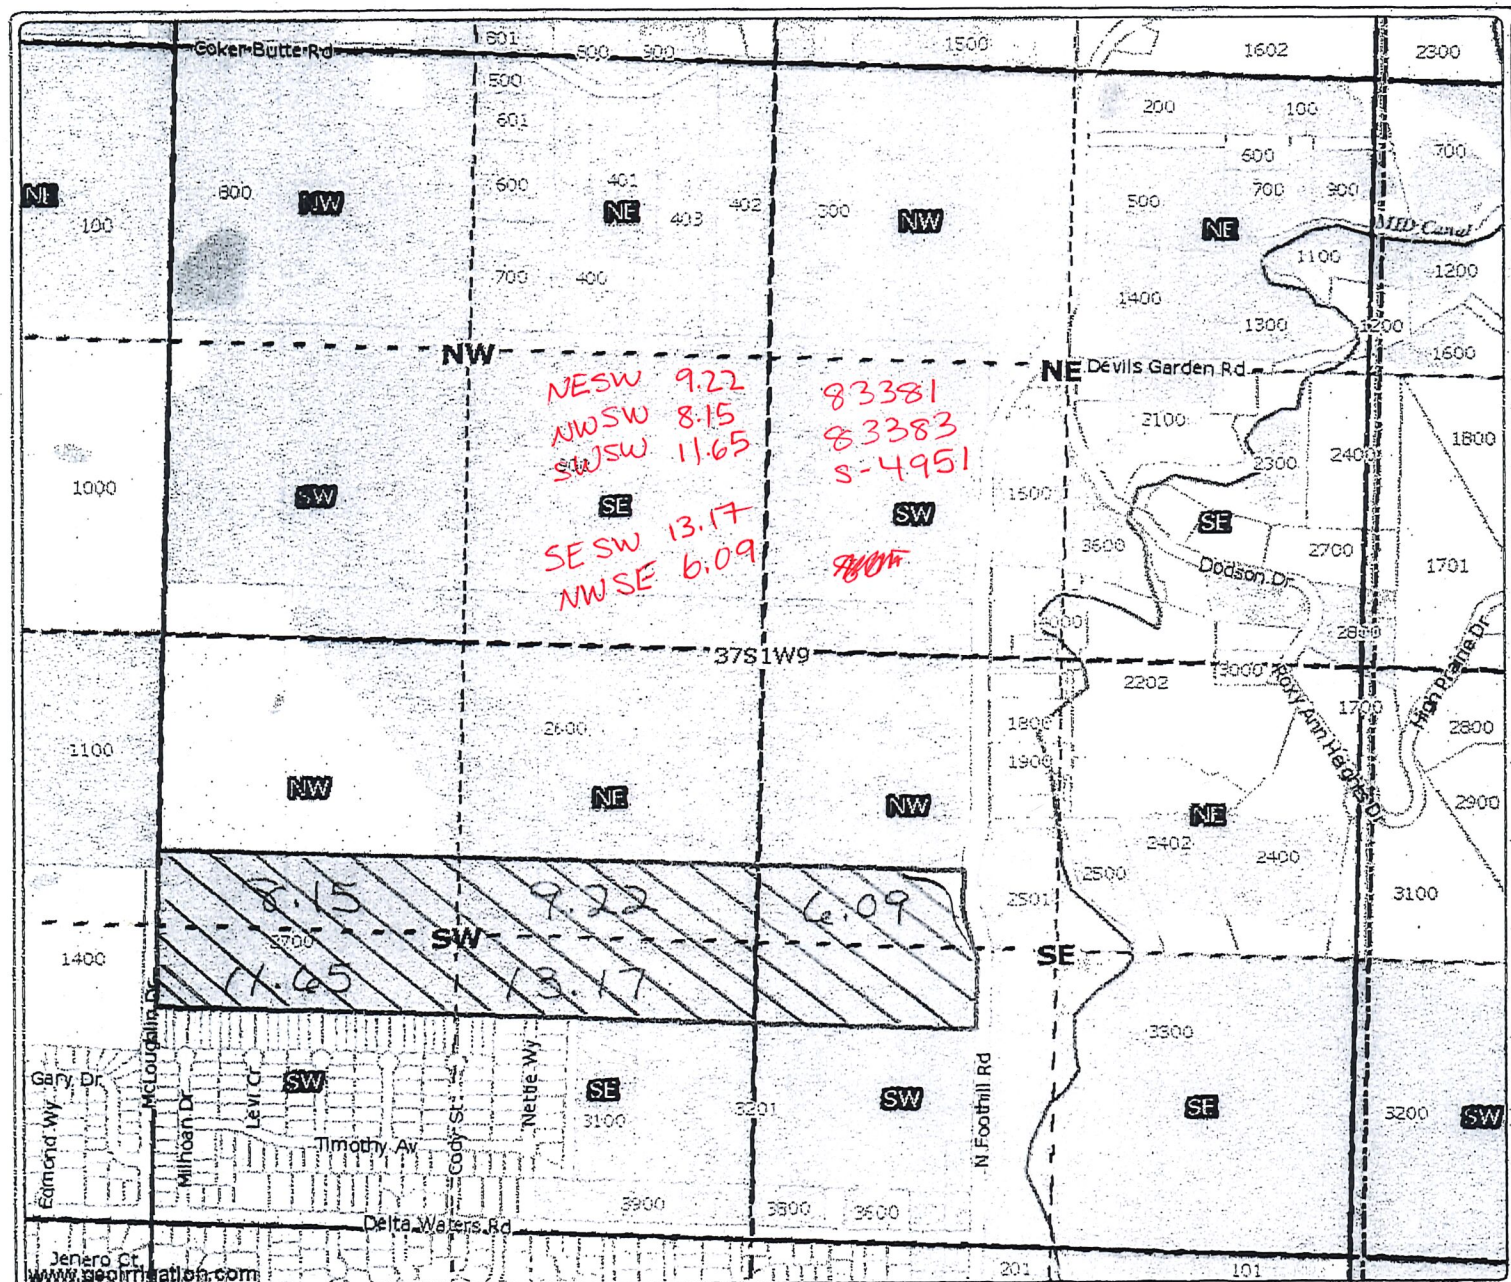

Transfer From Land:
37S 1W 09 TL 2700
48.28 AC.

- District Boundary USBR
- Road Labels
- Township Range
- Sections
- Section Labels
- Quarters
- Quarter Labels
- Quarter Quarters
- Quarter Quarters Labels
- Lot Labels
- Taxlots
- Waterbodies JACK CO
- Irrigation Ditches JACK CO
- Place of Use WORKING
- Transfer From AC

RECEIVED

JAN 08 2010

WATER RESOURCES DEPT
SALEM, OREGON



scale 1" = 1,092.30'
created: 4/13/2006

DISCLAIMER: This map is intended for display purposes only and is not intended for any legal representations.
There are no warranties, expressed or implied, that accompany this product.

Powered By
geolirrigation


ON

08-04

Medford Irrigation District

Proposed Place of Use Elliott

361E tax lot 12900
48 ac

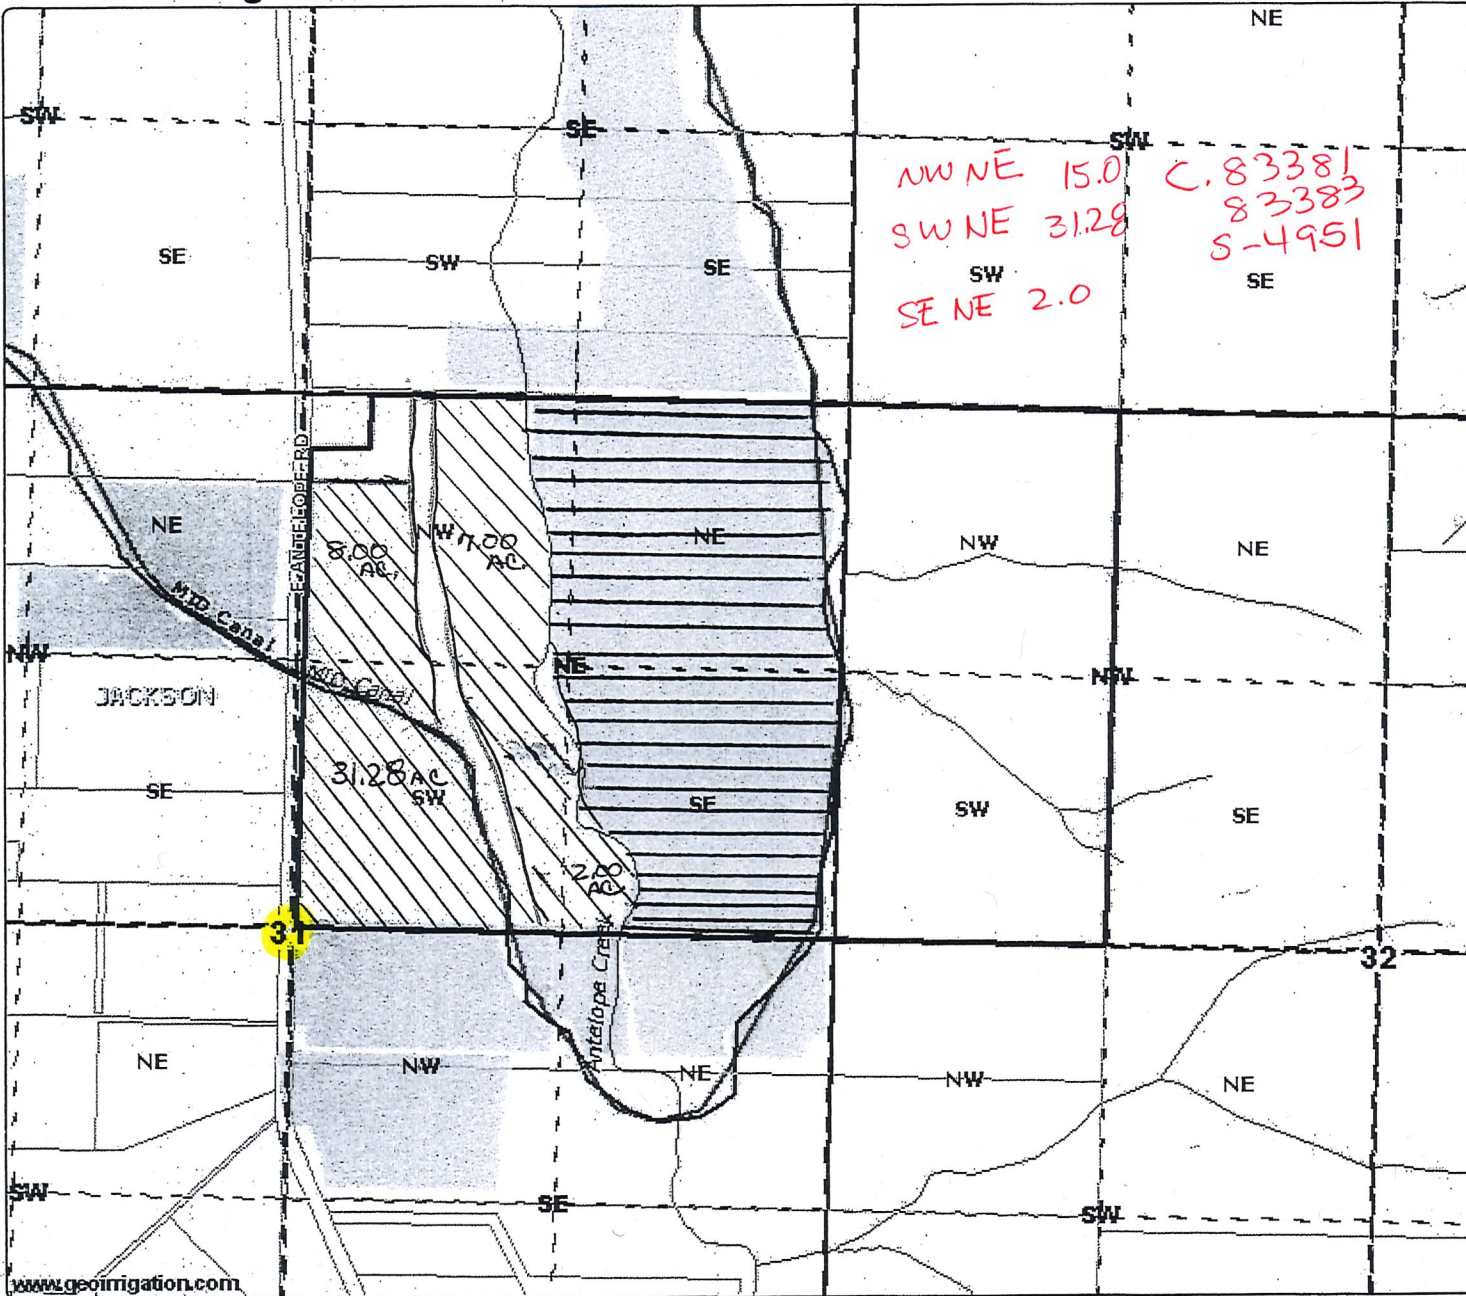

- District Boundary USBR
- County Boundary
- Road Labels
- Township Range
- Sections
- Section Labels
- Quarters
- Quarter Labels
- Quarter Quarters
- Quarter Quarters Labels
- Taxlots
- Rivers JACK CO
- Waterbodies JACK CO
- Irrigation Ditches JACK CO
- RVCOG Laterals
- Water Rights OLD
- Water Rights NEW

Proposed Ac. To irrigate

Irrigated Ac. RECEIVED

JAN 08 2010


WATER RESOURCES DEPT
SALEM, OREGON
Scale 1" = 900'
Created: 6/5/2008

www.geoirrigation.com

DISCLAIMER: This map is intended for display purposes only and is not intended for any legal representations. There are no warranties, expressed or implied, that accompany this product.

06-15 Transfer To:

08-04

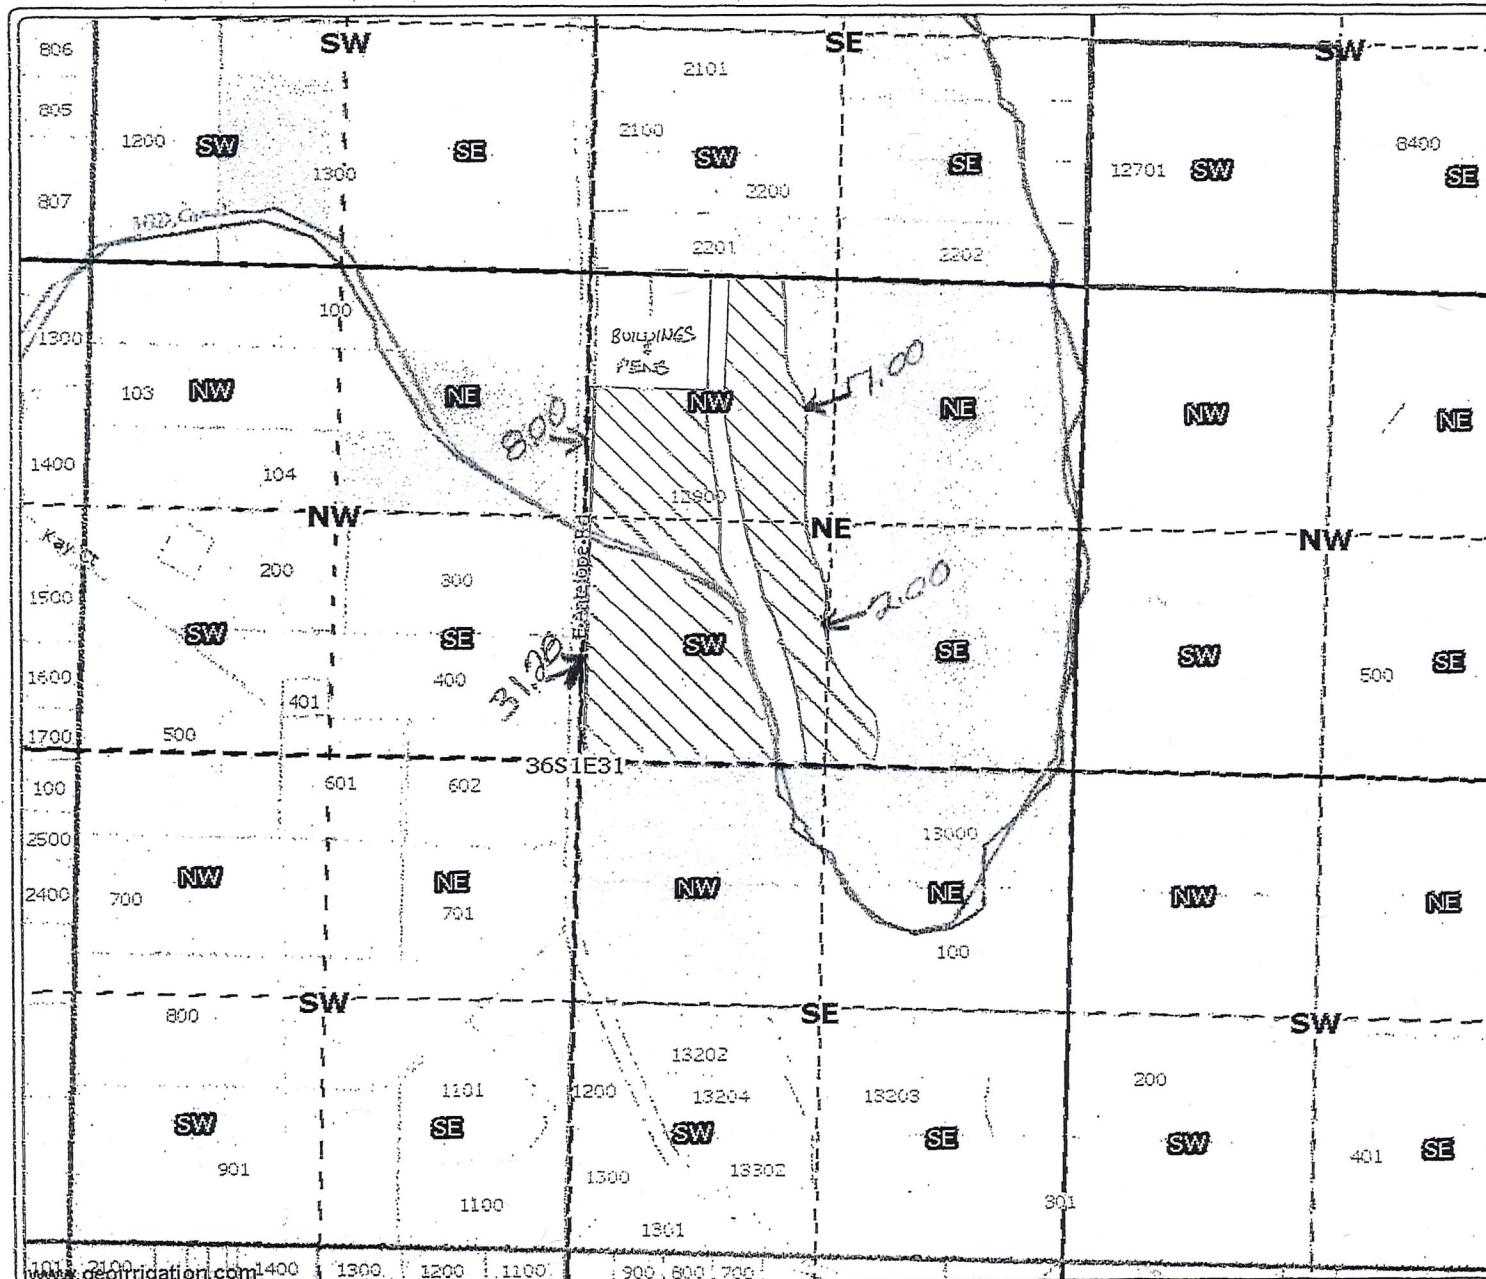

Requesting Water
Right ELLIOTT
361E 12900
48.0 Acres

- ☐ District Boundary USBR
- Road Labels
- ☐ Township Range
- ☐ Sections
- Section Labels
- ☐ Quarters
- Quarter Labels
- ☐ Quarter Quarters
- Quarter Quarters Labels
- Lot Labels
- Taxlots
- Waterbodies JACK CO
- Irrigation Ditches JACK CO
- RYCOG Laterals
- ☒ Place of Use WORKING

Jon C/Dorothy L. (Son)
ELLIOTT

361E 12900
3355 E. Antelope Rd.
Eagle Point, OR 97524

☒ Transfer To.
☒ UNDER WATER RIGHT
21 Florence Ave.
Medford, OR 97504



scale 1" = 1,320.00'
created: 3/13/2006

DISCLAIMER: This map is intended for display purposes only and is not intended for any legal representations.
There are no warranties, expressed or implied, that accompany this product.


RECEIVED
powered by
geolrrigation

JAN 08 2010

WATER RESOURCES DEPT

OFF

08-05

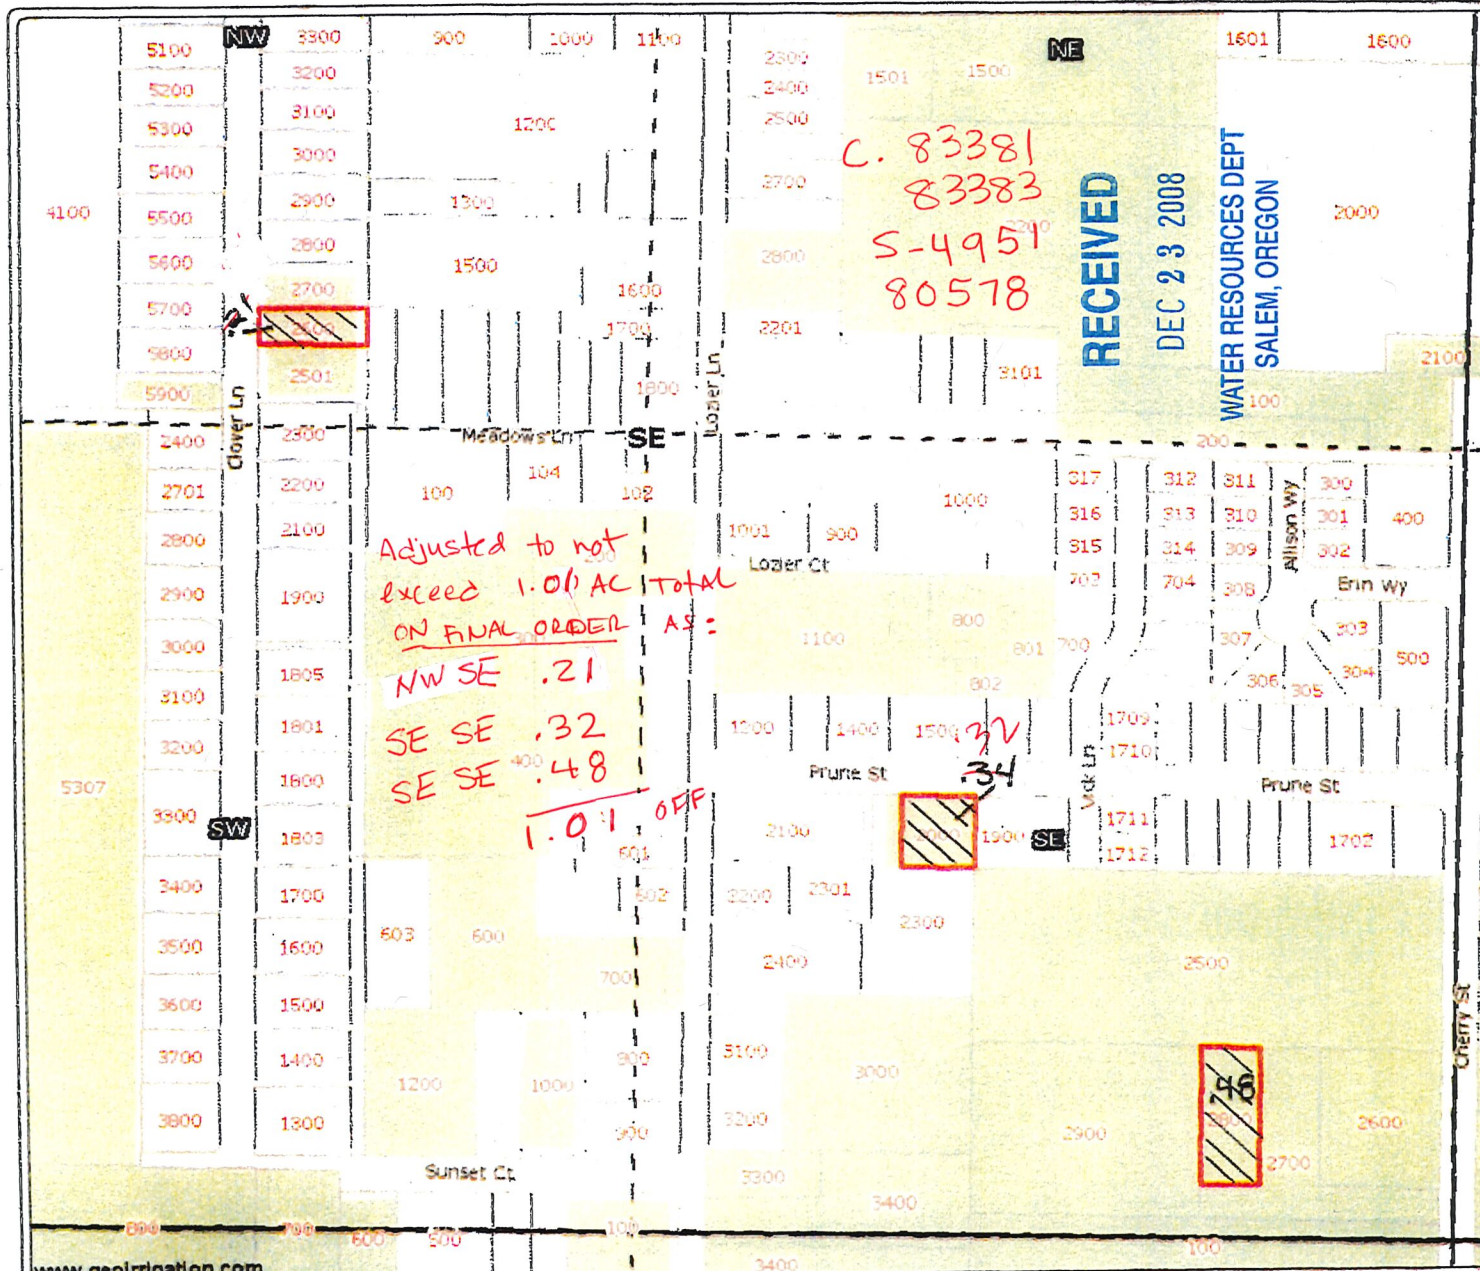

06-13 Transfer From: Medford Irrigation District

37 South, Range 2 West,
Section 26 NWSE & SESE

- District Boundary USBR
- Road Labels
- Township Range
- Sections
- Section Labels
- Quarters
- Quarter Labels
- Quarter Quarters
- Quarter Quarters Labels
- Lot Labels
- Taxlots
- Waterbodies JACK CO
- Irrigation Ditches JACK CO
- Place of Use WORKING

Transfer From

2600 = .21 AC
2000 = .32 AC
2800 = .48 AC
Total 1.01 AC

www.geolrrigation.com

DISCLAIMER: This map is intended for display purposes only and is not intended for any legal representations.
There are no warranties, expressed or implied, that accompany this product.

Powered By
geolrrigation




scale 1" = 400.00'
created: 6/14/2006

ON

Proposed Place of Use.

08-05

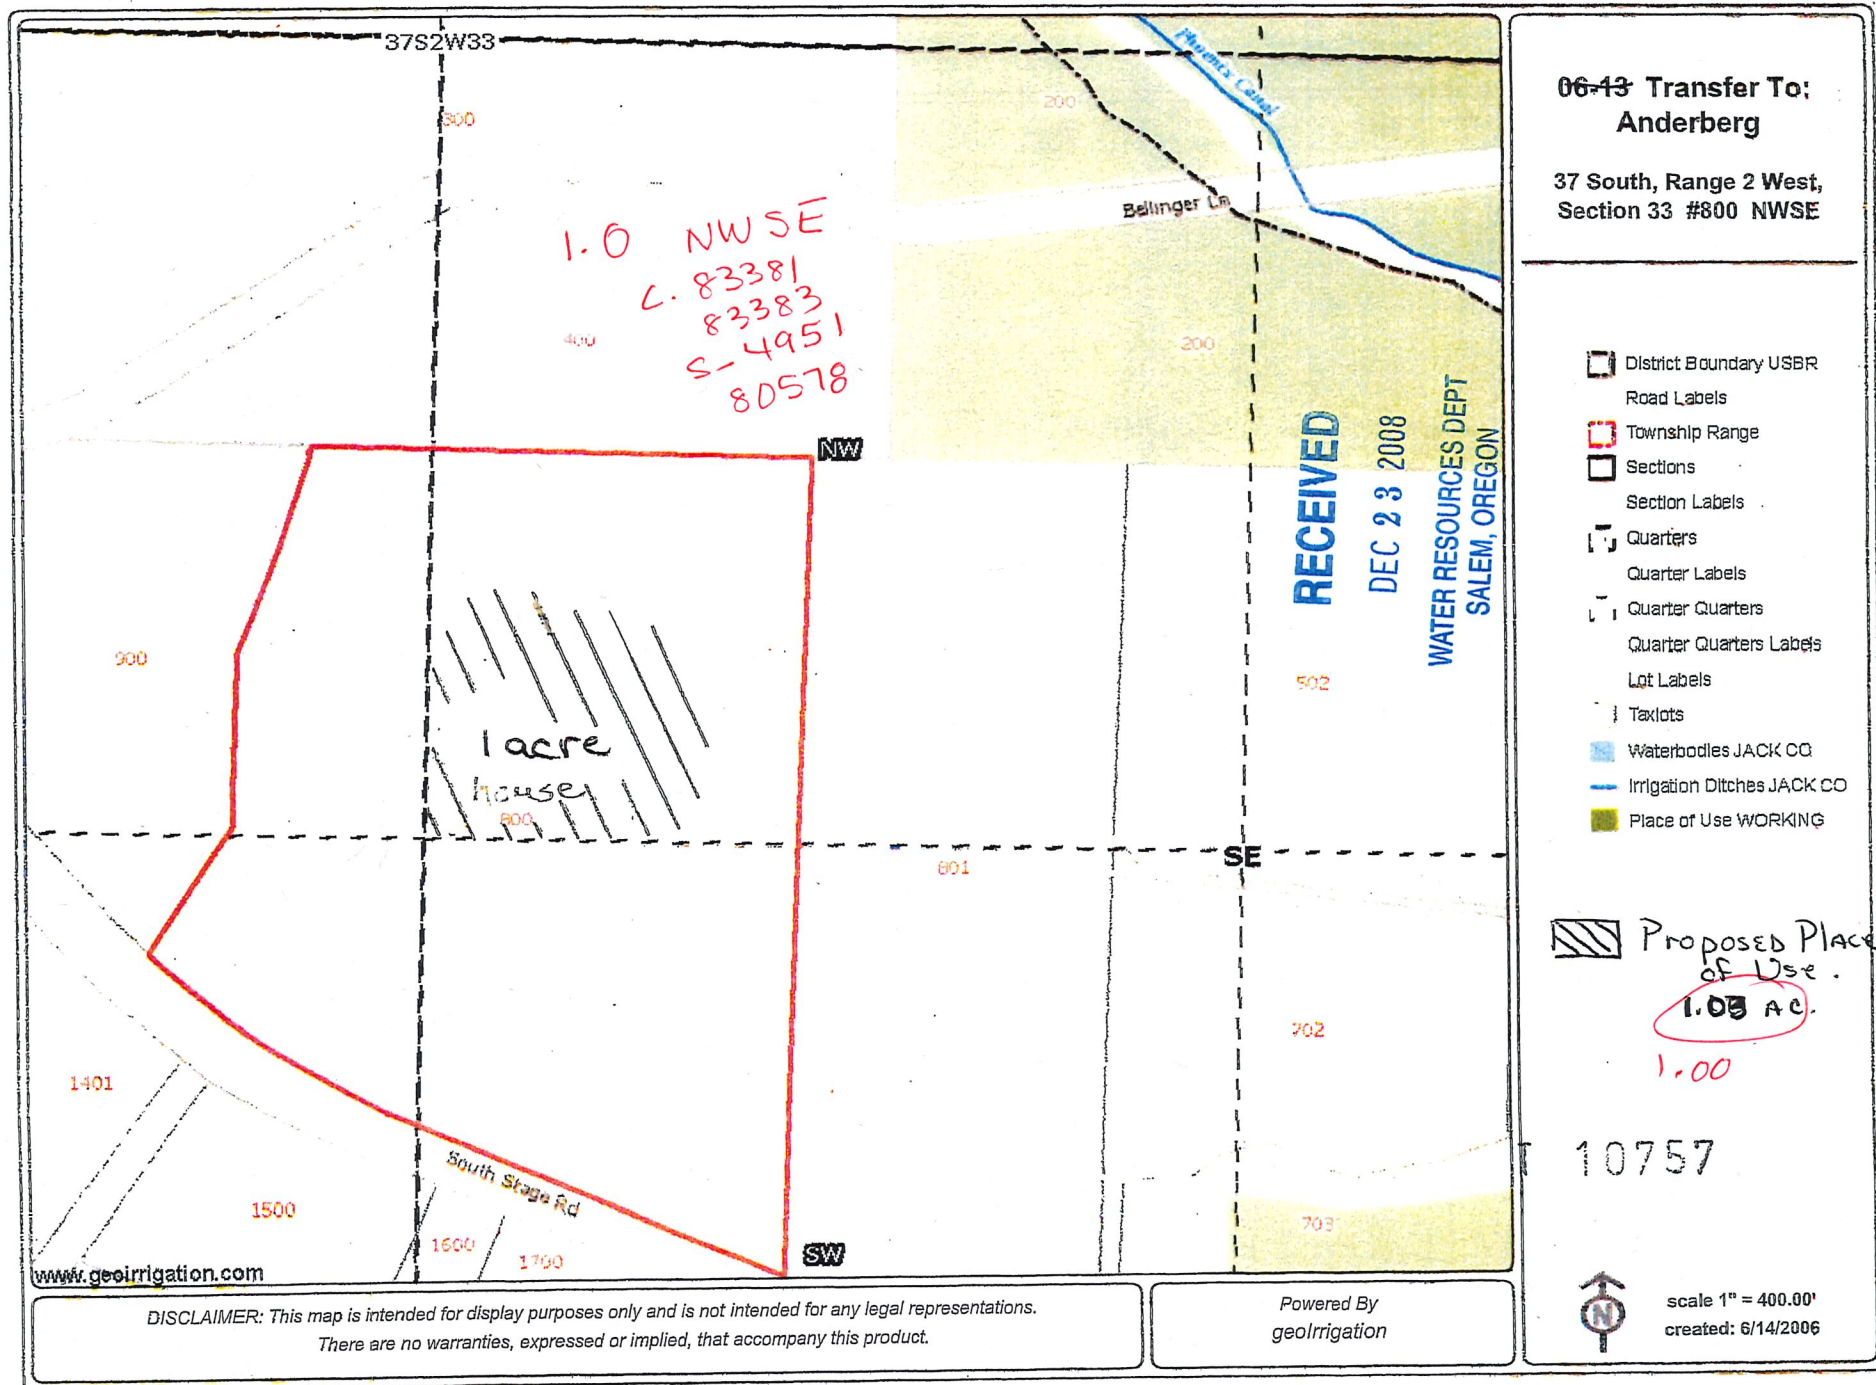

2)

OFF

08-06

Authorized Place of Use

00-03 Transfer From:
Jirsa

37S 2W 26 NWNE 2.65 Acres
& NENE .78 Acres

Tax Lot 700
Before Divided.

- ☐ District Boundary USBR
- ☐ Road Labels
- ☐ Township Range
- ☐ Sections
- ☐ Section Labels
- ☐ Quarters
- ☐ Quarter Labels
- ☐ Quarter Quarters
- ☐ Quarter Quarters Labels
- ☐ Lot Labels
- ☐ Taxlots
- ☐ Waterbodies JACK CO
- ☐ Irrigation Ditches JACK CO
- ☐ Place of Use WORKING

Transfer From


RECEIVED

JAN 08 2010

WATER RESOURCES DEPT
SALEM, OREGON



scale 1" = 400.00'
created: 3/29/2006

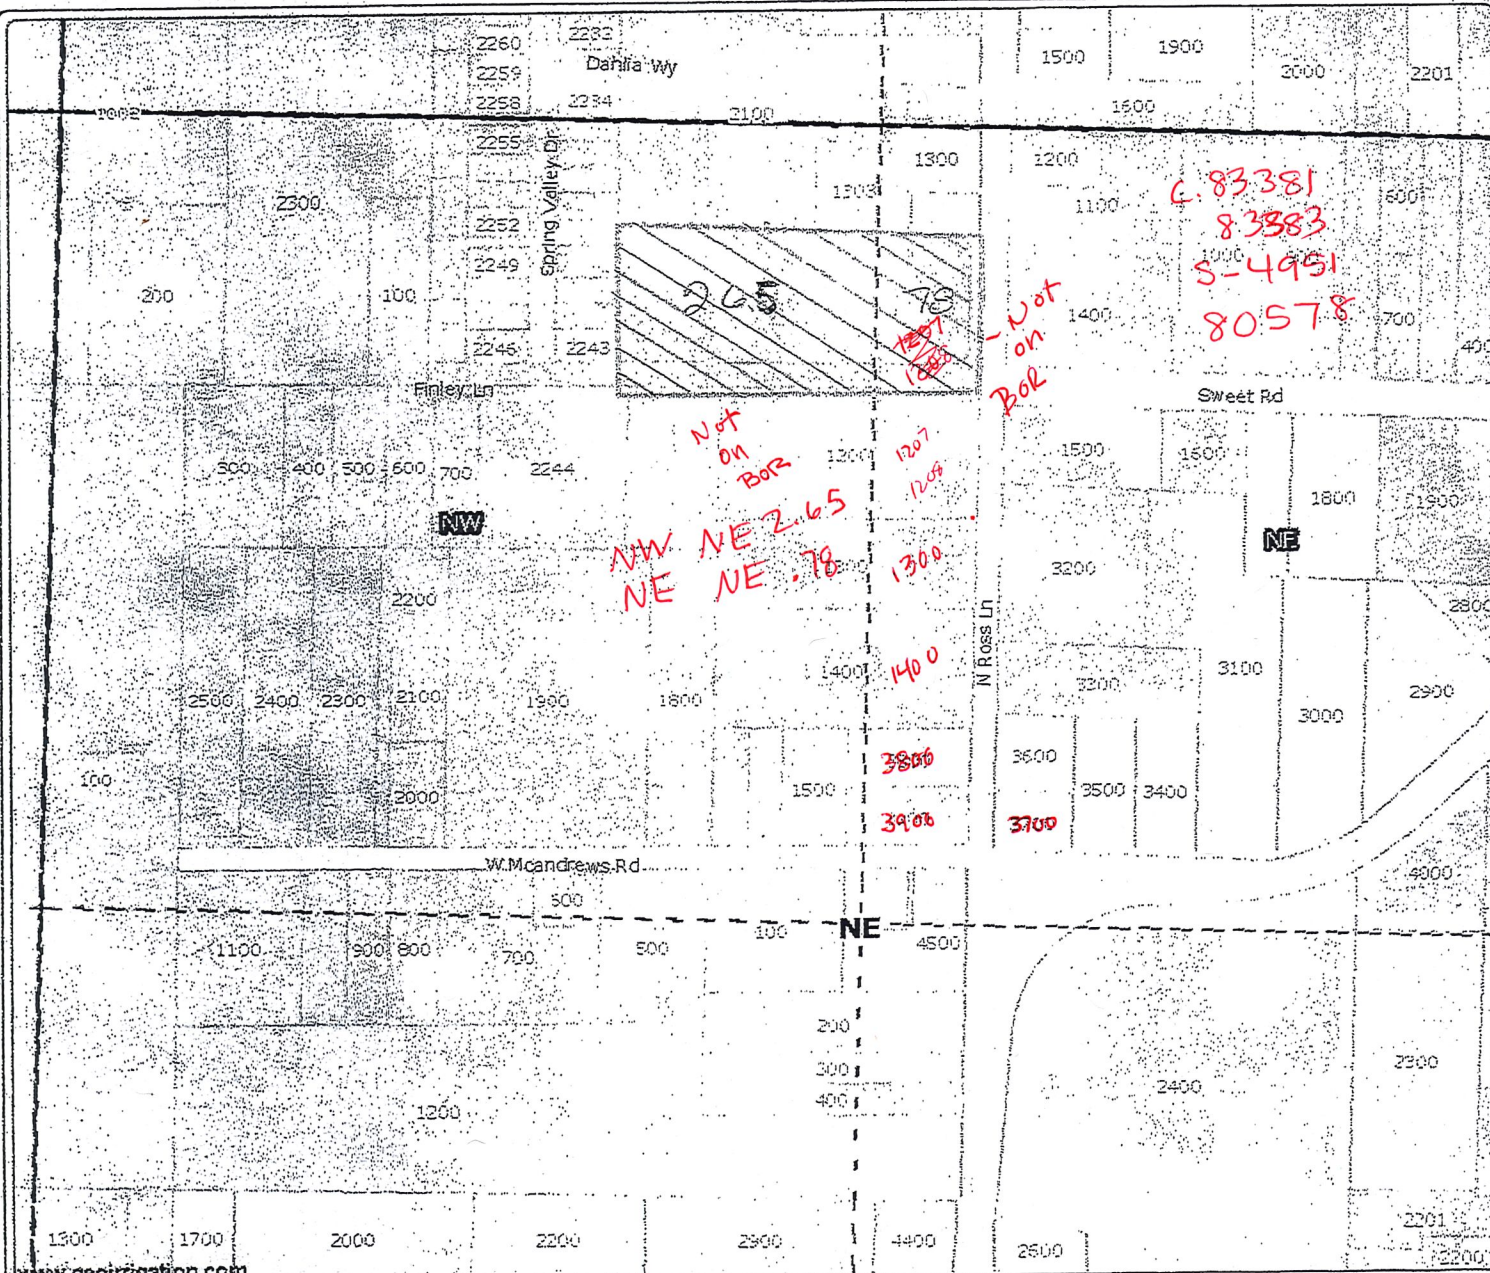

DISCLAIMER: This map is intended for display purposes only and is not intended for any legal representations.
There are no warranties, expressed or implied, that accompany this product.

Powered By
geoirrigation

17.9
20.0

OFF

Authorized Place of Use

08-06

Transfer From:

37S 2W 23 NESE

0.16 & 0.15 Acres

Tx Lot # 5000,
5100

- ☐ District Boundary USBR
- ☐ Road Labels
- ☐ Township Range
- ☐ Sections
- ☐ Section Labels
- ☐ Quarters
- ☐ Quarter Labels
- ☐ Quarter Quarters
- ☐ Quarter Quarters Labels
- ☐ Lot Labels
- ☐ Taxlots
- ☐ Waterbodies JACK CO
- ☐ Irrigation Ditches JACK CO
- ☐ Place of Use WORKING

Transfer OFF

.16
.15

.31 exceeds cent.


RECEIVED

JAN 08 2010

WATER RESOURCES DEPT
SALEM, OREGON



scale 1" = 400.00'
created: 3/29/2006

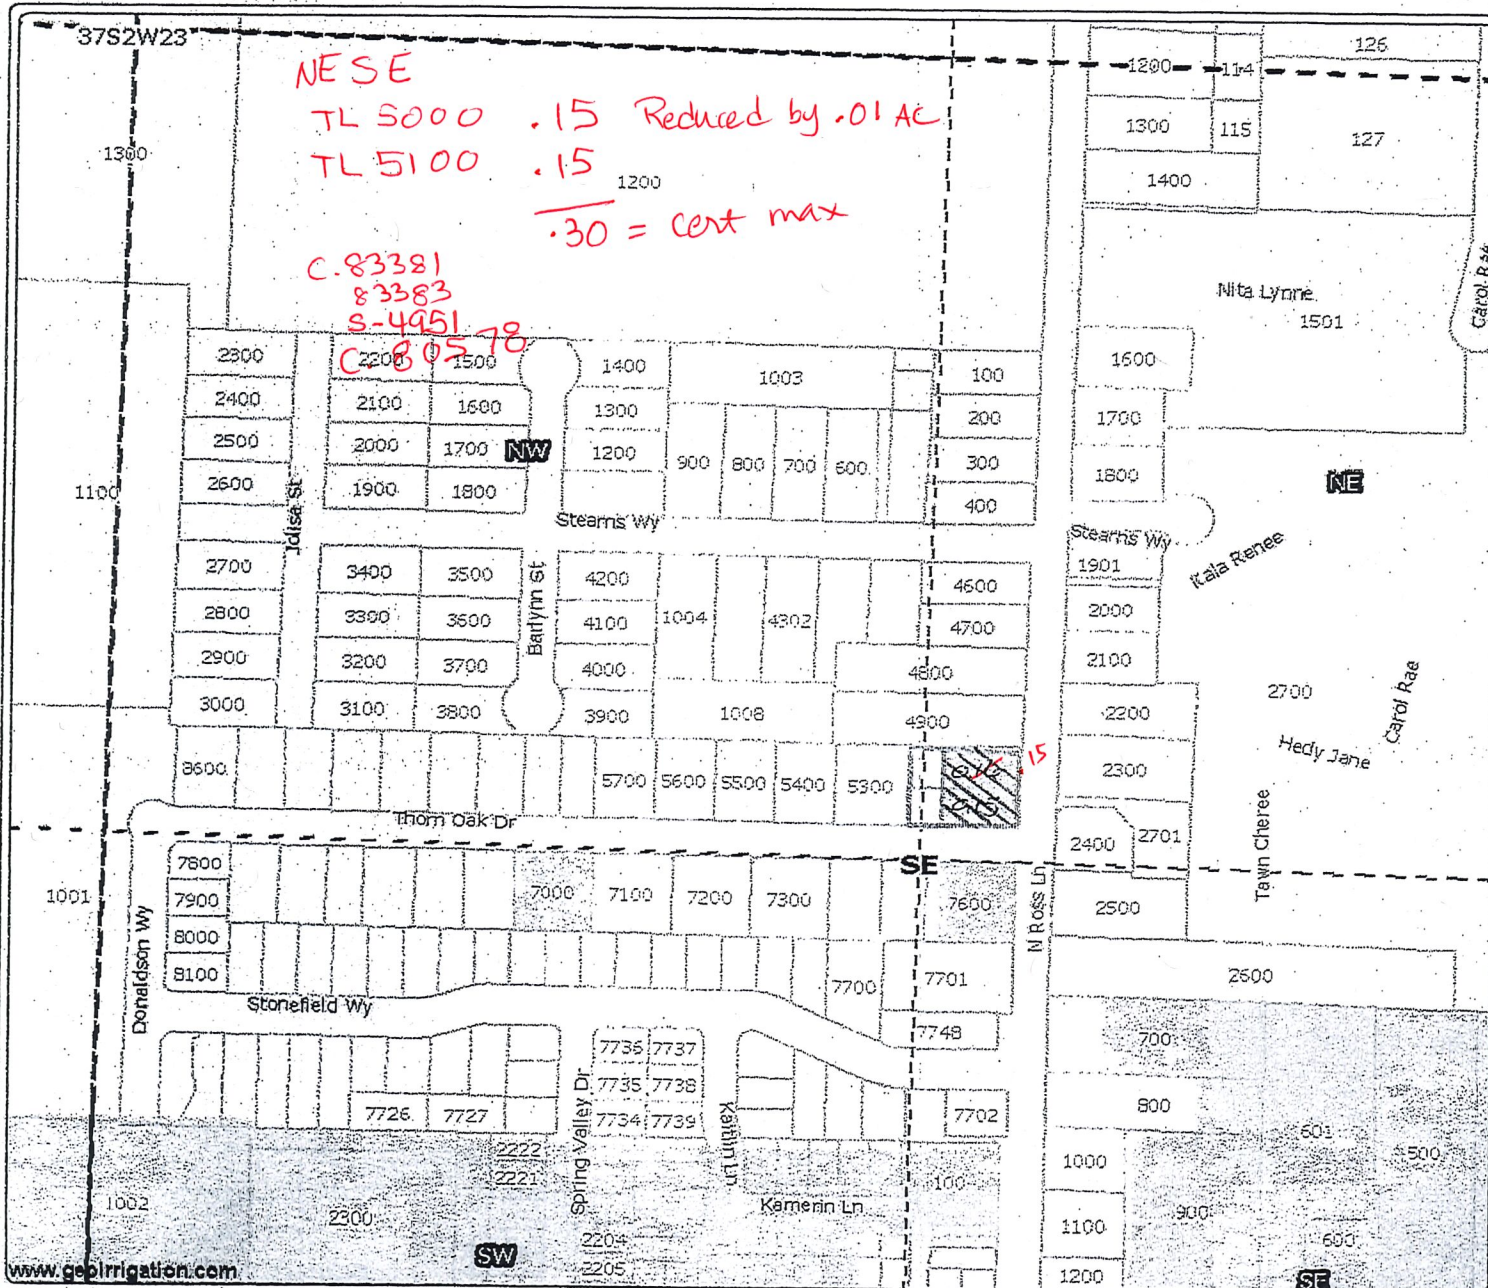

www.geolrrigation.com

DISCLAIMER: This map is intended for display purposes only and is not intended for any legal representations.
There are no warranties, expressed or implied, that accompany this product.

Powered By
geolrrigation


3)

OFF

08-06

Medford Irrigation District

Authorized Place of Use
372W23DB #7000

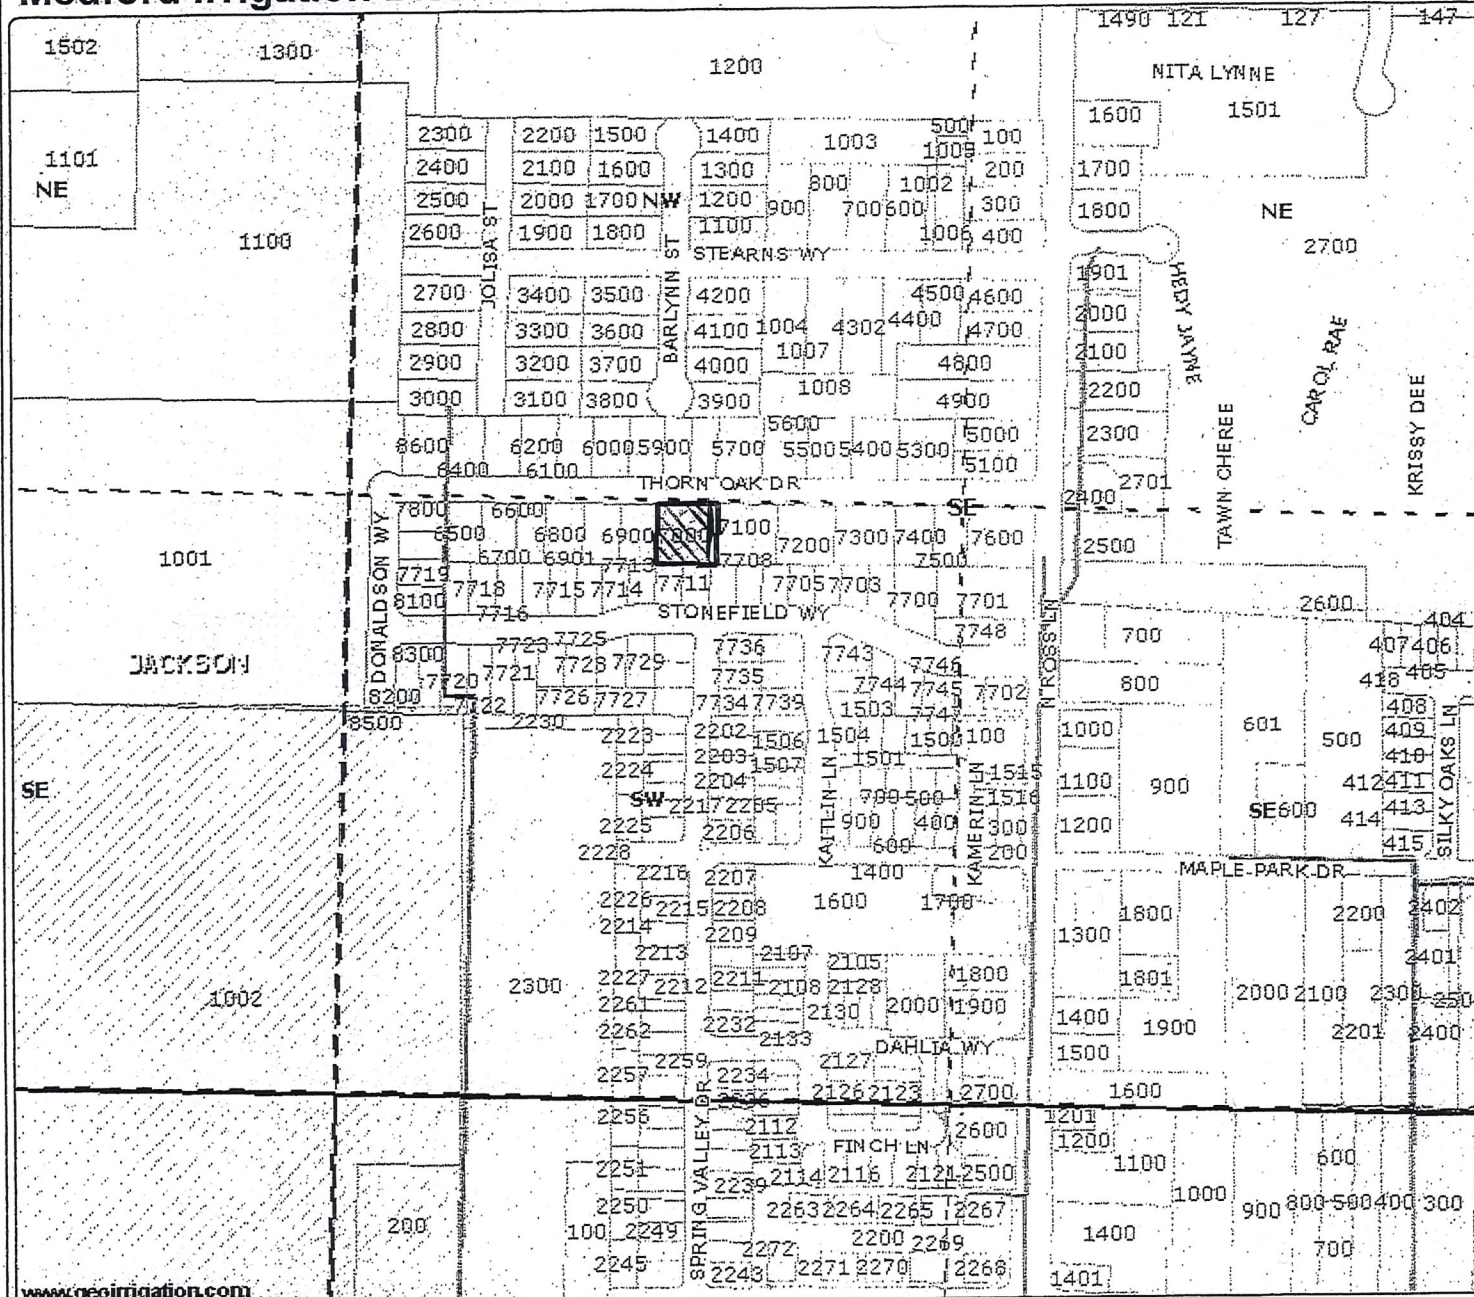

SWSE C. 83381
83383
3.31 ac To 8-4951
Transfer 80578
only

RECEIVED

JAN 08 2010

WATER RESOURCES DEPT
SALEM, OREGON



Scale 1" = 400'
Created: 12/28/2009

www.geoirrigation.com

DISCLAIMER: This map is intended for display purposes only and is not intended for any legal representations. There are no warranties, expressed or implied, that accompany this product.

ON

08-06

Proposed Place of Use

Transfer To :
TURNER

37S 2W 17 TL 3603

3.73 AC

4.05 AC TOTAL

- District Boundary USBR
- Road Labels
- Township Range
- Sections
- Section Labels
- Quarters
- Quarter Labels
- Quarter Quarters
- Quarter Quarters Labels
- Lot Labels
- Taxlots
- Waterbodies JACK CO
- Irrigation Ditches JACK CO
- RVCOG Laterals
- Place of Use WORKING

Proposed Place of Use


RECEIVED

JAN 08 2010

WATER RESOURCES DEPT
SALEM, OREGON



scale 1" = 400.00'
created: 3/24/2006

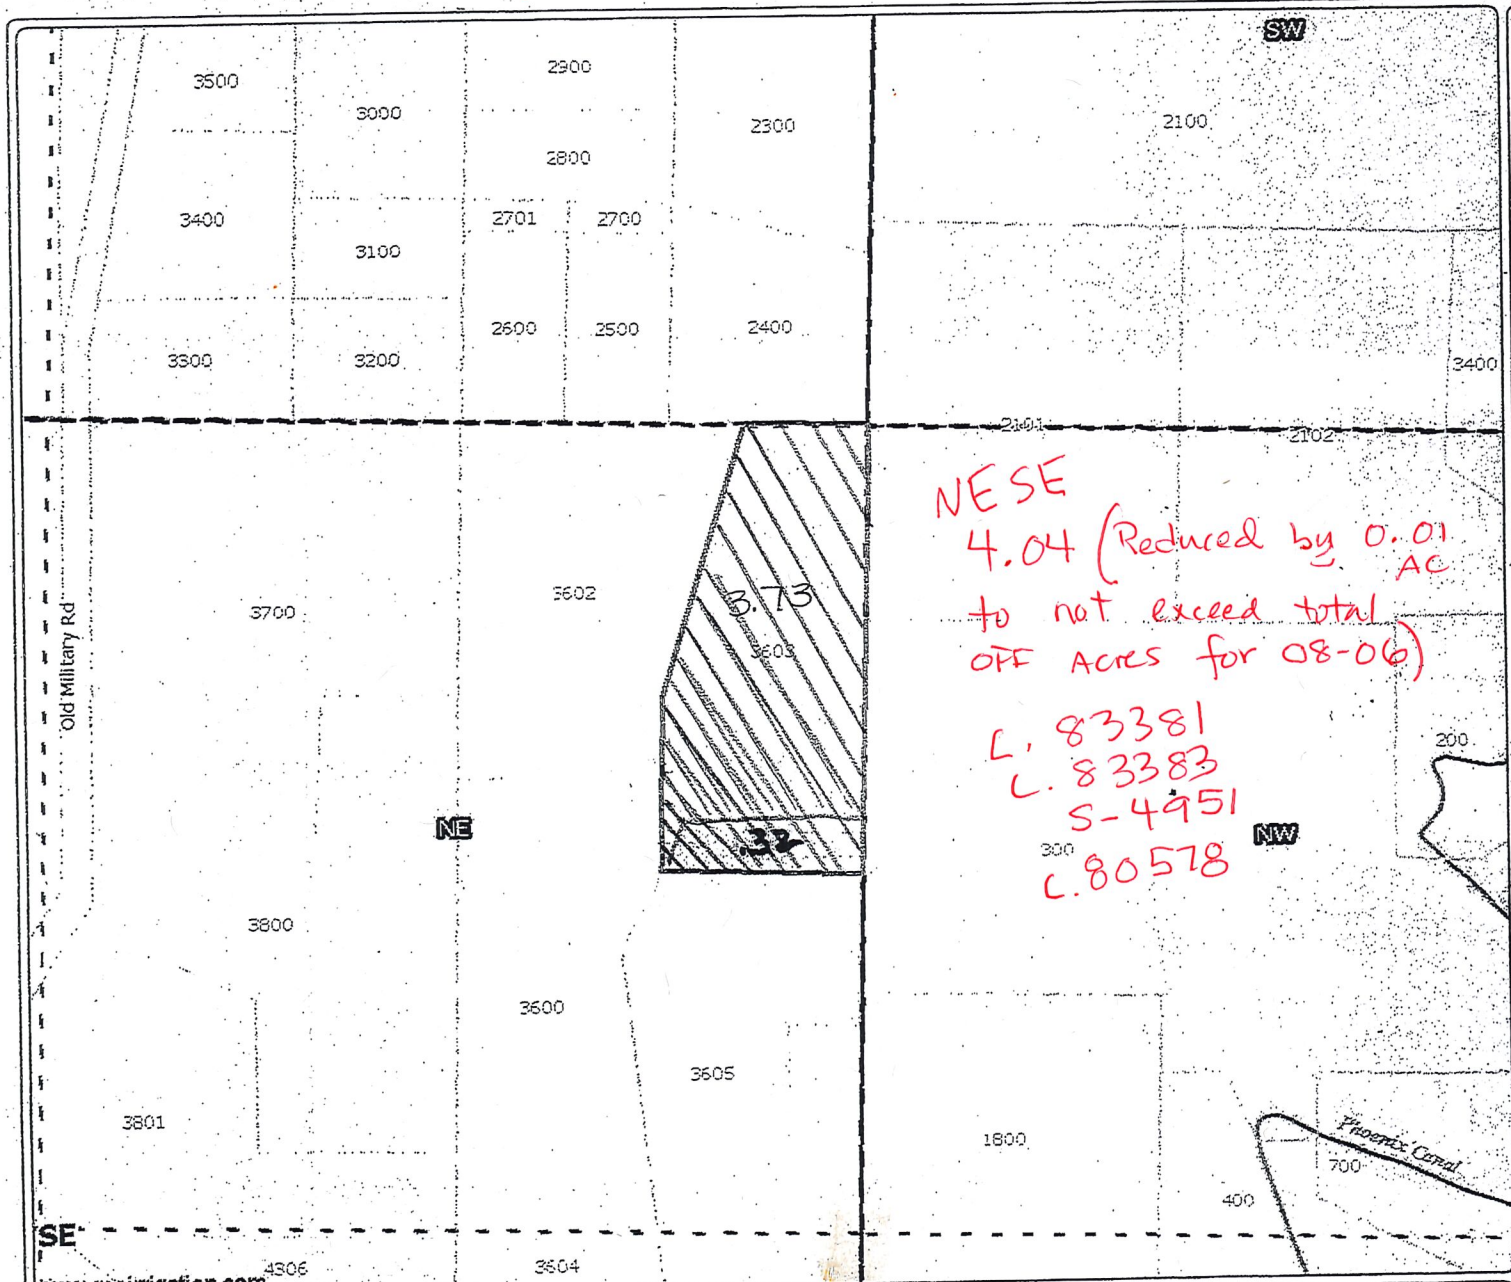


www.geoirrigation.com

DISCLAIMER: This map is intended for display purposes only and is not intended for any legal representations.
There are no warranties, expressed or implied, that accompany this product.

Powered By
geoirrigation

OFF

Authorized Place of Use

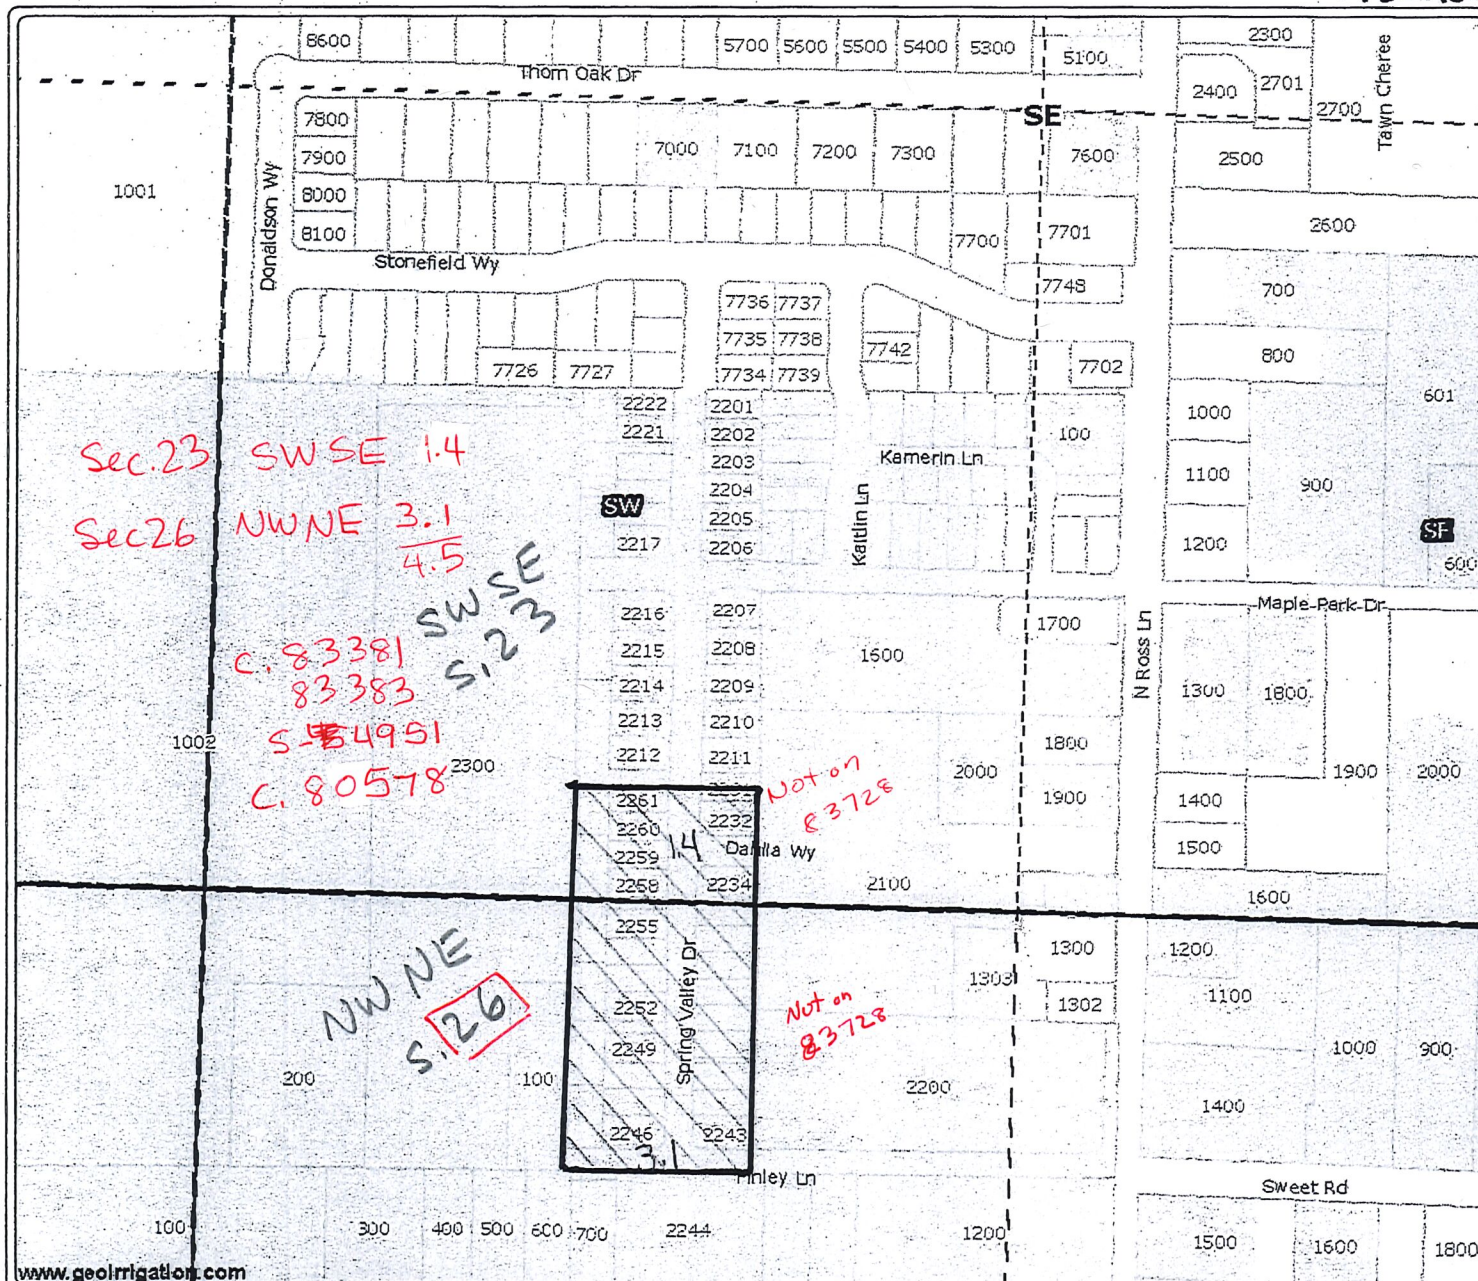

08-07
06-02 Transfer From:
JIRSA

37S 2W 23 - 37S 2W 26
4.50 Acres

Tax Lot # 700

SWSE
NWNE

- ☐ District Boundary USBR
- ☐ Road Labels
- ☐ Township Range
- ☐ Sections
- ☐ Section Labels
- ☐ Quarters
- ☐ Quarter Labels
- ☐ Quarter Quarters
- ☐ Quarter Quarters Labels
- ☐ Lot Labels
- ☐ Taxlots
- ☐ Waterbodies JACK CO
- ☐ Irrigation Ditches JACK CO
- ☐ Place of Use WORKING

Transfer Off
Before
Divided.

RECEIVED

JAN 08 2010

WATER RESOURCES DEPT
SALEM, OREGON



scale 1" = 400.00'
created: 3/24/2006


www.geolrrigation.com

DISCLAIMER: This map is intended for display purposes only and is not intended for any legal representations.
There are no warranties, expressed or implied, that accompany this product.

Powered By
geolrrigation

ON

Proposed Place of Use

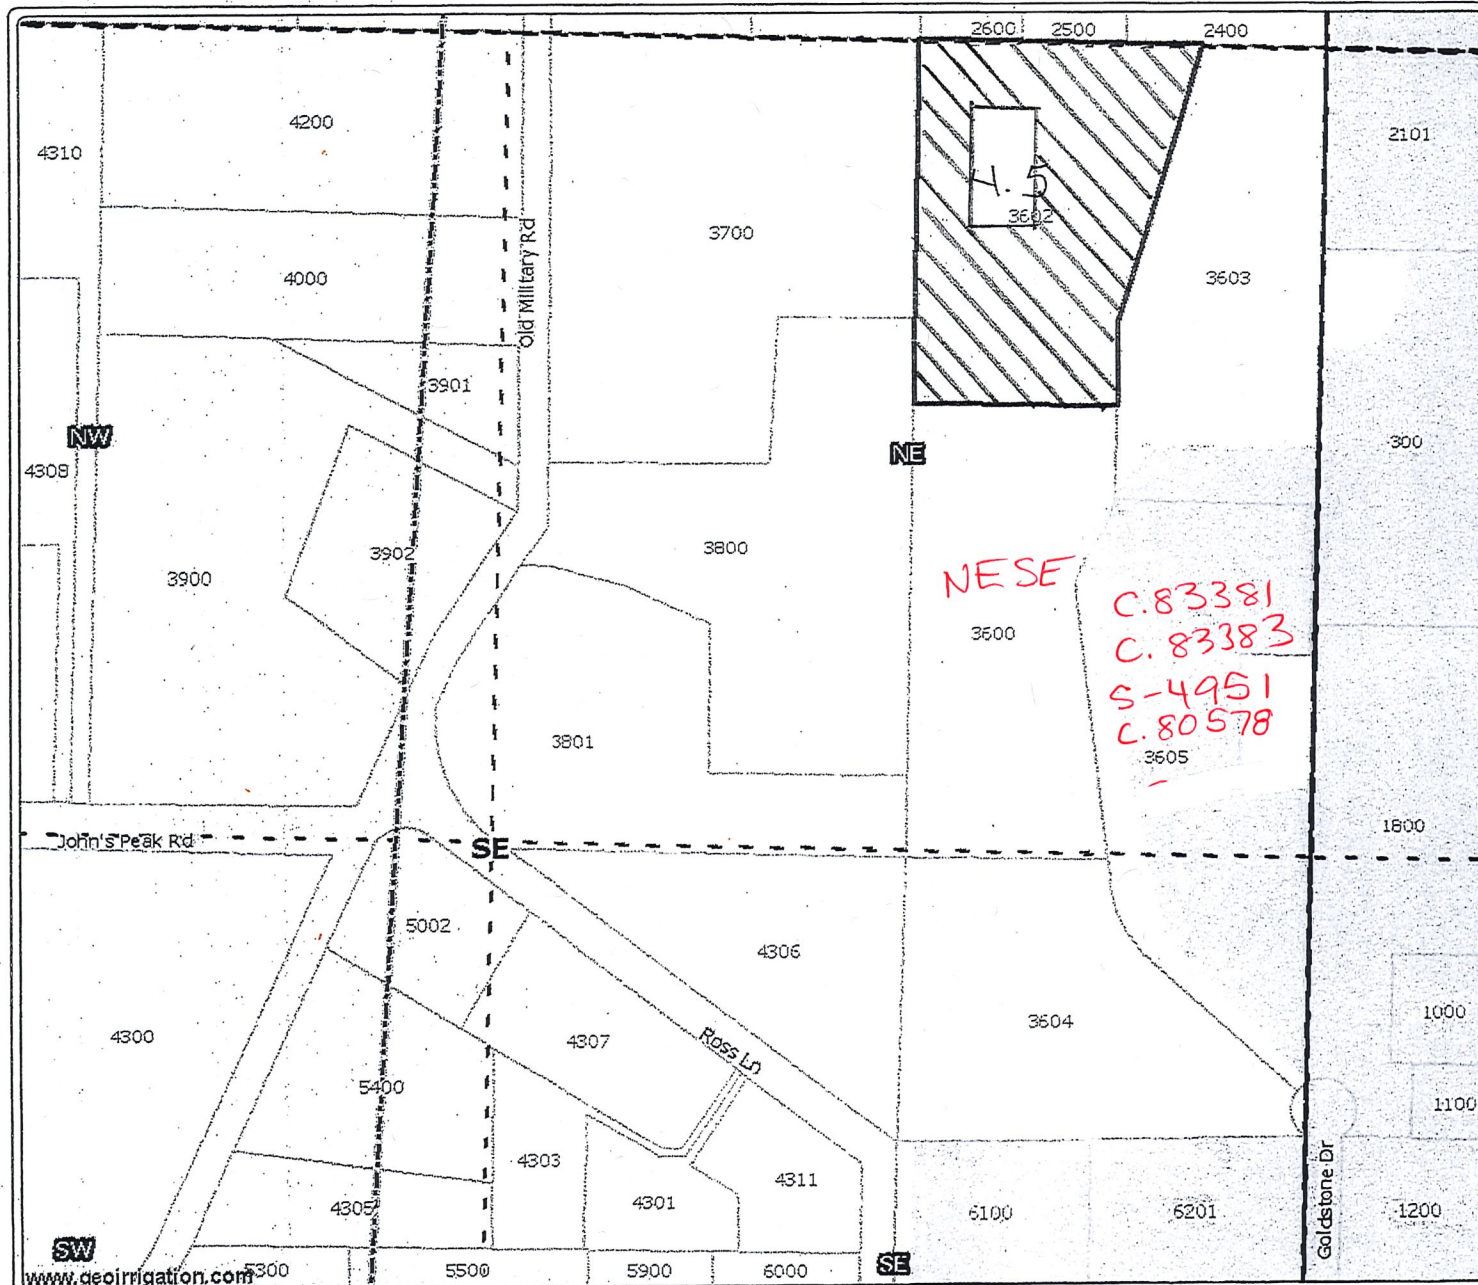

08-07

Transfer To :
MALOT

37S 2W 17 TL 3602
NESE

- ☐ District Boundary USBR
- ☐ Road Labels
- ☐ Township Range
- ☐ Sections
- ☐ Section Labels
- ☐ Quarters
- ☐ Quarter Labels
- ☐ Quarter Quarters
- ☐ Quarter Quarters Labels
- ☐ Lot Labels
- ☐ Taxlots
- ☐ Waterbodies JACK CO
- ☐ Irrigation Ditches JACK CO
- ☐ R/COG Laterals
- ☒ Place of Use WORKING

4.5 irr. ac.

RECEIVED

JAN 08 2010

**WATER RESOURCES DEPT
SALEM, OREGON**



scale 1" = 400.00'
created: 3/24/2006

DISCLAIMER: This map is intended for display purposes only and is not intended for any legal representations.
There are no warranties, expressed or implied, that accompany this product.

Powered By
geoirrigation

SW
www.geoirrigation.com

OFF

Authorized Place of Use


08-08

Transfer From:

SW SE

37S 2W 23 TL 700

4.47 Acres

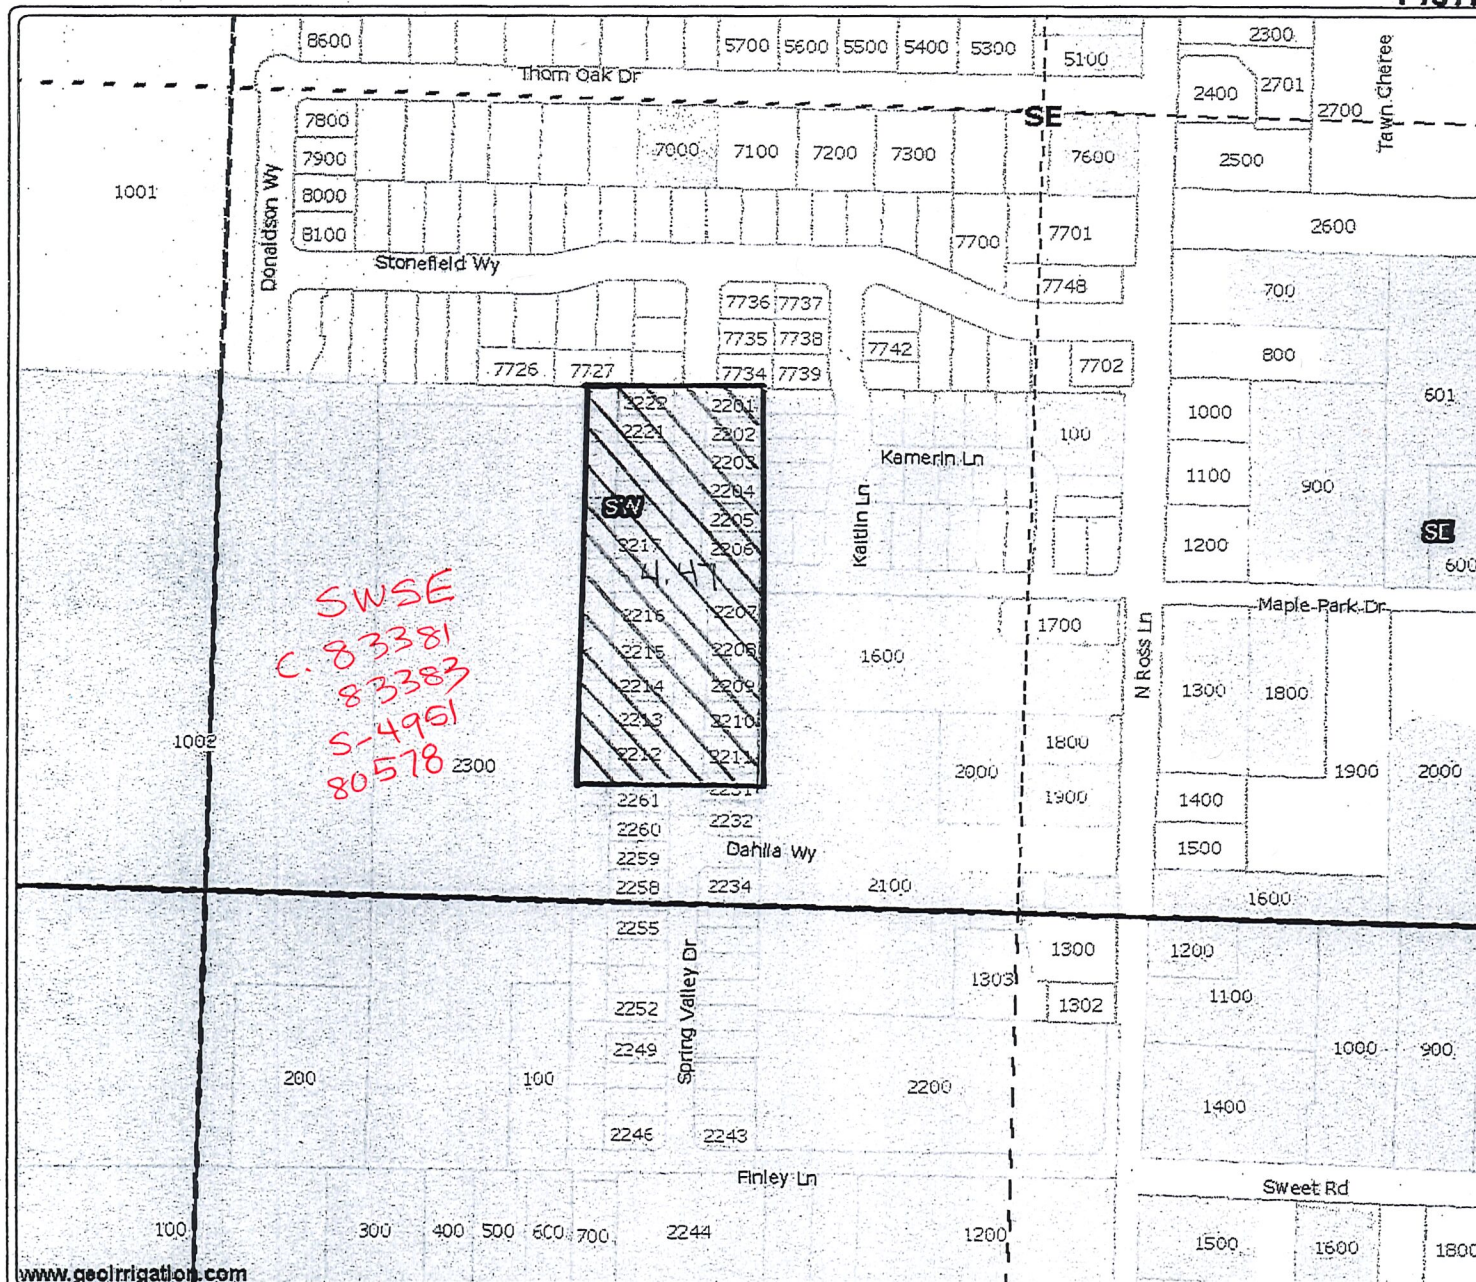

www.geolrrigation.com

DISCLAIMER: This map is intended for display purposes only and is not intended for any legal representations. There are no warranties, expressed or implied, that accompany this product.

Powered By
geolrrigation

- ☒ District Boundary USBR
- ☐ Road Labels
- ☐ Township Range
- ☐ Sections
- ☐ Section Labels
- ☐ Quarters
- ☐ Quarter Labels
- ☐ Quarter Quarters
- ☐ Quarter Quarters Labels
- ☐ Lot Labels
- ☐ Taxlots
- ☐ Waterbodies JACK CO
- ☐ Irrigation Ditches JACK CO
- ☒ Place of Use WORKING

☒ To be Transferred
4.47 AC.

RECEIVED

JAN 08 2010


WATER RESOURCES DEPT
SALEM, OREGON



scale 1" = 400.00'
created: 3/24/2006

6N

Proposed Place of Use
08-08

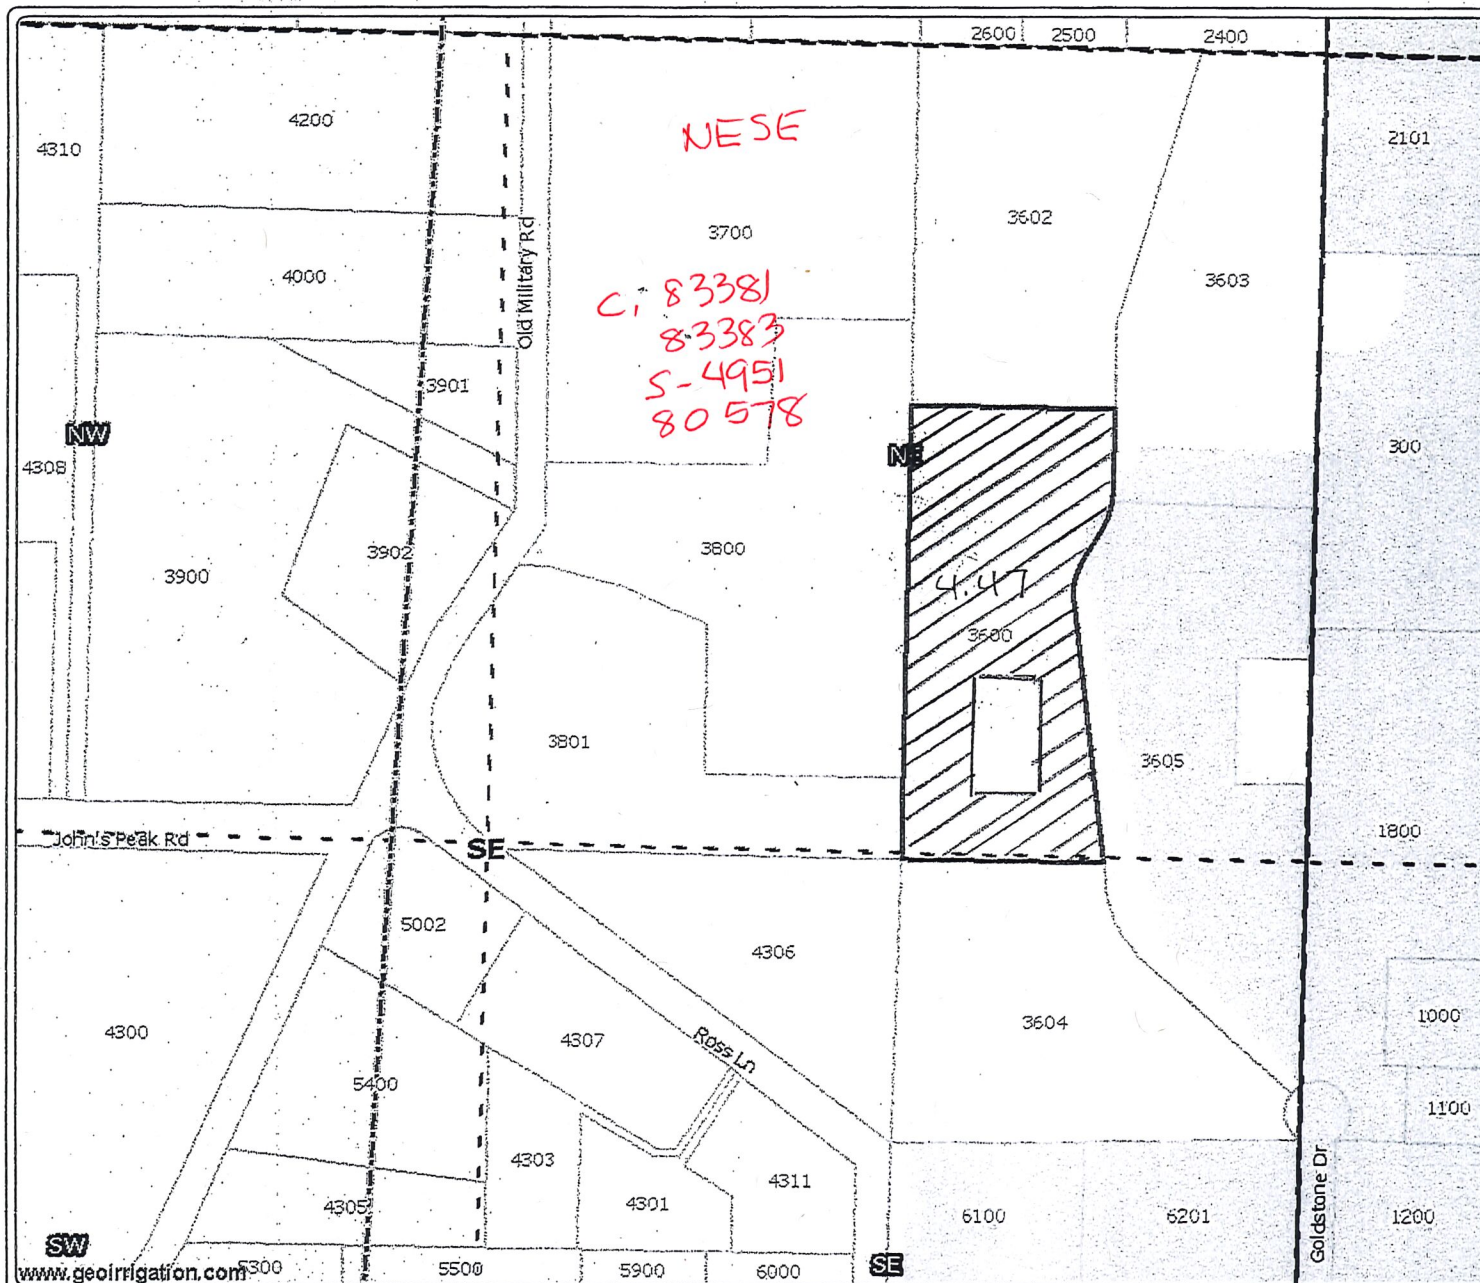

Place of Use

Transfer To :
STEIGERWALD

37S 2W 17 TL 3600
NESE

- District Boundary USBR
- Road Labels
- Township Range
- Sections
- Section Labels
- Quarters
- Quarter Labels
- Quarter Quarters
- Quarter Quarters Labels
- Lot Labels
- Taxlots
- Waterbodies JACK CO
- Irrigation Ditches JACK CO
- RVCOG Laterals
- Place of Use WORKING

4.47 AC.

RECEIVED

JAN 08 2010

WATER RESOURCES DEPT
SALEM, OREGON



scale 1" = 400.00'
created: 3/24/2006

DISCLAIMER: This map is intended for display purposes only and is not intended for any legal representations.
There are no warranties, expressed or implied, that accompany this product.

Powered By
geolrrigation

OFF

Authorized Place of Use

08-09

~~08-09~~ Transfer From

37S 2W 26AB TL 1900

3.76 Acres

- District Boundary USBR
- Road Labels
- Township Range
- Sections
- Section Labels
- Quarters
- Quarter Labels
- Quarter Quarters
- Quarter Quarters Labels
- Lot Labels
- Taxlots
- Waterbodies JACK CO
- Place of Use WORKING

Transferred
on 83728 From

RECEIVED

JAN 08 2010

WATER RESOURCES DEPT
SALEM, OREGON



scale 1" = 400.00'
created: 3/31/2006

www.geolrrigation.com

DISCLAIMER: This map is intended for display purposes only and is not intended for any legal representations.
There are no warranties, expressed or implied, that accompany this product.

Powered By
geolrrigation

NWNE 3.76
83381
83383
S-4951
80578
83728


NW

NE

ON

08-06

Proposed Place of Use

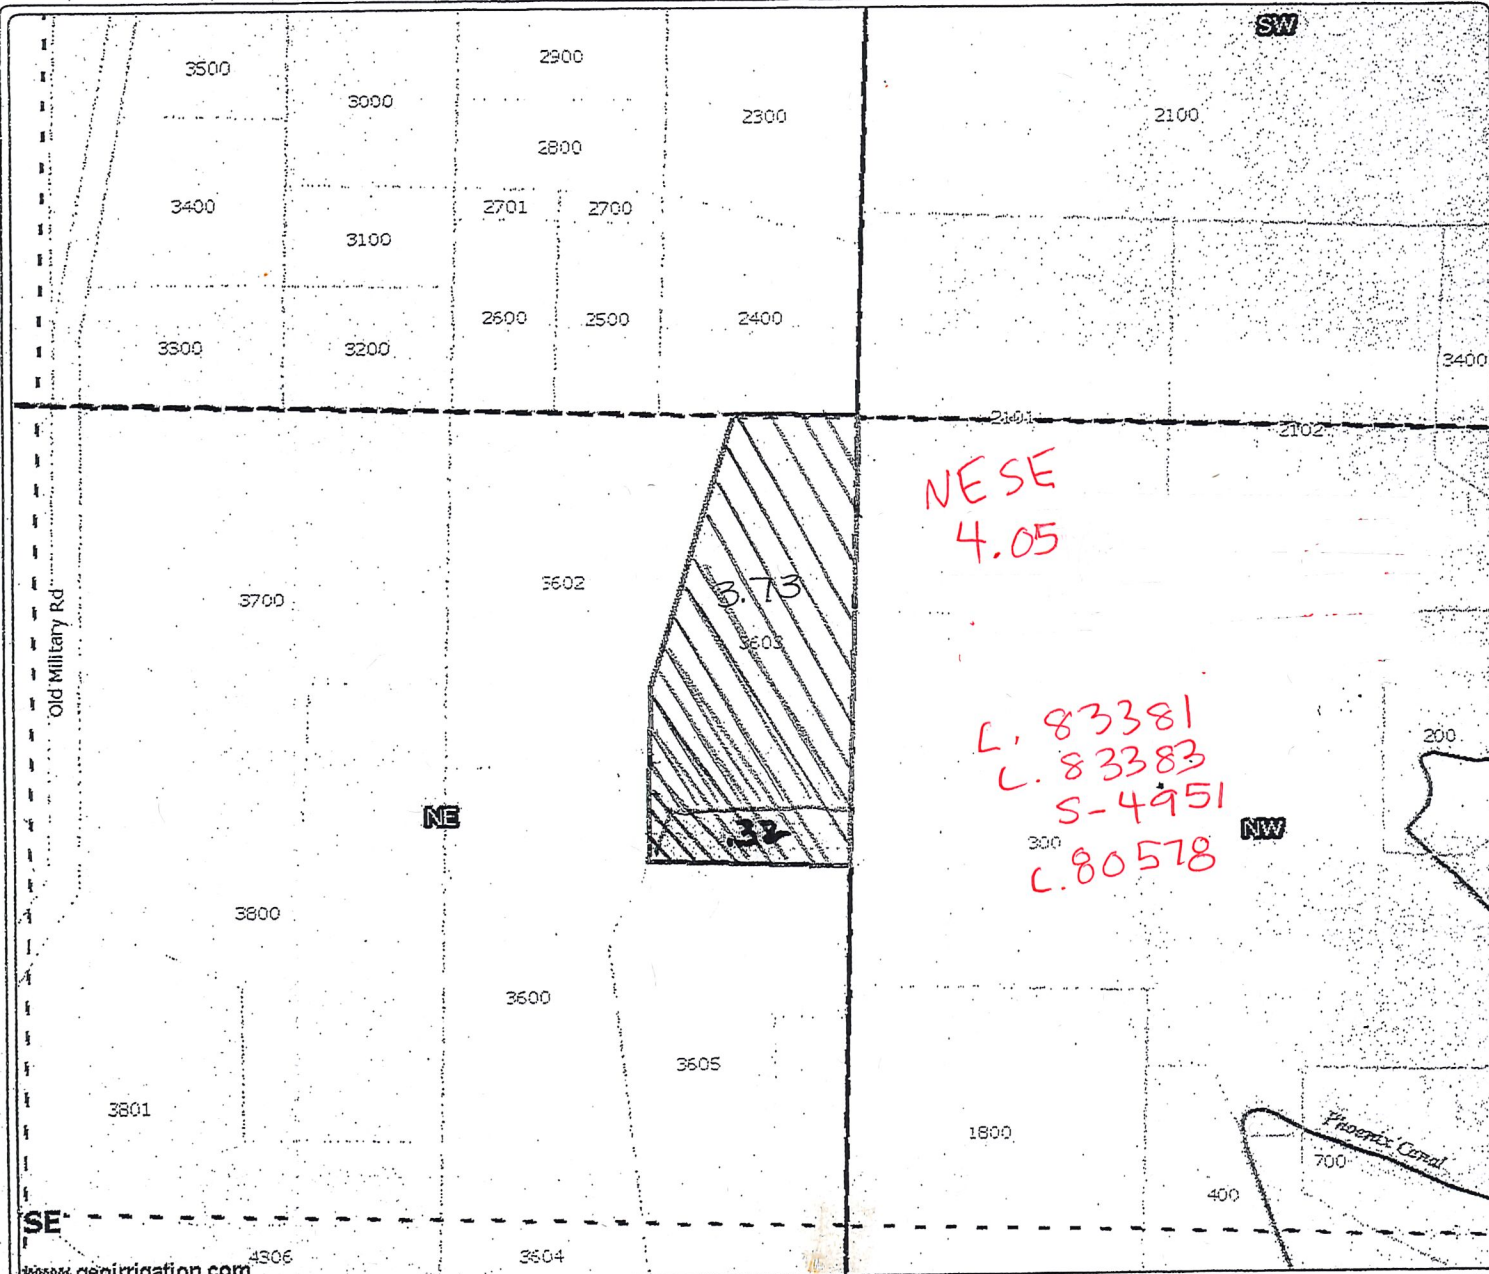

06-08 Transfer To :
TURNER

37S 2W 17 TL 3603

3.73 AC
4.05 AC TOTAL

- ☐ District Boundary USBR
- ☐ Road Labels
- ☐ Township Range
- ☐ Sections
- ☐ Section Labels
- ☐ Quarters
- ☐ Quarter Labels
- ☐ Quarter Quarters
- ☐ Quarter Quarters Labels
- ☐ Lot Labels
- ☐ Taxlots
- ☐ Waterbodies JACK CO
- ☐ Irrigation Ditches JACK CO
- ☐ R/COG Laterals
- ☐ Place of Use WORKING

Proposed Place of Use

RECEIVED

JAN 08 2010

WATER RESOURCES DEPT
SALEM, OREGON



scale 1" = 400.00'
created: 3/24/2006

www.geolrrigation.com

DISCLAIMER: This map is intended for display purposes only and is not intended for any legal representations.
There are no warranties, expressed or implied, that accompany this product.

Powered By
geolrrigation

ON

Proposed Place of Use

08-09

~~08-09~~ Transfer To:
Brown

37S 2W 33 TL 700
NESE & SESE
9.50 ac

- District Boundary USBR
- Road Labels
- Township Range
- Sections
- Section Labels
- Quarters
- Quarter Labels
- Quarter Quarters
- Quarter Quarters Labels
- Lot Labels
- Taxlots
- Waterbodies JACK CO
- Irrigation Ditches JACK CO
- Place of Use WORKING


9.52
9.50 ac.
To be irr.

amended 1-7-09
RECEIVED

582 nest
3.70 sese
JAN 08 2010
WATER RESOURCES DEPT
SALEM, OREGON



scale 1" = 400.00'
created: 3/30/2006

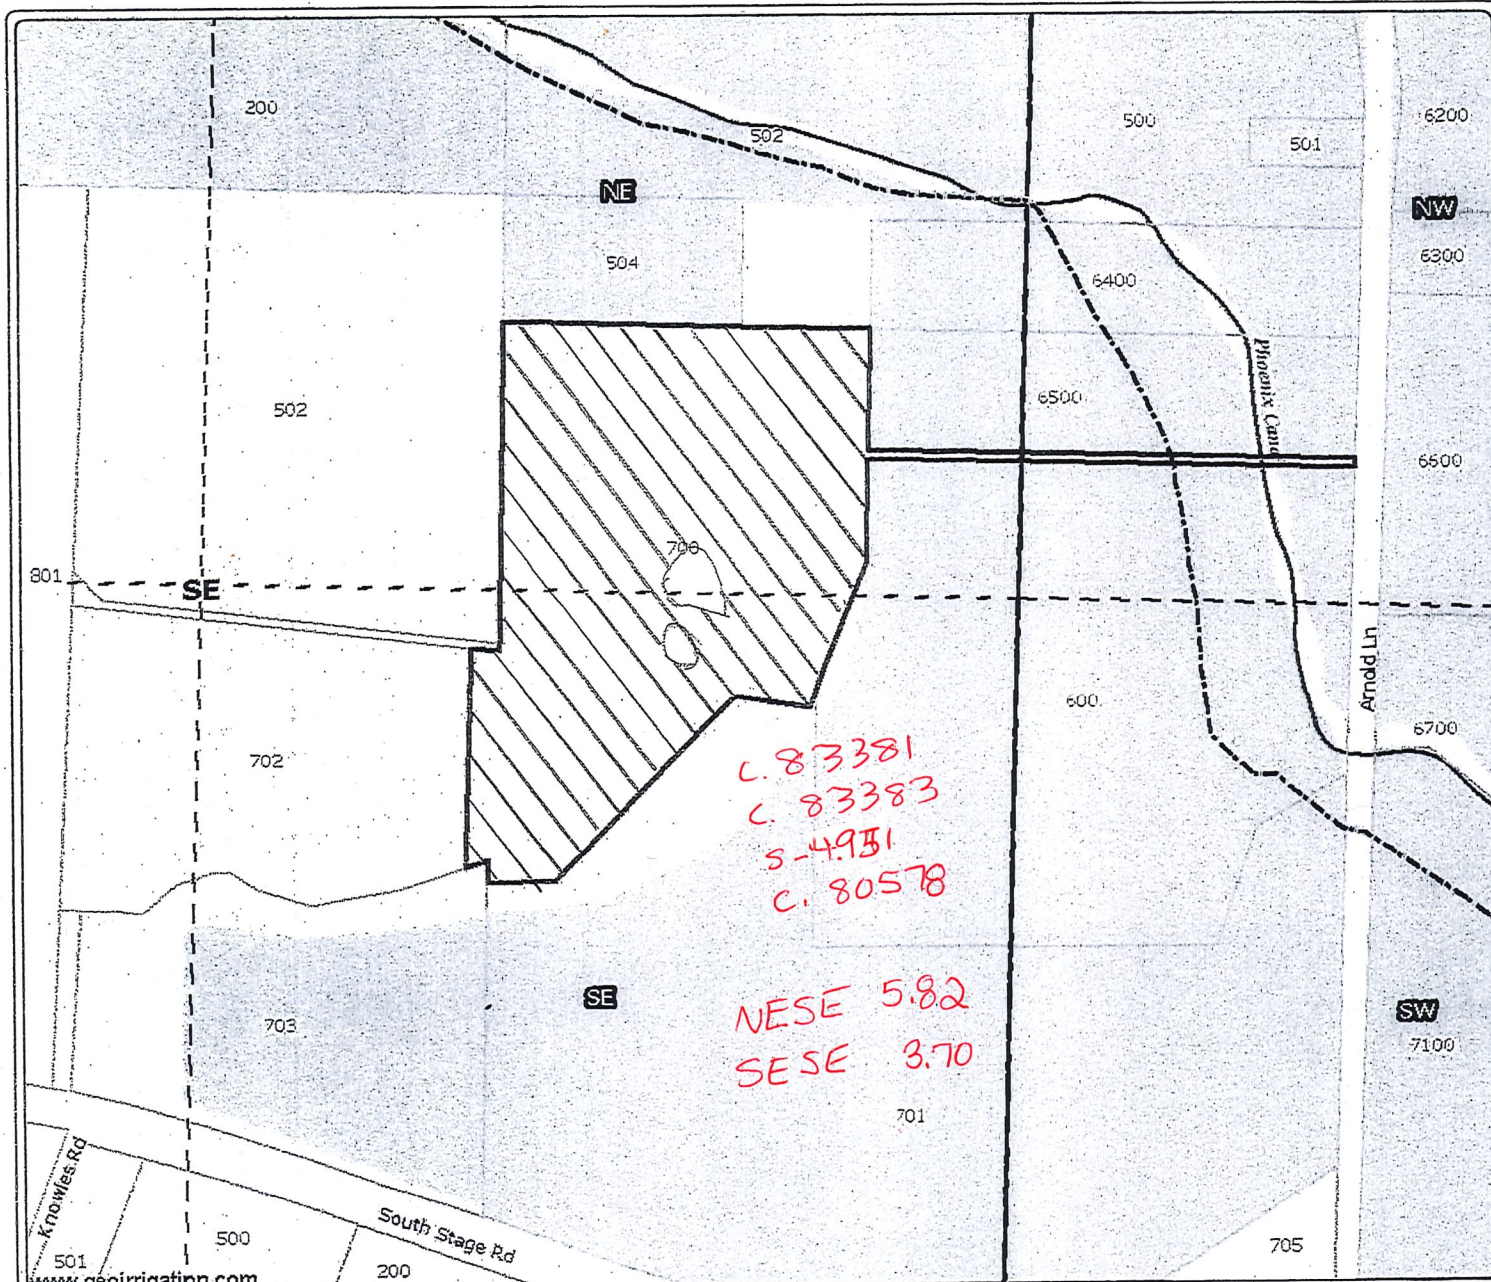


www.geoirrigation.com

DISCLAIMER: This map is intended for display purposes only and is not intended for any legal representations.
There are no warranties, expressed or implied, that accompany this product.

Powered By
geoirrigation

5 OFF

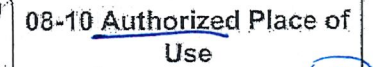

SWSE

35. Ac To Transfer.



Scale 1"=400'
Created: 4/20/2009

DISCLAIMER: This map is intended for display purposes only and is not intended for any legal representations. There are no warranties, expressed or implied, that accompany this product.

SENW 3.6

83381
83383
S-4951

OFF

Medford Irrigation District

08-10 Authorized Place of Use

37-1w-16A #800 3.60 ac

- District Boundary USBR
- County Boundary
- Road Labels
- Township Range
- Sections
- Section Labels
- Quarters
- Quarter Labels
- Quarter Quarters
- Quarter Quarters Labels
- Taxlots
- POU District Primary
- Irrigation Ditches JACK CO
- RWCDB Laterals

Place of Use
Transfer Off

SENW
RECEIVED

JAN 08 2010

WATER RESOURCES DEPT
SALEM, OREGON



Scale 1" = 400'
Created: 9/29/2008



DISCLAIMER: This map is intended for display purposes only and is not intended for any legal representations. There are no warranties, expressed or implied, that accompany this product.

OFF

Medford Irrigation District

Authorized Place of Use
08-10

371W16A #801 2.87 ac.

SE NW

- District Boundary USBR
- County Boundary
- Road Labels
- Township Range
- Sections
- Section Labels
- Quarters
- Quarter Labels
- Quarter Quarters
- Quarter Quarters Labels
- Taxlots
- POU District Primary
- Irrigation Ditches JACK CO
- RWCOD Laterals

2.87 To
Transfer OFF
#801
Before subdivided


RECEIVED

JAN 08 2010

WATER RESOURCES DEPT
SALEM, OREGON



Scale 1" = 500'
Created: 11/4/2008

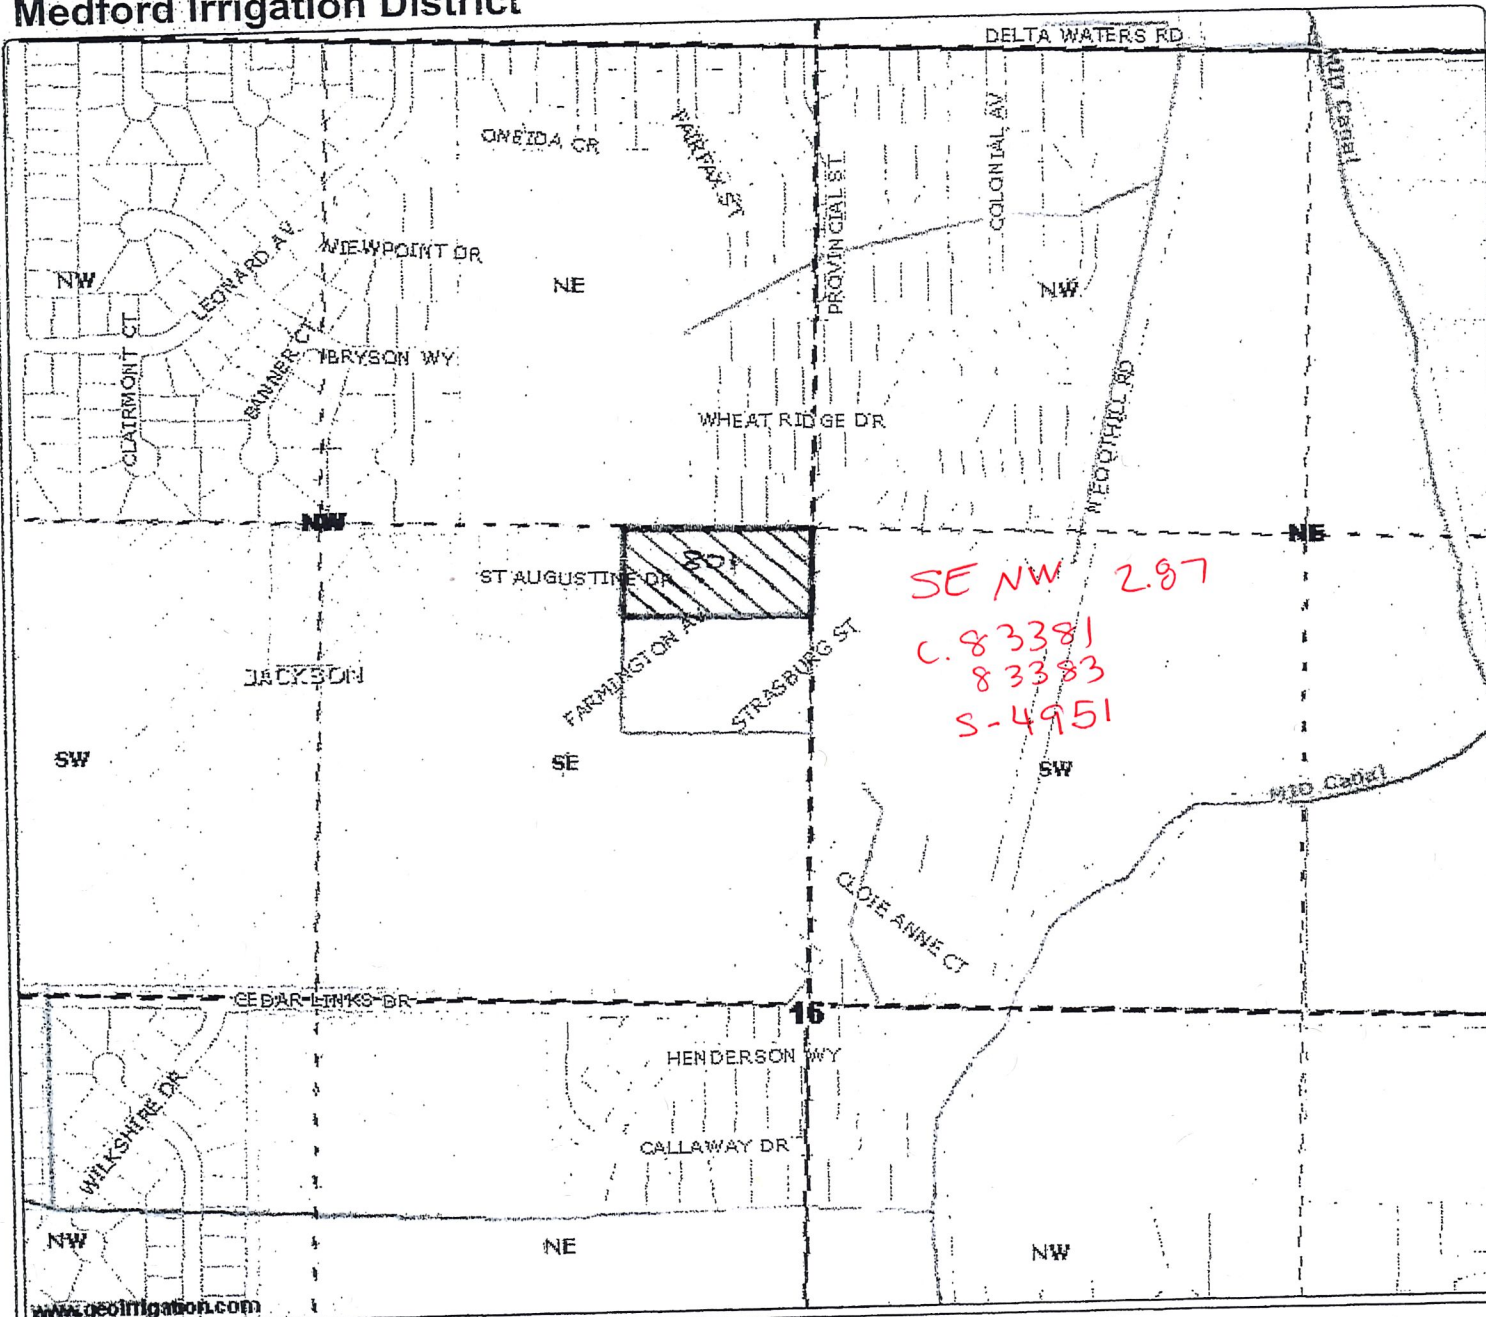


DISCLAIMER: This map is intended for display purposes only and is not intended for any legal representations. There are no warranties, expressed or implied, that accompany this product.

OFF

Medford Irrigation District

Authorized

Place of Use 08-10
371W20AB #200
3.20 ac

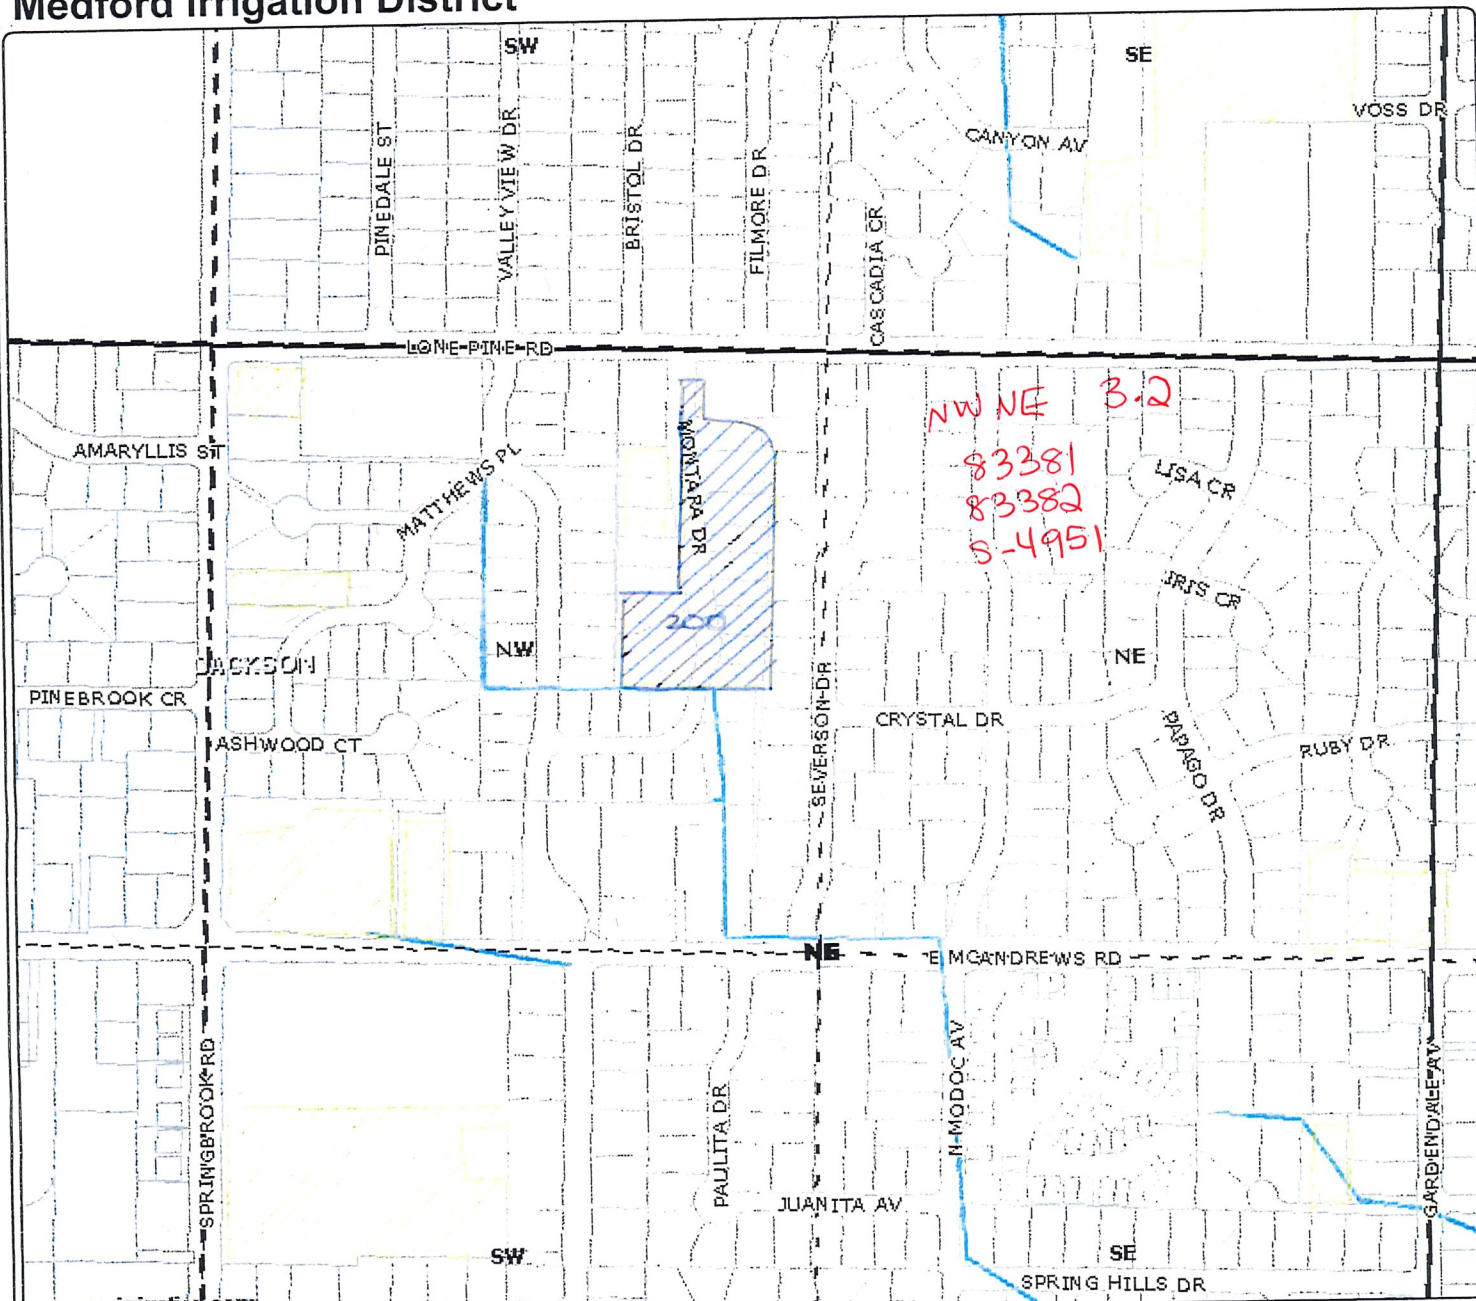

- District Boundary USBR
- County Boundary
- Road Labels
- Township Range
- Sections
- Section Labels
- Quarters
- Quarter Labels
- Quarter Quarters
- Quarter Quarters Labels
- Taxlots
- POU District Primary
- Irrigation Ditches JACK CO
- RVCOG Laterals

3.20 ac To Transfer



Scale 1" = 400'
Created: 11/4/2008

www.geoirrigation.com

DISCLAIMER: This map is intended for display purposes only and is not intended for any legal representations. There are no warranties, expressed or implied, that accompany this product.

RECEIVED

DEC 23 2008

WATER RESOURCES DEPT
SALEM, OREGON

10757

Medford Irrigation District



08-10 Authorized Place of Use

371w16ac #1100 .70 ac

SWNE

- District Boundary USBR
- County Boundary
- Road Labels
- Township Range
- Sections
- Section Labels
- Quarters
- Quarter Labels
- Quarter Quarters
- Quarter Quarters Labels
- Taxlots
- POU District Primary
- Irrigation Ditches JACK CO
- RVCOG Laterals

Place of Use Transfer OFF

83381
83383
S-4951



Scale 1" = 200'
Created: 9/29/2008

RECEIVED
DEC 23 2008

WATER RESOURCES DEPT
SALEM, OREGON

DISCLAIMER: This map is intended for display purposes only and is not intended for any legal representations. There are no warranties, expressed or implied, that accompany this product.

C1/4

07P

Authorized


Place of Use

08-10

371W21CC #1000

1.65 ac

Medford Irrigation District

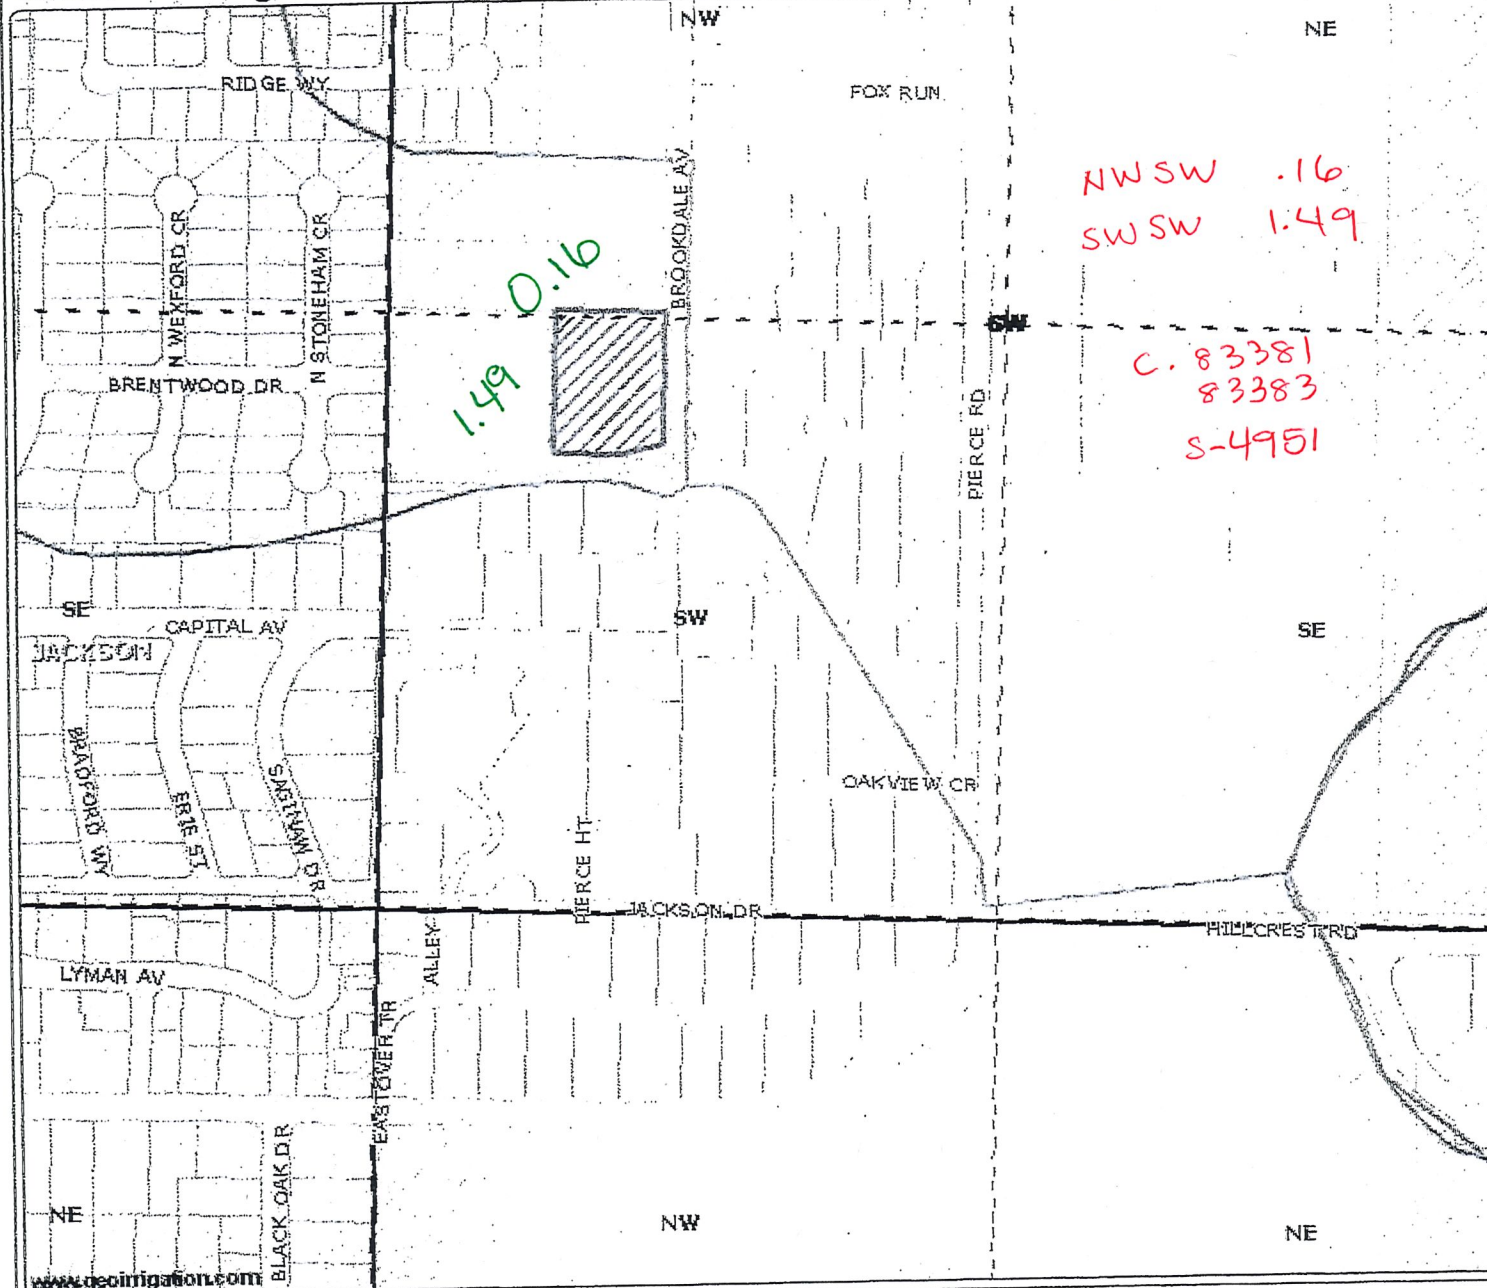

- ☐ District Boundary USBR
- ☐ County Boundary
- ☐ Road Labels
- ☐ Township Range
- ☐ Sections
- ☐ Section Labels
- ☐ Quarters
- ☐ Quarter Labels
- ☐ Quarter Quarters
- ☐ Quarter Quarters Labels
- ☐ Taxlots
- ☐ POI District Primary
- ☐ Irrigation Ditches JACK CO
- ☐ RVCOG Laterals

Total
1.65 ac To
Transfer
0.16 nwsu
1.49 swsu

RECEIVED

JAN 08 2010


WATER RESOURCES DEPT
SALEM, OREGON



Scale 1" = 400'
Created: 11/4/2008

DISCLAIMER: This map is intended for display purposes only and is not intended for any legal representations. There are no warranties, expressed or implied, that accompany this product.

Medford Irrigation District

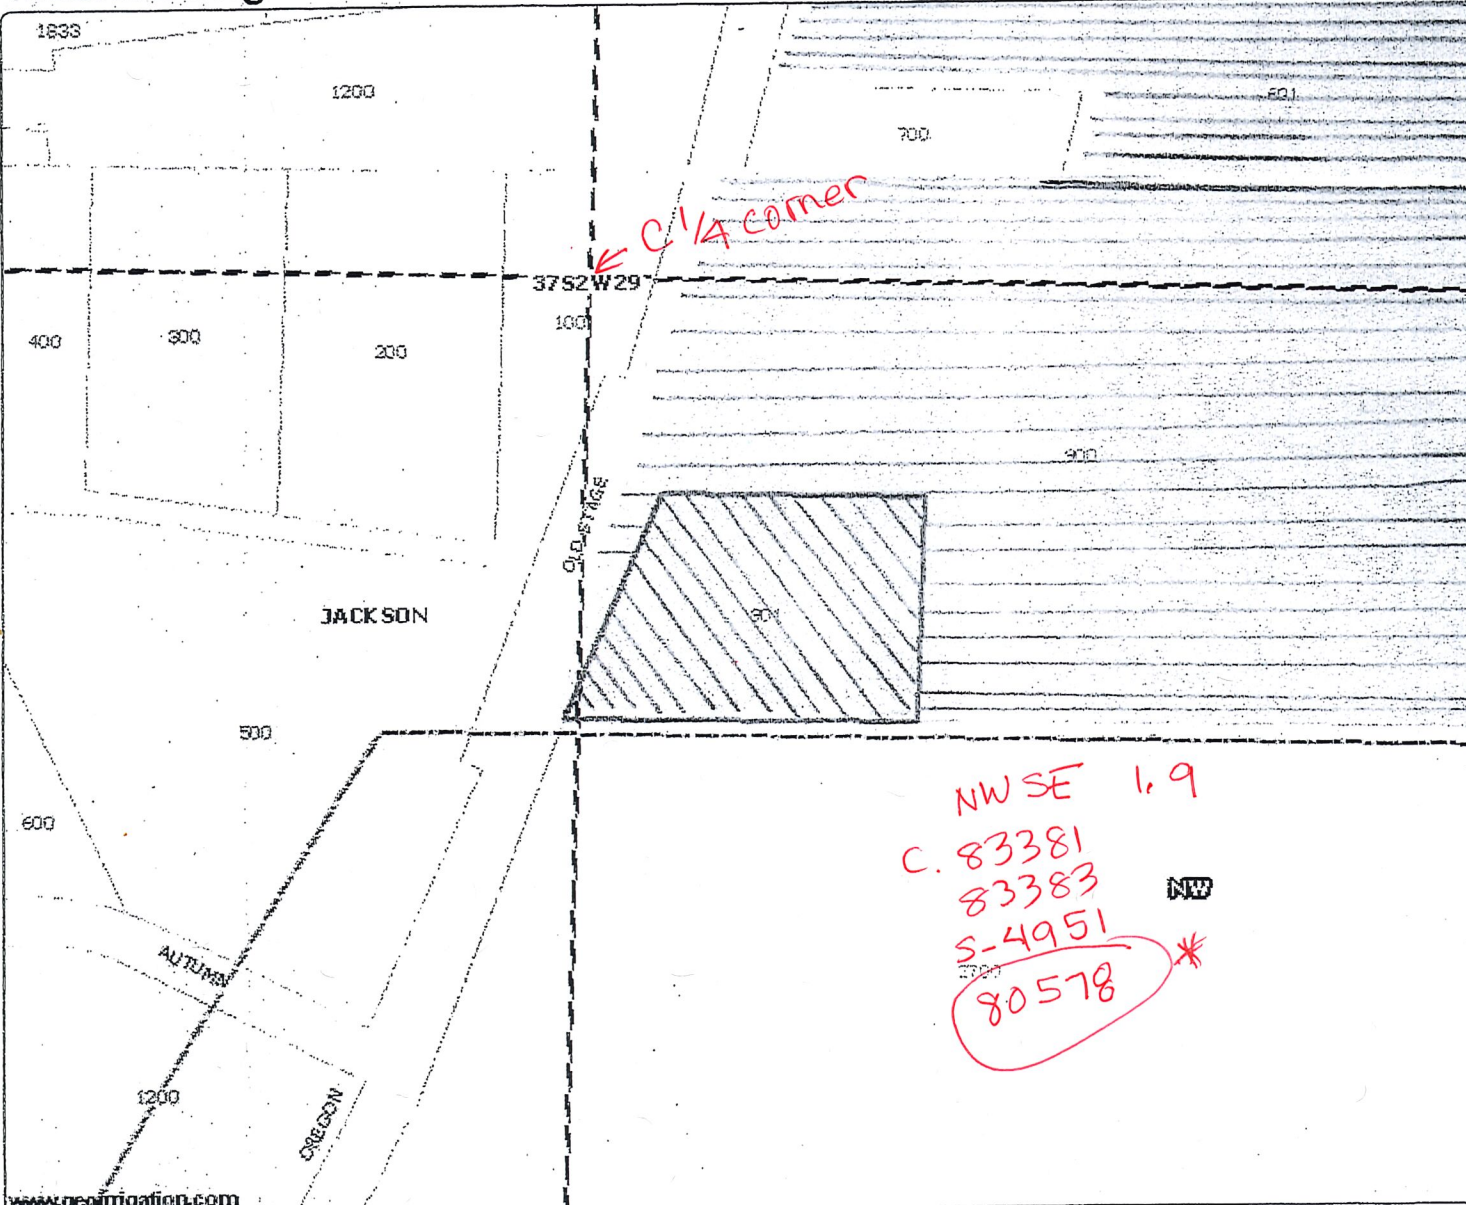

Authorized
08-1D
Place of Use
TRANSFER OFF
37-2W-29 TAX LOT 901

- ☐ District Boundary USBR
- ☐ County Boundary
- Road Labels
- ☐ Township Range
- ☐ Sections
- Section Labels
- ☐ Quarters
- Quarter Labels
- ☐ Quarter Quarters
- Quarter Quarters Labels
- Lot Labels
- ☐ Taxlots
- Rivers JACK CO
- Waterbodies JACK CO
- Irrigation Ditches JACK CO
- RVCQG Laterals
- Water Rights OLD
- Water Rights NEW

1.90 ac use
in Transfer 08-1D
under
irrigation

RECEIVED

JAN 08 2010

WATER RESOURCES DEPT
SALEM, OREGON
Scale 1" = 200'
Created: 1/17/2008

www.geoinigation.com
ARTHUR & SUSAN MILLETTE
428 OLD STAGE RD
OLD LAND 1.9 AC

DISCLAIMER: This map is intended for display purposes only and is not intended for any legal representations. There are no warranties, expressed or implied, that accompany this product.

OFF.

372W36DBV #1200 .22 ac



-  District Boundary USBR
-  County Boundary
-  Road Labels
-  Township Range
-  Sections
-  Section Labels
-  Quarters
-  Quarter Labels
-  Quarter Quarters
-  Quarter Quarters Labels
-  Taxlots
-  POU District Primary
-  Irrigation Ditches JACK CO
-  R/COG Laterals

☒ 22 AC.
To Transfer

Not on
83728

RECEIVED

JAN 08 2010

WATER RESOURCES DEPT
SALEM, OREGON



Scale 1" = 400'
Created: 11/4/2008


DISCLAIMER: This map is intended for display purposes only and is not intended for any legal representations. There are no warranties, expressed or implied, that accompany this product.

OFF

08-10

Authorized
Place
of
Use

Rogue River Valley Irrigation District Water Rights Transfer Map

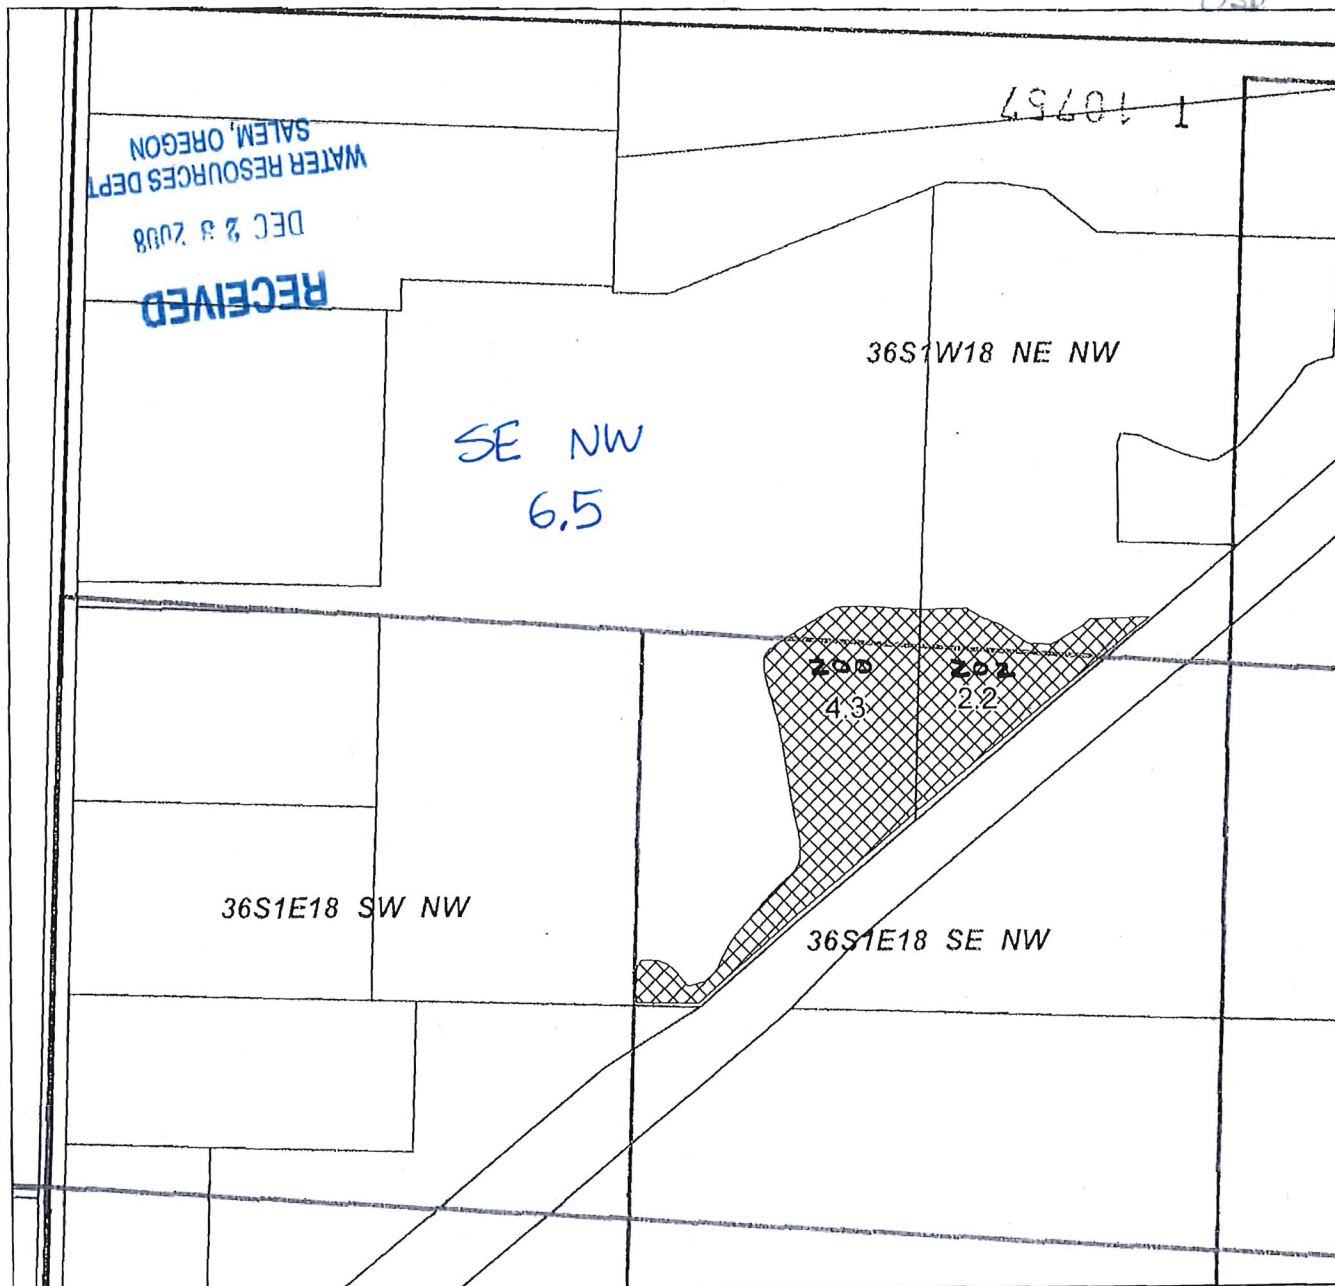

Located in SE 1/4 NW 1/4 SEC 18 T.36S. R.1 E.W.M.

Tax Lot T36S R1E 18 200 - 4.3 AC
T36S R1E 18 202 - 2.2 AC

From: RRVID

Certificates
80566 → 85286 1°
80569 → 85288 2°
80571 → 85876 2°
80574 → 85877 2°

- Transfer Off
- Qtr-Qtr
- Section Line
- Tax Lot Line




0 200 400 800 Feet

8-10

T-10757
ON

12

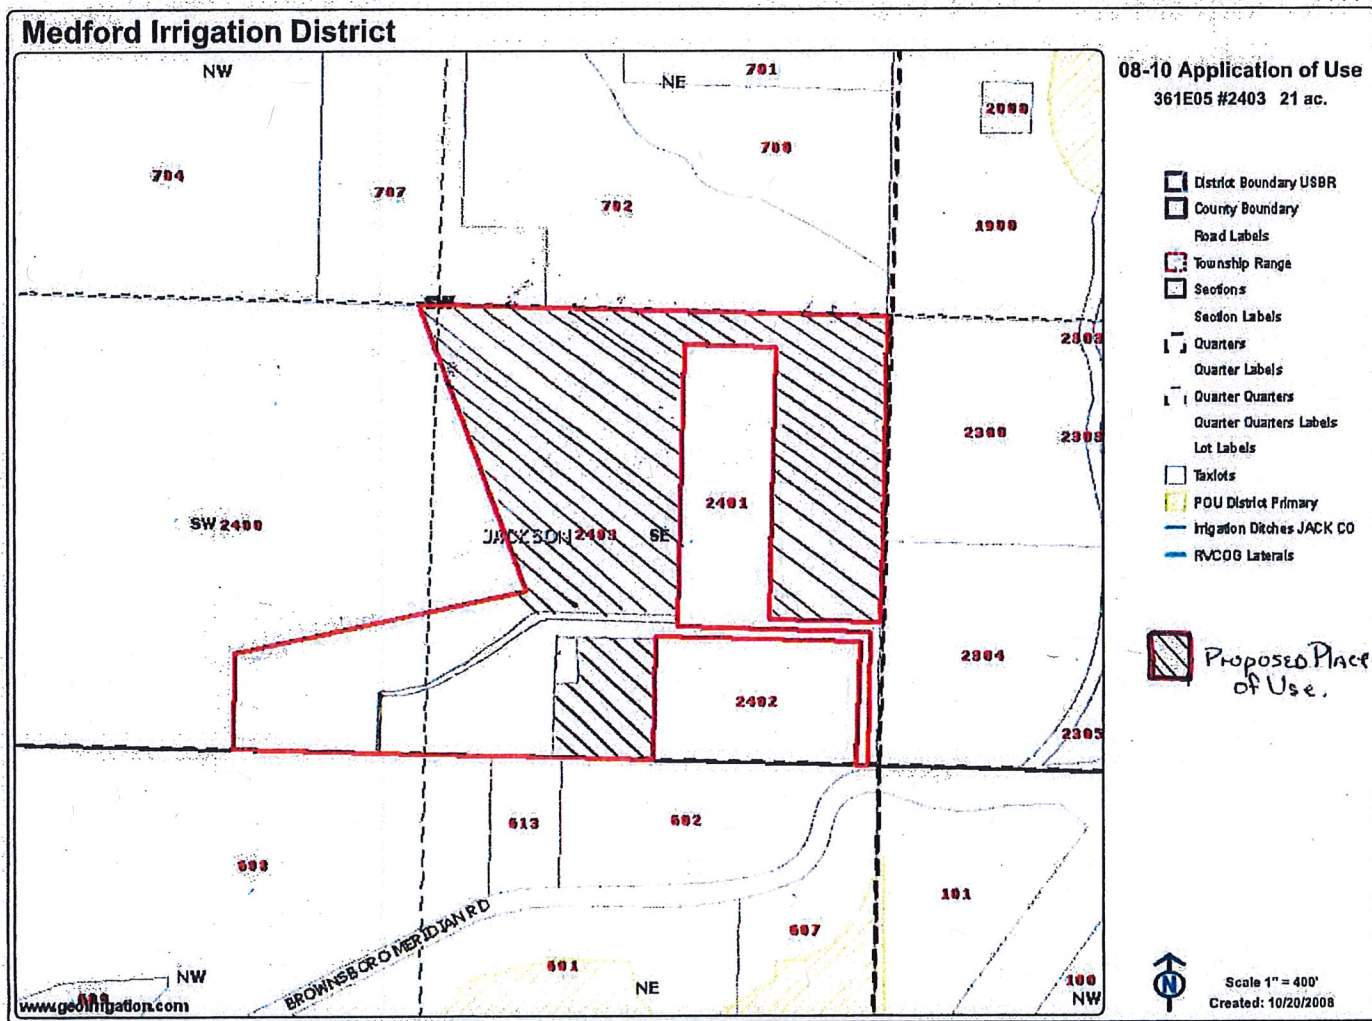

SE SW 1/4 - 83381, 83383, S-4951
SWSW 1/4 - 83381, 83383, S-4951

2.12 - 80578


SESW 6.5 85286, 85288, 85876, 85877

21.0 TOTAL

14.4 } 1° 83381
6.57 } 1° 85286
21.0 TOTAL

08-11

OFF

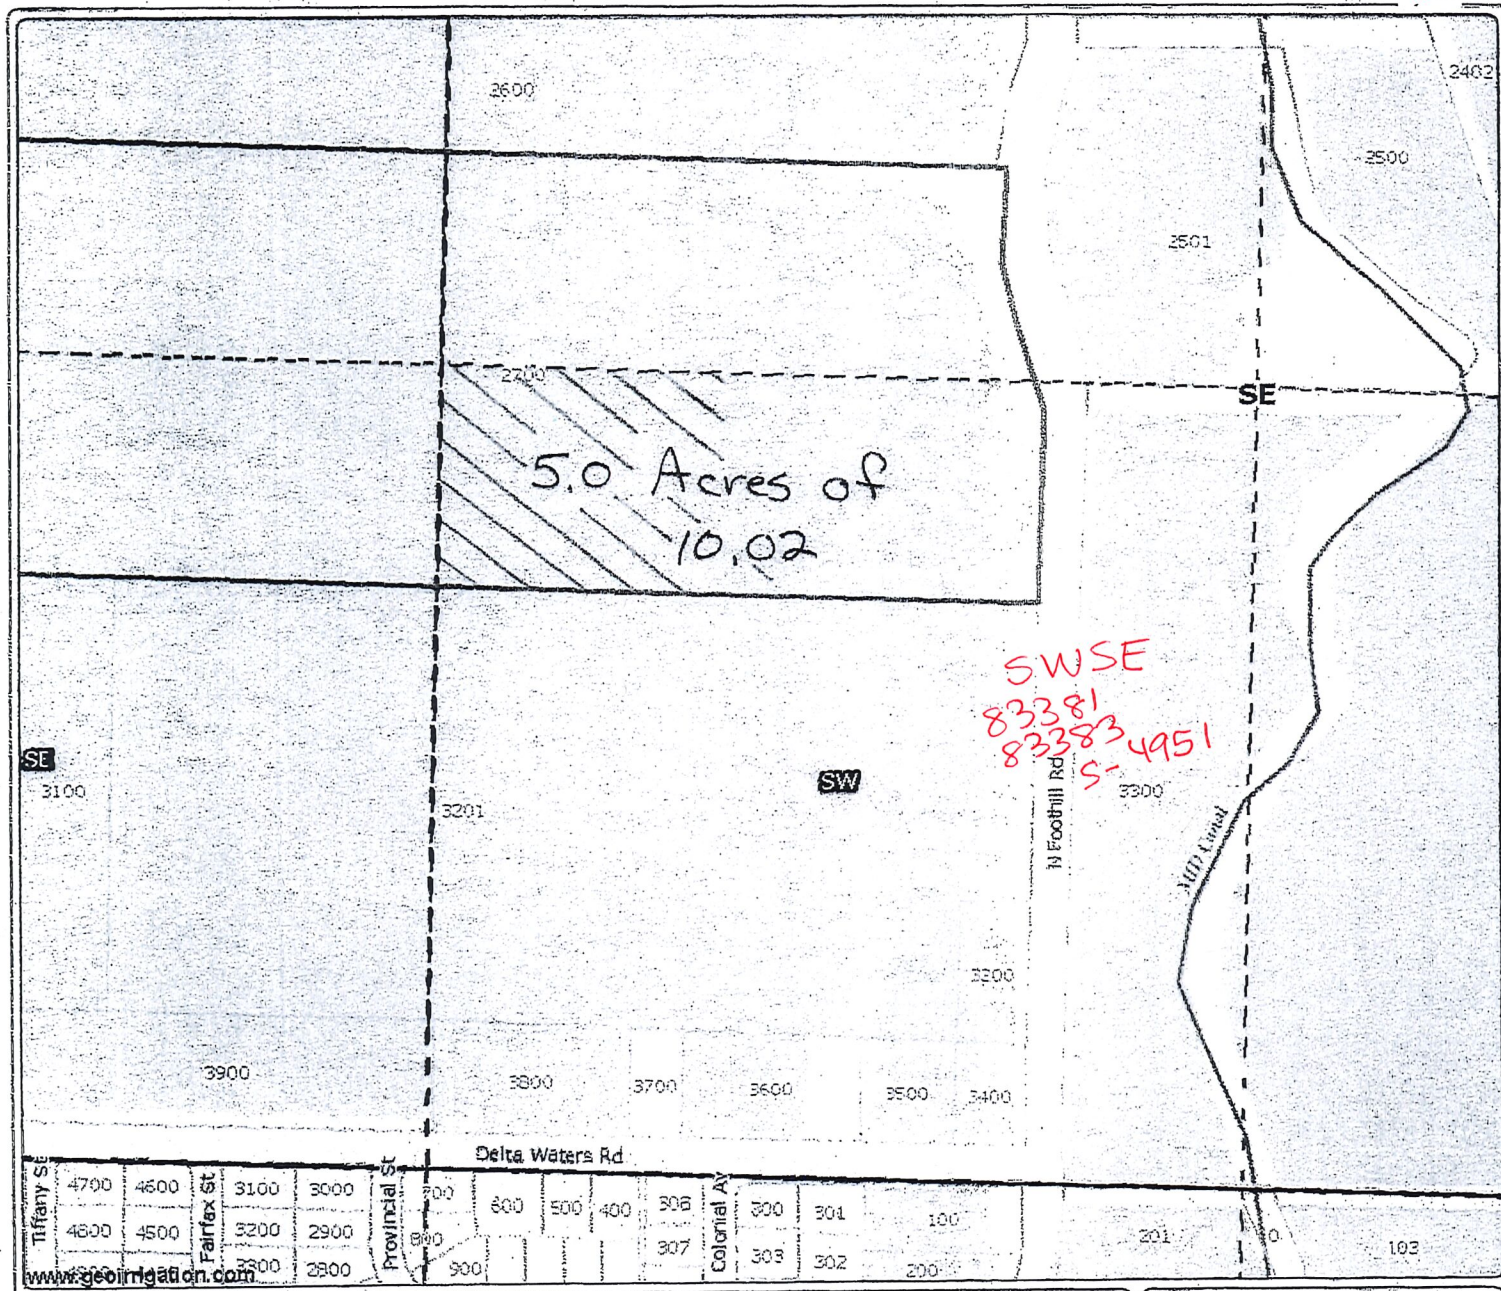

Transfer From:
Medford Irrigation District

37 South, Range 1 West,
Section 9 SWSE 5.0 Acres

- ☐ District Boundary USBR
- ☐ Road Labels
- ☐ Township Range
- ☐ Sections
- ☐ Section Labels
- ☐ Quarters
- ☐ Quarter Labels
- ☐ Quarter Quarters
- ☐ Quarter Quarters Labels
- ☐ Lot Labels
- ☐ Taxlots
- ☐ Waterbodies JACK CO
- ☐ Irrigation Ditches JACK CO
- ☐ Place of Use WORKING

RECEIVED

JAN 08 2010

WATER RESOURCES DEPT
SALEM, OREGON




scale 1" = 400.00'
created: 6/15/2006

DISCLAIMER: This map is intended for display purposes only and is not intended for any legal representations.
There are no warranties, expressed or implied, that accompany this product.

Powered By
geolrrigation

08-11

ON

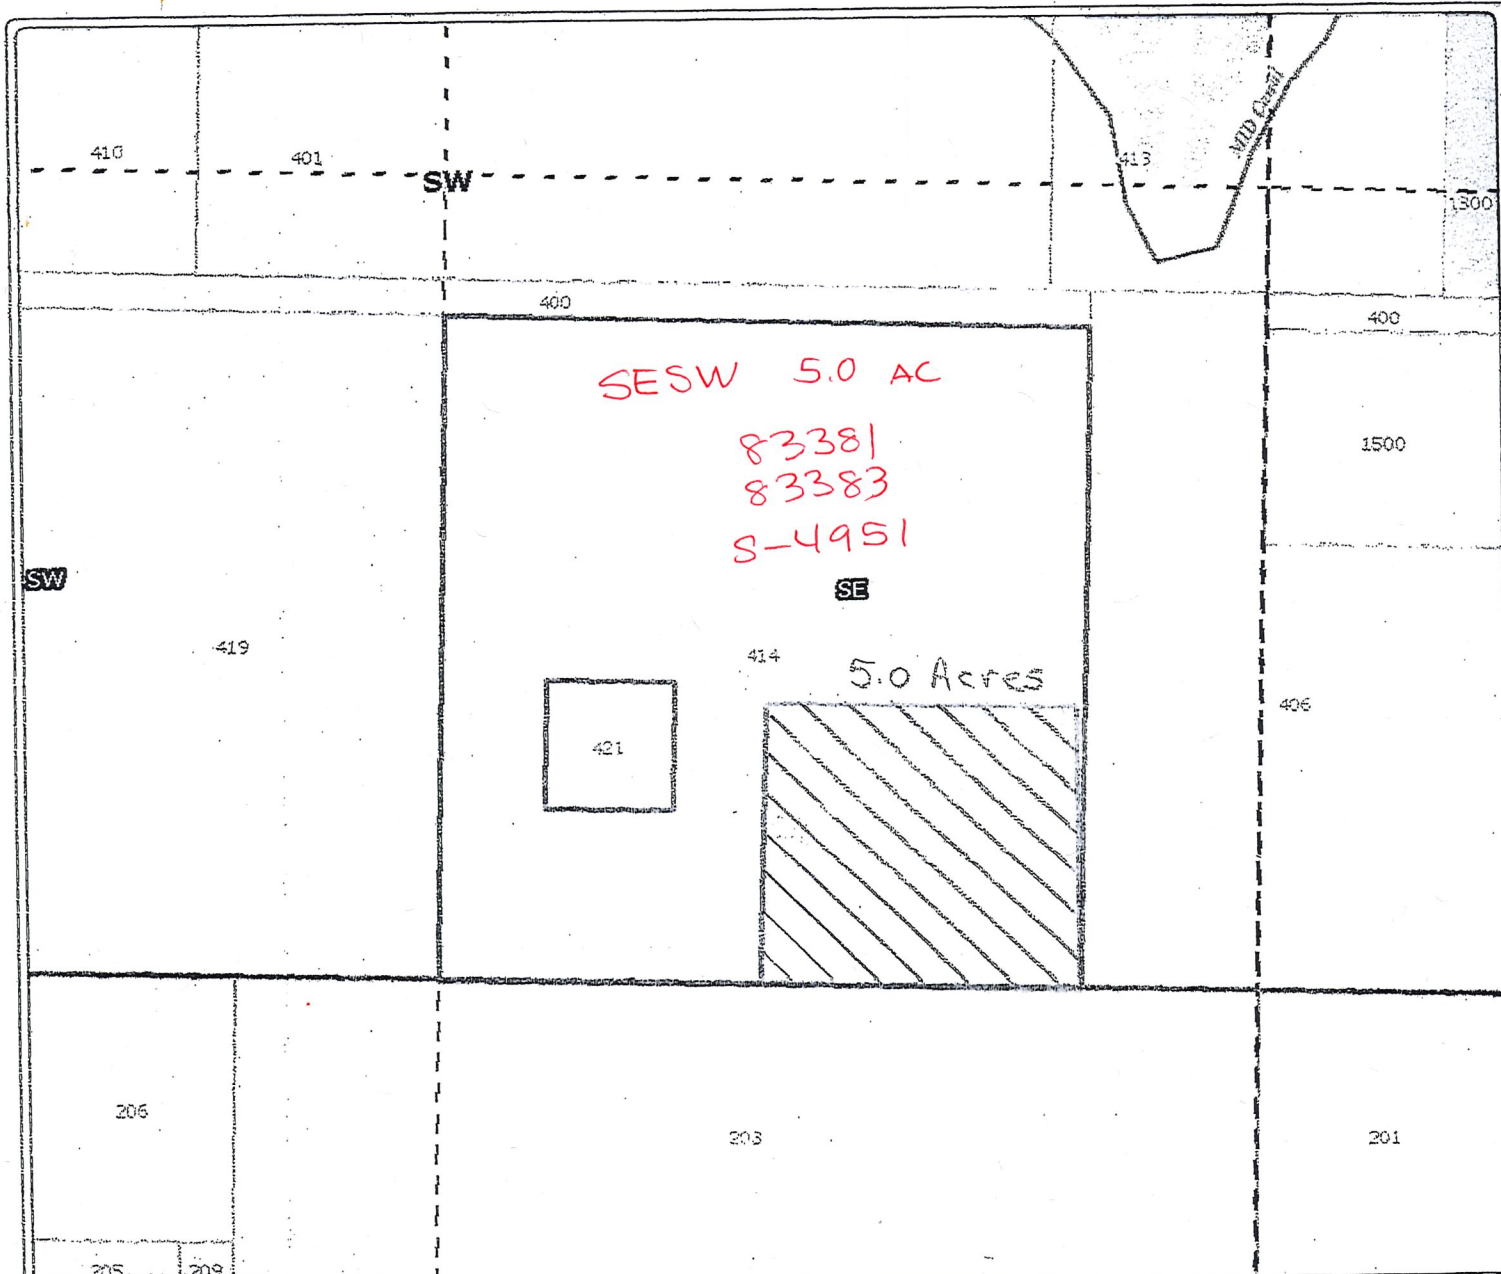

Transfer To:
Luehrs

36 South, 1 West, Section 36
TL 414 SESW 5.0 Acres

- ☐ District Boundary USBR
- ☐ Road Labels
- ☐ Township Range
- ☐ Sections
- ☐ Section Labels
- ☐ Quarters
- ☐ Quarter Labels
- ☐ Quarter Quarters
- ☐ Quarter Quarters Labels
- ☐ Lot Labels
- ☐ Taxlots
- ☐ Waterbodies JACK CO
- ☐ Irrigation Ditches JACK CO
- ☐ Place of Use WORKING

RECEIVED

JAN 08 2010

WATER RESOURCES DEPT
SALEM, OREGON

www.geoirrigation.com

DISCLAIMER: This map is intended for display purposes only and is not intended for any legal representations.
There are no warranties, expressed or implied, that accompany this product.

Powered By
geoirrigation



scale 1" = 400.00'
created: 6/15/2006