

2983

Within the red lines map of NW 1/4 Sec. 25 T.18S.R.11 E.W.M. 1/2 ac. Water Right to be transferred to Lot # 204 Blk.PP in the SE of NE 1/4 NW 1/4 Sec. 25 T.18S. R.11 E.W.M. See Map 18 11 26A New owners, Malcolm & Lucille Pike

SHOSHONE

SHOSHONE CIRCLE

SUMMER

INDIAN

BLK. PP

NW 1/4 NW 1/4 Sec 25

BAKER

RIVER WOODS

WINNEBAGO

CHOCTAW

BLK.

1-2

RECEIVED

FEB 26 1974

STATE ENGINEER SALEM, OREGON

RECEIVED


FEB 7 4 1977

WATER RESOURCES DEPT. SALEM, OREGON

T# 2983

"To"

T-2983

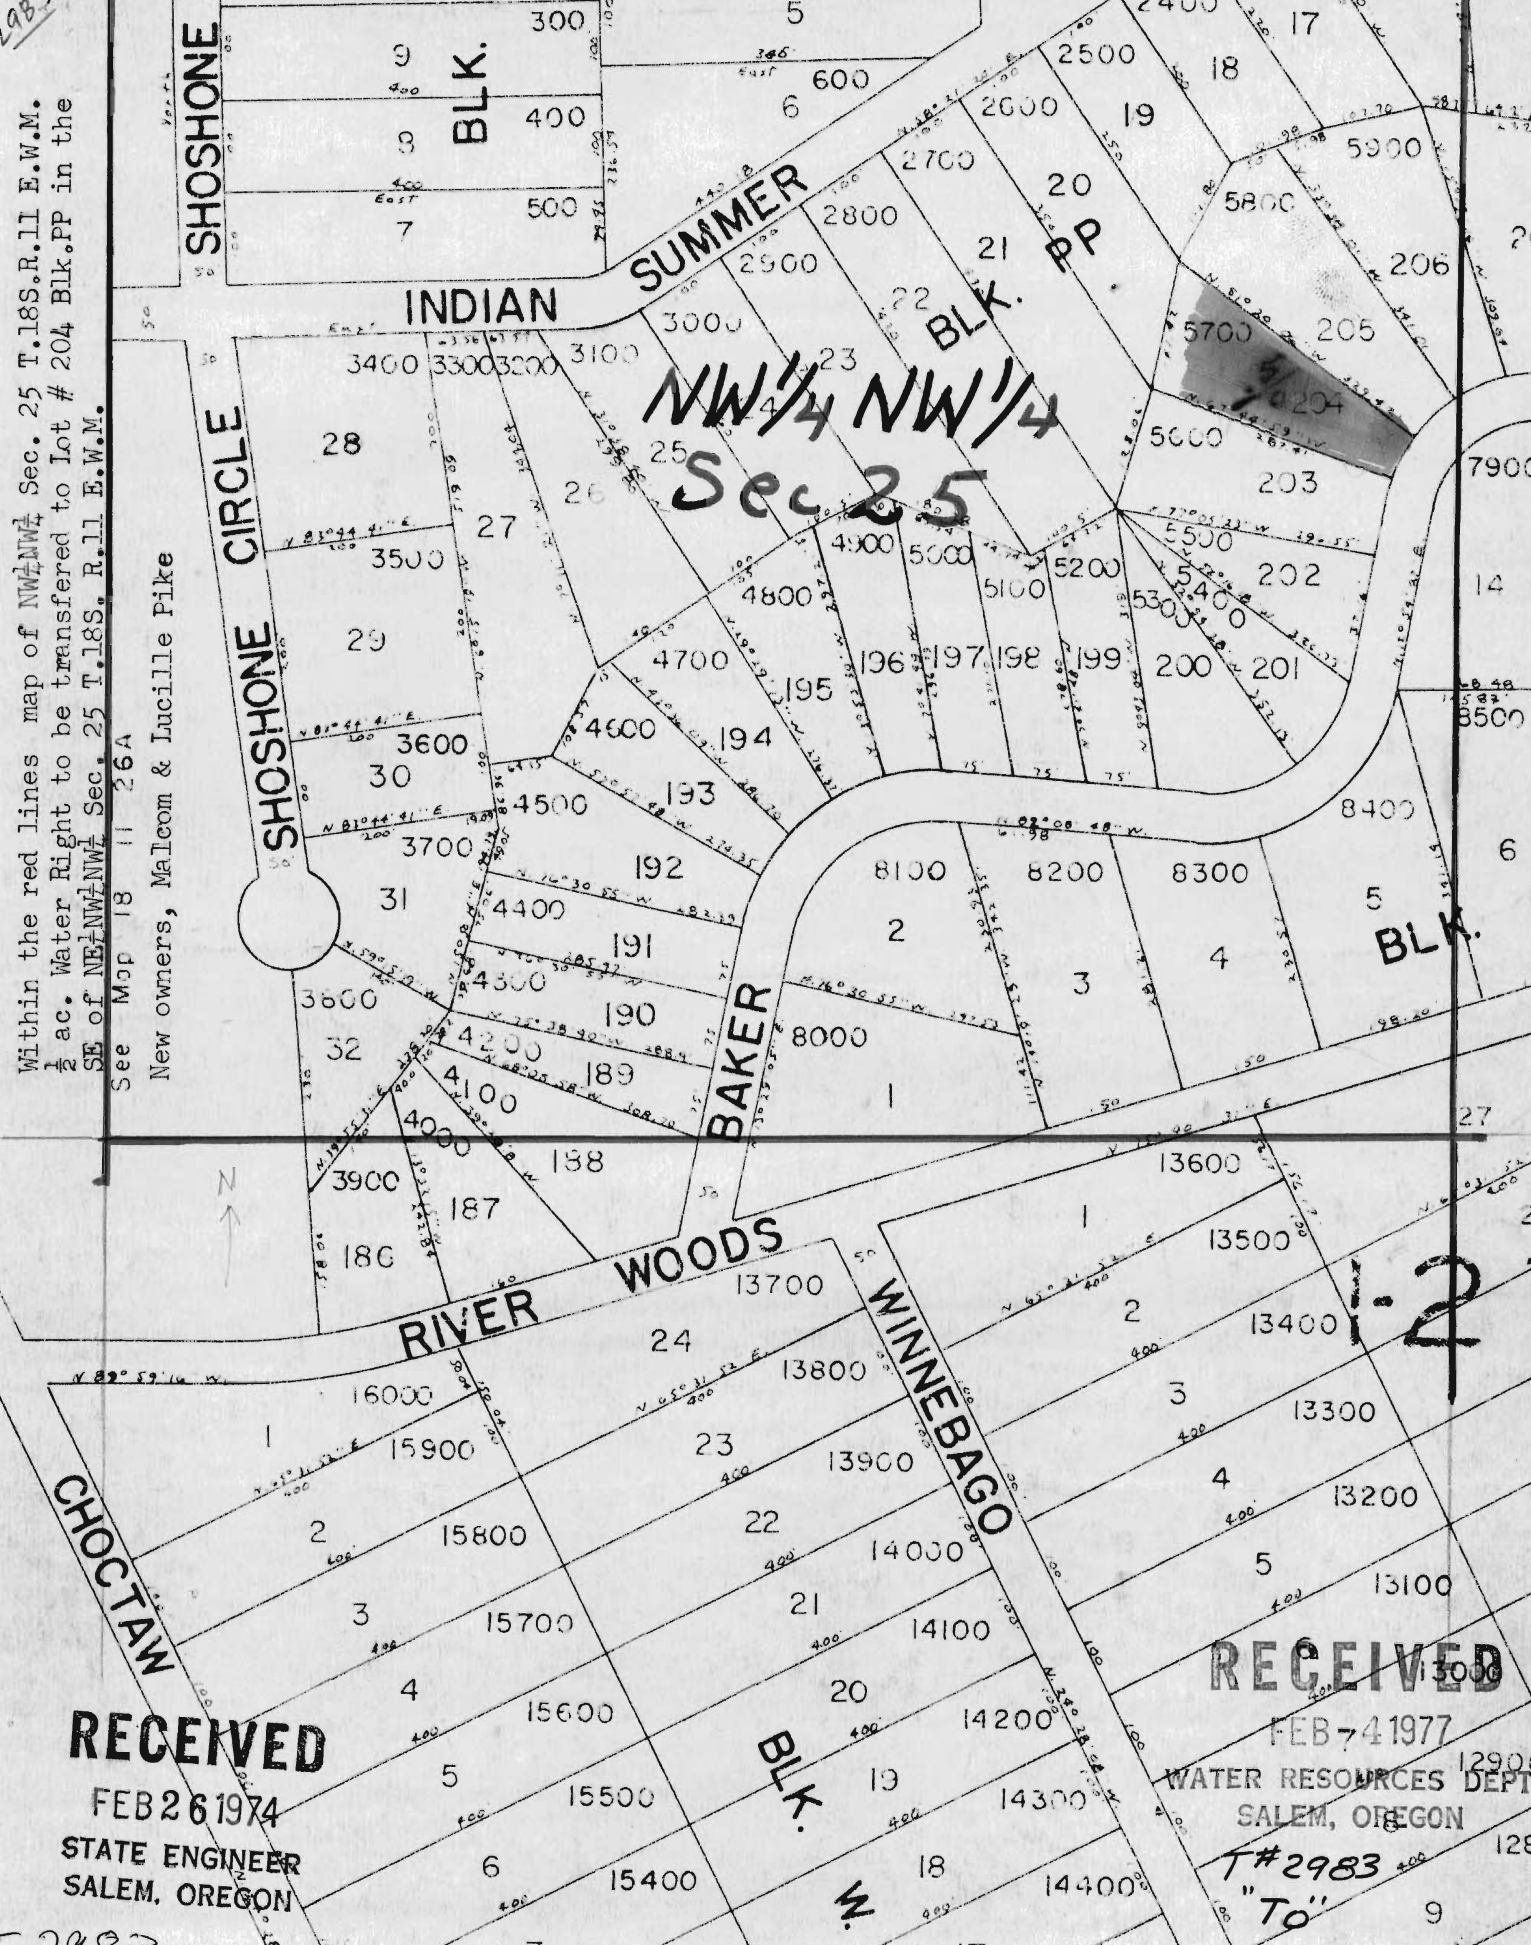

RECEIVED

FEB - 4 1977

WATER RESOURCES DEPT.
SALEM, OREGON

NW 1/4 NE 1/4 SEC. 8 T.18S. R.12 E.W.M.

18 12 8AB

DESCHUTES COUNTY

SCALE: 1" = 100'

See Map 18 12 5DC

HAYES AVENUE

500 600

25

NW 1/4 NE 1/4

CANAL

ACREAGE

200 100

CENTRAL

OREGON

HIGHWAY 2

SECTION 2
TRACTS 19-23 & 23 VACATED 12/7/21

13

23

22

21

20

REED

RECEIVED

FEB 26 1974

STATE ENGINEER
SALEM, OREGON

1/2 ac. Water Right to be transferred
off that portion of map colored red in
the ~~NW 1/4~~ NW 1/4 Sec. 8, 18S. R.12 E.W.M.
Owner Helene Van Landuyt

0.25

0.25

NW 1/4 NE 1/4

REED

See Map 18 12 8AC

AVE.

18 12 8AB

T#2983 "FROM"

See Map 18 12 8B

See Map 18 12 8AA