

~~Section 21 1900~~

~~10.11~~
~~4.3~~
~~5.7~~

SEC. 21 T.17S. R.12 E.W.M.

17 12 21


Tax Lot 400 Deed
1402

DESCHUTES COUNTY

SCALE: 1" = 400'

See Map 17 12 16C

See Map 17 12 16

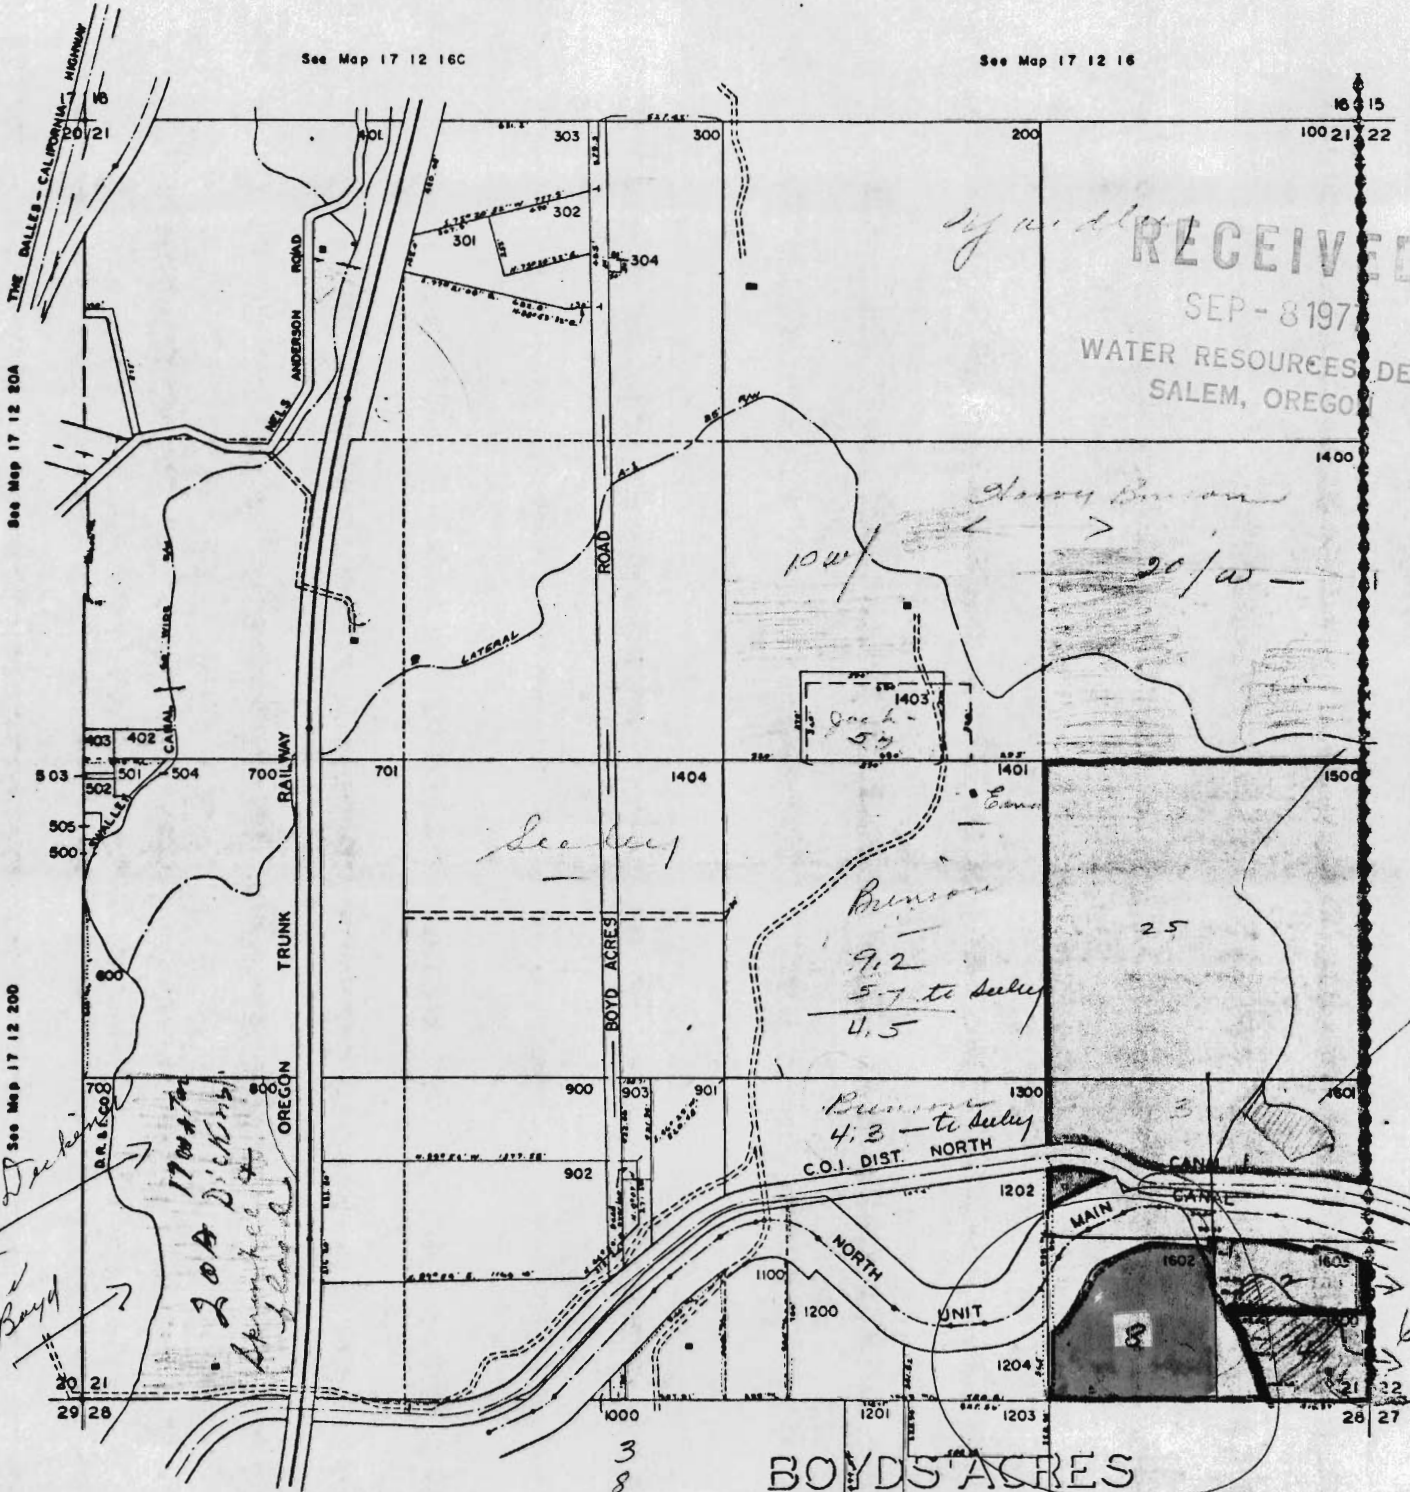

See Map 17 12 20A

See Map 17 12 200

See Map 17 12 22

See Map 17 12 28B

See Map 17 12 28A

17 12 21

BOYD'S ACRES

— IN DUGAN
— UNDER CONVEY OR DEAD END

17

30-16-12

T16S, R12E

Sec 32

11/20/73

Transfer application
to State Engineer

~~30-16-12~~

← Action 24-16-12

