

44°00'45"N 123°02'56"W



RECEIVED  
NOV 14 2022

(44°00'45"N 123°02'52"W) 962 ft

ogle



RECEIVED


NOV 14 2022

OWRD

SANITARIAN CITY

DATE 3/24/06

SP-00-  
NO ADI  
BET

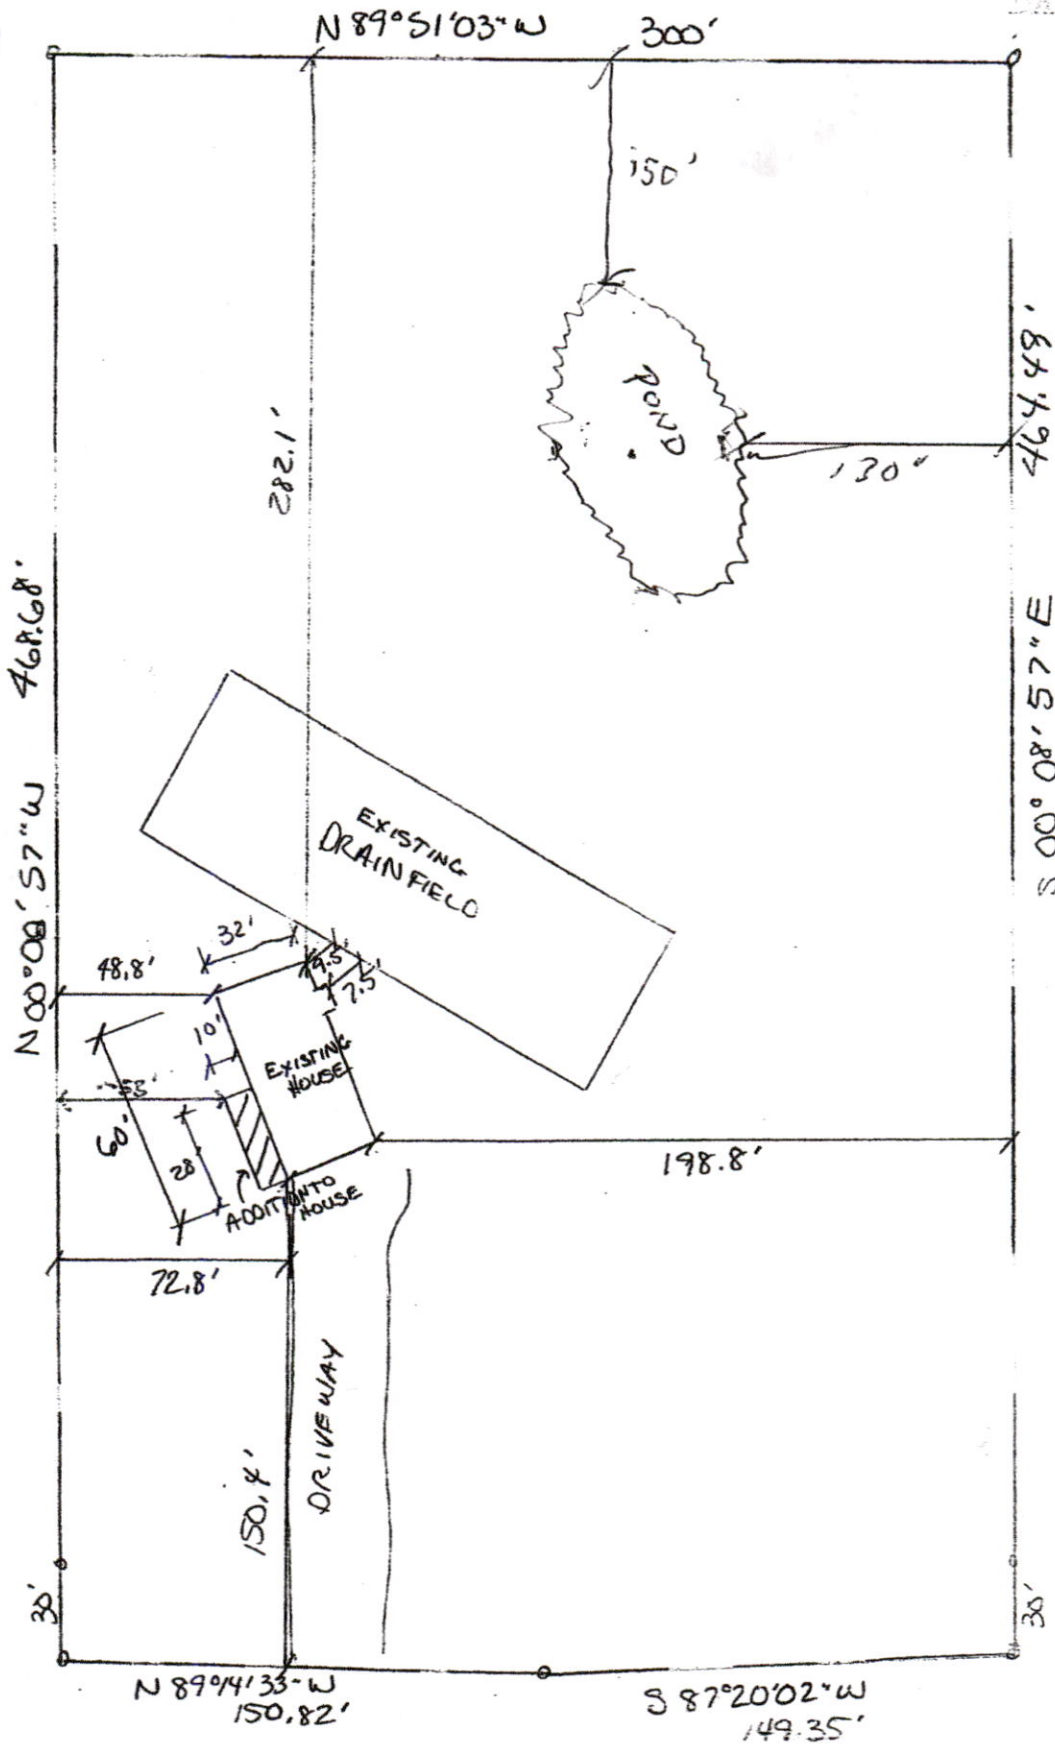

REC'D MAR

AS-BUILT  
DRAWING

E. 40TH AVE