


RECEIVED

MAR 09 2023

Applicant:
David Chamberland and Shireen Chamberland
DBA: Chamberland Vineyards, Inc.
6025 Hughes Road - Medford, OR 97504

OWRD
SALEM, OREGON

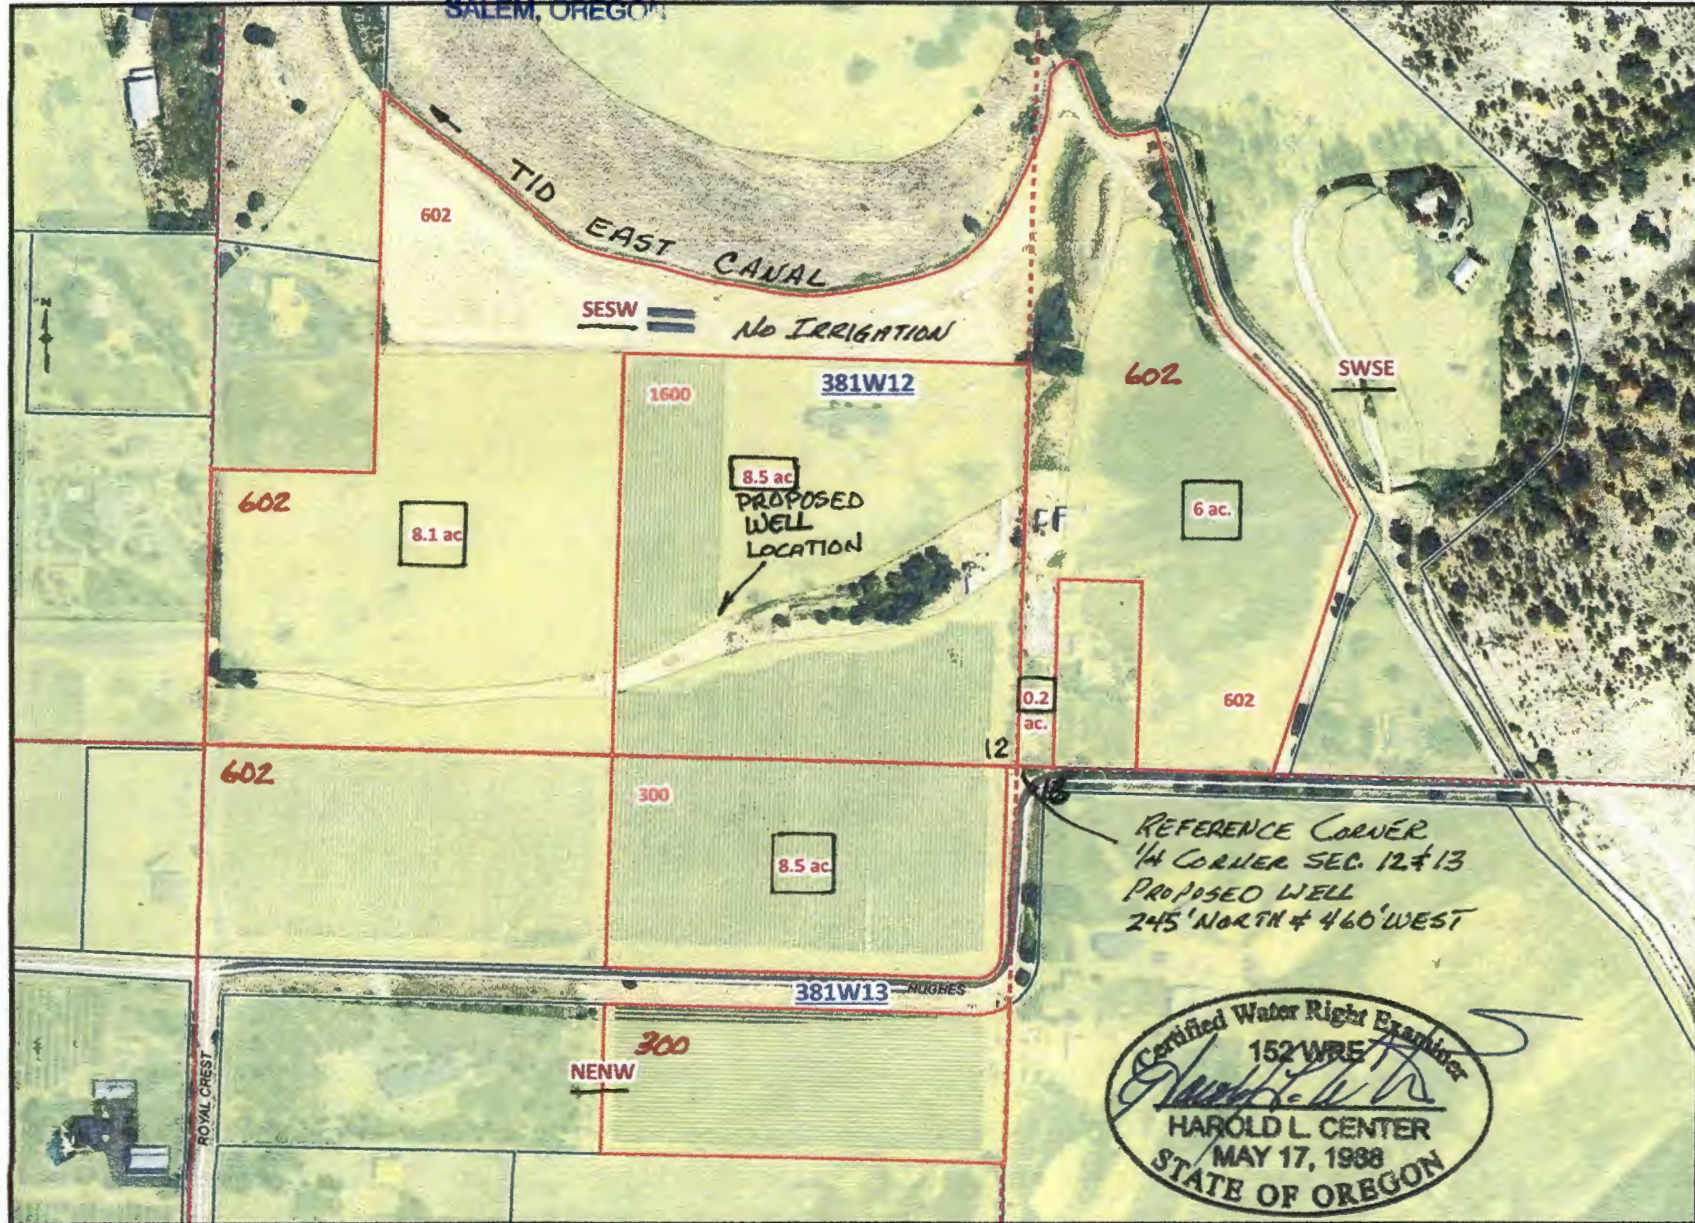

TALENT IRRIGATION DISTRICT

Water Rights Map

38 1W 12
SESW, SWSE

38 1W 13
NENW

Cert 79212 (P)
Cert 83727 (S)
Total: 31.3 ac

PROPOSED WELL LOCATION:
42° 16' 23.68"
122° 46' 09.00"
WELL LOCATION DETERMINED BY HAROLD L. CENTER
CWRE No 152

	TAXLOTS
	SELECTED TL
	IRR



1" = 300'

Certified Water Right Examiner
152 WRE
Harold L. Center
HAROLD L. CENTER
MAY 17, 1988
STATE OF OREGON

NOTE - TID IRRIGATION SHOWN IN GREEN

RENEWS: 12/31/23