

SE 1/4 SEC. 28
T.35S., R.46E., W.M.
MALHEUR COUNTY
SCALE: 1" = 2000'

ENGINEER

DK & ASSOCIATES, INC.
ATTN: DAVID KARR
PO BOX 12766
SALEM, OR 97309

PH: 503.606.3006
FAX: 503.606.3007

OWNER

DEPARTMENT OF STATE LANDS
EASTERN REGION OFFICE
ATTN: RANDY WEST
1645 NE FORBES ROAD
SUITE 112
BEND, OR 97701


PH: 541.388.6456

LEGEND

OHWM - OBSERVED HIGH WATER MARK
HWS - HIGH WATER SURFACE
WS - WATER SURFACE

SHEET INDEX


1 - COVER SHEET, PLAN VIEW, VICINITY MAP
2 - RESERVOIR PROFILES

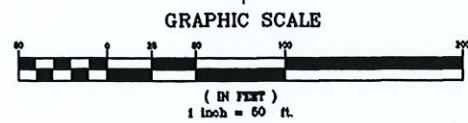

SE COR. SEC 28
T. 35S., R. 46E., W.M.

THE CONTROL MONUMENT FOR THE RESERVOIR BEARS N11°26'00"W 2918.18' FROM THE SE CORNER OF SECTION 28, TOWNSHIP 35 SOUTH, RANGE 46 EAST, W.M., MALHEUR COUNTY, OREGON

DK & Associates
CIVIL ENGINEERING & LAND SURVEYING
PO BOX 12766
SALEM, OR 97309
PH: 503.606.3006
FAX: 503.606.3007

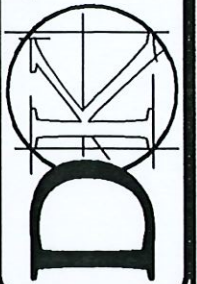

OREGON

MALHEUR COUNTY
ASBUILT SURVEY RESERVOIR #4 - APP. NO. _____
SE 1/4 SEC. 28, T.35S., R.46E., W.M. - MALHEUR COUNTY



DSN	N/A
DMN	DNK
SDN	DNK
DATE	11/29/06
SHEET	1 OF 2
JOB NUMBER	06-134

RECEIVED
DEC 26 2006
WATER RESOURCES
SALEM, OREGON