


NW 1/4 SEC. 28  
T. 32S., R. 44E., W.M.  
MALHEUR COUNTY  
SCALE: 1" = 2000'

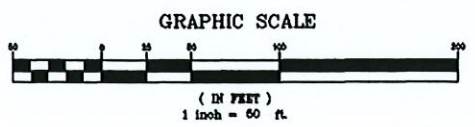

THE CONTROL MONUMENT FOR THE RESERVOIR BEARS N13°52'00"E 225.68' FROM THE NW CORNER OF SECTION 28, TOWNSHIP 32 SOUTH, RANGE 44 EAST, W.M., MALHEUR COUNTY, OREGON

**ENGINEER**

DK & ASSOCIATES, INC.  
ATTN: DAVID KARR  
PO BOX 12766  
SALEM, OR 97309  
PH: 503.606.3006  
FAX: 503.606.3007

**OWNER**

DEPARTMENT OF STATE LANDS  
EASTERN REGION OFFICE  
ATTN: RANDY WIEST  
1645 NE FORBES ROAD  
SUITE 112  
BEND, OR 97701  
PH: 541.388.6456

**LEGEND**


OHWM - OBSERVED HIGH WATER MARK  
HWS - HIGH WATER SURFACE  
WS - WATER SURFACE

**SHEET INDEX**

- 1 - COVER SHEET, PLAN VIEW, VICINITY MAP
- 2 - RESERVOIR PROFILES

**RECEIVED**  
DEC 26 2006  
WATER RESOURCES DEPT  
SALEM, OREGON

**DK & Associates**  
CIVIL ENGINEERING & LAND SURVEYING  
PO BOX 12766  
SALEM, OR 97309  
PH: 503.606.3006  
FAX: 503.606.3007

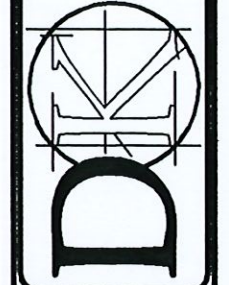

OREGON  
MALHEUR COUNTY  
ASBUILT SURVEY RESERVOIR #1 - APP. NO. \_\_\_\_\_  
NW 1/4 SEC. 28, T. 32S., R. 44E., W.M. - MALHEUR COUNTY



DATE	N/A
DATE	DMK
DATE	DMK
DATE	11/29/06
SHEET	
1	OF 2
JOB NUMBER	
06-134	