

Legend

"A" Source of Supply

"B" First Point of Diversion

"C" 42" Existing Main = SERVED ALL
the tax lots it crosses, plus
two additional lots in

Sec 31 (see map)


"D" Lafayette City Reservoir

Co-operative Shareholders

1. L. Anderson
2. ~~C. Bissonette~~
3. J. Winters
4. D. King (vested rights)
5. ~~J. Wood~~
6. D. Owens *
7. C. Fisher *
8. K. Futornick
9. D. Nelson
10. ~~D. Smith~~
11. K. Futornick *
12. ~~C. Fisher~~
13. ~~R. Fisher~~

14. J. Lewis
15. R. Johnson
16. J. McDowd
17. J. Wasker (vested rights filed)

Application No. 55690
Permit No. 42761

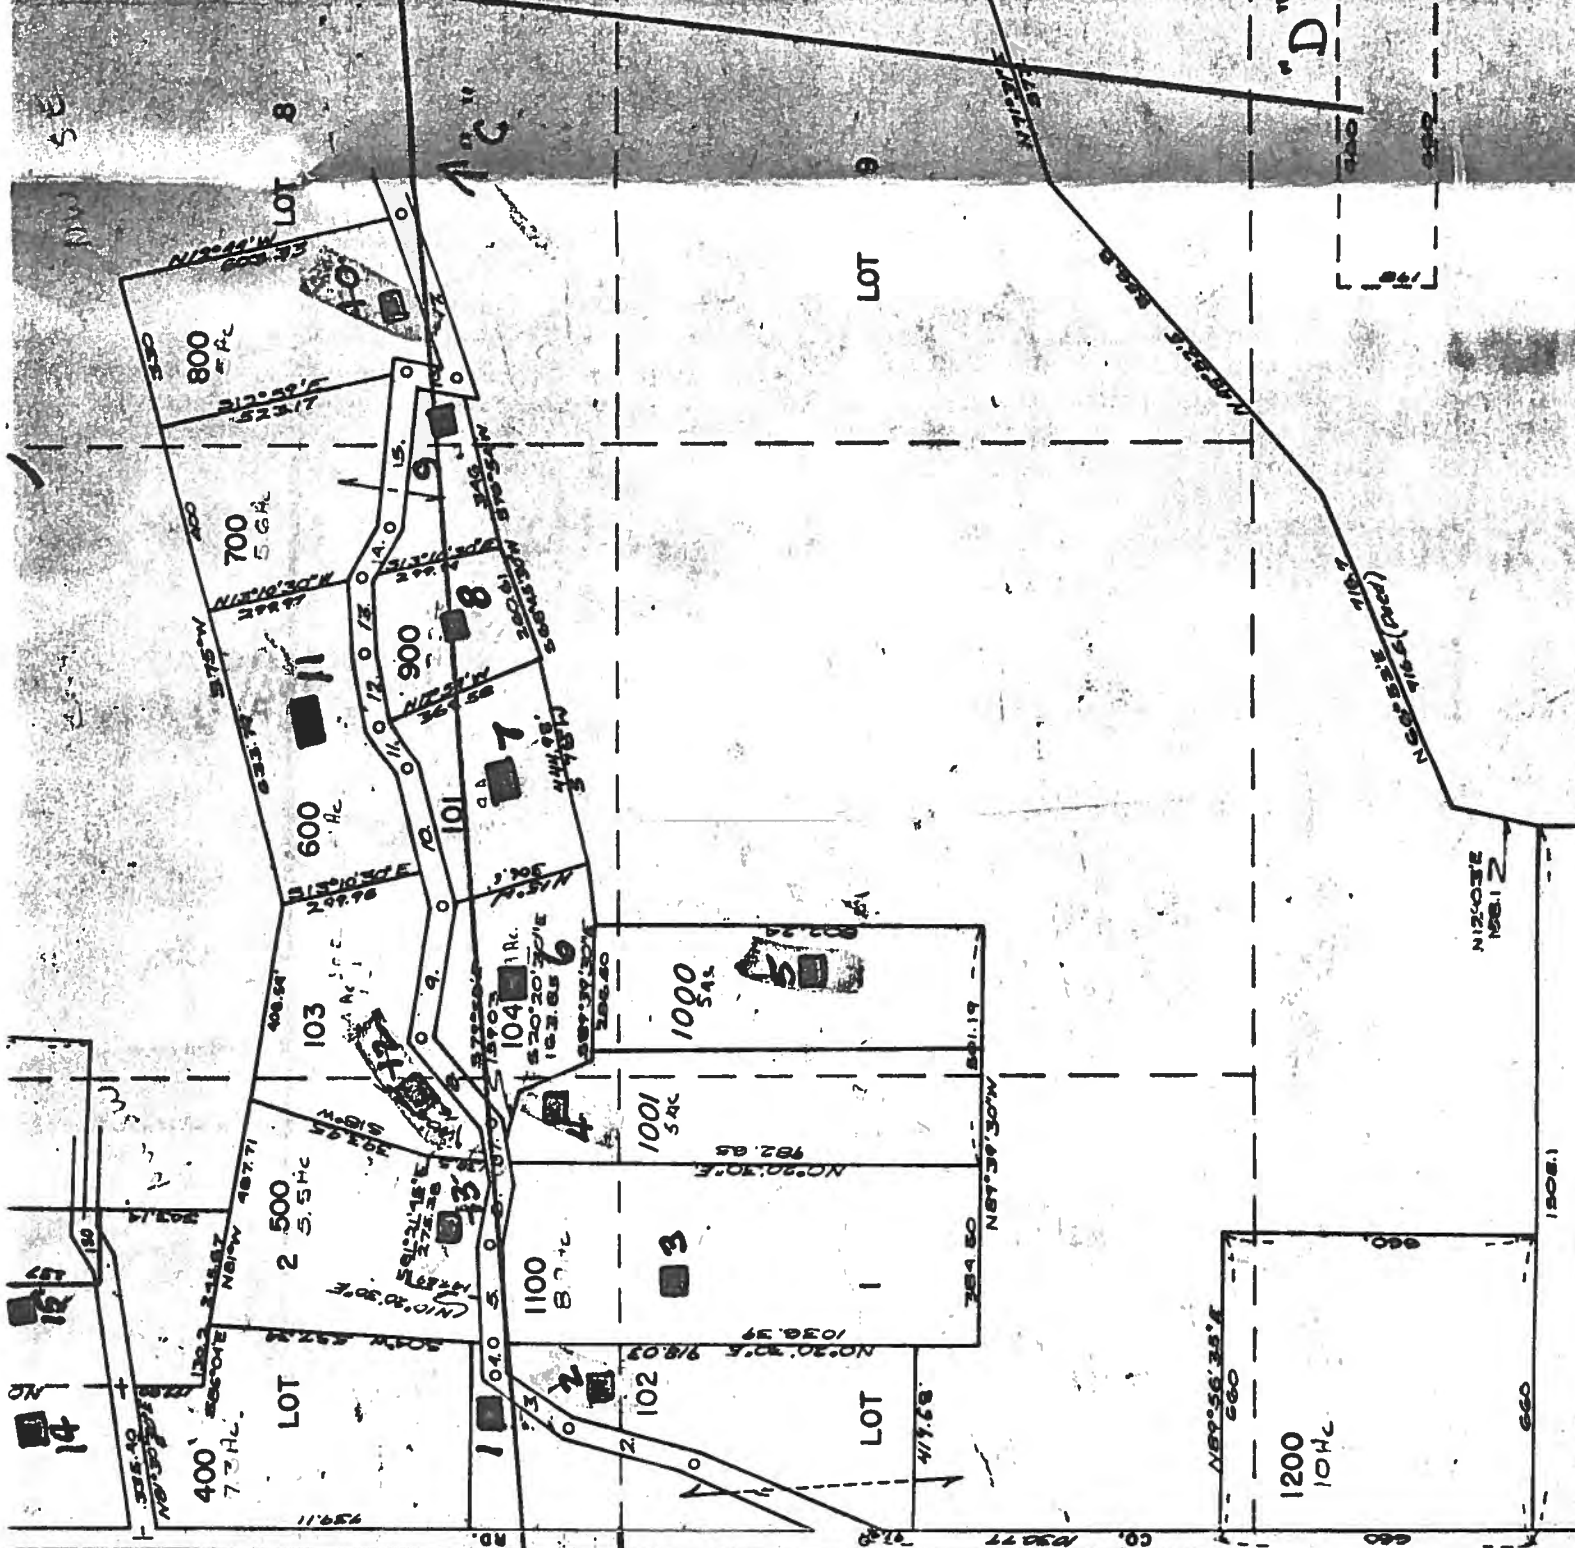

SECTION 32 T.3S. R.3W. WM.

YAMHILL COUNTY

1" = 400'

3 3 32
AERIAL 3DD 137

RECEIVED

APR 15 1977

WATER RESOURCES DEPT.
EM. OREGON

RECEIVED

MAR 17 1978

WATER RESOURCES DEPT.
SALIN, CALIF.

8.3

Spring

Legend

- "A" Source of Supply
"B" First Point of Diversion
"C" "2" Existing MAIN = SERVES ALL
the TAX LOTS it CROSSES, plus
two ADDITIONAL LOTS in
Sec 31 (see MAP)
"D" Lafayette City Reservoir

Co-operative Shareholders

1. L. ANDERSON
2. C. Bissonette
3. J. WINTERS
4. D. KING (vested Rights filed)
5. J. Wood
6. D. Owens*
7. C. Fisher*
8. K. Futornick
9. D. NELSON
10. D. Smith
11. K. Futornick*
12. C. Fisher
14. J. Lewis
15. R. Johnson
16. J. McDOWALL
17. J. Warcher (vested Rights filed)

1. N22°00'55"E 315.11
2. N25°53'05"E 102.60
3. N15°54'25"E 295.52
4. N35°02'05"E 180.35
5. N85°09'15"E 300.50
6. S71°45'45"E 421.91
7. N80°06'40"E 123.94
8. N49°34'50"E 232.88
9. S71°56'40"E 287.05
10. N71°11'50"E 274.45
11. N55°31'30"E 127.05
12. N79°16'35"E 164.91
13. N85°17'50"E 151
14. S59°54'E 134.73
15. S85°40'25"E 214.44
16. S11°44'W 123.57
17. N70°31'30"E 381.37

Application No. 55690
Permit No. 42761

YAMHILL COUNTY


1" = 400'

3 3 32
AERIAL 3DD 13730 29
31 3229 28
32 33Legend

- "A" Source of Supply
- "B" First Point of Diversion
- "C" "2" Existing MAIN = SERVES ALL
the TAX LOTS it CROSSES, PLUS
two ADDITIONAL LOTS IN
Sec 31 (see MAP)
- "D" Lafayette City Reservoir

Co-operative Shareholders

1. L. ANDERSON
2. C. BISSONETTE
3. J. WINTERS
4. D. KING (Vested Rights filed)
5. J. WOOD
6. D. OWENS *
7. C. FISHER *
8. K. FUTORNICK
9. D. NELSON
10. D. SMITH
11. K. FUTORNICK *
12. C. FISHER
13. R. FISHER
14. J. LEWIS
15. R. JOHNSON
16. J. McDOWALL
17. J. WACHEN (Vested Rights filed)

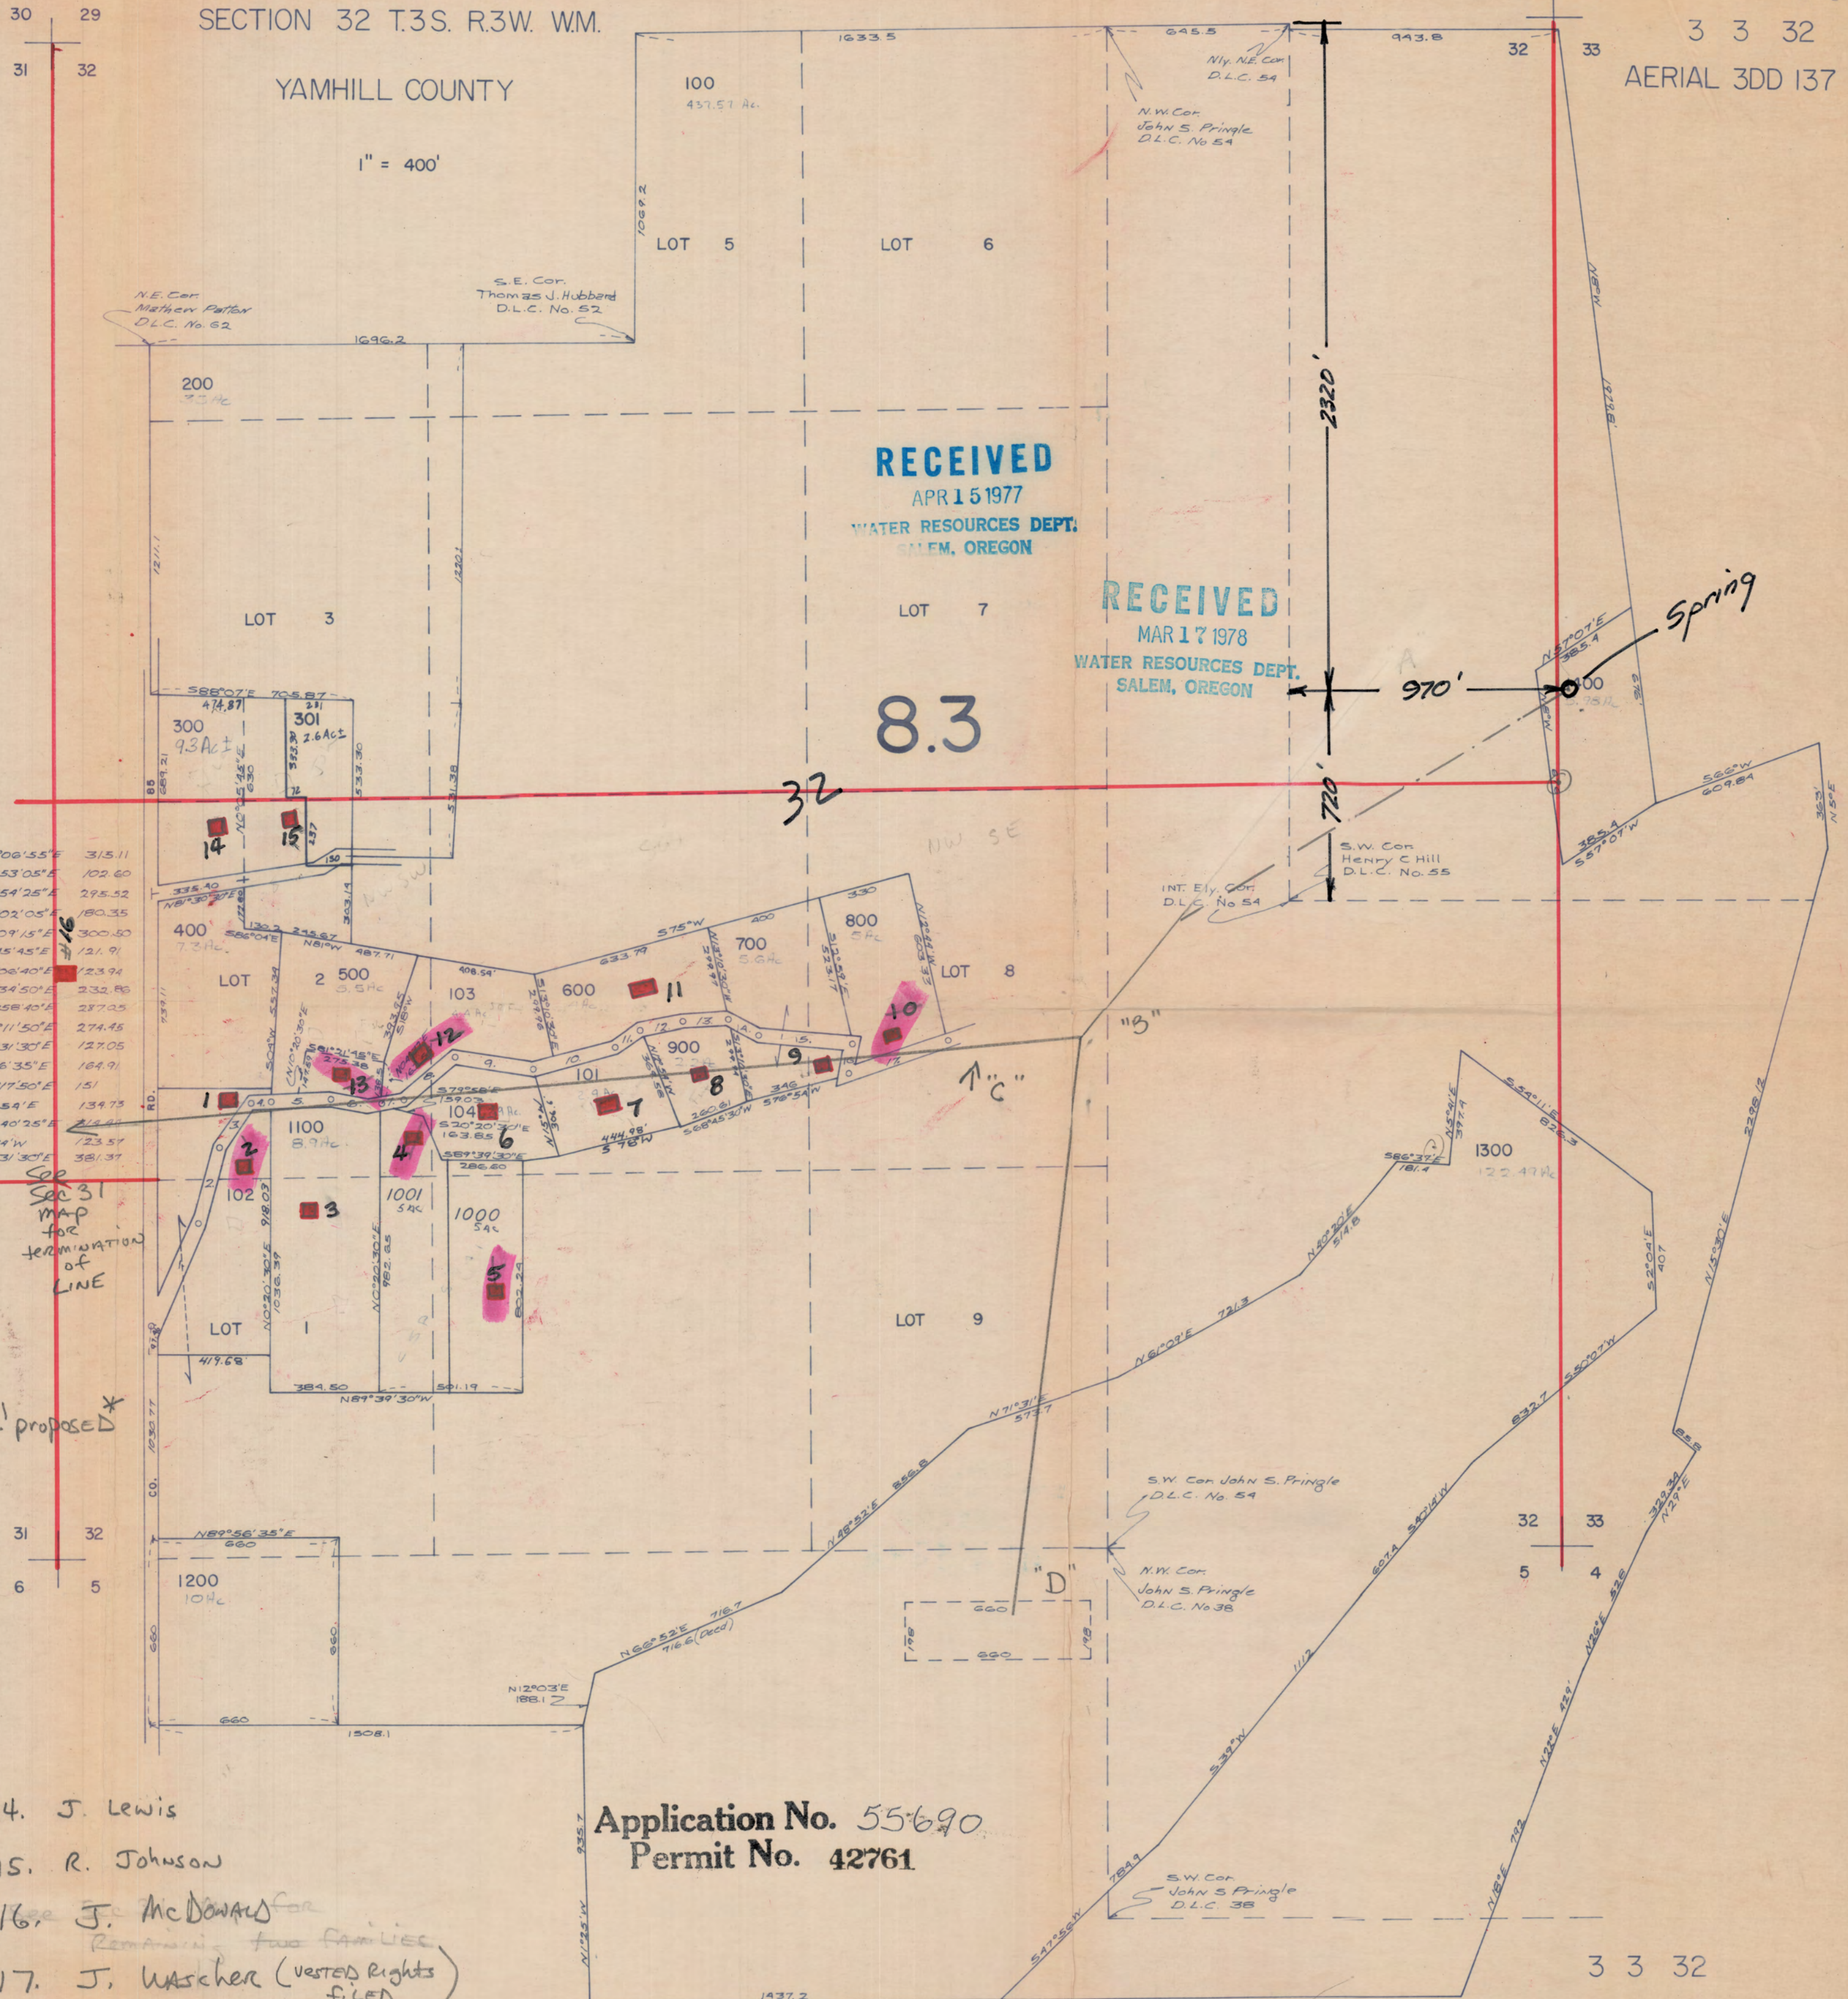

Application No. 55690
Permit No. 42761

SECTION 32 T.3S. R.3W. WM.

YAMHILL COUNTY

1" = 400'

3 3 32
AERIAL 3DD 137


Legend

- "A" Source of Supply
 "B" First Point of Diversion
 "C" 2" Existing MAIN = SERVES ALL the TAX LOTS it CROSSES, plus two ADDITIONAL LOTS in Sec 31 (see MAP)
 "D" Lafayette City Reservoir

Co-operative Shareholders

- | | |
|----------------------------------|--------------------------------------|
| 1. L. ANDERSON | 14. J. Lewis |
| 2. C. Bissonette | 15. R. Johnson |
| 3. J. WINTERS | 16. J. McDONALD |
| 4. D. KING (vested Rights filed) | 17. J. WISCHER (vested Rights filed) |
| 5. J. WOOD | |
| 6. D. Owens* | |
| 7. C. Fisher* | |
| 8. K. Futornick | |
| 9. D. NELSON | |
| 10. D. Smith | |
| 11. K. Futornick* | |
| 12. C. Fisher | |
| 13. R. Fisher | |

1. N22°08'55"E 315.11
2. N25°53'05"E 102.60
3. N15°54'26"E 295.32
4. N33°02'05"E 180.35
5. N88°09'15"E 300.50
6. S74°45'45"E 121.91
7. N60°06'40"E 233.94
8. N44°34'50"E 232.85
9. S74°58'45"E 277.05
10. N76°11'50"E 274.45
11. N55°39'30"E 127.05
12. N79°16'35"E 164.91
13. N85°17'50"E 151
14. S59°54'E 134.73
15. S85°40'28"E 215.4
16. S11°44'W 123.57
17. N70°31'35"E 381.37

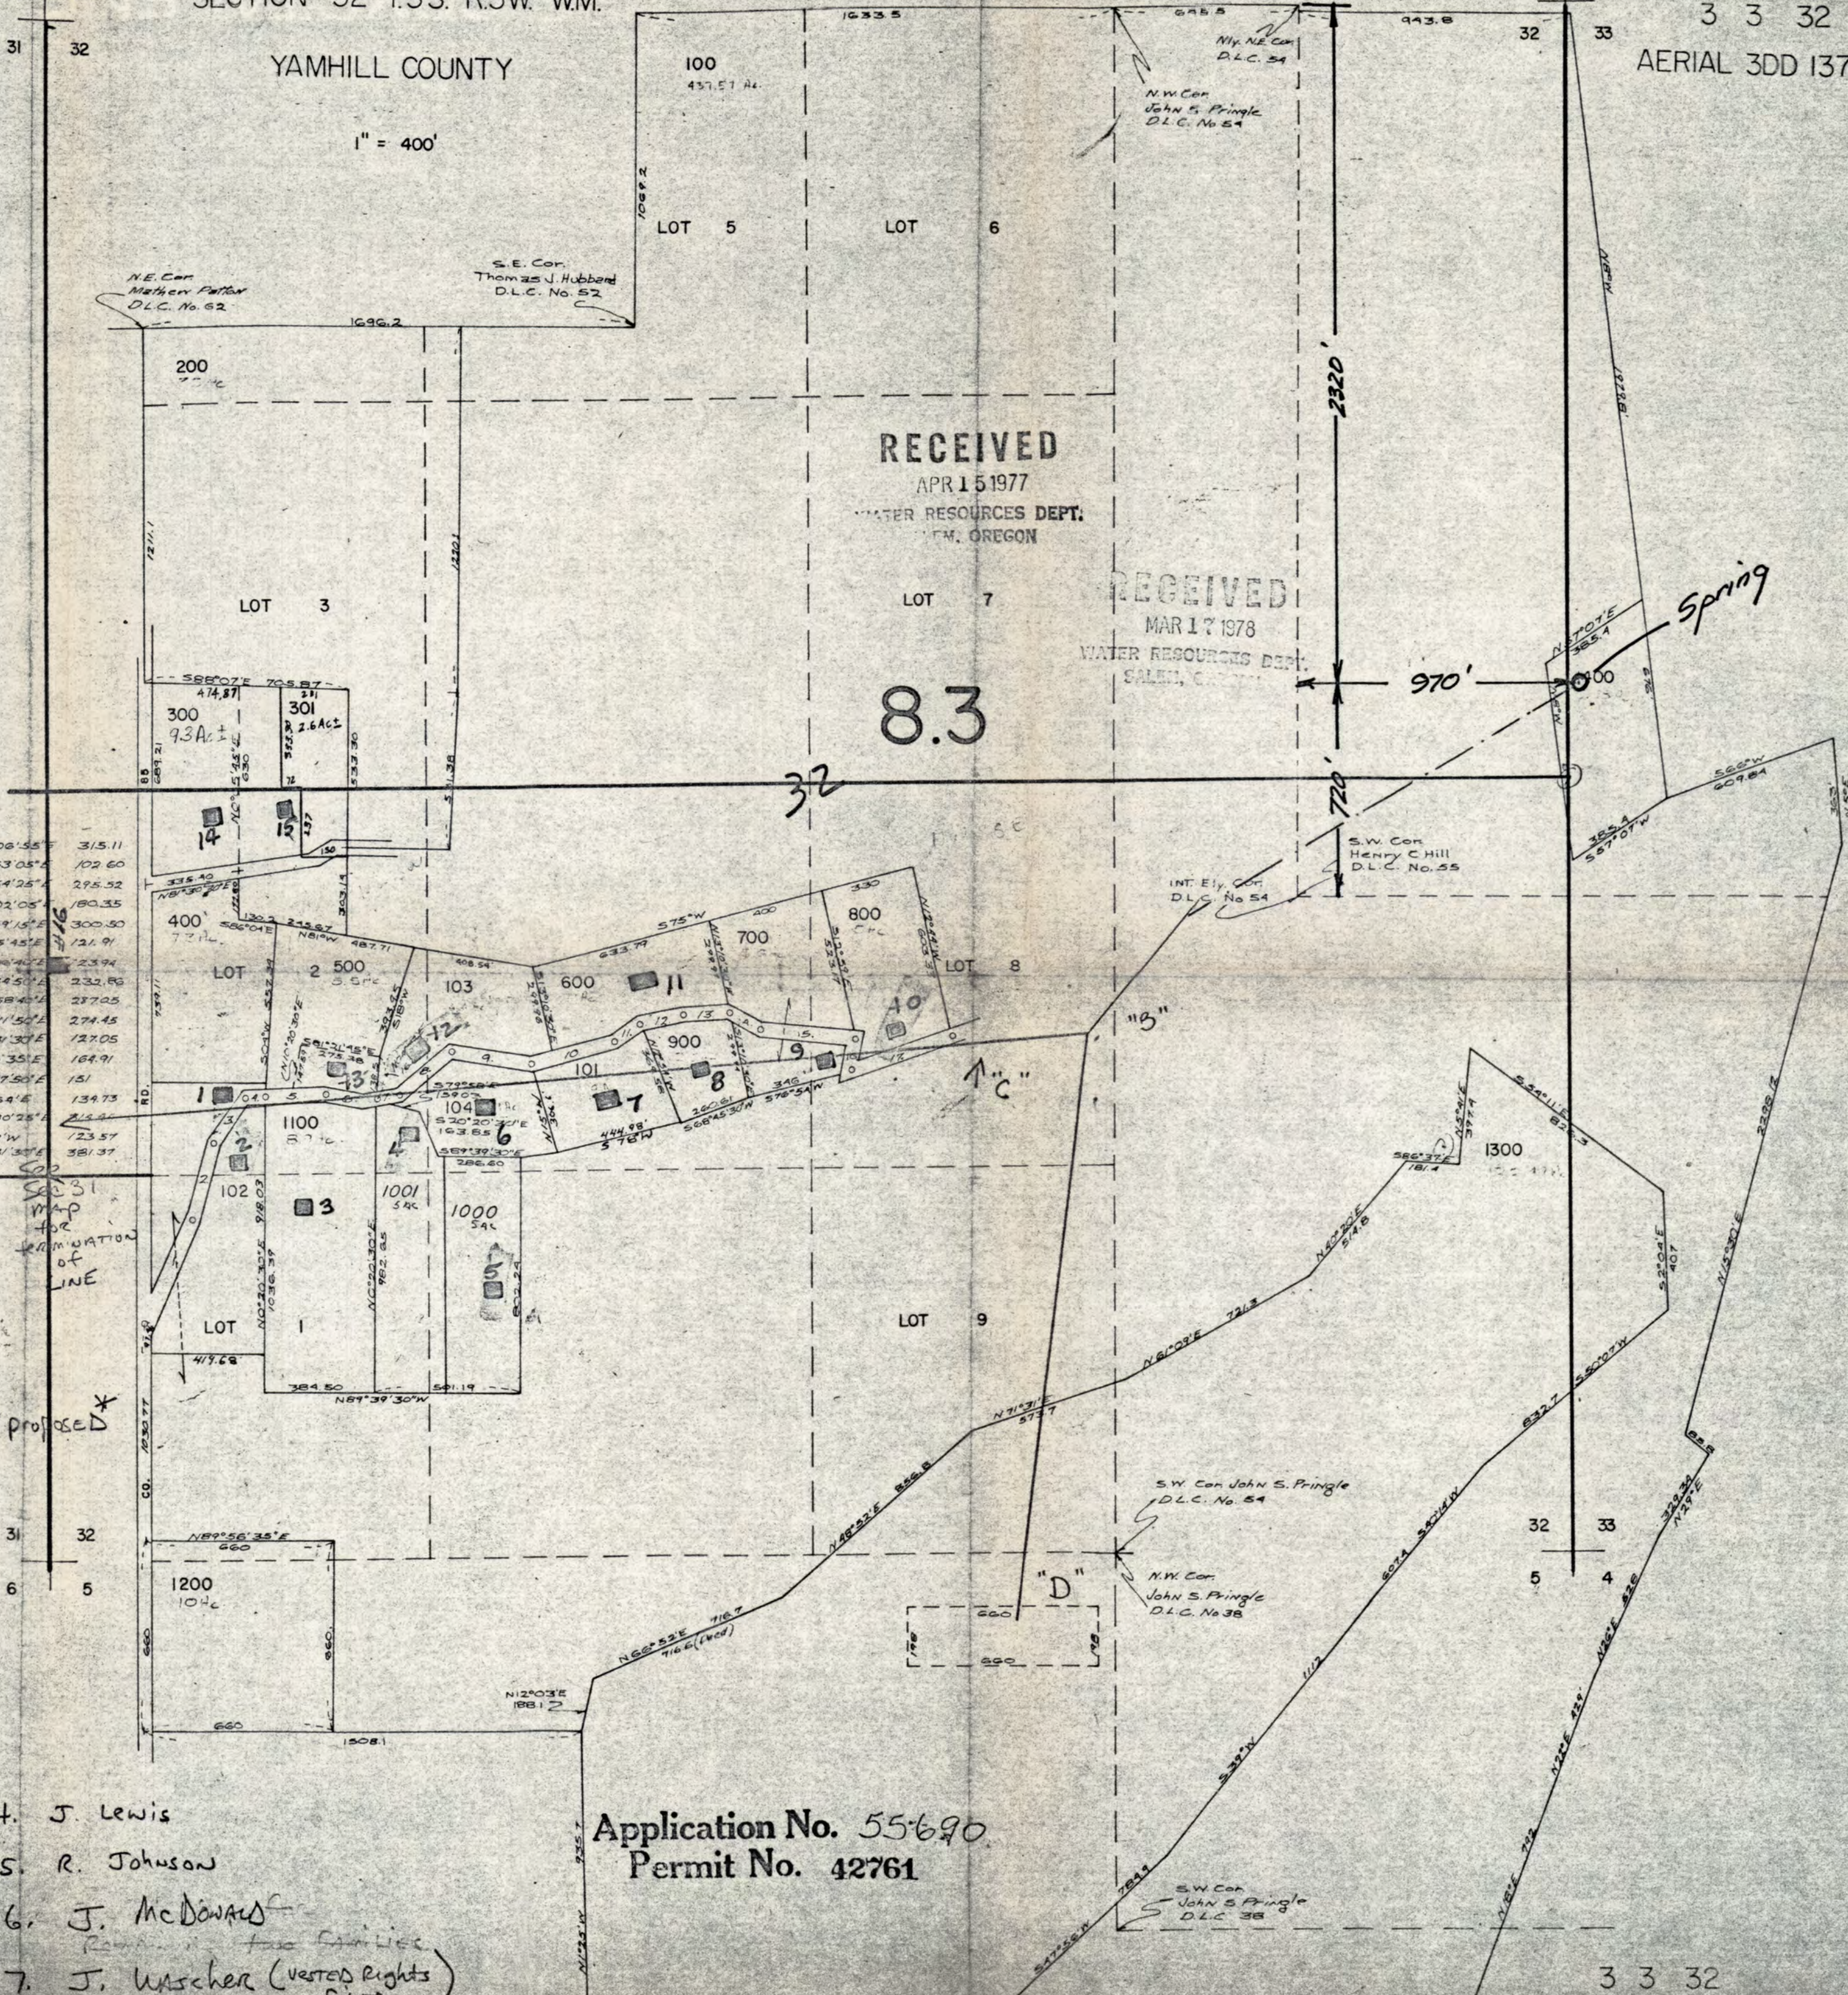

Application No. 55690
 Permit No. 42761