


FINAL PROOF SURVEY
UNDER
APPLICATION NO.R-71972 PERMIT NO.R-11518
IN THE NAME OF
NICKIE A CARTER, SR.
NE 1/4 OF THE NE 1/4
OF SECTION 27
T.11S., R.1W., W.M.
LINN COUNTY, OREGON
SCALE: 1"=400'-0"

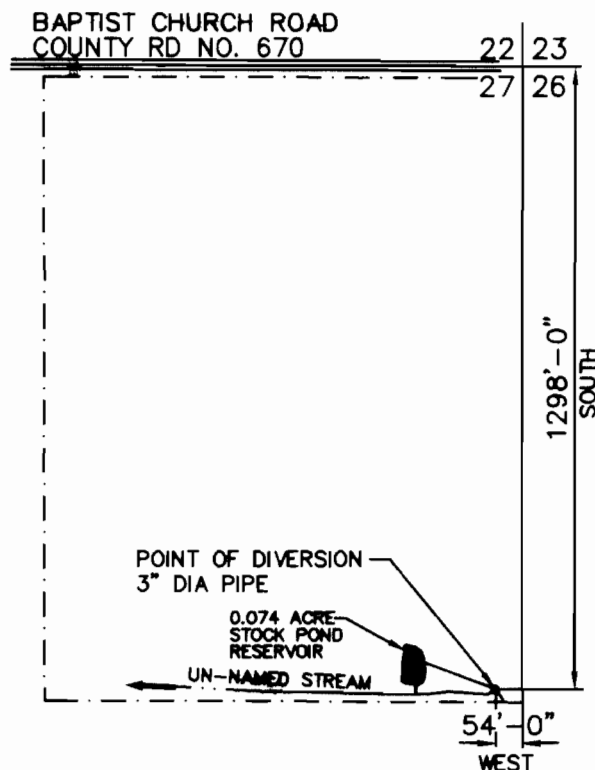


RECEIVED

SEP 30 1996

WATER RESOURCES DEPT.
SALEM, OREGON

LEGEND:

- SECTION LINE
- FORTY LINE
- - - - - PROPERTY LINE
- UN-NAMED STREAM
- TRIBUTARY OF BEAVER CREEK

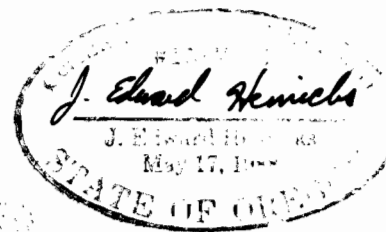

I J. EDWARD HENRICKS, BEING DULY SWORN AS A WATER RIGHT EXAMINER
LICENSE NO. 170 HAVE PREPARED THIS MAP FOR NICKIE A. CARTER, SR. ON
THIS 14th DAY OF SEPTEMBER 1996. THE AREA HATCHED REPRESENTS
THE EXISTING POND FOR STOCK WATERING.

PREPARATION OF THIS MAP IS FOR THE PURPOSE OF IDENTIFYING
THE LOCATION OF THE WATER RIGHT ONLY AND HAS NO INTENT TO PROVIDE
DIMENSIONS OR LOCATION OF PROPERTY OWNERSHIP LINES.

ONLY DOCUMENTS STAMPED
WITH RED INK ARE ORIGINALS