

POND #3

AREA=2.35 ACRE



VOLUME=35.7± ACRE-FT.

NOTE:

POND IS EXISTING. THIS DRAWING REFLECTS THE AS-BUILT CONDITION OF THE POND.





SCALE 1" = 60'

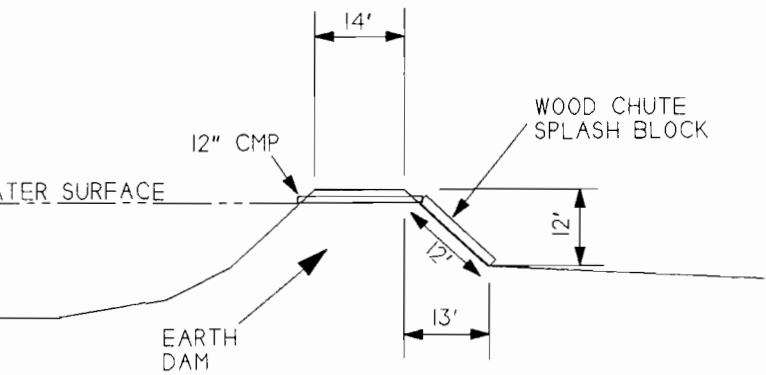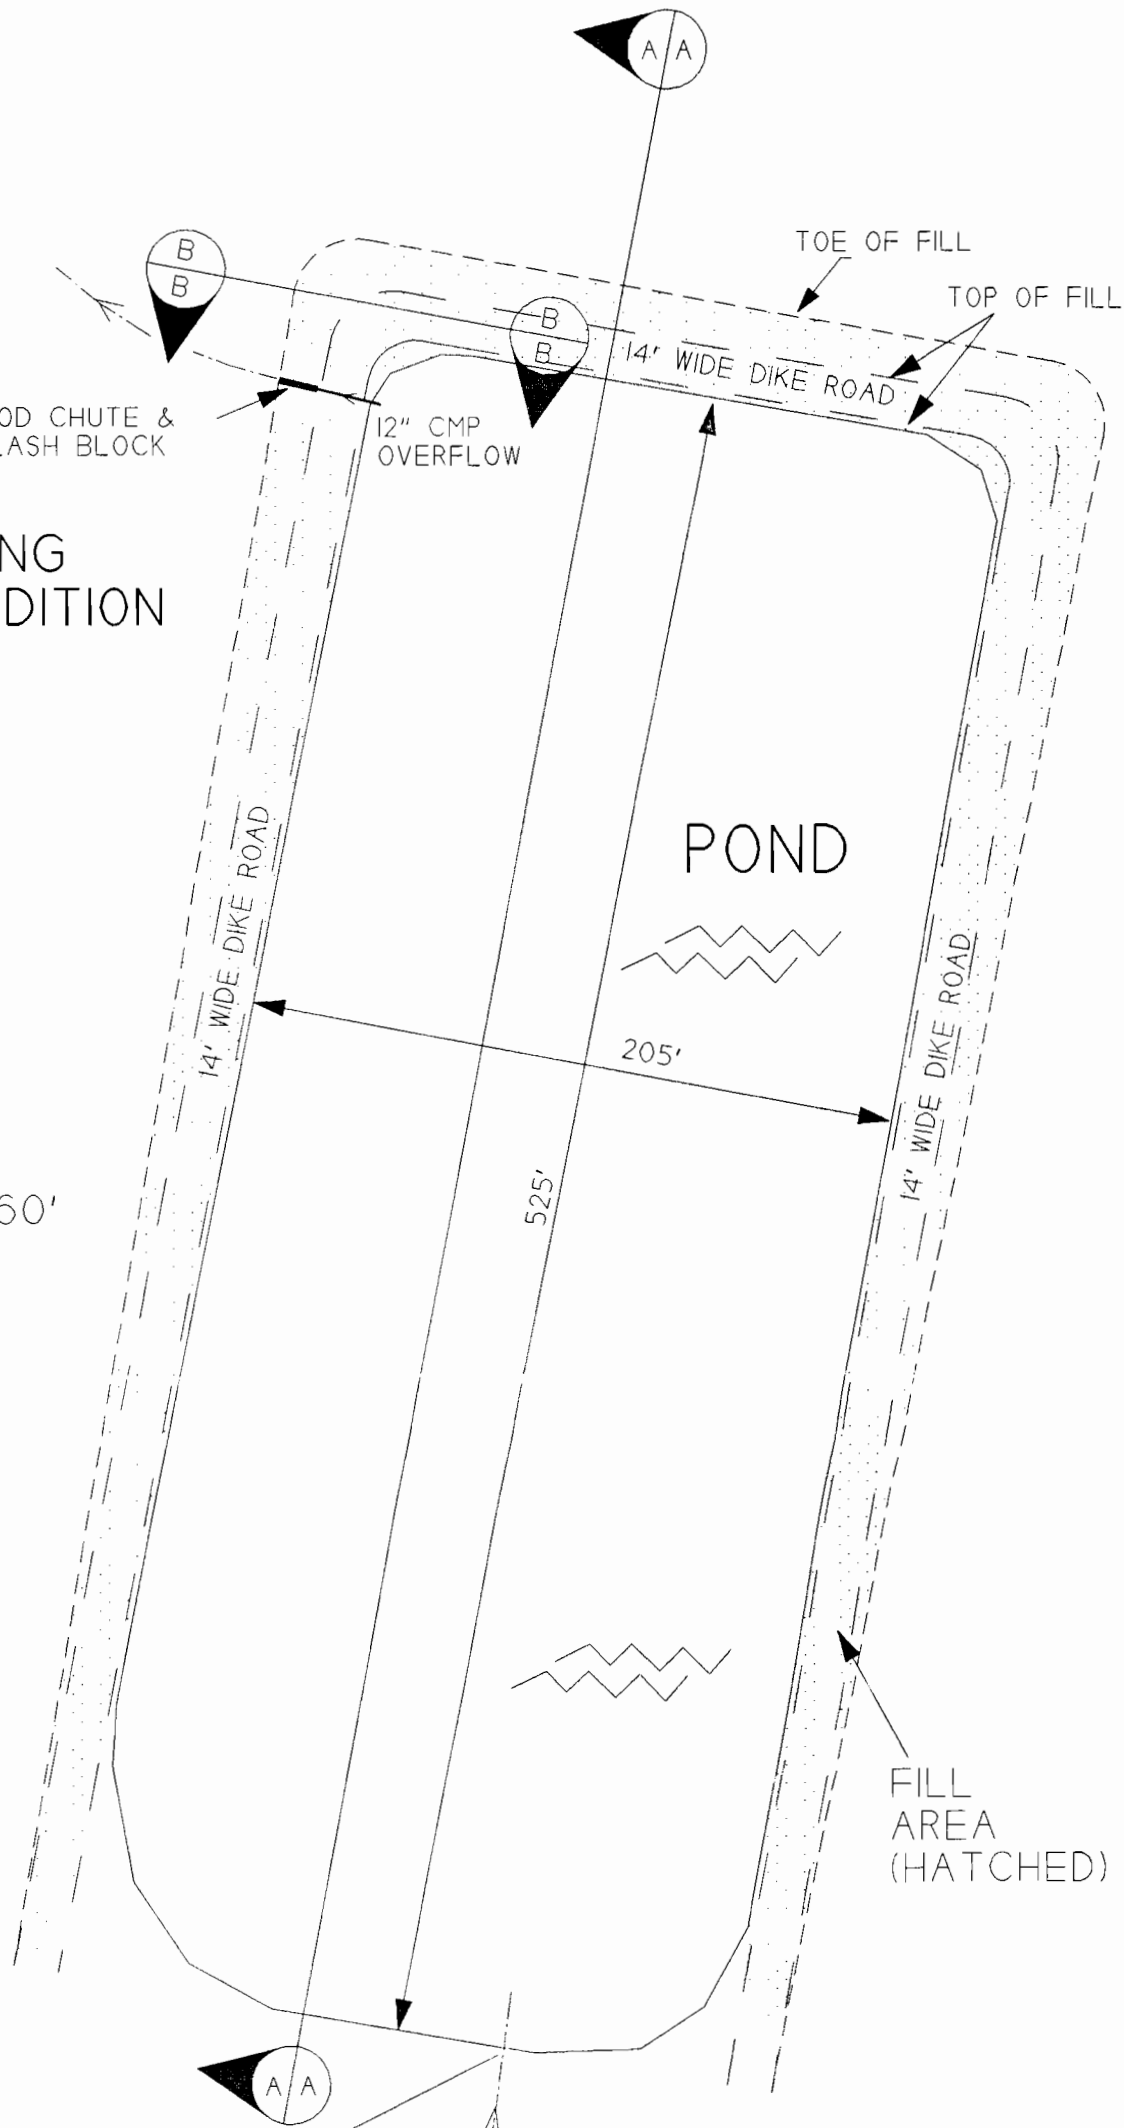

SECTION VIEW
SCALE 1"=30'

Application No. R-8938
Unit No. R12189

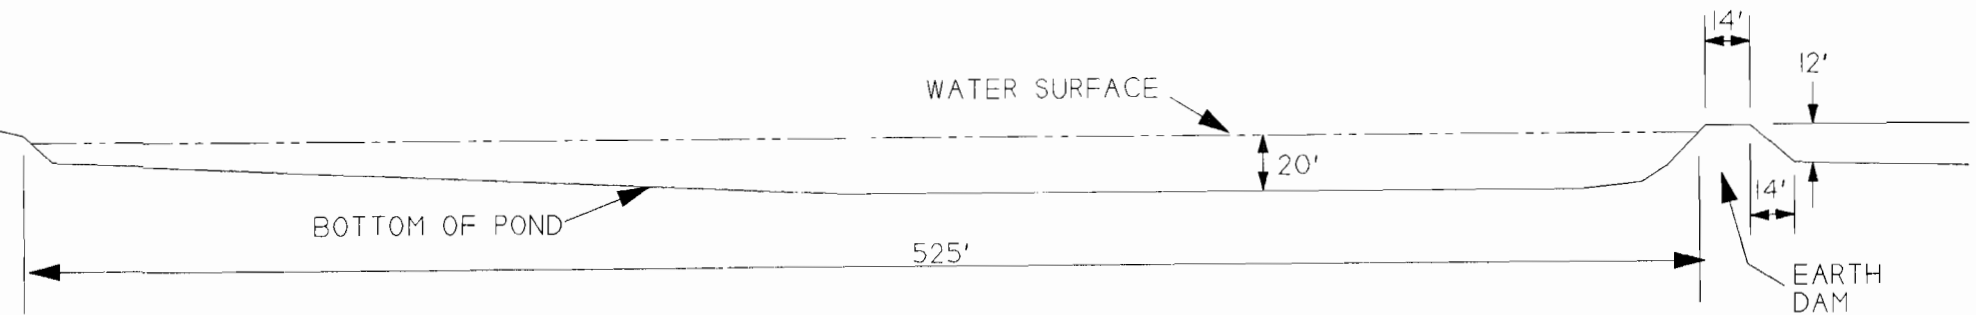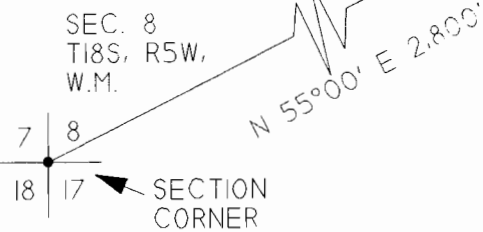

SECTION VIEW
SCALE 1"=60'