



WORK
COPY

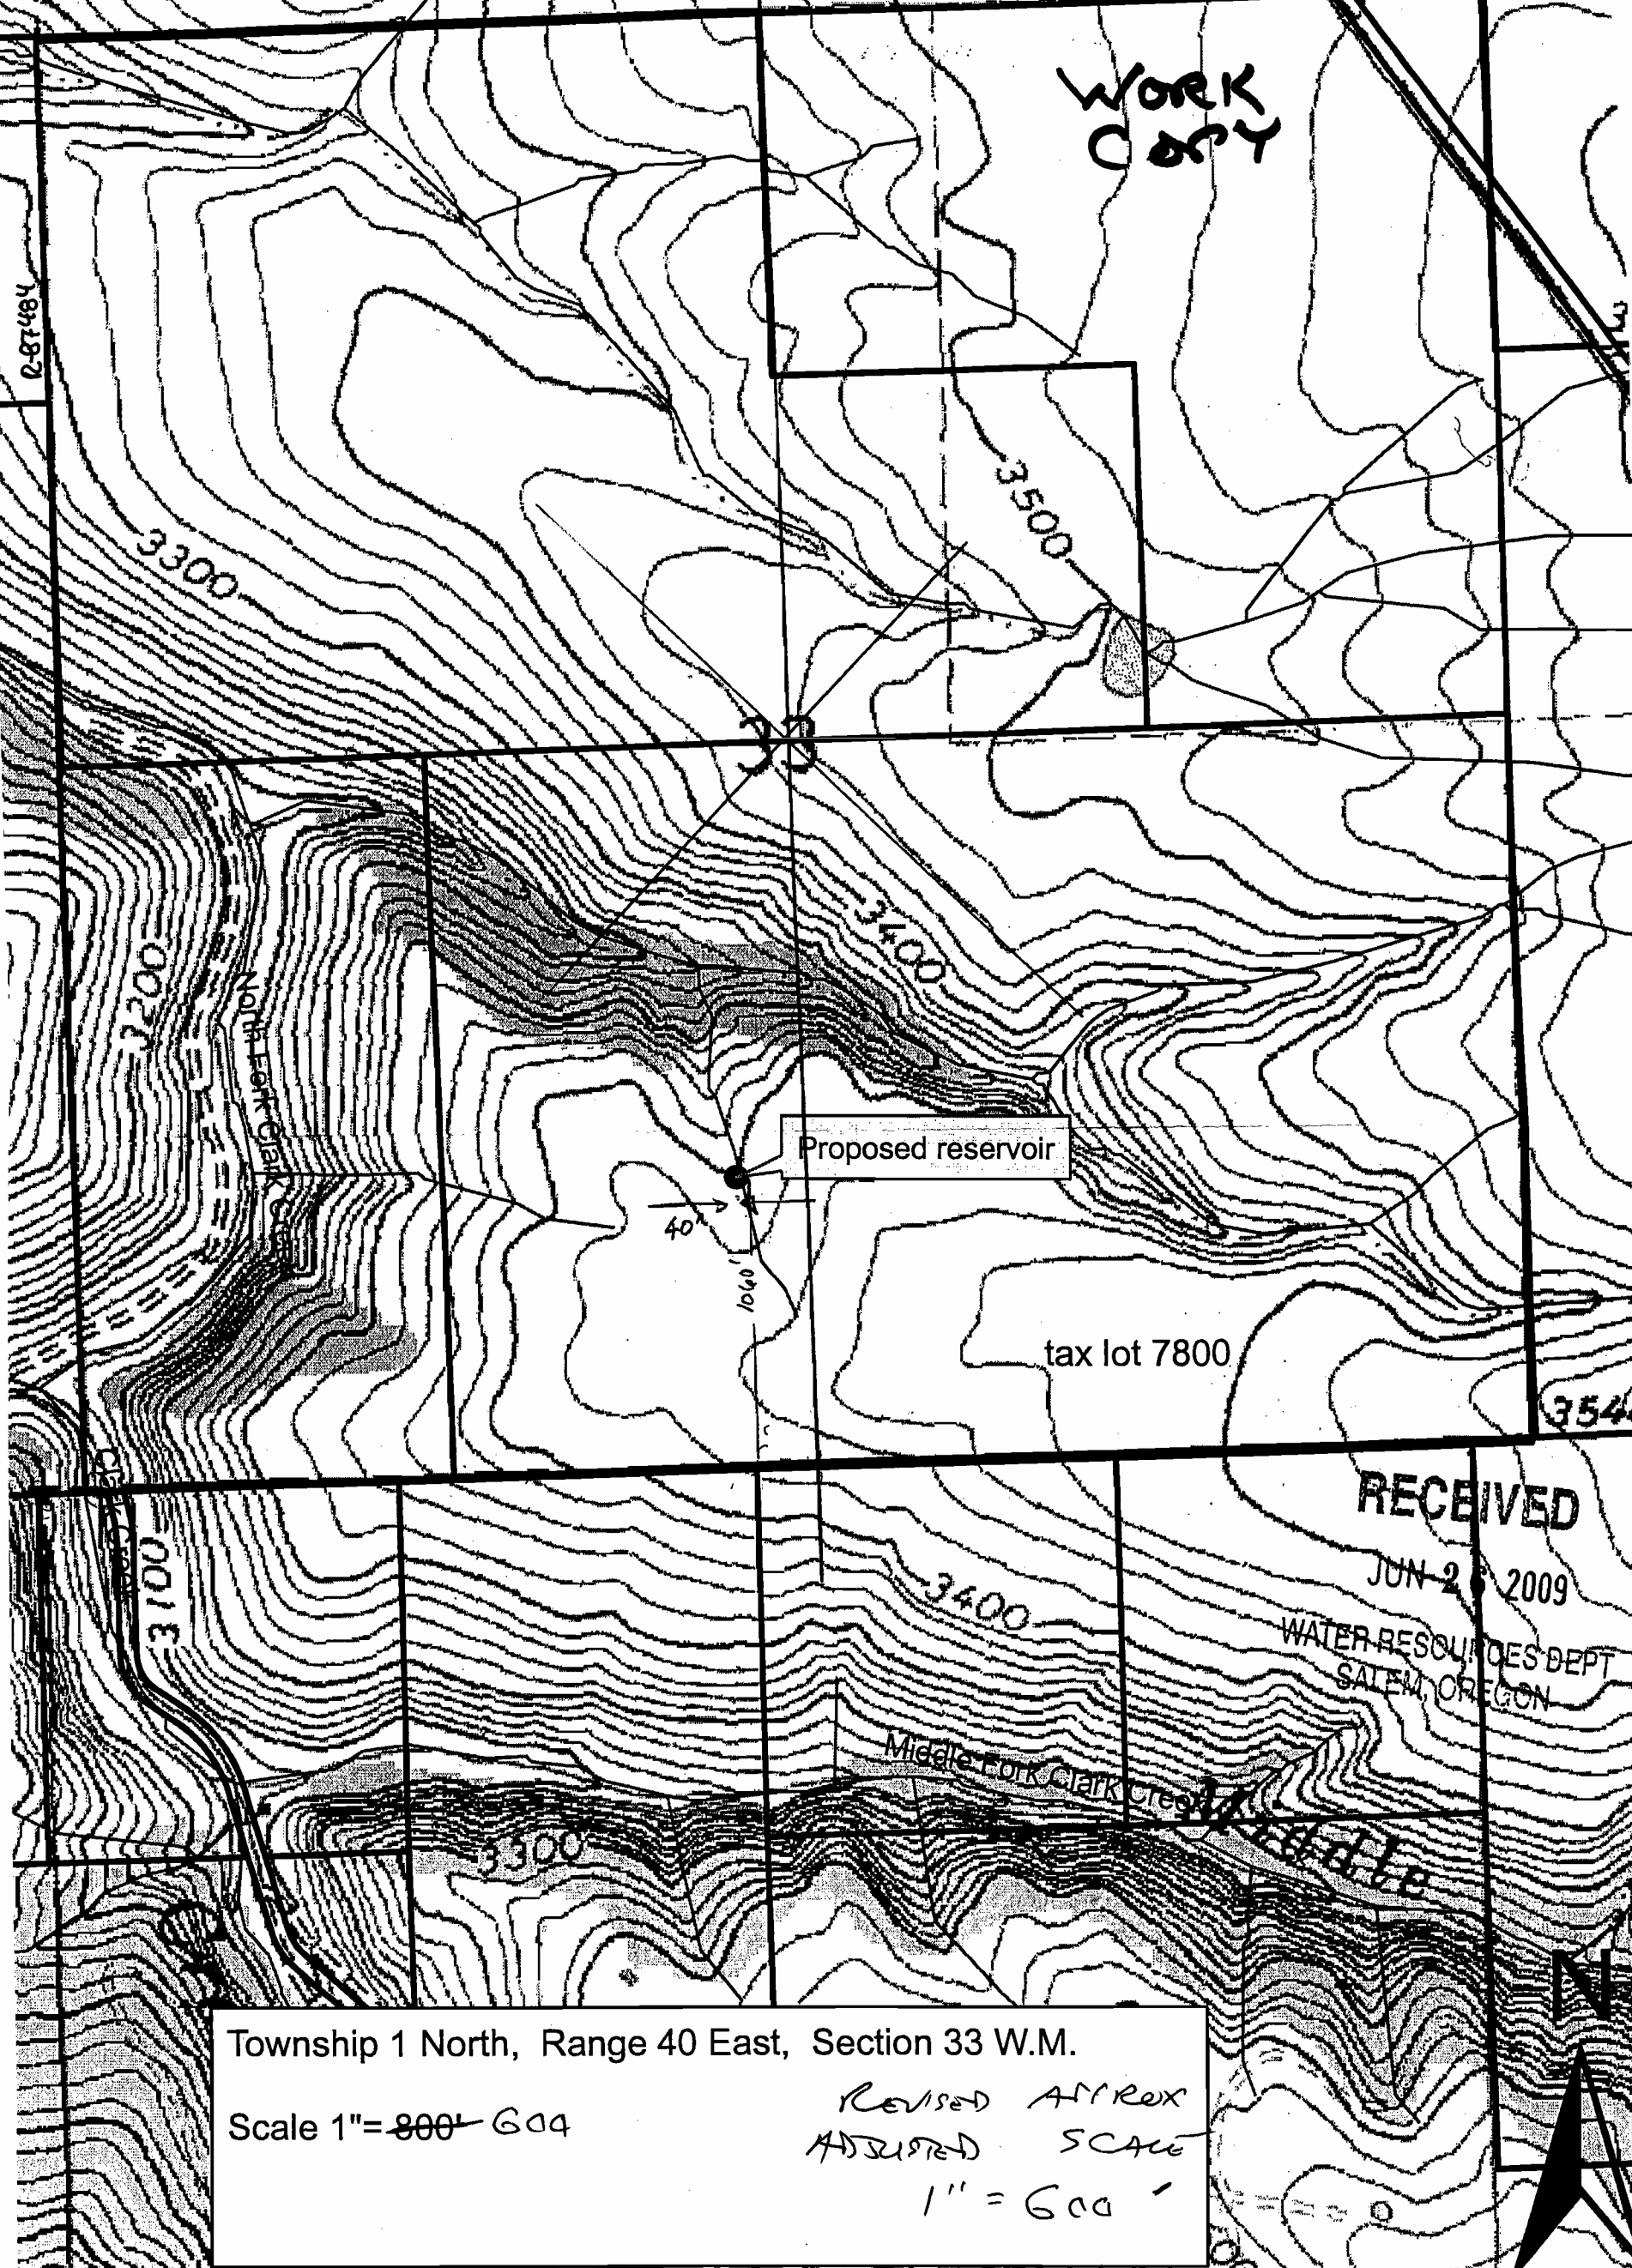

Township 1 North, Range 40 East, Section 33 W.M.
Scale 1" = ~~800'~~ 604
Revised APPROX
ASSURED SCALE
1" = 600'

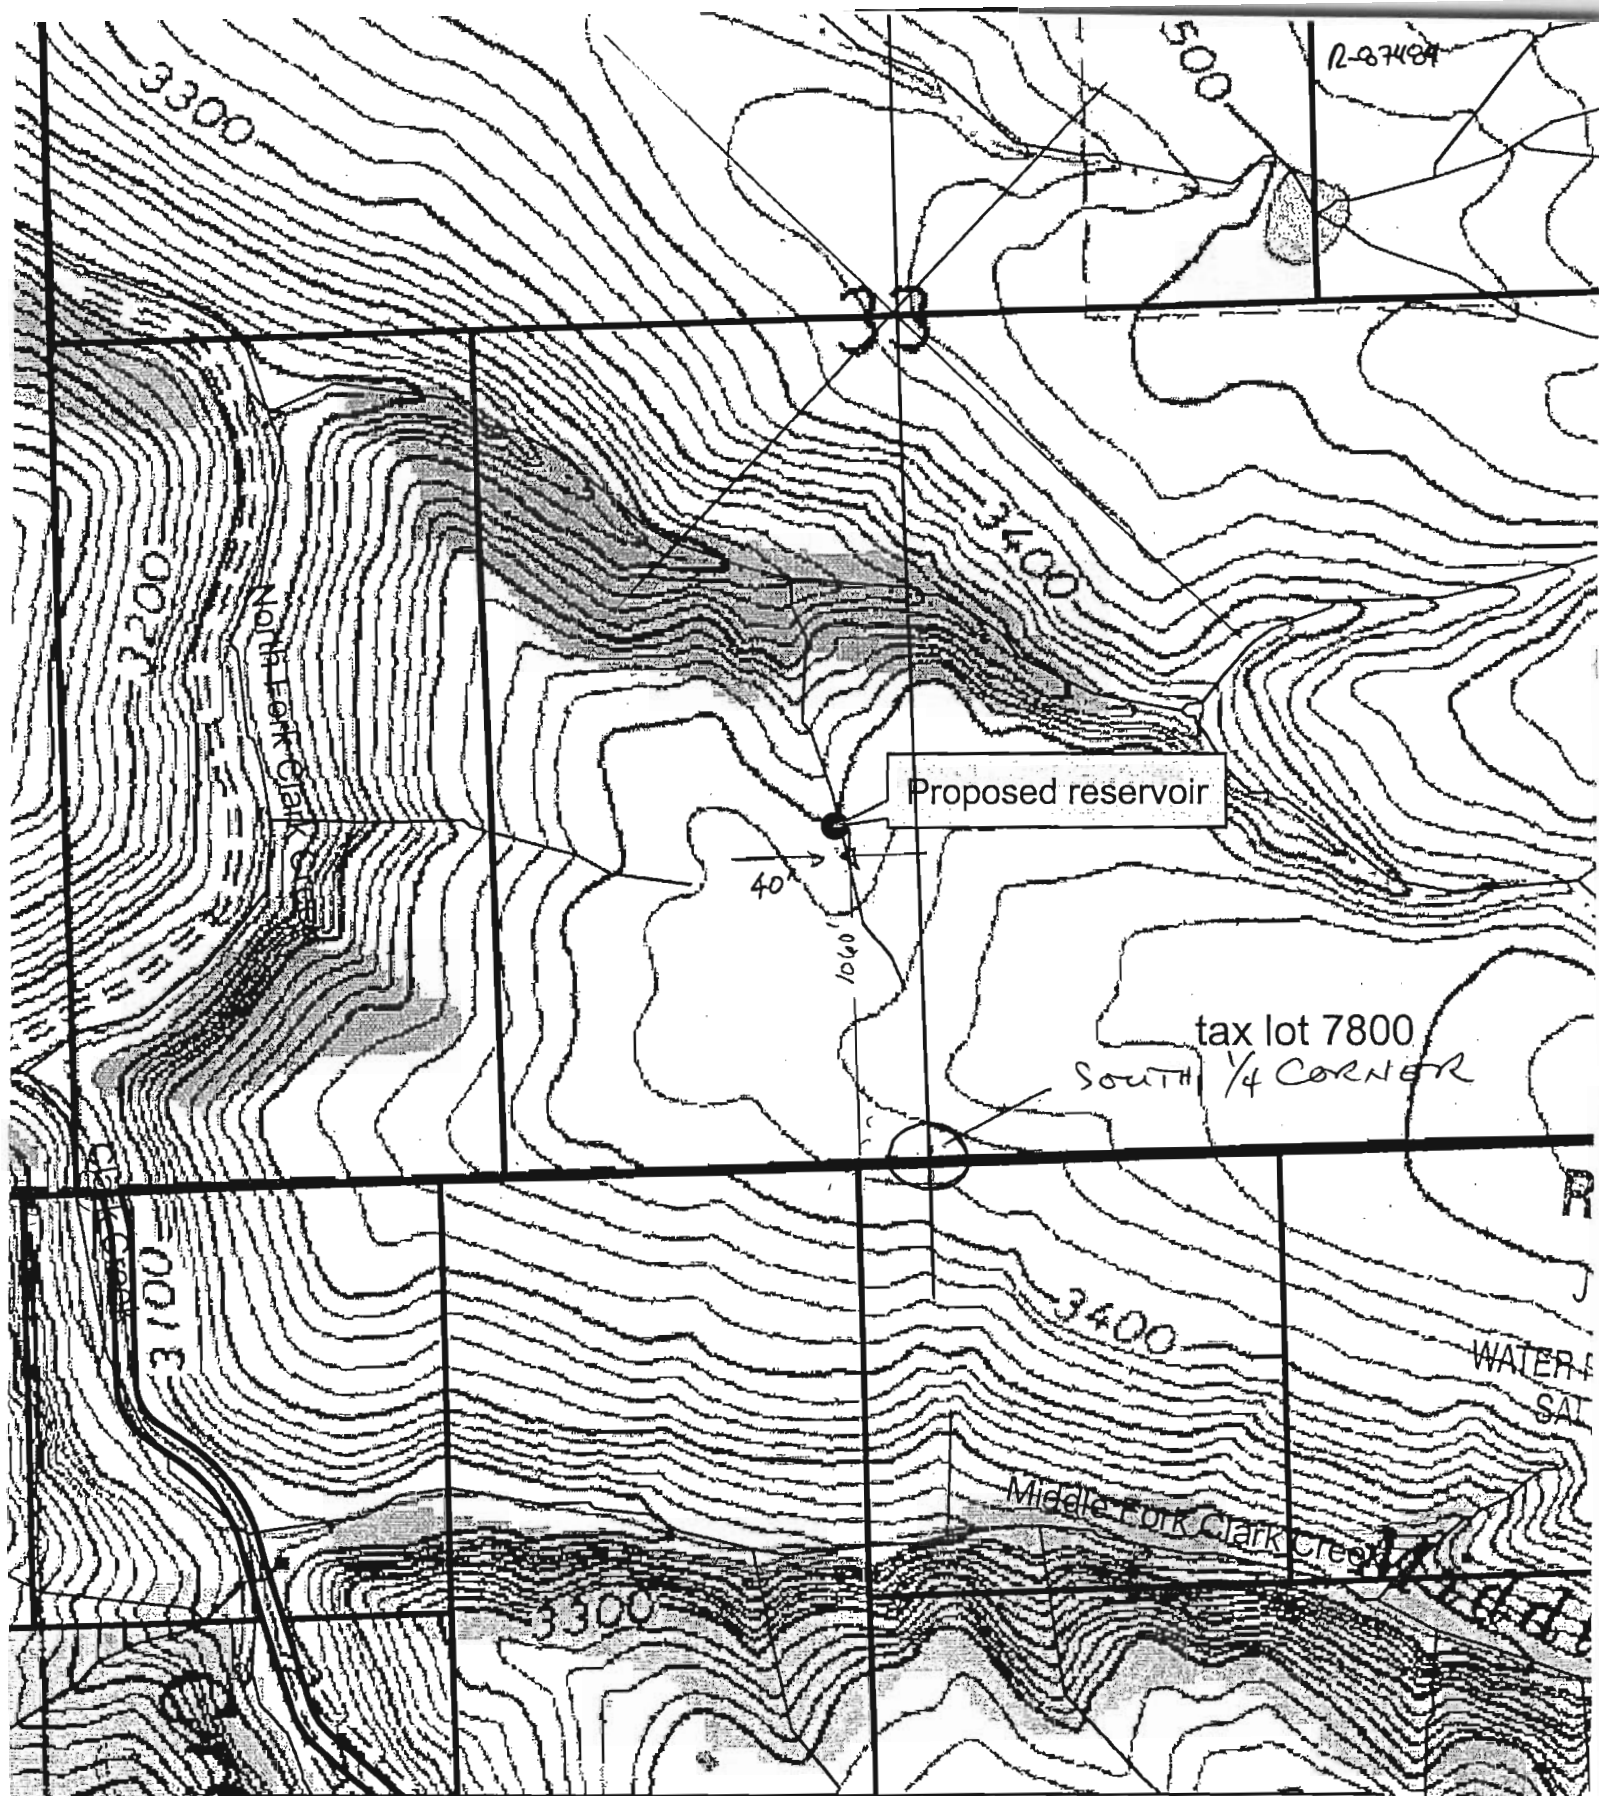

Township 1 North, Range 40 East, Section 33 W.M.

Scale 1" = ~~800'~~ 600'

RESERVOIR LOCATED FROM
SECTION 33 SOUTH 1/4 CORNER

1060 FT NORTH & 240 FT WEST.

REVISED APPROX
ADJUSTED SCALE
1" = 600'

R-87484

Crum's Foley

33

North Fork Clark Creek

Proposed reservoir

RECEIVED

JUN 26 2009

WATER RESOURCES DEPT
SALEM, OREGON

tax lot 7800

BEARING
162° 15'
DISTANCE
1.18

Clark Creek

Middle Fork Clark Creek


Township 1 North, Range 40 East, Section 33 W.M.
Proposed reservoir GPS (deg, dec min)
N 45 deg 31.060 min, W 117 deg 49.162 min

Scale 1"= 800'

N




R-87484

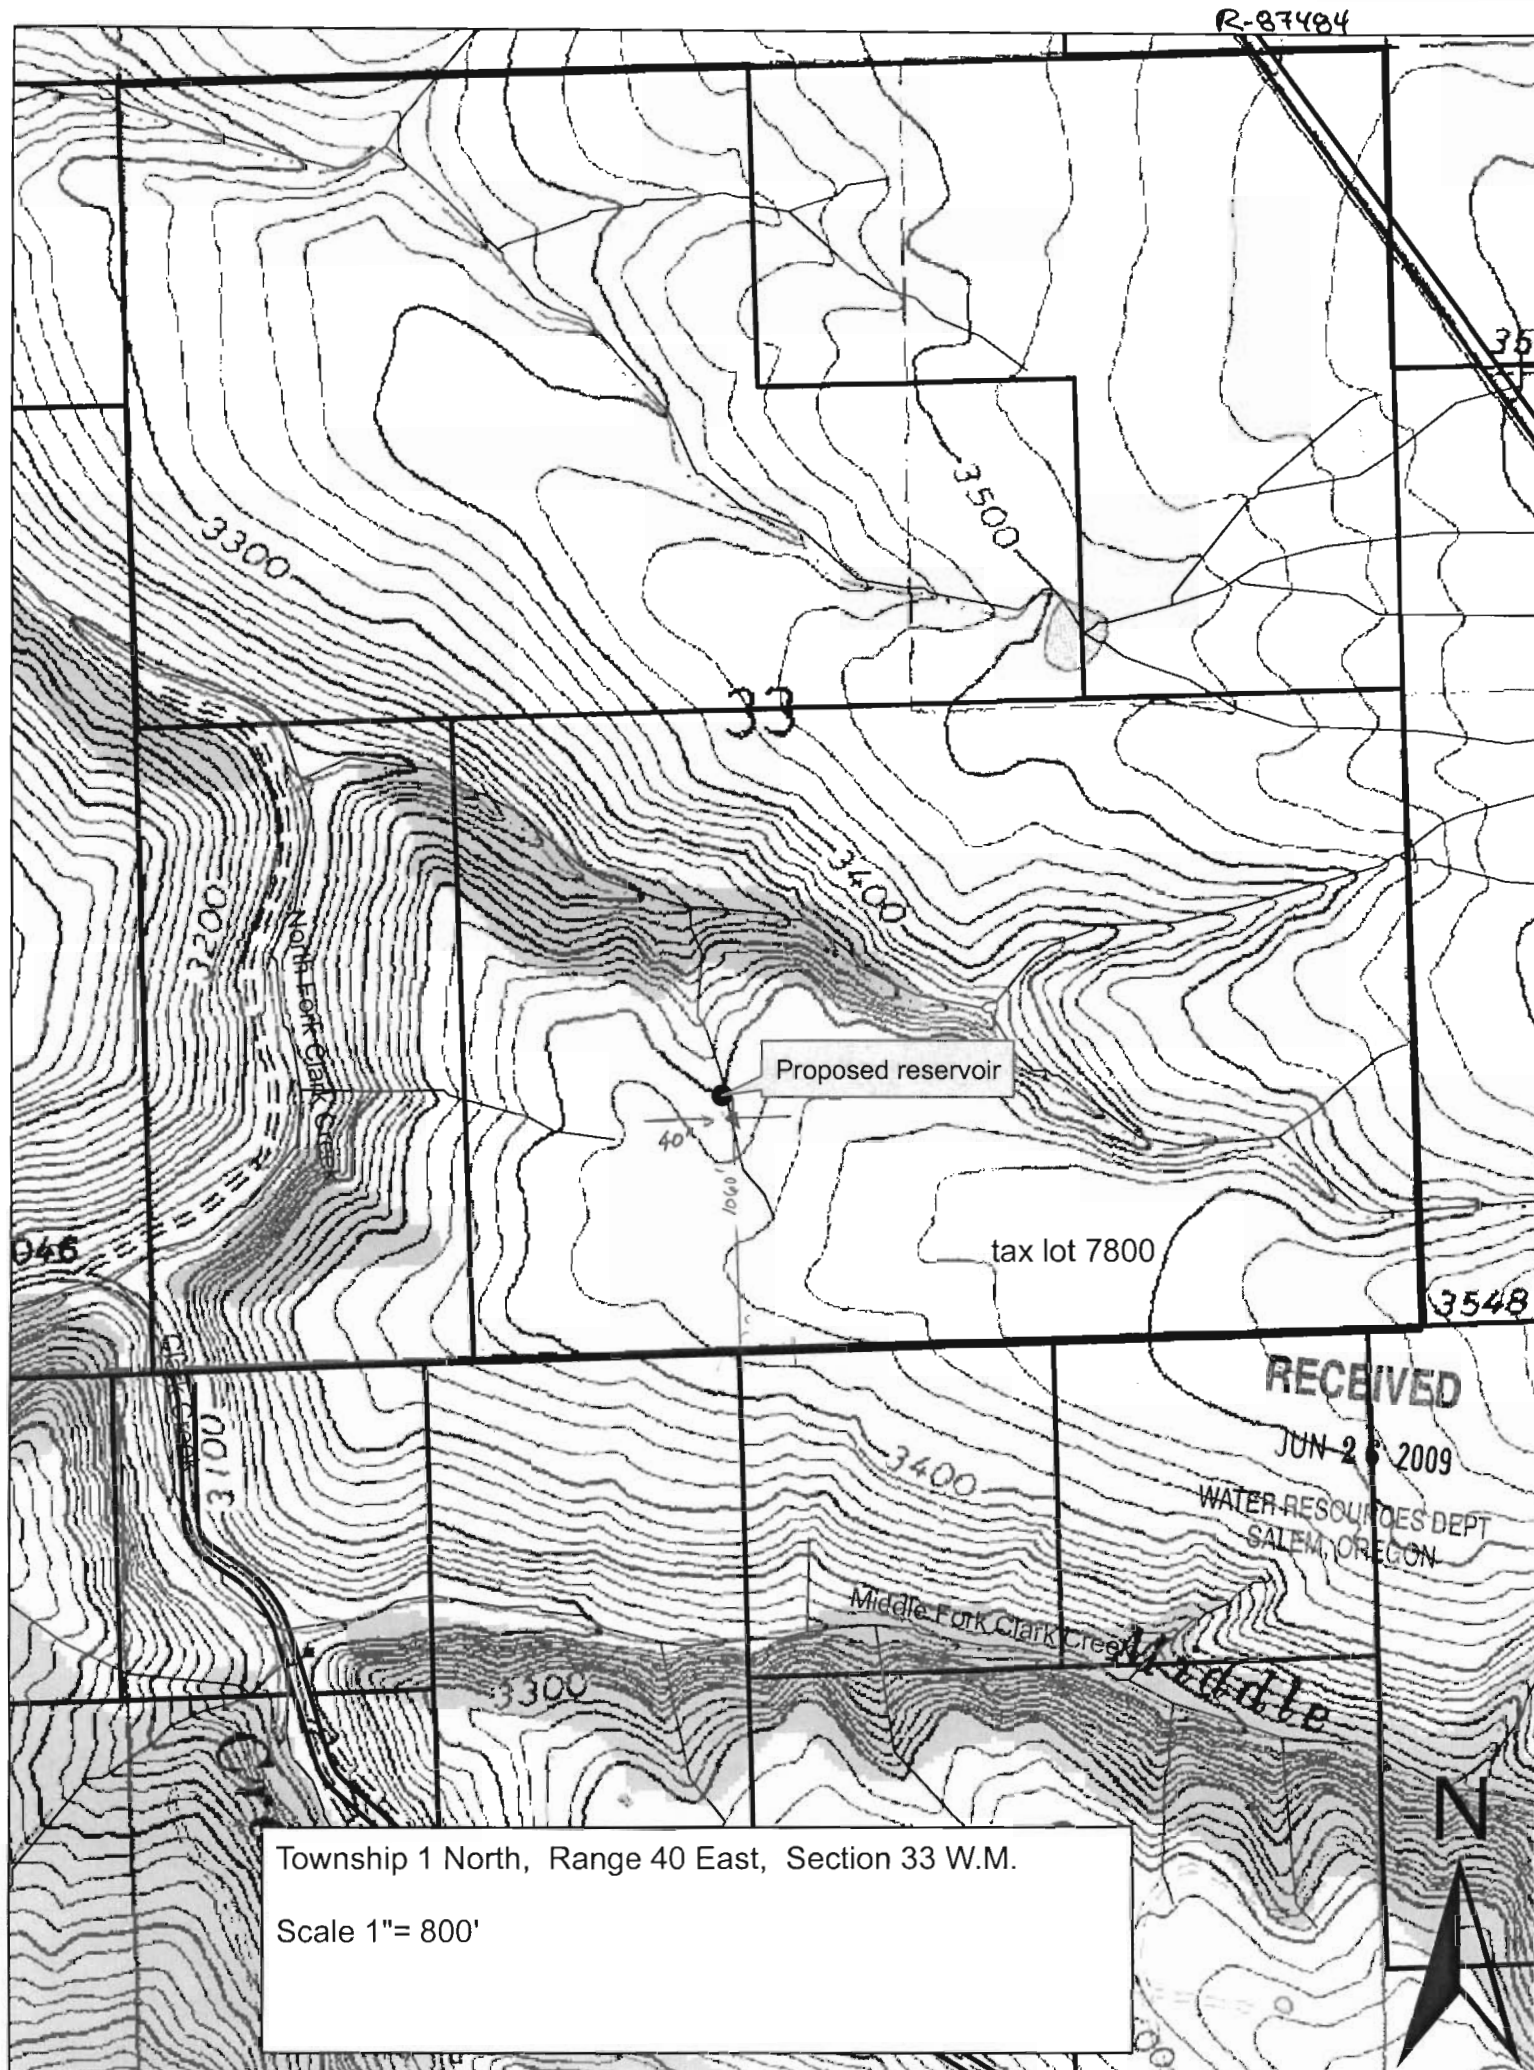

Township 1 North, Range 40 East, Section 33 W.M.

Scale 1"= 800'

WORK
COPY

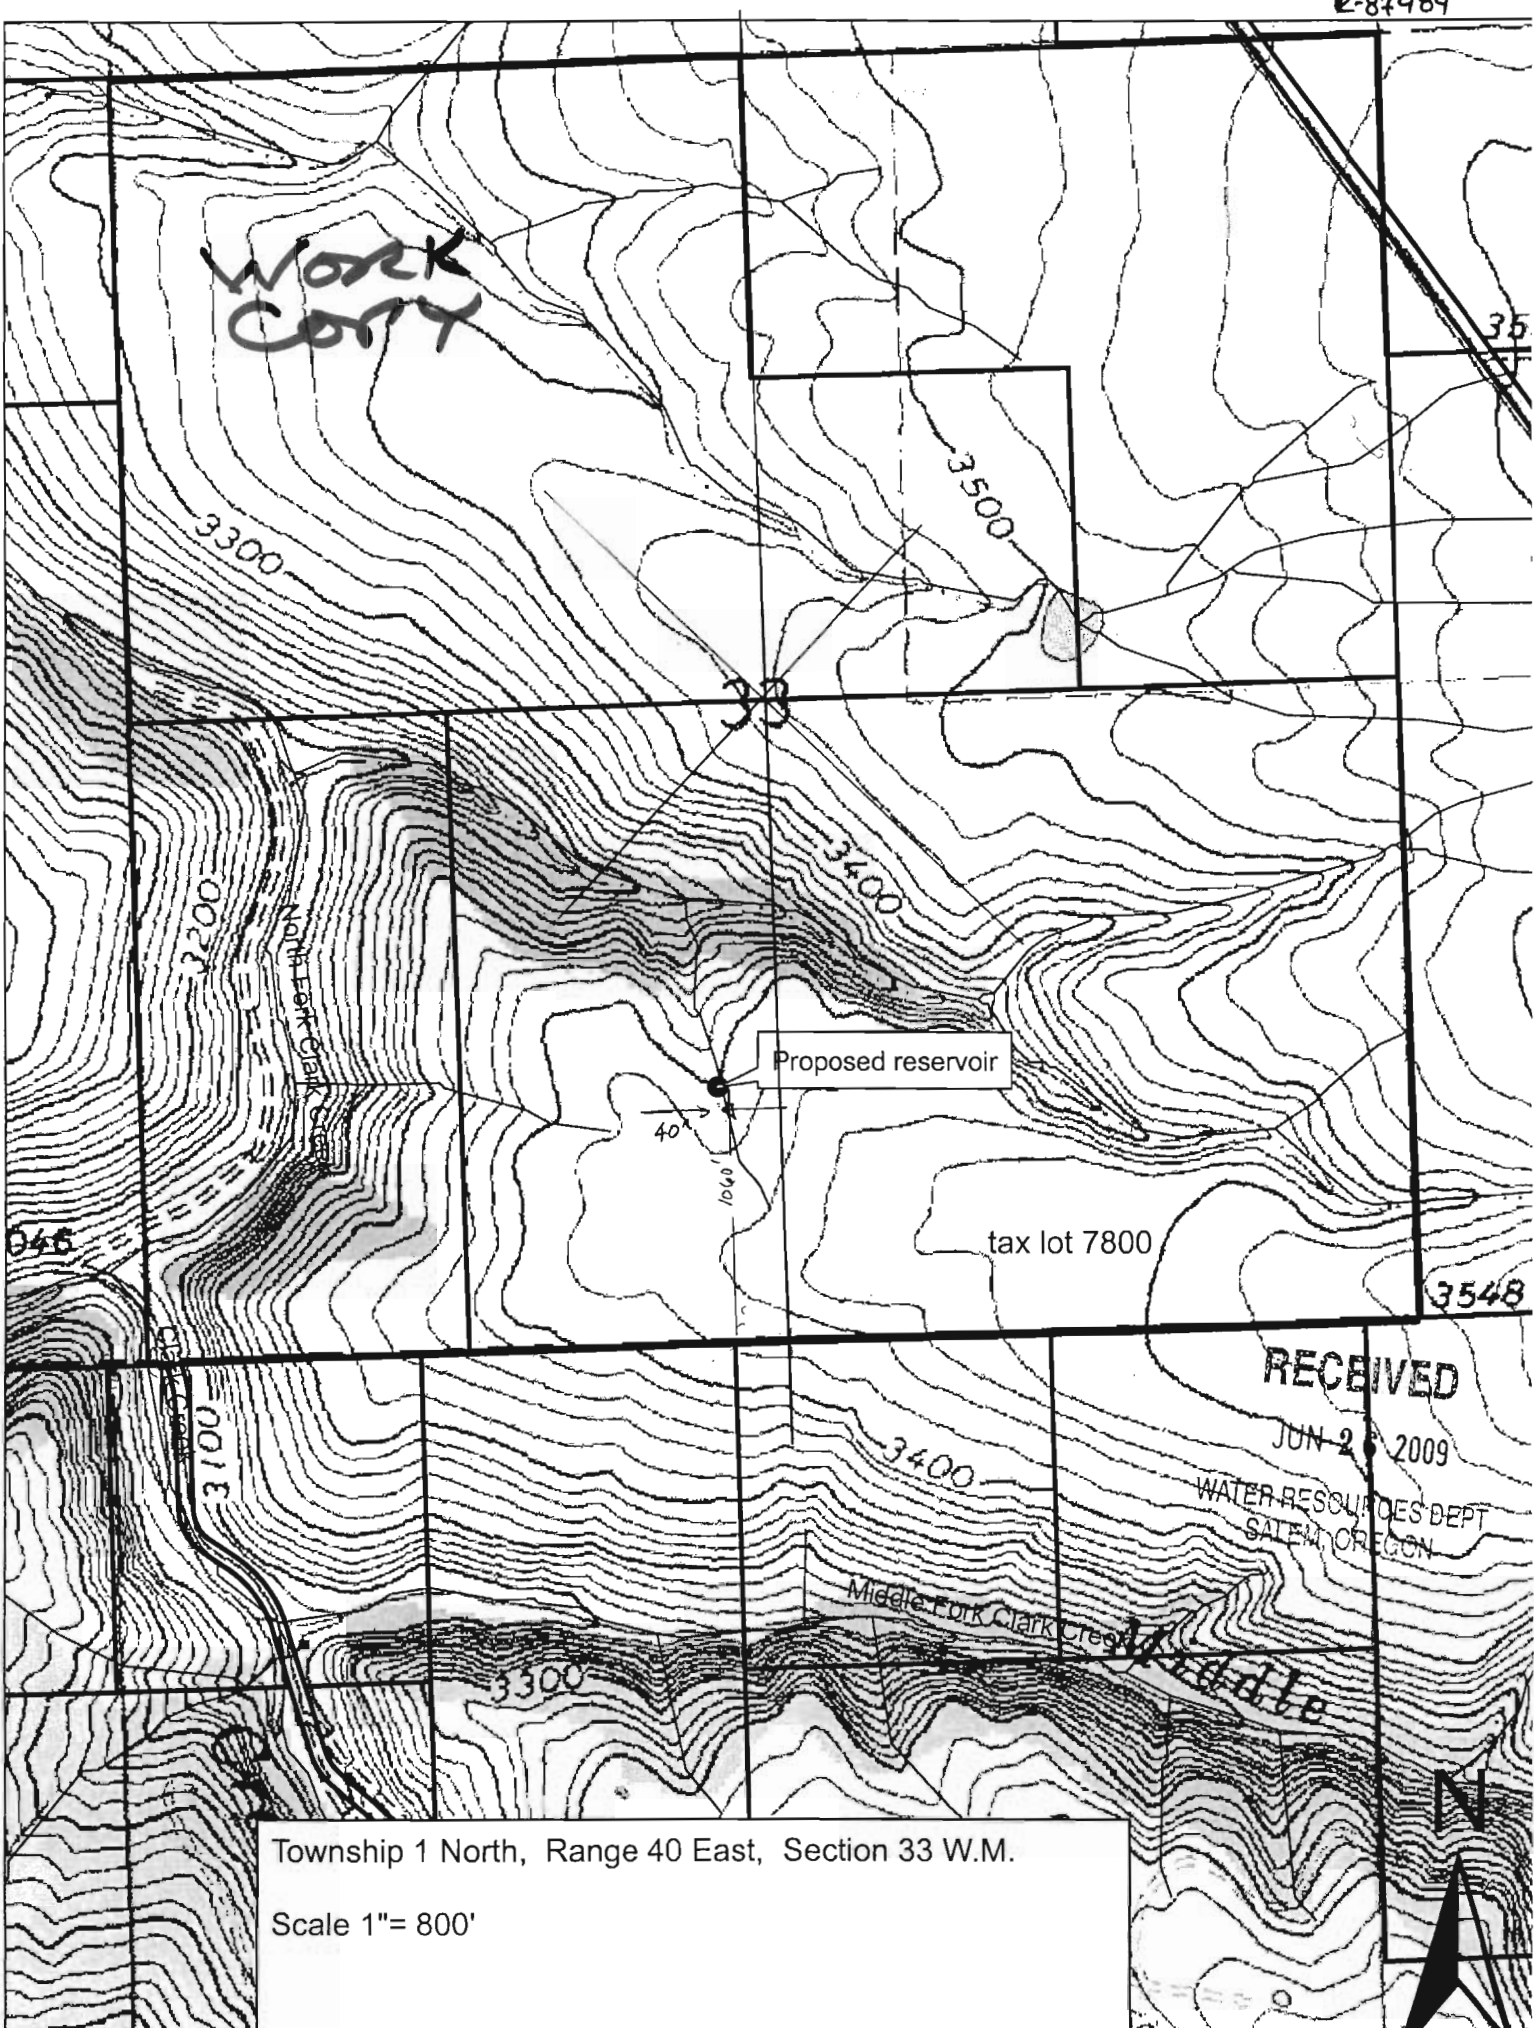

33

35

3300

3500

3200

3400

Proposed reservoir

40'

1060'

tax lot 7800

3548

RECEIVED

JUN 26 2009

WATER RESOURCES DEPT
SALEM, OREGON

3400

3100

Middle Fork Clark Creek

3300

Township 1 North, Range 40 East, Section 33 W.M.

Scale 1"= 800'

N