

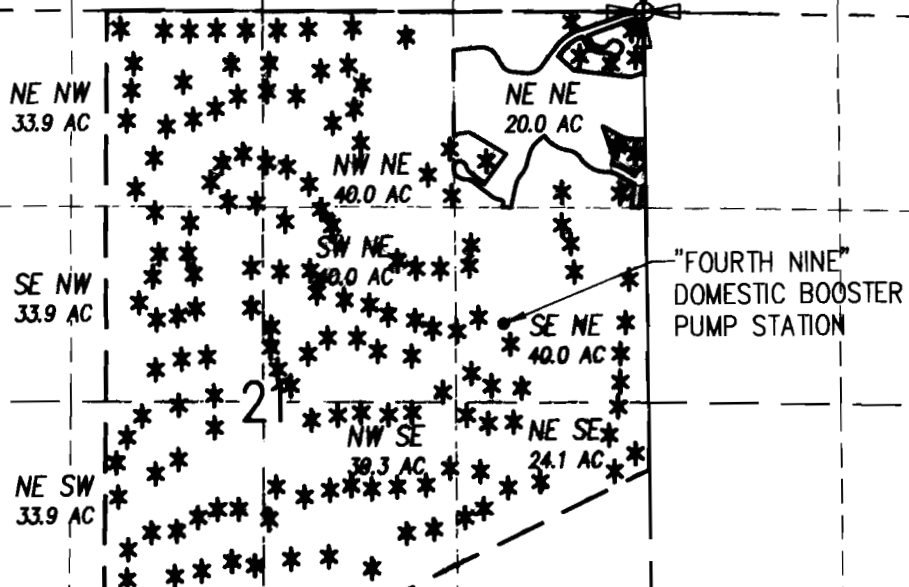
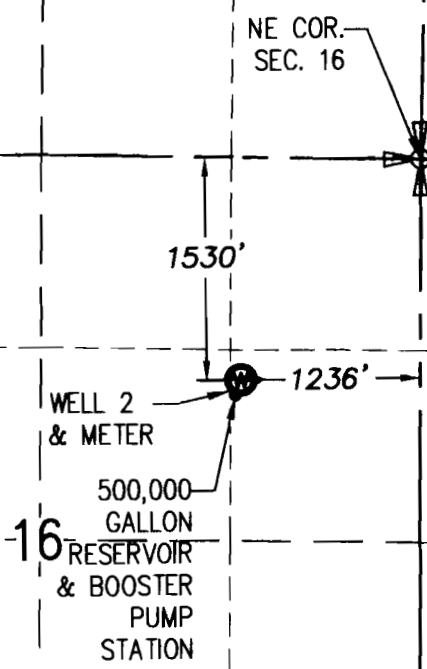
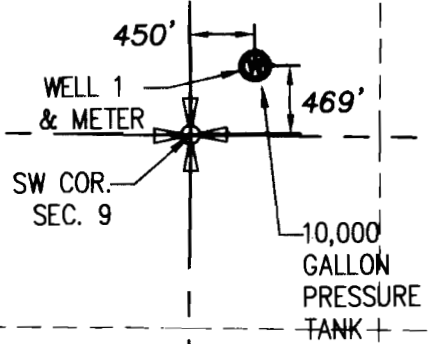


5

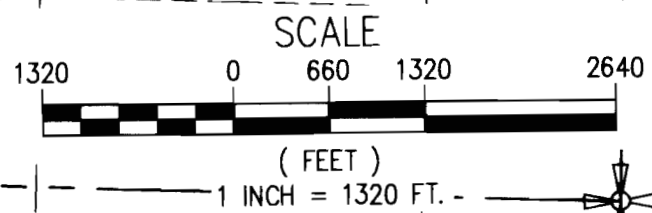

DEC 29 2009

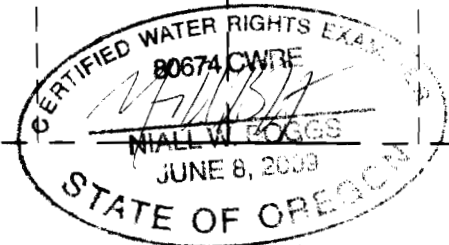

EXPIRES: 12/31/2009
RENEWS:

BLACK BUTTE RANCH ASSOCIATION
APPLICATION #G-9117
PERMIT #G-8501
T. 14S., R. 9E, W.M.

THE PURPOSE OF THIS MAP IS TO IDENTIFY THE LOCATION OF THE WATER RIGHTS. THIS MAP IS NOT INTENDED TO PROVIDE LEGAL DIMENSIONS OR LOCATIONS OF PROPERTY OWNERSHIP LINES.

- NOTES:
1. PERMIT G-8501 IS FOR DOMESTIC USE
 2. FOR TAXLOT INFORMATION, SEE SUPPLEMENTAL TAX MAPS
 3. FOR WATER LINE LAYOUT SEE SUPPLEMENTAL AS-BUILT MAP

SHEET NUMBER 1	CLAIM OF BENEFICIAL USE MAP APPLICATION G-9117, PERMIT G-8501 BLACK BUTTE RANCH PERMIT 8501 COBU		SHEET INFO		REVISIONS		 123 SW Columbia Street Bend, OR 97702 541-388-4255 Fax 541-388-4229 www.whpacific.com
	PROJECT NUMBER 35602	DRAWING FILE NAME 35602-LAND-COBU MAP FOR PERMIT G-8501	SCALE 1" = 1320'	DESIGNED BY: DRAWN NWB CHECKED JEF APPROVED JEF LAST EDIT 7/22/2009 PLOT DATE 10/27/2009 SUBMITTAL	NO.	BY	