

ASHT-1-19

1"=200'

ALL DISTANCES MEASURED FROM NW CORNER SECTION 23

WELL #1	870	ft EAST	&	155	ft SOUTH
WELL #2	765	ft EAST		120	ft SOUTH

USED WITHIN TAX LOT 300
GEOHERMAL

THIS MAP WAS PREPARED FOR ASSESSMENT PURPOSE ONLY

NW1/4 NW1/4 SEC. 23 T.1N. R.2E. W.M.
MULTNOMAH COUNTY

IN 2E 23BB
PORTLAND

1" = 100'

SEE MAP IN 2E 14C

S/L JOHN POWELL D.L.C. 42

APPROX.
1/16 COR.



RECEIVED
MAR 16 2011

WATER RESOURCES DEPT
SALEM, OREGON

IN 2E 23BB
PORTLAND

PortlandMaps

[New Search](#) | [Mapping](#) | [Advanced](#) | [Google Earth](#) | [Help](#) | [PortlandOnline](#)

12423 NE WHITAKER WAY - ARGAY - PORTLAND


Explorer | [Property](#) | [Maps](#) | [Projects](#) | [Crime](#) | [Census](#) | [Environmental](#) | [Transportation](#)

Explore the area, view different themes

[Property Detail](#)



Long -122.53388 Lat 45.56202

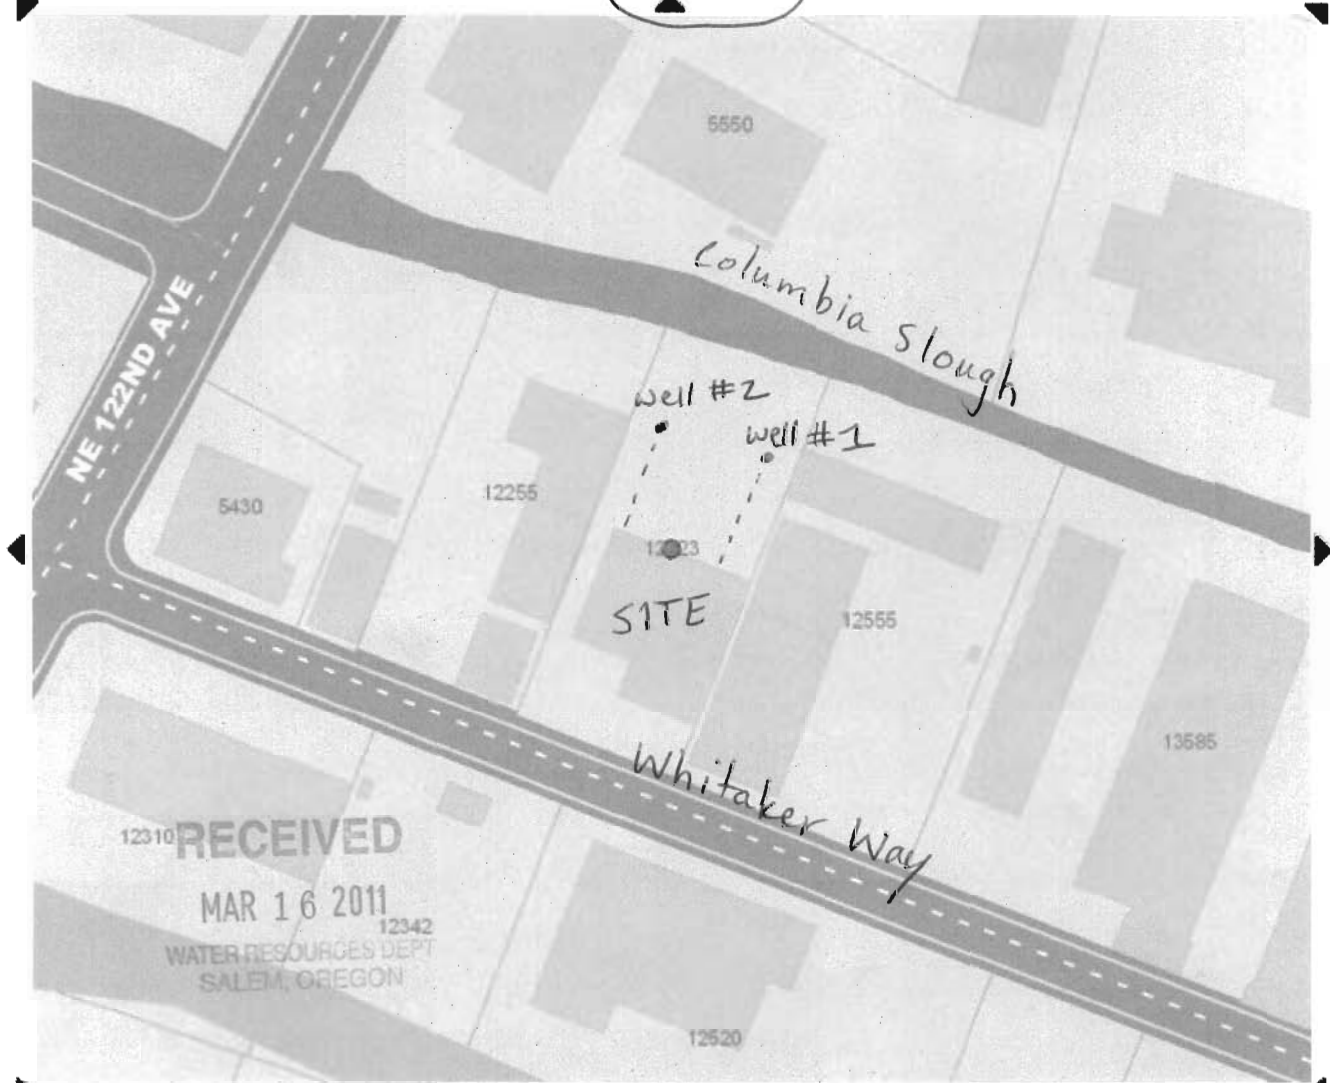

Property

0 |-----| 200 FT

City of Portland, Corporate GIS

2/28/2011

THE GIS APPLICATIONS ACCESSED THROUGH THIS WEB SITE PROVIDE A VISUAL DISPLAY OF DATA FOR YOUR CONVENIENCE. EVERY REASONABLE EFFORT HAS BEEN MADE TO ASSURE THE ACCURACY OF THE MAPS AND ASSOCIATED DATA. THE CITY OF PORTLAND MAKES NO WARRANTY, REPRESENTATION OR GUARANTEE AS TO THE CONTENT, SEQUENCE, ACCURACY, TIMELINESS OR COMPLETENESS OF ANY OF THE DATA PROVIDED HEREIN. THE USER OF THESE APPLICATIONS SHOULD NOT RELY ON THE DATA PROVIDED HEREIN FOR ANY REASON. THE CITY OF PORTLAND EXPLICITLY DISCLAIMS ANY REPRESENTATIONS AND WARRANTIES, INCLUDING, WITHOUT LIMITATION, THE IMPLIED WARRANTIES OF MERCHANTABILITY AND FITNESS FOR A PARTICULAR PURPOSE. THE CITY OF PORTLAND SHALL ASSUME NO LIABILITY FOR ANY ERRORS, OMISSIONS, OR INACCURACIES IN THE INFORMATION PROVIDED REGARDLESS OF HOW CAUSED. THE CITY OF PORTLAND SHALL ASSUME NO LIABILITY FOR ANY DECISIONS MADE OR ACTIONS TAKEN OR NOT TAKEN BY THE USER OF THE APPLICATIONS IN RELIANCE UPON ANY INFORMATION OR DATA FURNISHED HEREUNDER. FOR UPDATED INFORMATION ABOUT THE MAP DATA ON PORTLANDMAPS PLEASE REFER TO [CITY'S METADATA](#). FOR QUESTIONS ABOUT ASSESSMENT INFORMATION PLEASE CONTACT THE COUNTY ASSESSORS OFFICE IN YOUR COUNTY.

[Address](#) | [Mapping](#) | [Advanced](#) | [Google Earth](#) | [Help](#) | [About](#)

PortlandMaps © 2011 [City of Portland, Oregon](#)

Township: 1N
Range: 2E
Section: 23

Tax Lot: 1 TL 300
of acres = .20 acres of SE/SW of 23
Private Owner: Willis Gill; NRI, Inc.

1/4 - 1/4: ~~SW~~ ^{NW} section of ~~SW~~ ^{NW} section of section 23
www.portlandmaps.com/detail.cfm?&no... NW G-17454