


LEGEND

DISCRIPTION	SYMBOLS
SECTION LINE	
QUARTER-QUARTER LINE	
TAX LOT LINE	
SECTION CORNER	
RECOGNIZED SURVEY CORNER	
POINT OF APPROPRIATION	
PLACE OF USE FOR NEW WATER RIGHT PER APPLICATION	
SUPPLEMENTAL AREA FOR WATER RIGHT CERT. 31088 & WATER RIGHT CERT. 48051	


RECEIVED
MAY 11 2011
WATER RESOURCES DEPT
SALEM, OREGON

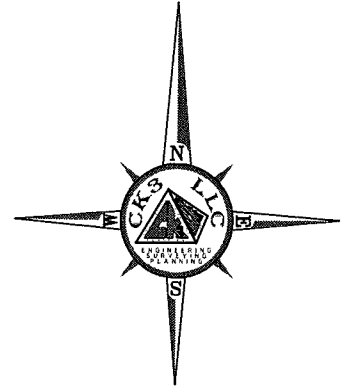

1/16 MILE (330') 1/16 MILE (330') 1/8 MILE (660')
SCALE 1" = 1/8 MILE
ALL DISTANCES SHOWN HERE ARE IN FEET UNLESS NOTED OTHERWISE

App G-17417

DISCLAIMER
I, STEWART R. EDWARDS, HEREBY CERTIFY: THAT THIS MAP WAS MADE TO BE PART OF THE APPLICATION FOR WATER RIGHTS. SECTIONAL LINES SHOWN ARE APPROXIMATE AND THIS MAP IS NOT INTENDED FOR ANY OTHER USE AND DOES NOT GUARANTEE LAND OWNERSHIP.

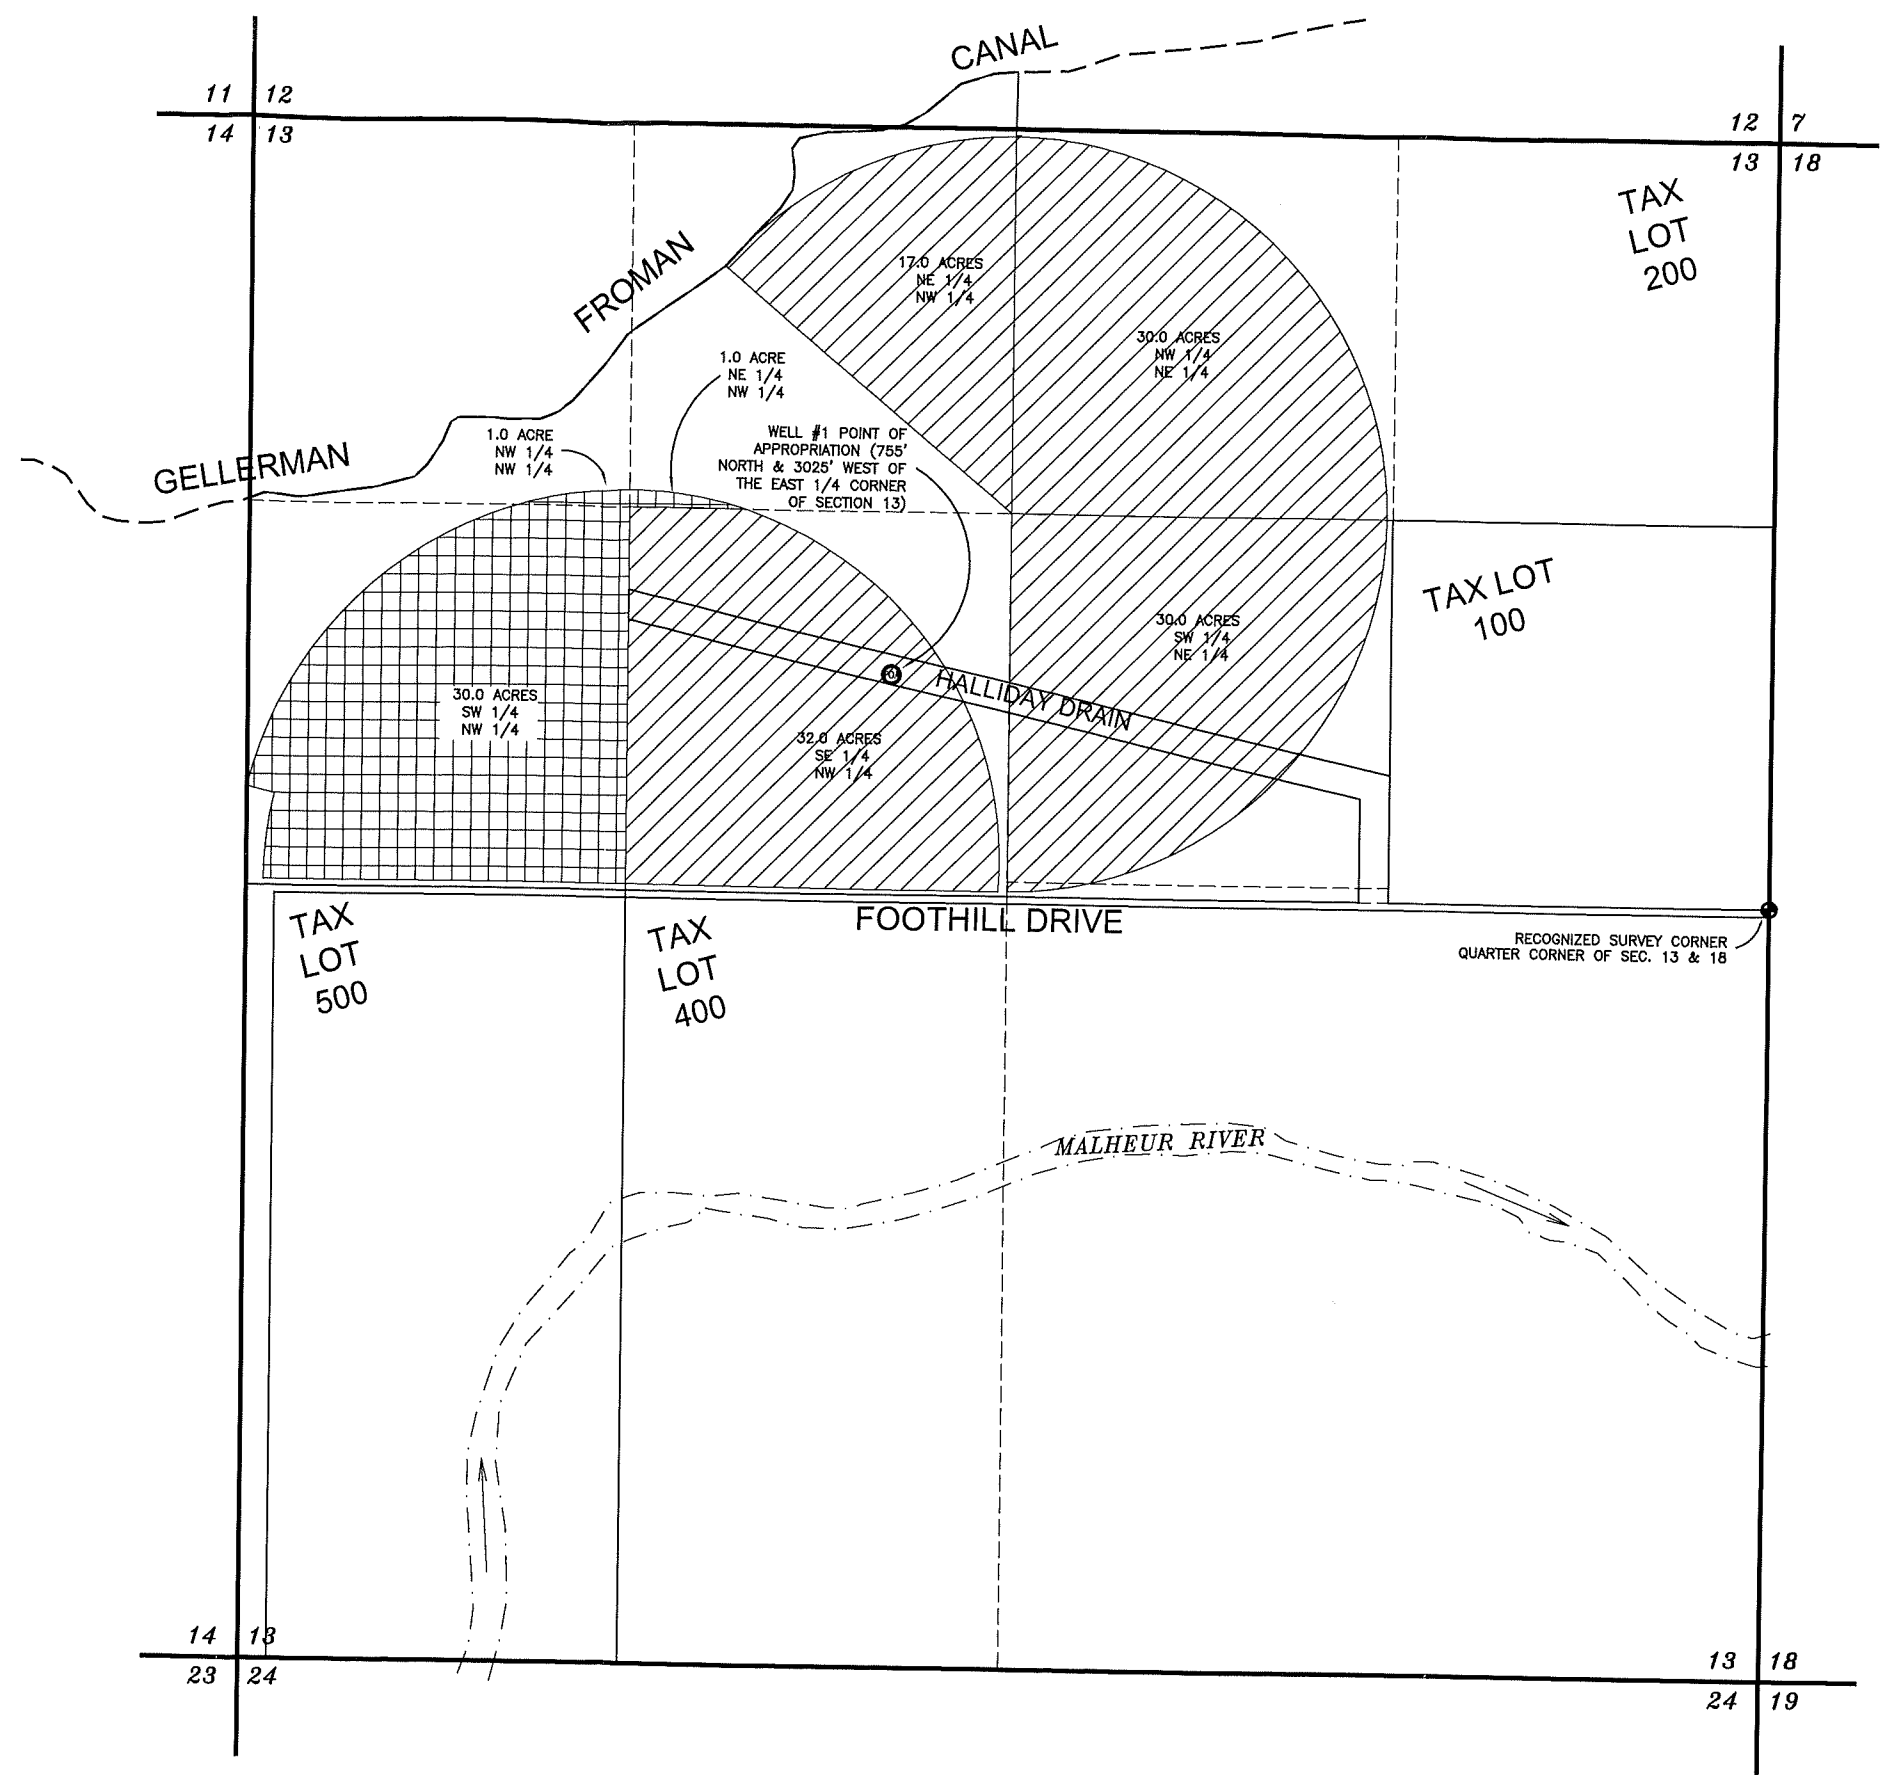

ENG. BY: _____
APR. BY: STU EDWARDS
DWG. BY: PW
DATE: 08/17/10

#	REVISION	DATE
1	AS-BUILT LOCATION	4/15/11
	OF WELL #1	

WATER RIGHT APPLICATION MAP
T 18S, R 45E,
SEC. 13, W.M.
MALHEUR COUNTY, OREGON
SAM TRENKEL
1010 RAILROAD AVENUE
ONTARIO, OREGON 97914

CK3, L.L.C.
368 S.W. 5th Avenue
Ontario, Oregon 97914
Phn: (541) 889-5411
Fax: (541) 889-2074

**CIVIL-STRUCTURAL-ELECTRICAL
ENGINEERING, SURVEYING & PLANNING**

WR-1
SHEET: 1 OF 2
JOB: CO-10010

THIS DRAWING, & ALL INFORMATION HEREIN, REMAIN THE PROPERTY OF CK3, L.L.C. ALL RIGHTS ARE EXPRESSLY RESERVED & IT MAY NOT BE REPRODUCED IN WHOLE OR IN PART WITHOUT THE EXPRESSED WRITTEN CONSENT OF CK3, L.L.C.