


FINAL PROOF SURVEY
TRANSFER T-~~7182~~ T-4217

~~JAMES R. STEWART~~
~~HC 60 BOX 1888~~
~~LAKEVIEW, OREGON 97039~~
~~(541) 847-2722~~

NE1/4 SECTION 32, TOWNSHIP 39 SOUTH, RANGE 19 EAST, W.M.

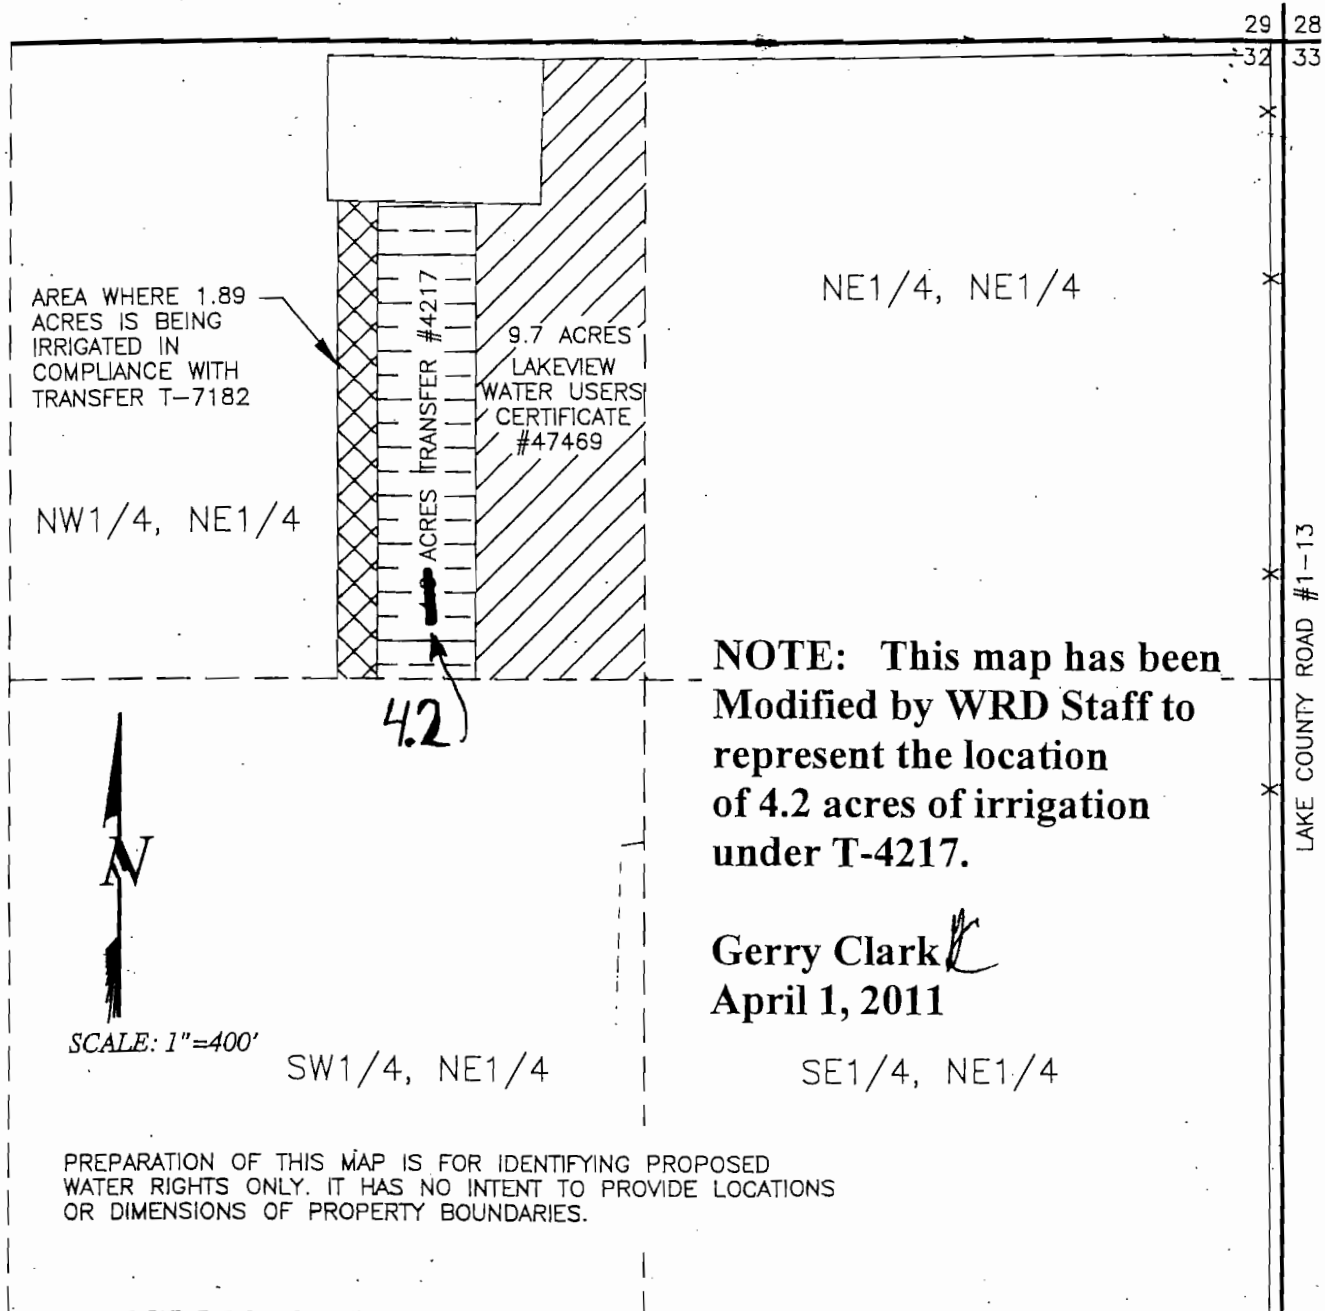

29 28
32 33

NE1/4, NE1/4

AREA WHERE 1.89
ACRES IS BEING
IRRIGATED IN
COMPLIANCE WITH
TRANSFER T-7182

9.7 ACRES
LAKEVIEW
WATER USERS
CERTIFICATE
#47469

ACRES TRANSFER #4217

NW1/4, NE1/4

4.2

NOTE: This map has been Modified by WRD Staff to represent the location of 4.2 acres of irrigation under T-4217.

Gerry Clark
April 1, 2011

LAKE COUNTY ROAD #1-13


SCALE: 1"=400'

SW1/4, NE1/4

SE1/4, NE1/4

PREPARATION OF THIS MAP IS FOR IDENTIFYING PROPOSED WATER RIGHTS ONLY. IT HAS NO INTENT TO PROVIDE LOCATIONS OR DIMENSIONS OF PROPERTY BOUNDARIES.

T. 39 S., R. 19 E., W.M.

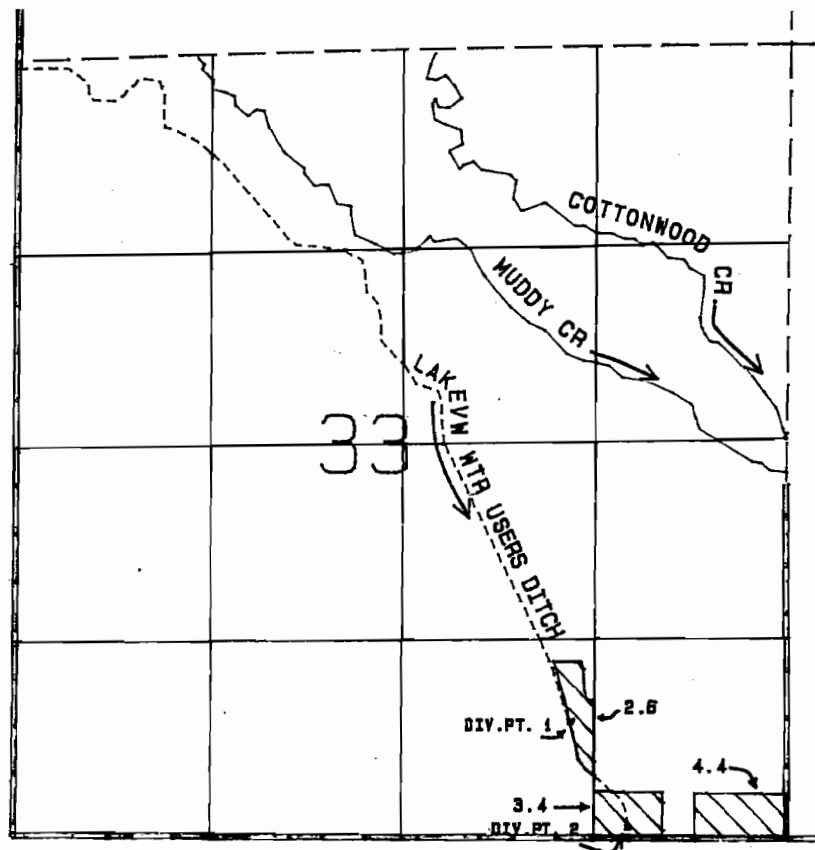

SCALE: 1 = 1320

FINAL PROOF SURVEY

UNDER

TRANSFER 4217

IN NAME OF

Key C. Clark / LAKEVIEW WATER USERS

Surveyed Oct. 19, 1987 By T.M. Warren

Photo: 379-97L RWK-61S