


Elliott Map

1" = 1320'

Tax Lot: 500

Township 15 South, Range 3 West, W.M.

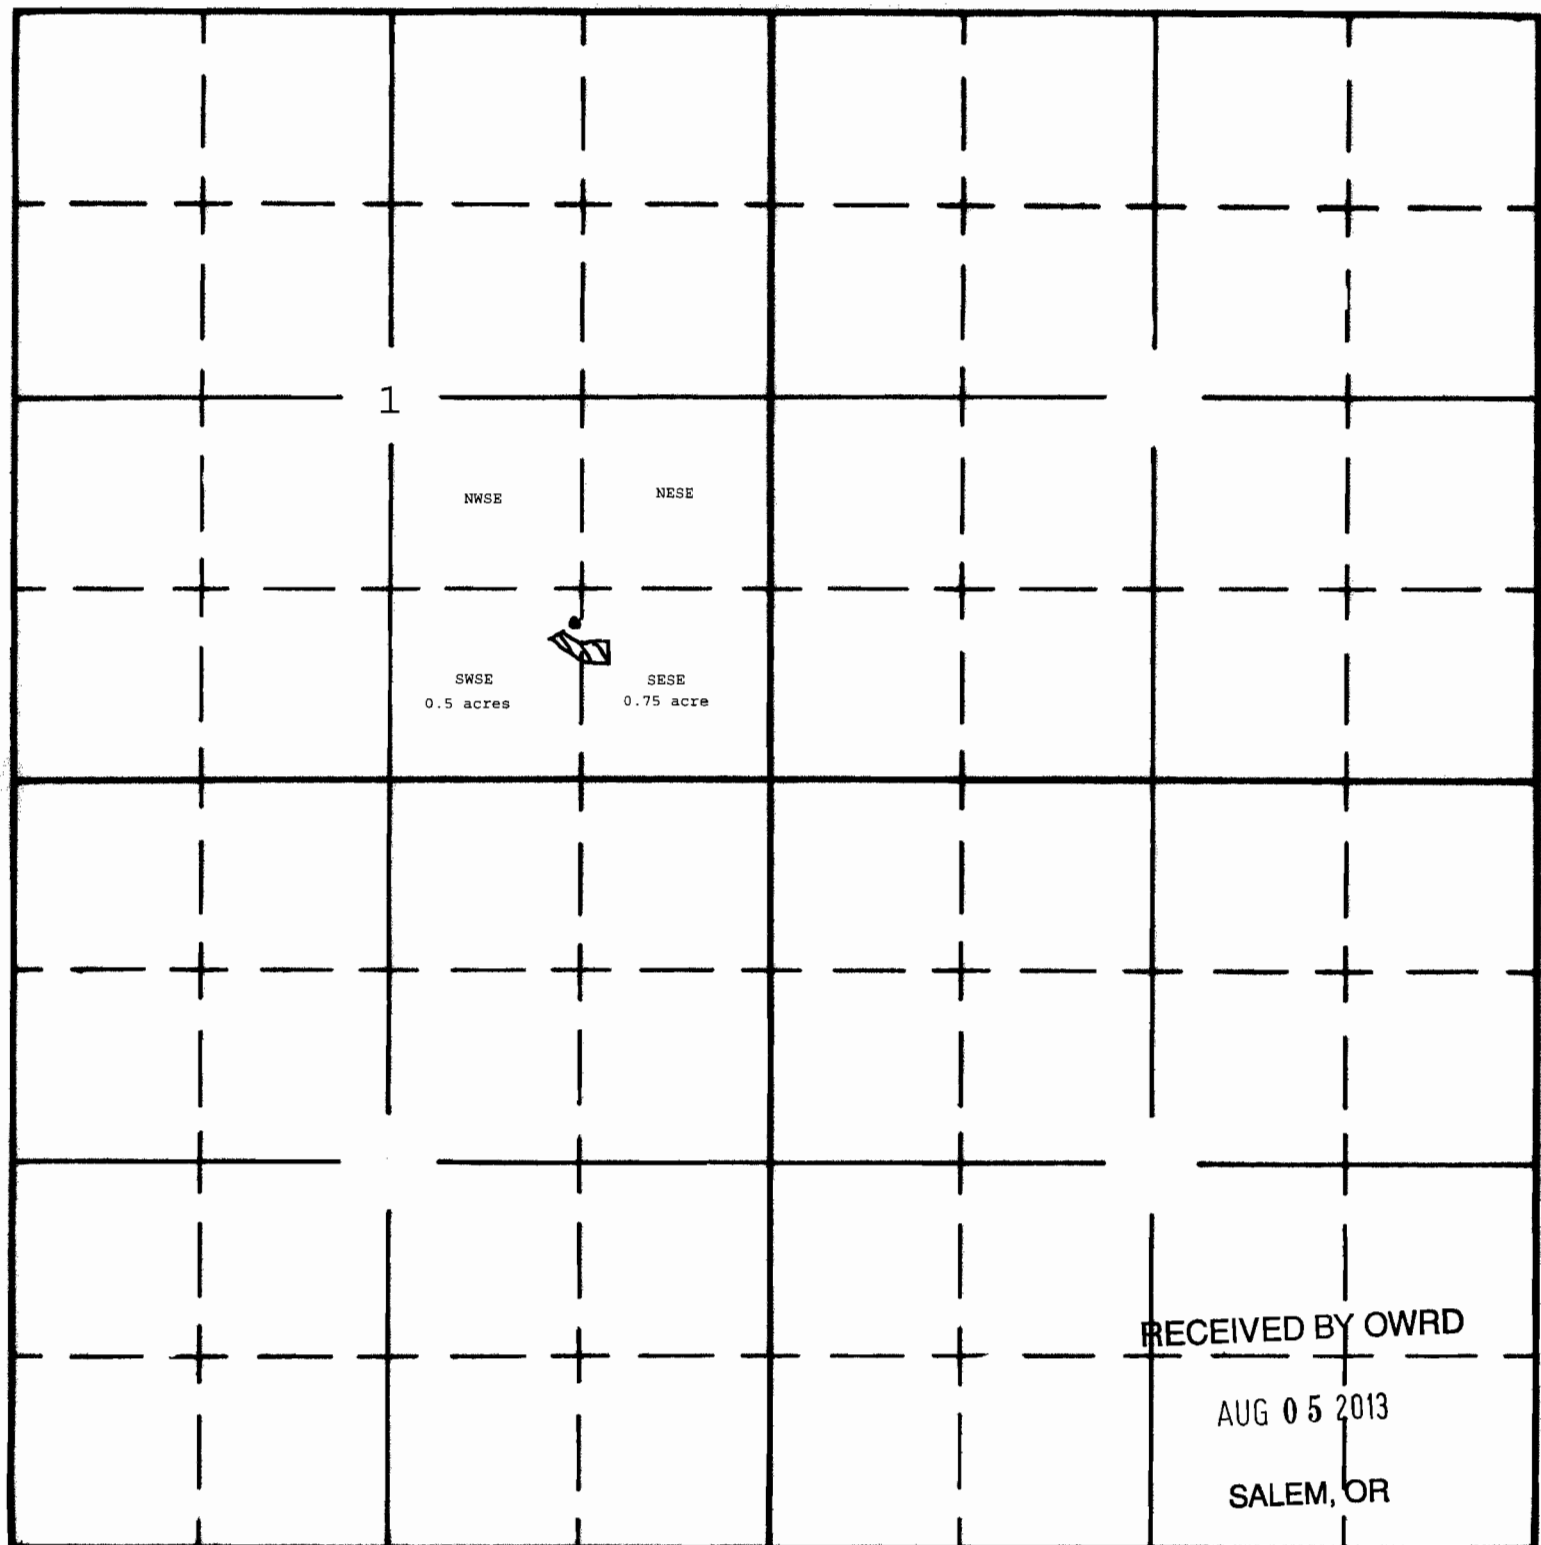

RECEIVED BY OWRD

AUG 05 2013

SALEM, OR


POD Location: 1150 Feet North and 375 Feet West from the SE Corner Section 1

Total Acreage to be irrigated 1.25 acre

Linn County

Sam Elliott 7-24-13

T.15S.R.3W.W.M.

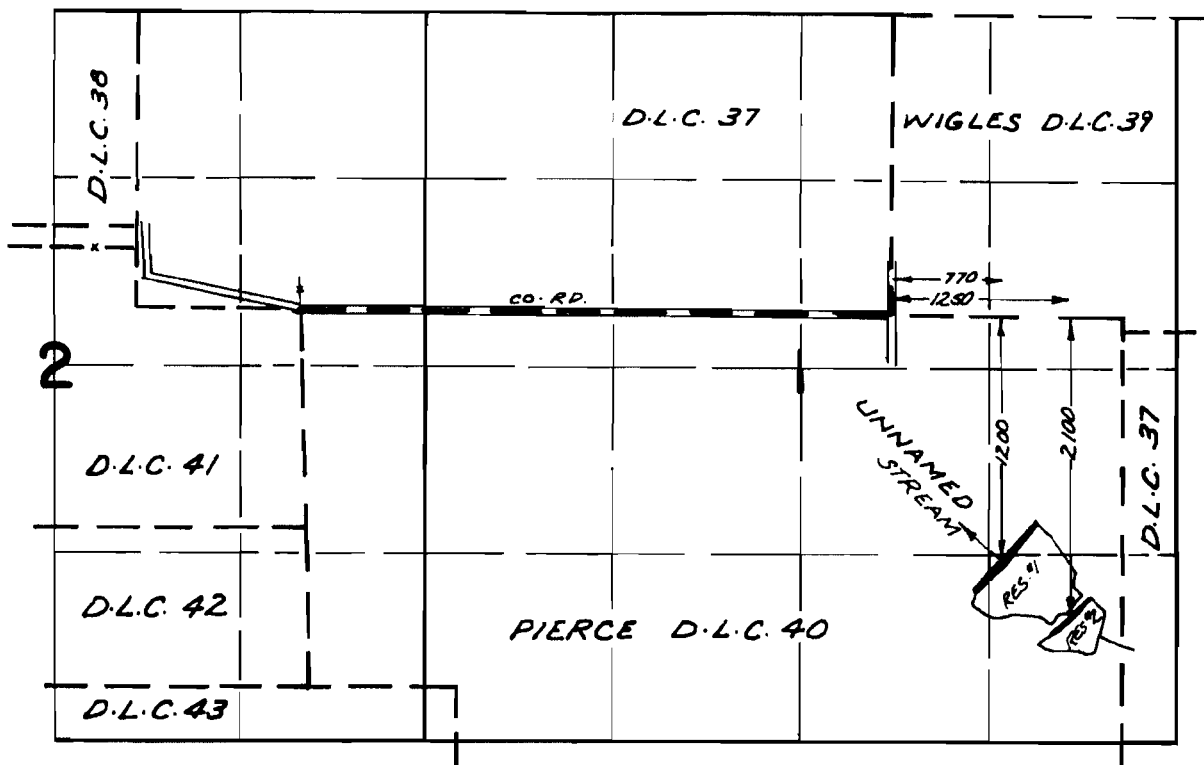

FINAL PROOF SURVEY


UNDER

Application No. R-47544 ~~47545~~ Permit No. R-5585 ~~34888~~
IN NAME OF _____

W. D. E. NORMA M. GANN

Surveyed OCT. 23, 1973, by R. MUCKEN

T.15S.R.3W.W.M.

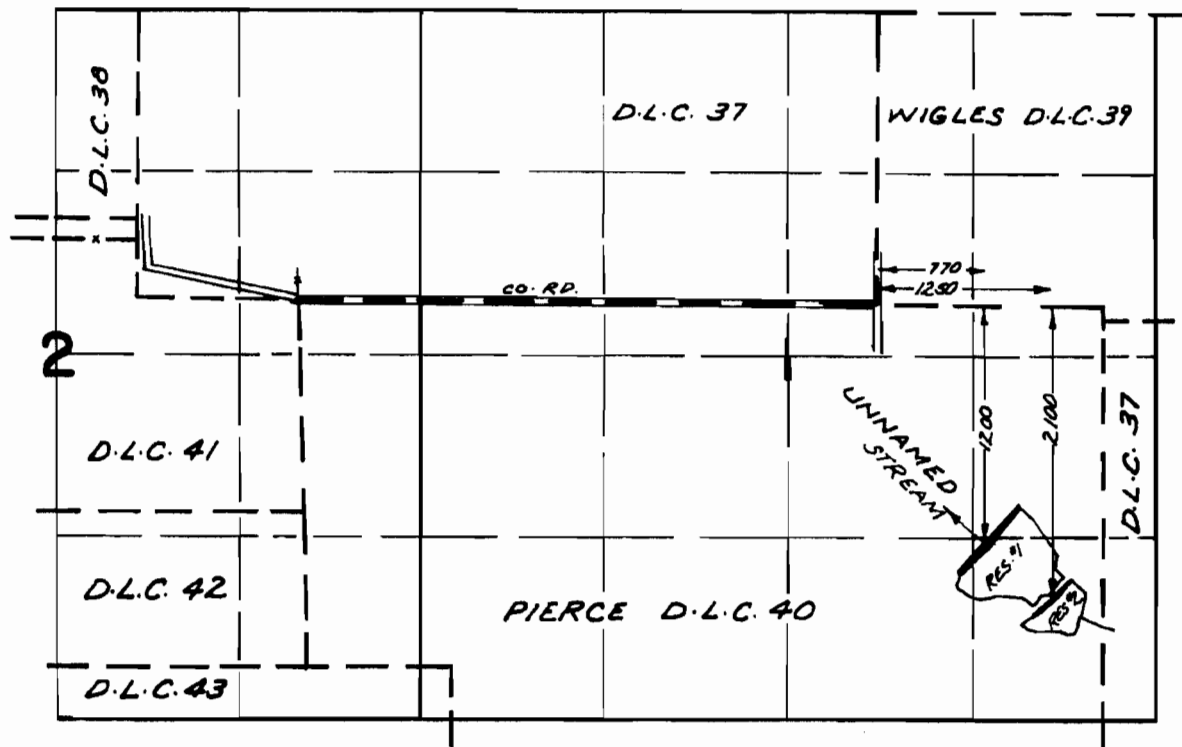

RECEIVED BY OWRD

FINAL PROOF SURVEY
UNDER

AUG 05 2013

SALEM, OR

Application No. *R-47544* *R-5585*
47545 Permit No. *34998*
IN NAME OF

W. D. F. NORMA M. GANN

Surveyed *OCT. 23, 1973.* by *R. MUCKEN*

THIS MAP WAS PREPARED FOR
ASSESSMENT PURPOSES ONLY

SEC. 01 T. 15S. R. 03W. W.M.
LINN COUNTY, OREGON

1" = 400'

15 3W 1


SEE MAP 14 3W 36

SEE MAP 14 3W 35

SEE MAP 15 2W

SEE MAP 15 3W 2

SEE MAP 15 3W 12

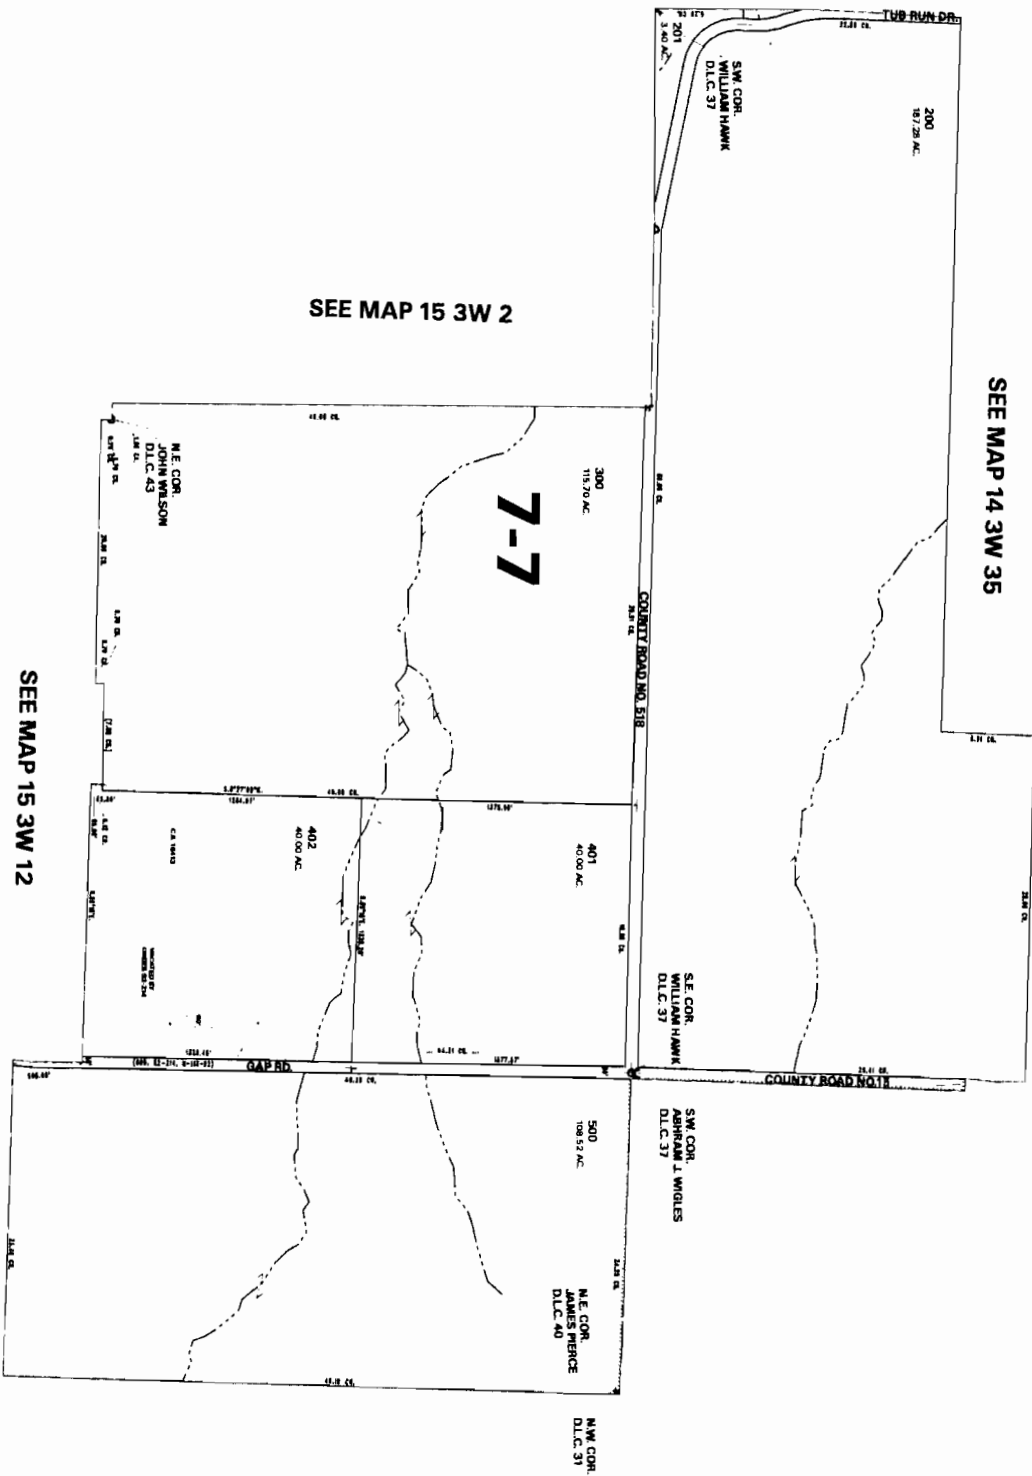

RECEIVED BY OWRD

AUG 05 2013

SALEM, OR

15 3W 1

10/08/00 07:31:04 Sun