



Oregon Water Resources Department Notice of Exempt Reservoir

For reservoirs built before January 1, 1995, that:

- Store less than 9.2 acre-feet of water, or
- Have a dam less than 10 feet high.

The deadline for submitting a Notice of Exempt Reservoir is January 31, 1997.

RECEIVED

FEB - 4 1997

WATER RESOURCES DEPT.
SALEM, OREGON

Landowner: RISHEL, KATHLEEN R.
Last name First name MI

Authorized Agent: _____
Last name First name MI

Address: 280 H STREET
FREMONT, CA. 94536

Phone: (510) 794-4618 (510) 438-2597 (P&R)
City State Zip

FAX: (510) 623-1874 E-Mail Address: _____
Home Work

A. County of use: JACKSON B. River basin (see reverse): _____

C. Legal description of reservoir location:

Township	Range	Section	Quarter/Quarter	Tax Lot #
40 S	3 E	5		107

D. Name, if any, of reservoir: POND E. Reservoir in existence since: 1 / 1 / ?
MM DD YY

F. Source of water: SEASONAL RUN-OFF which flows into TYLER OR EMIGRANT
Name of river or creek Name of river or creek ?

G. Maximum height of dam: 4 feet.

H. Quantity of water stored in reservoir at maximum capacity (see reverse): POND IS SEASONAL - APPROX. 12' x 15' acre-feet.

I. Water stored in reservoir is used for (see reverse): WILDLIFE

J. Rate and area of use: Refer to chart on the back of this form. For each type of water use listed in Item I, show the quantity of water used and, if applicable, the number of acres on which water is used.

BEFORE YOU SIGN AND SUBMIT THIS APPLICATION... HAVE YOU:

- ☒ Answered each question on this form as completely as possible? YES
- ☒ Attached a legible map showing township, section, range, quarter-quarter & tax lot number?

By my signature below, I swear that all statements made and information provided in this application are true to the best of my knowledge.

Kathleen R. Rishel
(Signature of Landowner/Agent)

KATHLEEN R. RISHEL, OWNER
(Printed name and title)

1/30/97
(Date)

For Department Use	File # <u>82198</u>	Date received <u>1/30/97</u>
--------------------	---------------------	------------------------------

FEB - 4 1997

LA-37739

EXHIBIT A

WATER RESOURCES DEPT.
SALEM, OREGON

A tract of land situated in Section 5 in Township 40 South, Range 3 East of the Willamette Meridian in Jackson County, Oregon, more particularly described as follows: Commencing at the northeast corner of the Northwest Quarter of the Southeast Quarter of said Section 5, thence South 45°01'33" West 284.98 feet, thence North 44°24'40" West 1535.91 feet (record North 44°24'18" West 1536.03 feet) to the easterly right-of-way line of Tyler Creek (County) Road, thence along said right-of-way line, South 17°11'43" West 28.42 feet to a 5/8" iron rod (Spero LS 2309) for the true point of beginning; thence South 44°24'40" East 683.73 feet to a 5/8" iron rod (Spero LS 2309); thence South 45°01'33" West 375.40 feet to a 5/8" iron rod (Spero LS 2309); thence North 44°26'20" West (record North 44°26'11" West) 555.27 feet to a 1/2" iron pipe on the southeasterly right-of-way line of Tyler Creek (County) Road; thence along said right-of-way line and along the arc of a 160 foot radius curve (the long chord bears North 43°23'02" East 141.34 feet), an arc distance of 146.39 feet (record 146.32 feet); thence continuing along said right-of-way line, North 17°11'43" East (record North 17°13'28" East) 266.47 feet to the true point of beginning.

(Code 5-2, Portion Account #1-11201-9, Map #403E5, Portion Tax Lot #107)
(Code 5-2, Portion Account #1-11229-7, Map #403E5, Portion Tax Lot #1900)

P- 82198

~~FEB - 4 1997~~

(P 9391)

~~1P-4269~~

(P-11413)

P-82198

WR

~~5-2~~

40 3E 5

JACKSON COUNTY TITLE
DIVISION OF CONTINENTAL LAND TITLE CO.
502 W. MAIN Ph. 779-2811 MEDFORD, OREGON

T40 S. R. 3E SEC. 5

T.L. 107

RECEIVED

FEB - 4 1997

WATER RESOURCES DEPT
SALEM, OREGON

COPY CASE


Well to be drilled at future date and will conform to County requirements for setbacks from septic fields, etc.

AREA "1" SUB-SECTION "13-J"

ORDER SIGNED? —
BOARD RE-ZONED

APPEAL TO
L.U.B.A.
? (STATE)
IF NOT - OK

Conditionally Approved (X)
Approved ()
Denied ()
By: W. Langen Date: 9-15-89
Jackson County Planning & Development

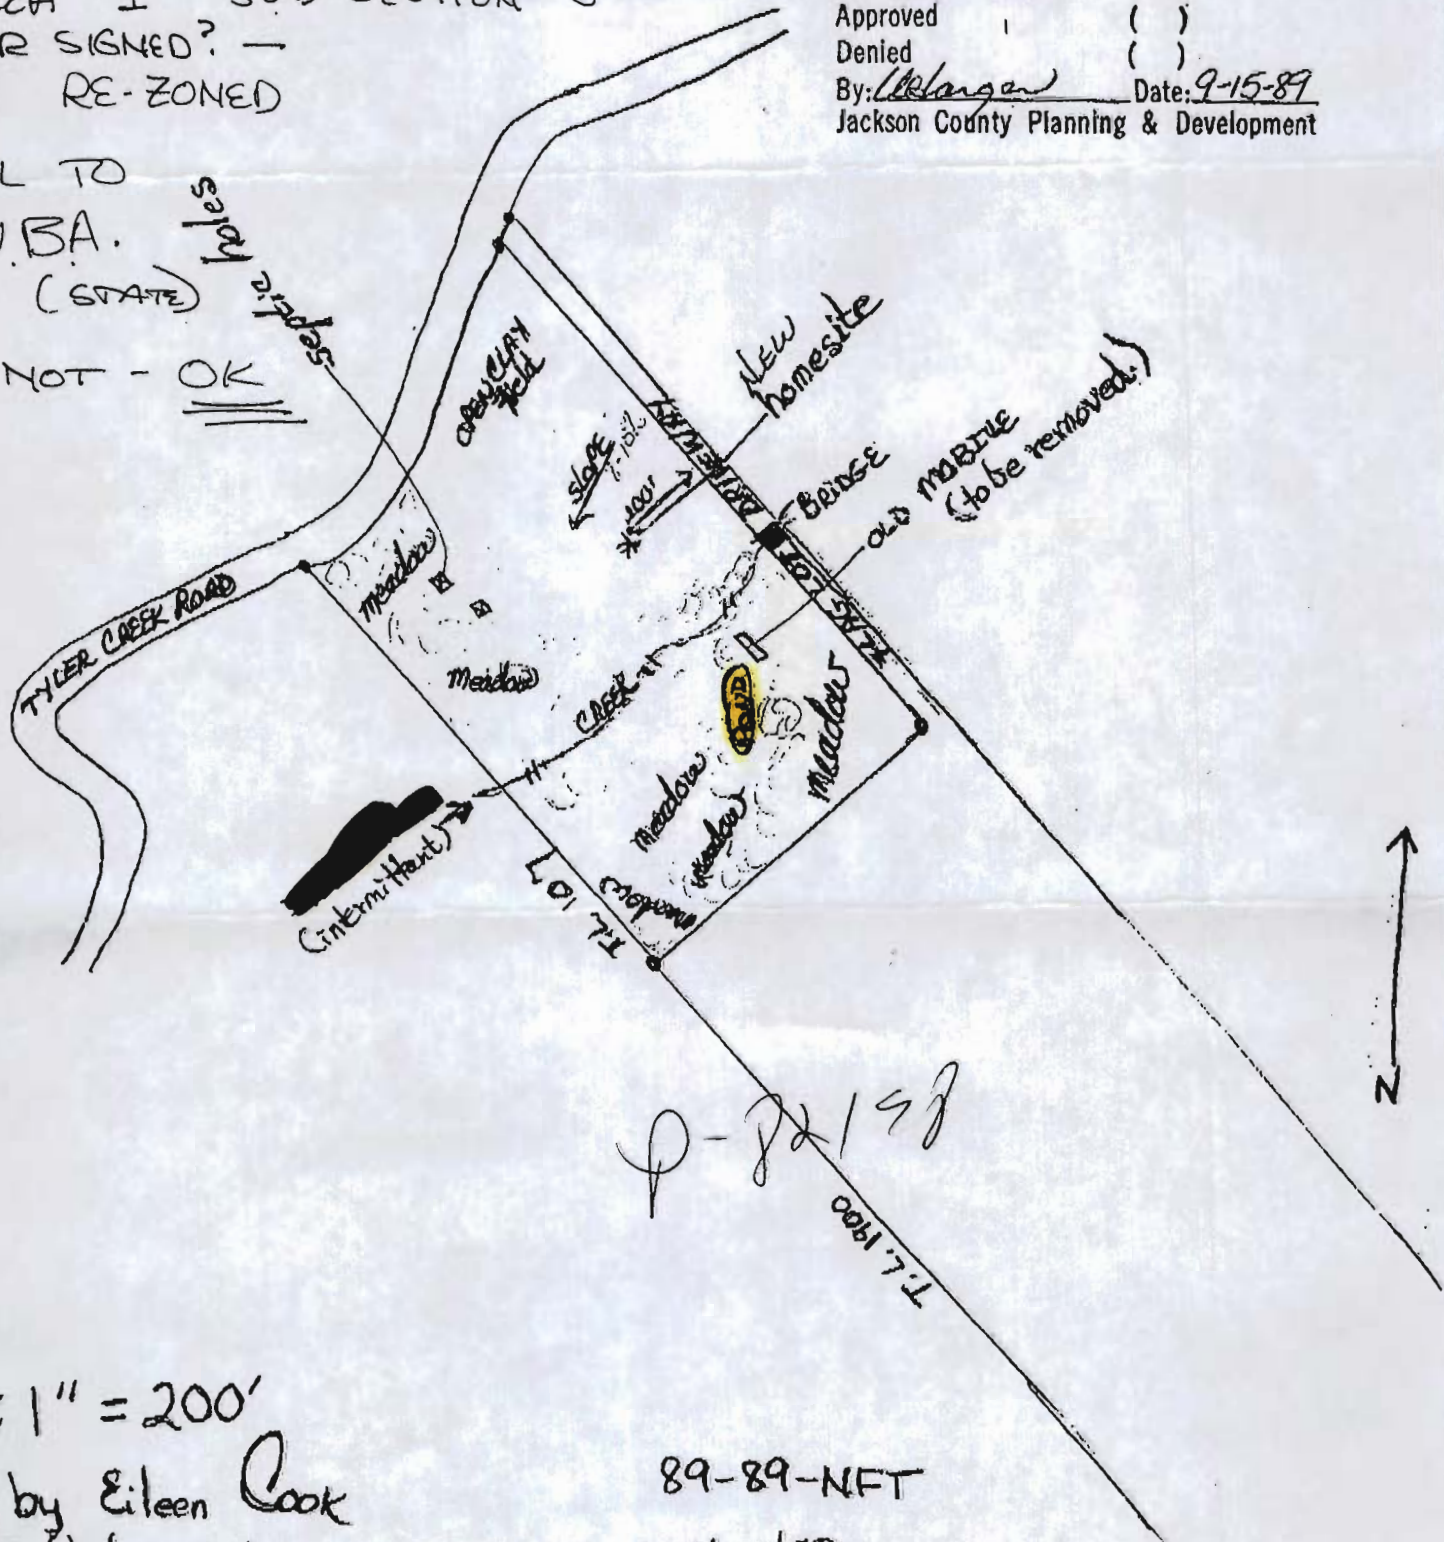

SCALE: 1" = 200'

prepared by Eileen Cook

89-89-NFT