


History of Subject Property

The Sogins purchased the subject property in 1999 for a consideration of \$45,000 from Chere Winters. At the time of sale the parcel was raw land, and has since been developed as a cranberry farm. We believe easements for road access, the sump, and pump house were provided to the buyer at the time of sale or shortly thereafter.

Zoning

The subject property is zoned EFU-Exclusive Farm Use. This zone is primarily designed for agricultural and forest related uses, and the residential uses in conjunction with the growing of cranberries is allowed. Appropriate zoning language can be found in the addenda section of this report.

Zoning Map

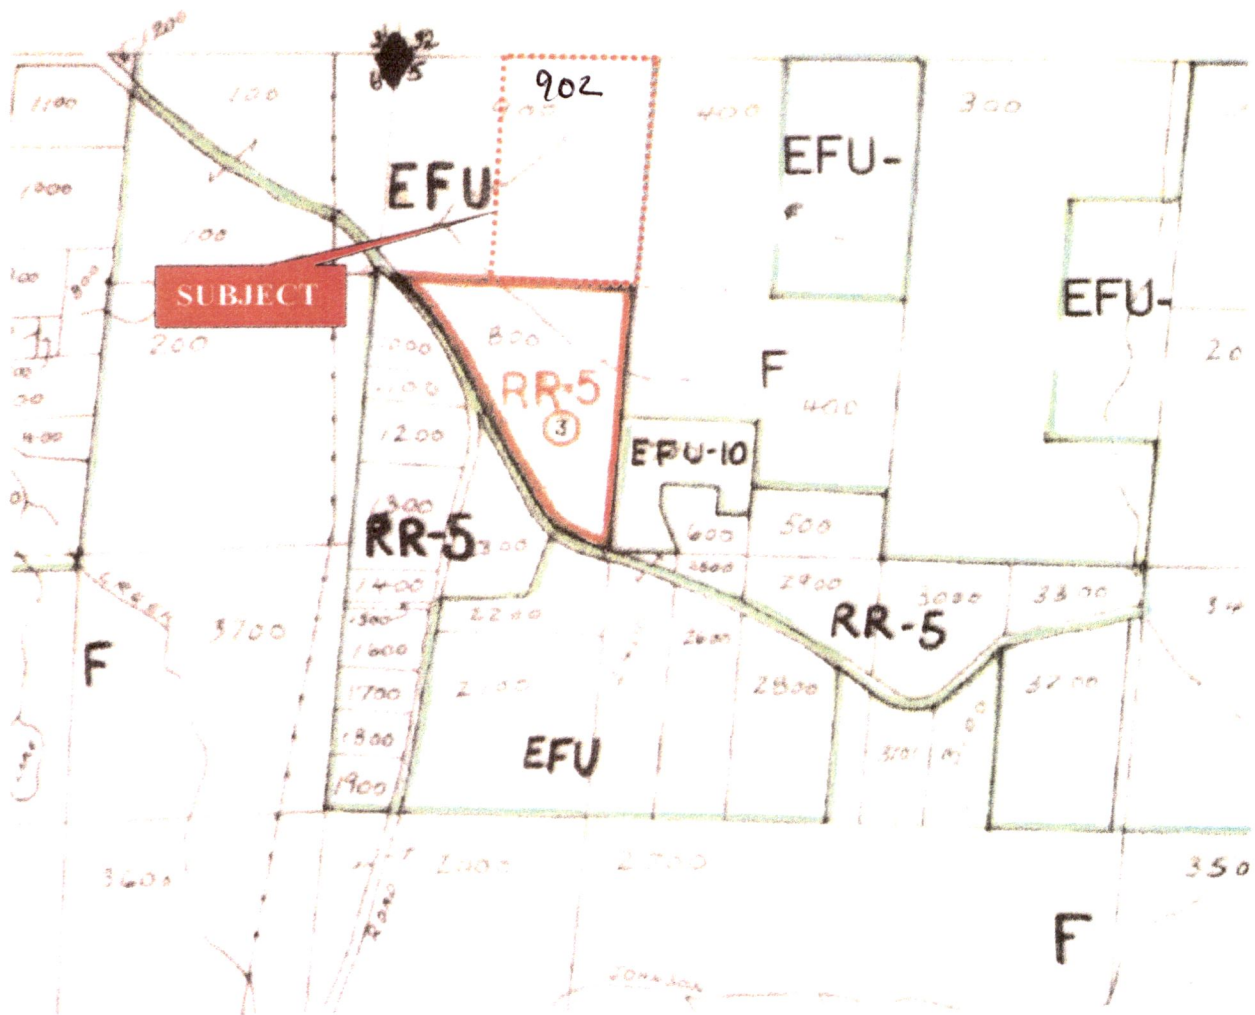

--- Lines are approximate

RECEIVED BY OWRD

NOV 27 2017

SALEM, OR

RECEIVED

OCT 12 2017

OWRD

PURPOSE ONLY

B-3373 - 10/27/2010

G-18586

1000 / nach einer Zeit

Udding
Sump

Bamming for
well

irrigation

800 FT
from NW
corner

Aerial View

SALEM OF

----- = Lines are approximate.

Baron
well
Domestic
well
wrap

700 FT
From
36 com

RECEIVED

OCT 12 2017

OWRD

Marineau and Associates


B-3373 - 10/27/2010

96587-25

RECEIVED BY OWNER

NOV 27 2017

AS-BUILT PLAN OF THE CONSTRUCTED SYSTEM. Indicate the direction of NORTH. Show locations of all wells within 200 feet of the system. Show system setback distances from property lines, structures, wells, streams, etc.

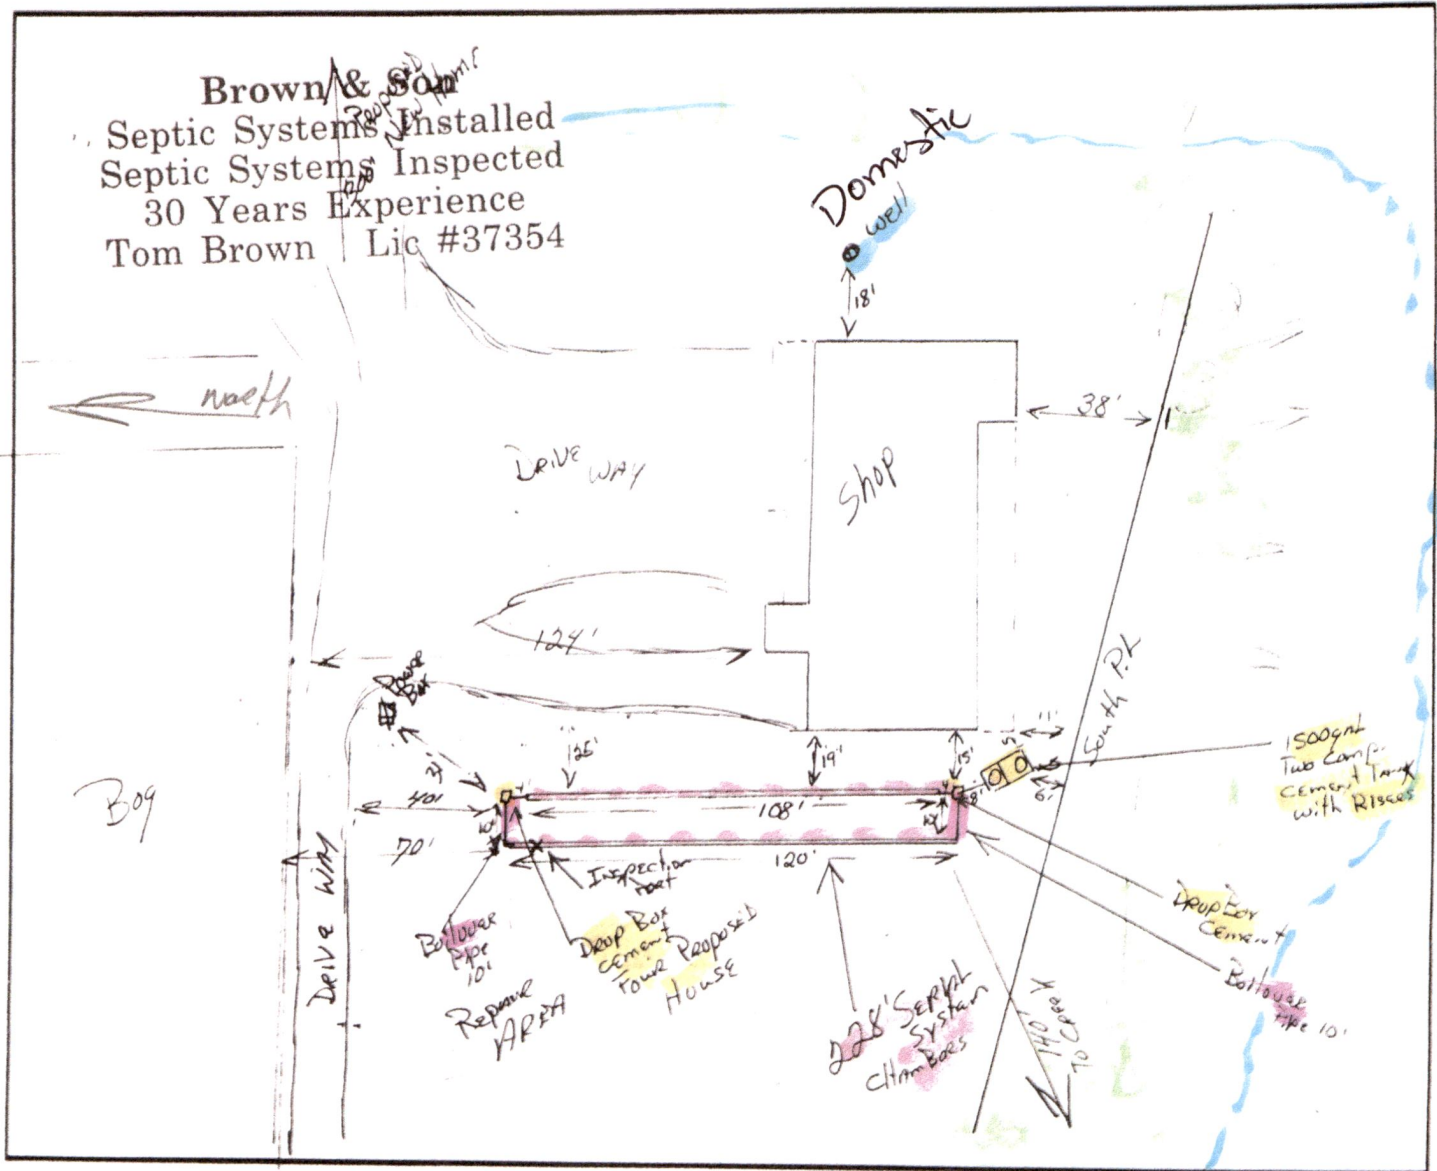

I certify that the information provided on both pages of this document is correct and that the construction of this system was in accordance with the permit and the rules regulating the construction of onsite wastewater treatment systems (OAR Chapter 340, Divisions 71 and 73)

Owner/Permittee or Certified Installer w/Certification#:		Print Name: <u>Brown & Son</u>	
Licensed Installer:	Yes ☒ No ☐	License#: <u>37354</u>	Certification# <u>I185 6-29-08</u>
Owner/ Certified Installer:	Signature: <u>Thomas W Brown</u>		Date: <u>10-2-08</u> Phone#: <u>297-0780</u>

Notice Accepted	Yes	No	Date:
-----------------	-----	----	-------

Installer/Owner
(Permittee) Yes No Date

If No, Reason for Non Acceptance:

Comment:

Notified:

RECEIVED BY OWRD

NOV 27 2017

SALEM, OR

RECEIVED

OCT 12 2017

OWRD

G-18586