

Permit No. 45899

45899

RECEIVED

APR 28 1981

WATER RESOURCES DEPT
SALEM, OREGON

STATE OF OREGON WATER RESOURCES DEPARTMENT

Application for Permit to Appropriate Surface Water

I, Theodore R. McNeely.

(Name of Applicant)

of.....1450 Fairview Rt

(Mailing Address)

Coguille

(City)

State of.....Ore

97473

Phone No. 396-2279

. do hereby

make application for a permit to appropriate the following described waters of the State of Oregon:

1. The source of the proposed appropriation is ^{two} UNNAMED STREAMS

two

Unnamed Streams

....., a tributary of Coquille River.

2. The point of diversion is to be located See below ft. and ft.

(N. or S.)

(E. or W.)

from the corner of

(Public Land Survey Corner)

POD #1 40' N 1875' W from SE cor sec 19

(If there is more than one point of diversion, each must be described)

~~POD #2 190' N 1970' W from SE cor sec 19~~

POB#3 510' N 2000' W "

..... being within the SW $\frac{1}{4}$ of the SE $\frac{1}{4}$ of

Sec. 19 Tp. 28S R. 12W, W. M., in the county of Coos
(N. or S.) (E. or W.)

(N. or S.)

(E. or W.)

., W. M., in the county of.....Coos

3. Location of area to be irrigated, or place of use if other than irrigation.

[illegible]

4. The amount of water which the applicant intends to apply to beneficial use is 0.015
cubic feet per second from Unad St. #1 to be supplemented from
(If water is to be used from more than one source, give quantity from each)

5. The use to which the water is to be applied is 4 domestic uses = 0.01 stock = 0.005

6.

DESCRIPTION OF WORKS

Include dimensions and type of construction of diversion dam and headgate, length and dimensions of supply ditch or pipeline, size and type of pump and motor, type of irrigation system to adequately describe the proposed distribution system.

POD #1: Concrete tiles in stream - 1600 feet $1\frac{1}{4}$ " x 1"
plastic pipe to places of use - $\frac{3}{4}$ hp. electric
pump.

POD #3: Dirt dam 3 feet high - 500 feet 1" pipe to
POD #1 - $\frac{3}{4}$ hp. electric pump.

If for domestic use state number of families to be supplied 4

7. Construction work will begin on or before Has begun

8. Construction work will be completed on or before April 27, 1983

9. The water will be completely applied to the proposed use on or before April 27, 1984

Application No. 61606

Permit No. 45899

72800

Application No. 61606

Permit No. 45899

Permit to Appropriate the Public Waters of the State of Oregon

42800

This is to certify that I have examined the foregoing application and do hereby grant the same **SUBJECT TO EXISTING RIGHTS INCLUDING THE EXISTING FLOW POLICIES ESTABLISHED BY THE WATER POLICY REVIEW BOARD** and the following limitations and conditions:

The right herein granted is limited to the amount of water which can be applied to beneficial use and shall not exceed 0.015 cubic feet per second measured at the point of diversion from the stream, or its equivalent in case of rotation with other water users, from unnamed Stream 1, with any deficiency in the available supply from Stream 1 to be made up by appropriation from unnamed Stream 2

The use to which this water is to be applied is domestic for four families and stock, being 0.01 cfs for domestic and 0.005 cfs for stock.

If for irrigation, this appropriation shall be limited to of one cubic foot per second or its equivalent for each acre irrigated


and shall be subject to such reasonable rotation system as may be ordered by the proper state officer.

The priority date of this permit is April 28, 1981

Actual construction work shall begin on or before August 20, 1982 and shall thereafter be prosecuted with reasonable diligence and be completed on or before October 1, 1983

Complete application of the water to the proposed use shall be made on or before October 1, 1984

WITNESS my hand this 20th day of August, 1981

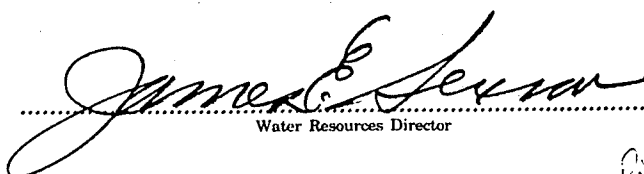
Water Resources Director

RAH B

Remarks: POD#1 will be the primary point of diversion. During dry summer months natural water flow is not always available at this point. Water is generally available even during drought years at ~~POD#2 and POD#3~~ because of springs and less seasonal ~~and a~~ more reliable stream (~~POD#~~ Union Str#2) downstream

Theodore R. McFeely
Signature of Applicant

This is to certify that I have examined the foregoing application, together with the accompanying maps and data, and return the same for.....

In order to retain its priority, this application must be returned to the Water Resources Director with corrections on or before, 19.....

WITNESS my hand this day of, 19.....

..... Water Resources Director

By

This instrument was first received in the office of the Water Resources Director at Salem, Oregon, on the

28 day of April, 1981, at 11:00 o'clock
A.M.

Application No. 61606 Permit No. 45899


12820

RECEIVED

APR 28 1981


WATER RESOURCES DEPT
SALEM, OREGON

T28S R12W
S $\frac{1}{2}$ SE $\frac{1}{4}$
Sec 19

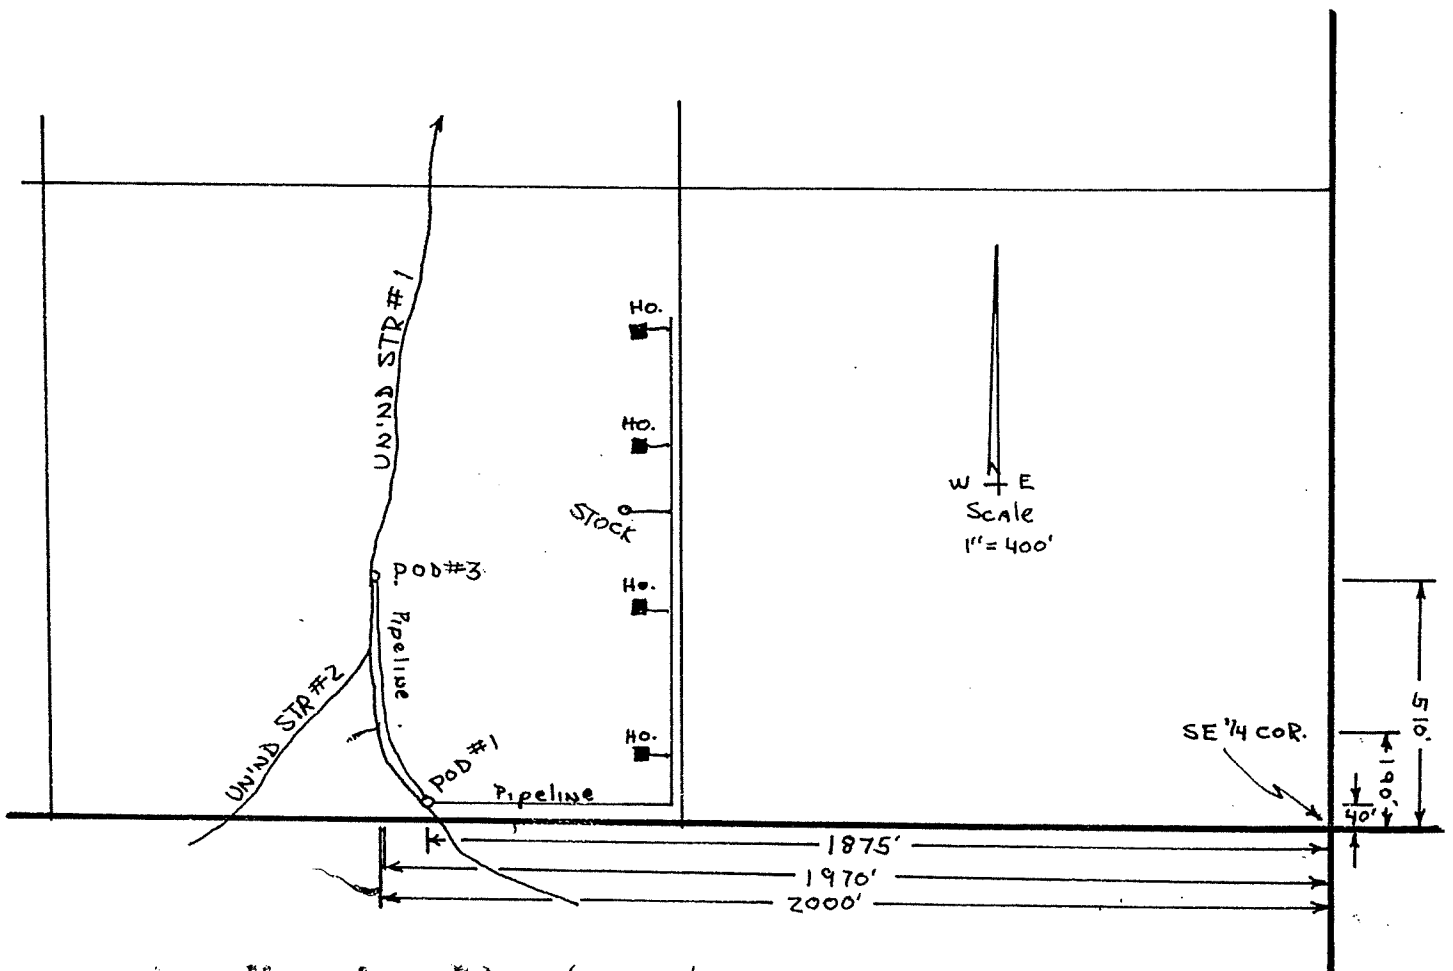

Application No. 61606
Permit No. 45899

Application No. 61606
 Permit No. 45899

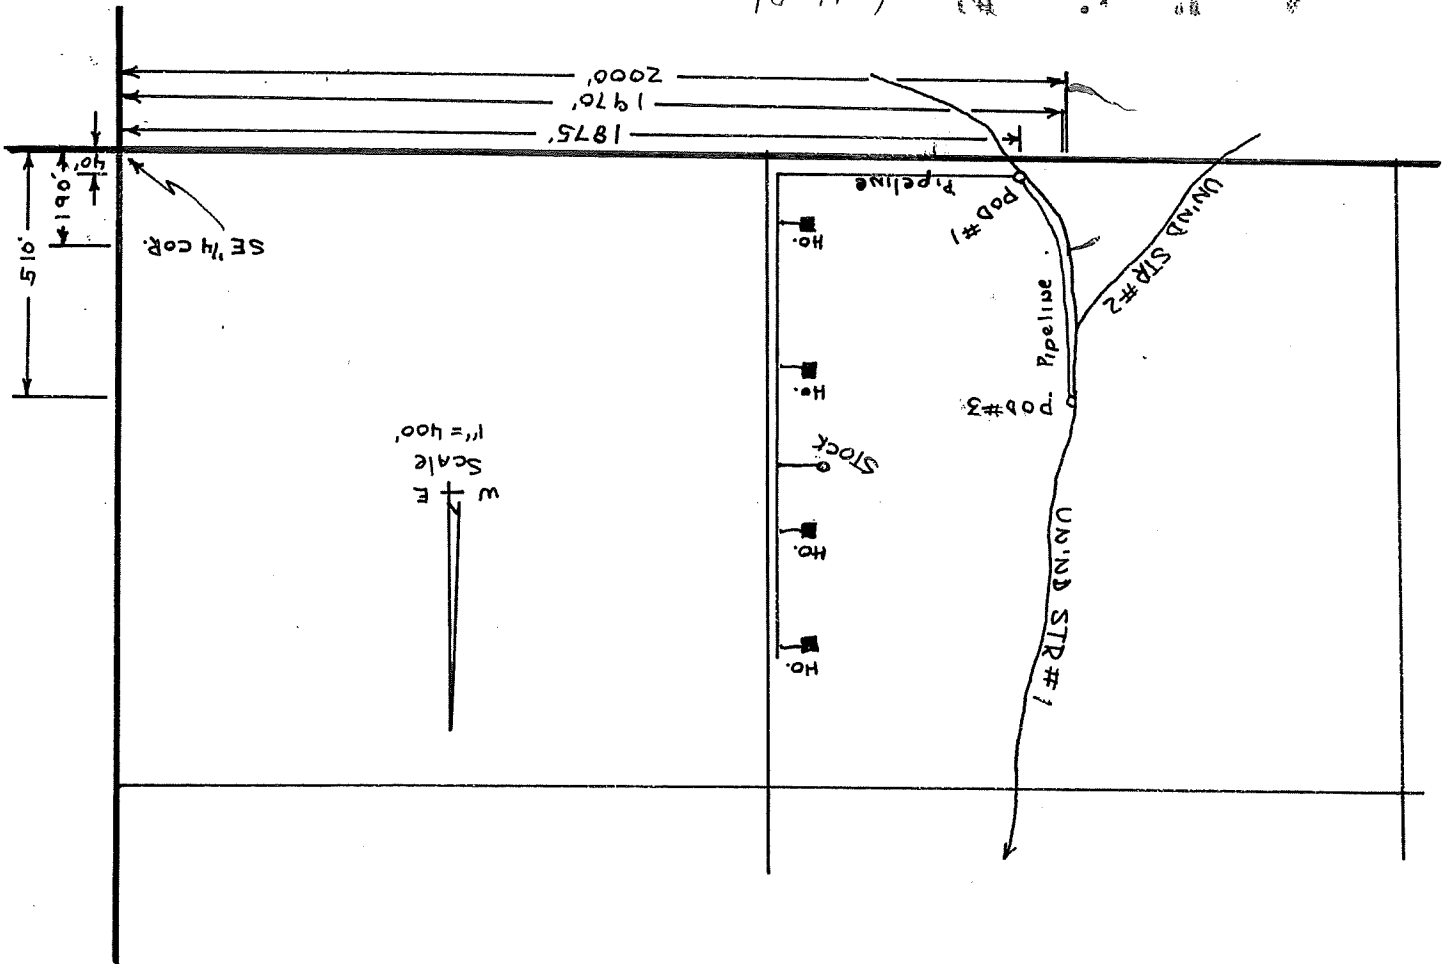

T28S R12W
 S 1/2 SE 1/4
 Sec 19

RECEIVED
 APR 28 1981
 WATER RESOURCES DEPT
 SALEM, OREGON

Journal of Management Education 26(8)

Application No. 61166
Permit No. 45899


RECEIVED RECEIVED


JAN 14 1981

APR 28 1981

WATER RESOURCES DEPT WATER RESOURCES DEPT
SALEM, OREGON SALEM, OREGON

Scale = 1" = 200'
W21R 582 L

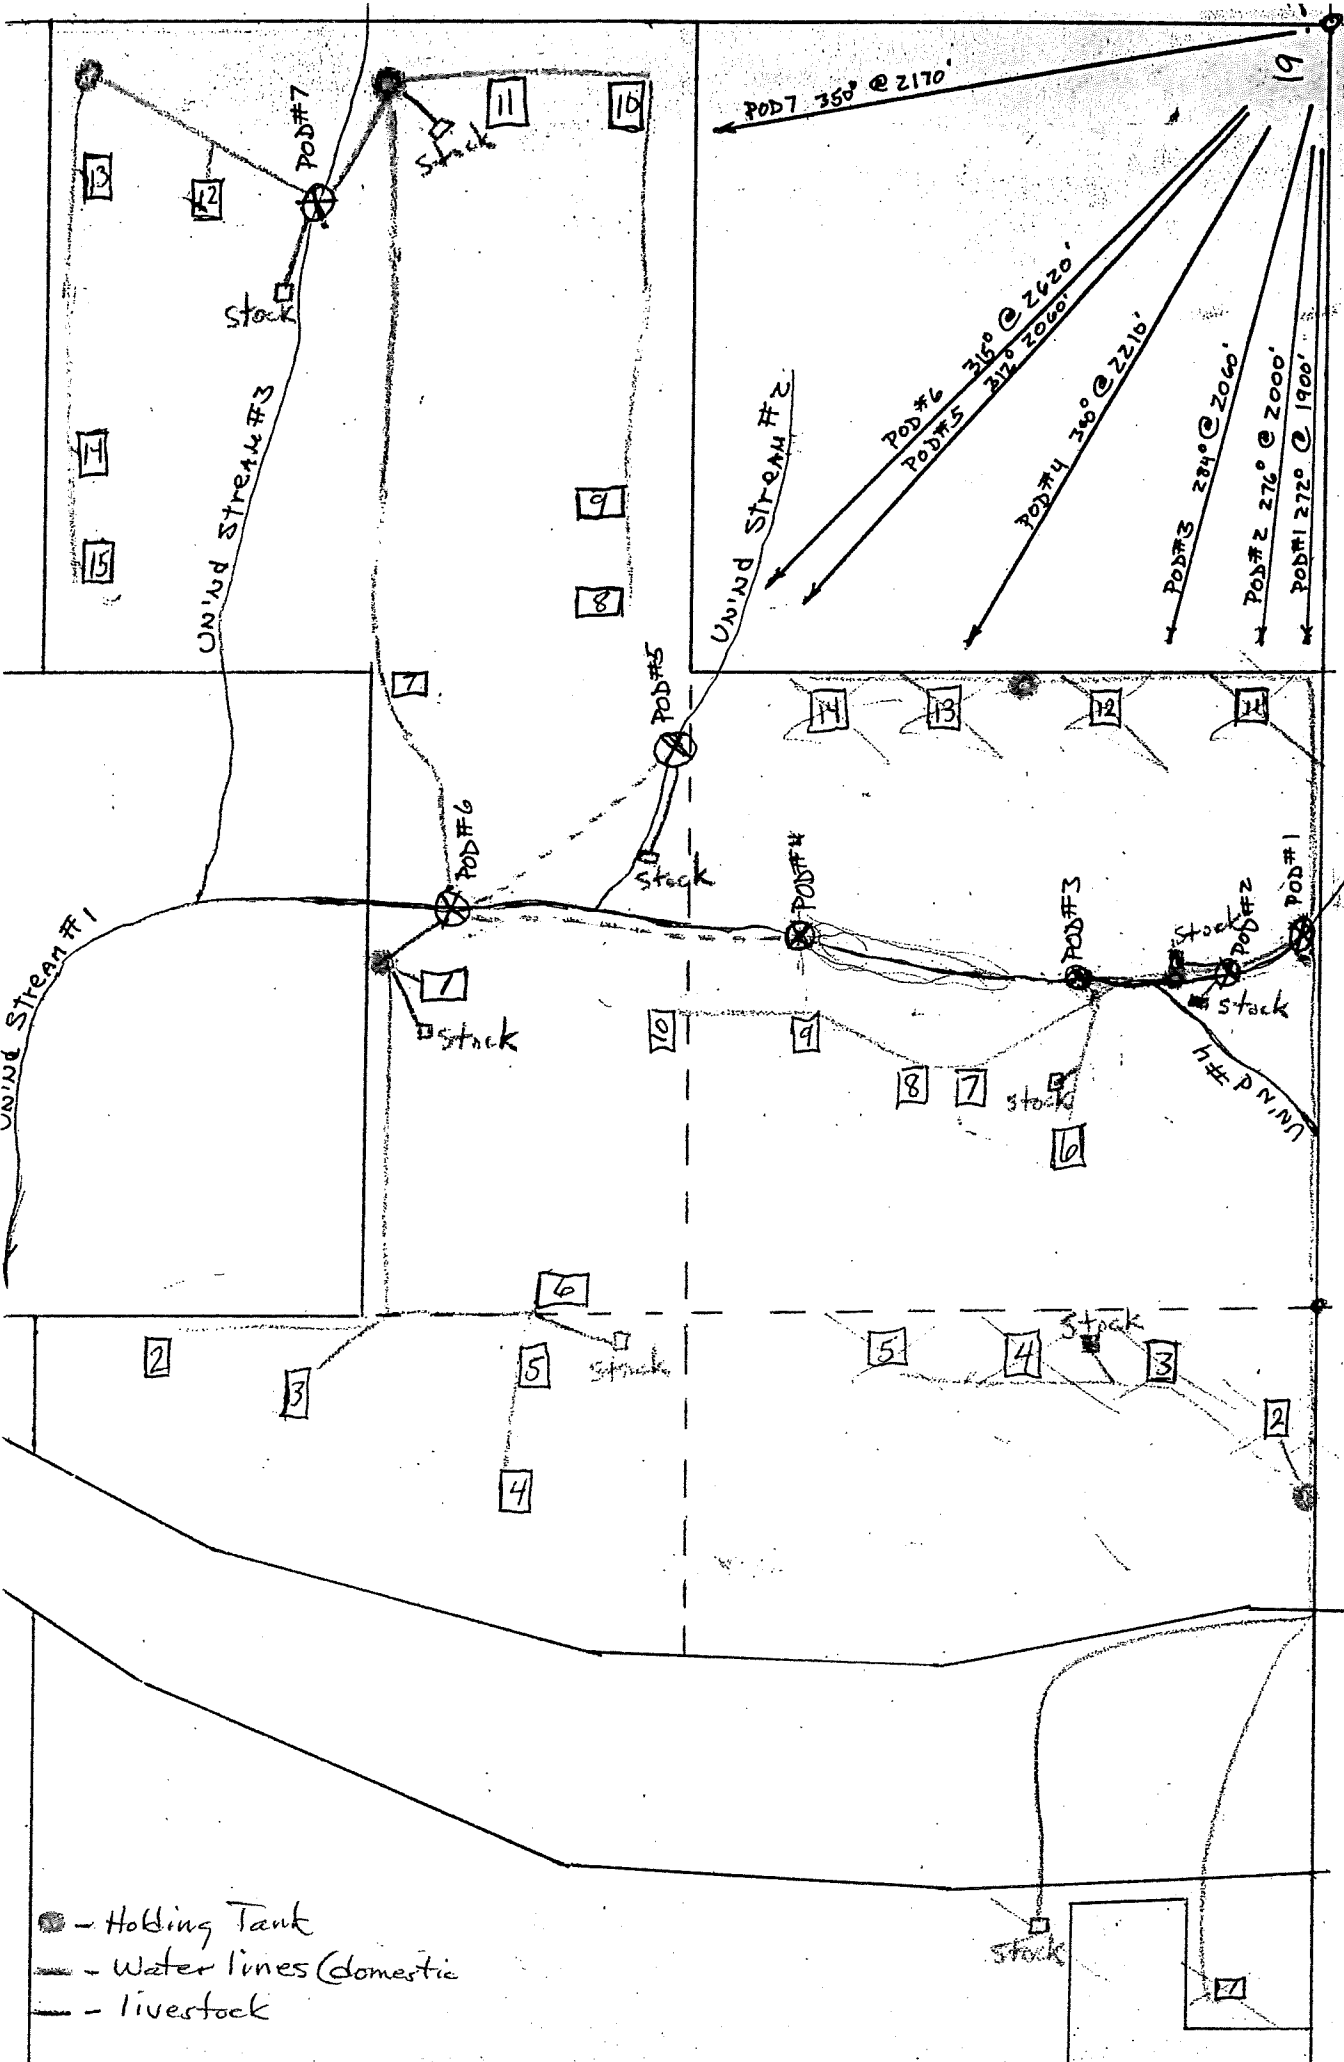

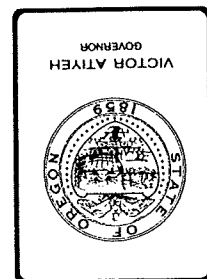

Water Resources Department

555 13th STREET N.E., SALEM, OREGON 97310

PHONE

378-8508

March 26, 1985

Theodore R. McNeely
1450 Fairview Route
Coquille, OR 97423

REFERENCE: File 61606

According to the terms of your Permit 45899 which was for 0.015 cubic foot per second of water from two unnamed streams for domestic use for four families and stock purposes in Coos County,

Complete application of water means the application of water to a beneficial use under the permit to the full extent intended. In the case of irrigation, it means beneficial irrigation of all the lands the permittee intends to cover under the terms of the permit. If the water has been used, you should promptly submit notice describing the extent of completion as set forth in the letter accompanying your permit and also in our postal card of October 18, 1984.

ORS 537.260 provides that: "Whenever the time within which any application under a permit should have been perfected has expired and the owner of the permit fails or refuses within three months thereafter to submit to the Water Resources Director proof of completion of the application as required by ORS 537.230 and 537.250, the Water Resources Director may, after 60 days notice by registered mail, order the cancellation of the permit..."

In accordance with the provisions of ORS 537.260, you are hereby notified that unless proof of beneficial use is received within 60 days from the date of this letter, the permit(s) may be canceled without further notice. If for any reason, you are no longer interested in the project described by the permit, we would appreciate it if you would so advise. If the property involved has changed hands and any part of the project has been completed, you should immediately assign the permit to the new owner and advise us of his name and address. An assignment form will be furnished upon request.


Sincerely,

Bruce A. Estes

Bruce A. Estes, Supervisor
Survey/Certificate Section

FORM 690-10-100
CERTIFIED - RETURN RECEIPT REQUESTED

COPY

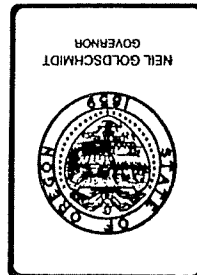

NEIL GOLDSCHMIDT
GOVERNOR

Water Resources Department

3850 PORTLAND ROAD NE, SALEM, OREGON 97310

PHONE

378-3739

March 22, 1988

John Drollet
Watermaster, Dist. 19
290 North Central
Coos Co. Annex
Coquille, OR 97423

Dear John:

REFERENCE: Files 61604-61609, T.R. McNeely

You have asked if Mr. McNeely can still apply for extensions of the time limits for his permits 45897, 45898, 45899, 45900, 45901, and 45902. The answer is "Yes, he can".

Except for Permit 45900 which was filed as "completed", we have not been notified as to what, if anything, was accomplished since the permits were issued. No B or C forms were filed, and no response was received from our March 26, 1985 certified letter.

Any request for extension of time would have to be very clear as to what was accomplished within the time limits in terms of construction and use of water. The permits are all awaiting survey, and carry the "survey regardless" designation.

Sincerely,

Steven P. Applegate
Field Crews Supervisor
SPA:ldh

July 23, 1981

Theodore R. McNesly
1456 Fairview Route
Coquille, OR 97423

Dear Mr. McNesly:

REFERENCE: Files 61604, 61605, 61606, 61607, 61608 and 61609

Your six applications and accompanying maps have been reviewed. Application 61604 describes the proposed use of 0.015 cubic foot per second of water from two unnamed streams for domestic use for four families and stockwater. Application 61605 describes the proposed use of 0.01 cfs from two unnamed streams for domestic use for five families and stockwater. Application 61606 describes the proposed use of 0.015 cfs from two unnamed streams for domestic use for four families and stockwater. Application 61607 describes the proposed use of 0.02 cfs of water from two streams for domestic use for six families and stockwater. Application 61608 describes the proposed use of 0.015 cfs of water from an unnamed stream for domestic use for five families and stockwater, and Application 61609 describes the proposed use of 0.015 cfs from two unnamed streams for domestic use for five families and stockwater.

Permits will be issued for the use of water from the Coquille River and its tributaries. However, water may not be available during dry periods. The water may be needed to satisfy existing rights.

Your applications are in satisfactory form for the issuance of permits and will be considered for approval with the next group to be processed.

Sincerely,

STEPHEN C. CROWN
Water Rights Engineer

SCB:wpb

enclosure Receipt 13838

5949A

Theodore R. McNeely
1456 Fairview Route
Coquille, Oregon 97423

61604
61605
61606
61607
61608
61609

45897, 45898, 45899, 45900, 45901 and 45902.

Form 111

FOIA b 7 - D

Name Theodore R. McNeely
 Address 1450 Fairview Rt. Co. #1111e, OR 97423
 Assigned _____
 Address _____
 Beginning construction Aug 20 1982
 Completion of construction OCT 1 - 1983
 Extended to _____
 Complete application of water OCT 1 - 1984