



**Oregon**  
Kate Brown, Governor

**Water Resources Department**

725 Summer St NE, Suite A

Salem, OR 97301

(503) 986-0900

Fax (503) 986-0904

January 6, 2021

Hollis Land & Timber LLC  
3 Monroe Parkway  
Suite P-425  
Lake Oswego OR 97305

On December 30, 2020 the Water Resources Department received the Claim of Beneficial Use (COBU) for the following file(s):

Application R-87985 Permit R-15182

The COBU included a report and map. The Department hopes to review your submittal within approximately 2 - 4 years. At that time we will review these items and provide a final certificate, proposed certificate, or a request for additional information.

If you are interested in having your COBU reviewed sooner, you may pay to have your file processed immediately, using the Reimbursement Authority program, which is described at:

<https://www.oregon.gov/OWRD/programs/WaterRights/RA/Pages/Certificate.aspx>

Customer Service phone: (503) 986-0900

Enclosed is your receipt for the \$200.00 COBU recording fee

If you sell the property, please contact the Department, or have the new owners contact the Department about the need to file an assignment.

Cc: file R-87985  
William Flatz, CWRE

# Checklist for Claims of Beneficial Use Received at CSG Counter

Application #:	WRD Reviewer:
Transfer #:	
Date Received:	
CWRE Name:	
Priority Date (s):	

## Fees Required:

- YES  NO  A fee of \$200 must accompany this form for permits with priority dates of July 9, 1987, or later.
- YES  NO  A fee of \$200 must accompany this form for any transfers including a water right with a priority date of July 9, 1987, or later.  
 Example – A transfer involves 5 rights and one of the rights has a priority date of July 9, 1987, or later, the fee is required.

Fill in App or Transfer Number

## Map Review:

- Map on polyester film (OAR 690-014-0170(1) & 310-0050(1)(b))
- Application & permit #; or transfer # (OAR 690-014-0100(1))
- Disclaimer (OAR 690-014-0170(5))
- North arrow (OAR 690-310-0050(2)(c))
- CWRE stamp and signature (OAR 690-014 & 310-0050)
- Appropriate scale (1" = 1320', 1" = 400', or the original full-size scale of the county assessor map) (014 & 310)
- Township, range, section, and tax lot numbers (OAR 690-310-0050(4) )

## Report Review:

- On form provided by the Department (OAR 690-014-0100(1))
- Application & permit #; or transfer # (OAR 690-014)
- Ownership information (OAR 690-014)
- Date of survey (OAR 690-014)
- Person interviewed (OAR 690-014)
- County (OAR 690-014)
- CWRE stamp and signature (OAR 690-014-0100)
- Signature(s) of all permittee of transfer holder (OAR 690-014-0100)

**MONEY SLIP**

DATE: \_\_\_\_\_ RECEIPT #: \_\_\_\_\_

RECEIVED FROM: \_\_\_\_\_ APPLICATION PERMIT TRANSFER

CASH  CHECK # \_\_\_\_\_ OTHER (IDENTIFY) \_\_\_\_\_ TOTAL RECD \$ \_\_\_\_\_

1083 TREASURY 4178 MISC CASH ACCT.

0407 COPIES \_\_\_\_\_ \$ \_\_\_\_\_  
 OTHER: (IDENTIFY) \_\_\_\_\_ \$ \_\_\_\_\_

0243 Instream Lease \_\_\_\_\_ 0244 Muni Water Mgmt. Plan \_\_\_\_\_ 0245 Cons. Water \_\_\_\_\_

1083 TREASURY 4270 WRD OPERATING ACCT.

MISCELLANEOUS

0407 COPY & TAPE FEES 4611 \$ \_\_\_\_\_

0410 RESEARCH FEES \$ \_\_\_\_\_

0409 MISC REVENUE (IDENTIFY) \$ \_\_\_\_\_

TC162 DEPOSIT LIAB. (IDENTIFY) \$ \_\_\_\_\_

0240 EXTENSION OF TIME \$ \_\_\_\_\_

WATER RIGHTS EXAM FEE RECORD FEE

0201 SURFACE WATER \$ \_\_\_\_\_ 0202 \$ \_\_\_\_\_

0203 GROUND WATER \$ \_\_\_\_\_ 0204 \$ \_\_\_\_\_

0205 TRANSFER \$ \_\_\_\_\_

WELL CONSTRUCTION EXAM FEE RECORD FEE

0218 WELL DRILL CONSTRUCTOR \$ \_\_\_\_\_ 0219 \$ \_\_\_\_\_

LANDOWNER'S PERMIT \$ \_\_\_\_\_ 0220 \$ \_\_\_\_\_

OTHER (IDENTIFY) COBU \$ 200.00

0607 TREASURY 0487 HYDROELECTRIC

0233 POWER LICENSE FEE (FWWRD) LIC NUMBER \_\_\_\_\_ \$ \_\_\_\_\_

0231 HYDRO LICENSE FEE (FWWRD) \_\_\_\_\_ \$ \_\_\_\_\_

HYDRO APPLICATION \$ \_\_\_\_\_

SPECIAL INSTRUCTIONS:

RETURN TO APPLICANT -- LETTER ATTACHED

## Groundwater File Review:

- Pump Test not required (Priority Date prior to December 20, 1988) \*If no, include pump test flyer w/acknowledgment letter
- Pump Test required (Priority Date on or after December 20, 1988)
- Pump Test submitted
- Pump Test not submitted

**CLAIM OF  
BENEFICIAL USE  
for Reservoir Permits by  
CWRE's (not self-certified)**



**Oregon Water Resources Department**  
725 Summer Street NE, Suite A  
Salem, Oregon 97301-1266  
(503) 986-0900  
[www.oregon.gov/OWRD](http://www.oregon.gov/OWRD)

**RECEIVED**

**DEC 30 2020**

**OWRD**

**A fee of \$200 must accompany this form for permits with priority dates of July 9, 1987, or later. Claims received without the correct fee of \$200 will be returned.**

**A separate form shall be completed for each permit.**

*In cases where a permit has been amended through the permit amendment process, a separate claim for the permit amendment is not required. Incorporate the permit amendment into the claim for the permit.*

This form is subject to revision. **Begin each new claim by checking for a new version of this form at:**  
<https://www.oregon.gov/OWRD/Forms/Pages/default.aspx>

The completion of this form is required by OAR 690-014-0100(1) and 690-014-0110(4).

Please type or print in dark ink. If this form is found to contain errors or omissions, it may be returned to you. **Every item must have a response.** If any requested information does not apply to the claim, insert "NA." **Do not delete or alter any section of this form unless directed by the form.** The Department may require the submittal of additional information from any water user or authorized agent.

"Section 8" of this form is intended to aid in the completion of this form and should not be submitted.

If you have questions regarding the completion of this form, please call 503-986-0900 and ask for the Certificate Section.

The Department has a program that allows it to enter into a voluntary agreement with an applicant for expedited services. Under such an agreement, the applicant pays the cost to hire additional staff that would not otherwise be available. This program means a certificate may be issued in about a month. For more information on this program see:

<https://www.oregon.gov/OWRD/programs/WaterRights/RA/Pages/default.aspx>

**SECTION 1**

**GENERAL INFORMATION**

**1. File Information**

<b>APPLICATION #</b> R-87985	<b>PERMIT # (IF APPLICABLE)</b> R-15182	<b>PERMIT AMENDMENT # (IF APPLICABLE)</b> N/A
---------------------------------	--	--

**2. Property Owner (current owner information)**

APPLICANT/BUSINESS NAME <b>Hollis Land and Timber LLC</b>		PHONE NO.	ADDITIONAL CONTACT NO.
ADDRESS <b>3 Monroe Parkway, Suite P-425</b>			
CITY <b>Lake Oswego</b>	STATE <b>OR</b>	ZIP <b>97035</b>	E-MAIL

**RECEIVED****DEC 30 2020****OWRD**

If the current property owner is not the permit holder of record, it is recommended that an assignment be filed with the Department. ***Each permit holder of record must sign this form.***

**3. Permit holder of record (this may, or may not, be the current property owner)**

PERMIT HOLDER OF RECORD <b>Hollis Land and Timber LLC</b>		
ADDRESS <b>3 Monroe Parkway, Suite P-425</b>		
CITY <b>Lake Oswego</b>	STATE <b>OR</b>	ZIP <b>97035</b>

ADDITIONAL PERMIT HOLDER OF RECORD		
ADDRESS		
CITY	STATE	ZIP

**4. Date of Site Inspection:****2-6-2017****5. Person(s) interviewed and description of their association with the project:**

NAME	DATE	ASSOCIATION WITH THE PROJECT
<b>Zach Kramer</b>	<b>2-6-2017</b>	<b>Partner and Manager</b>

**6. County****Yamhill**

**7. If any property described in the place of use of the permit final order is excluded from this report, identify the owner of record for that property (ORS 537.230(5)):**


OWNER OF RECORD <b>N/A</b>		
ADDRESS		
CITY	STATE	ZIP

Add additional tables for owners of record as needed

**SECTION 2  
SIGNATURES**

CWRE Statement, Seal and Signature

The facts contained in this Claim of Beneficial Use are true and correct to the best of my knowledge.

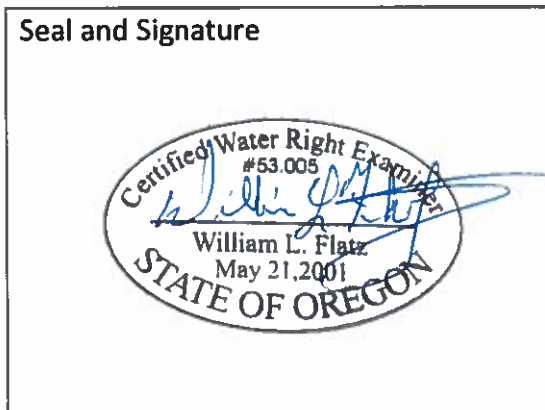

**RECEIVED  
DEC 30 2020  
OWRD**

<b>CWRE NAME</b> William L. Flatz		<b>PHONE NO.</b> 503-357-5717	<b>ADDITIONAL CONTACT NO.</b> 503-939-8381
<b>ADDRESS</b> 2318-B Pacific Avenue			
<b>CITY</b> Forest Grove	<b>STATE</b> OR	<b>ZIP</b> 97116	<b>E-MAIL</b> billflatz@stuntzner.com

Permit Holder's of Record Signature or Acknowledgement

*Each permit or transfer holder of record must sign this form in the space provided below.*

The facts contained in this Claim of Beneficial Use are true and correct to the best of my knowledge. I request that the Department issue a water right certificate.

SIGNATURE	PRINT OR TYPE NAME	TITLE	DATE
	DAVID H. ANDERSON	PRESIDENT	12/18/20

**SECTION 3**

**RECEIVED**

**CLAIM DESCRIPTION**

**DEC 30 2020**

**OWRD**

**1. Reservoir source and, if from surface water, the tributary:**

RESERVOIR NAME OR NUMBER	SOURCE	TRIBUTARY
Hollis Reservoir	Unnamed creek	Bryan Creek, Willamette River

**2. Developed use(s), period of use, and acre foot (af) for each use:**

RESERVOIR NAME OR NUMBER	USES	SEASON OR MONTHS WHEN WATER WAS APPROPRIATED FOR STORAGE	VOLUME STORED (AF)
Hollis Reservoir	Storage for Irrigation, wildlife, aesthetics, fire protection and recreation.	Nov. 1 <sup>st</sup> through June 30 <sup>th</sup> .	75.9 AF
<b>Total Quantity of Water Stored</b>			<b>75.9 AF</b>

**3. Provide a general narrative description of the distribution works. This description must trace the water system from each point of diversion to the reservoir:**

The winter runoff flows downhill into the reservoir. The majority of the runoff flows south in an intermittent channel that was previously excavated when the prior owner installed drain tile. Before flowing into the reservoir the channel enters a sediment settling pool which can be emptied seasonally. The sediment settling pool filled up with sediment during the first winter.



**Drone photo of Hollis Reservoir May 12, 2017**

RECEIVED

DEC 30 2020

OWRD



**Hollis Reservoir first fill complete February 6<sup>th</sup>, 2017.**

**Reminder: The map associated with this claim must identify the location of the point(s) of diversion, Donation Land Claims (DLC), Government Lots (GLot), and Quarter-Quarters (QQ).**

**4. Variations:**

Was the use developed differently from what was authorized by the permit, permit amendment final order, or extension final order? If yes, describe below.

**YES**

**NO**

(e.g. "The permit allowed the development of three reservoirs. The permit holder only developed one of the reservoirs." or "The permit allowed for the storage of 9 acre feet of water. The reservoir was developed to hold 5.2 acre feet.")

**The permit allowed 100 acre feet of storage. The owners developed 75.9 acre feet of storage.**

**5. Claim Summary:**

RESERVOIR NAME OR #	MAXIMUM STORAGE AUTHORIZED BY PERMIT (AF)	MAXIMUM STORAGE DEVELOPED (AF)
Hollis Reservoir	100 AF	75.9 AF

**RECEIVED**

**DEC 30 2020**

**OWRD**



**SECTION 4**

**SYSTEM DESCRIPTION**

Are there multiple reservoirs?

YES  NO

If "YES" you will need to copy and complete Sections A through E for each reservoir.

Reservoir Name or Number this section describes (only needed if there is more than one):

N/A

RECEIVED

DEC 30 2020

**A. Reservoir Location**

1. Is the reservoir on-channel?

YES  NO

2. Provide dam outlet location and/or point of diversion(s).

OWRD

TWP	RNG	MER	SEC	QQ	GLOT	DLC	MEASURED DISTANCES
2S	3W	W.M.	35	NW/NW		45	345' West and 1380'South from the NW Corner of Section 35

Reminder: The map associated with this claim must identify Donation Land Claims (DLC), Government Lots (GLOT), and Quarter-Quarters (QQ).

**B. Diversion and Delivery System Information**

Provide the following information concerning the diversion and delivery system. Information provided must describe the equipment used to transport the water from the point(s) of diversion to the reservoir.

1. Is a pump used?

YES  NO

If "NO" items 2 through item 5 may be deleted.

2. Pump Information

MANUFACTURER	MODEL	SERIAL NUMBER	TYPE (CENTRIFUGAL, TURBINE OR SUBMERSIBLE)

3. Theoretical Pump Capacity

HORSEPOWER	OPERATING PSI	LIFT FROM SOURCE TO PUMP *IF A WELL, THE WATER LEVEL DURING PUMPING	LIFT FROM PUMP TO PLACE OF USE	TOTAL PUMP OUTPUT (IN CFS)

4. Provide pump calculations:

**5. Measured Pump Capacity (using meter if meter was present and system was operating)**

INITIAL METER READING	ENDING METER READING	DURATION OF TIME OBSERVED	TOTAL PUMP OUTPUT (IN CFS)

Reminder: For pump calculations use the reference information at the end of this document.

**6. Additional notes or comments related to the system:**

RECEIVED

The reservoir fills from natural runoff during the winter months.

DEC 30 2020

OWRD

**C. Gravity Flow Pipe**

(THE DEPARTMENT TYPICALLY USES THE HAZEN-WILLIAM'S FORMULA FOR A GRAVITY FLOW PIPE SYSTEM)

**1. Does the system involve a gravity flow pipe?**

YES  NO

If "NO", items 2 through 4 relating to this section may be deleted.

**2. Complete the table:**

PIPE SIZE	PIPE TYPE	"C" FACTOR	AMOUNT OF FALL	LENGTH OF PIPE	SLOPE	COMPUTED RATE OF WATER FLOW (IN CFS)

**3. Provide calculations:**

**4. If an actual measurement was taken, provide the following:**

DATE OF MEASUREMENT	WHO MADE THE MEASUREMENT	MEASUREMENT METHOD	MEASURED QUANTITY OF WATER (IN CFS)

Attach measurement notes.

**D. Gravity Flow Canal or Ditch**

(THE DEPARTMENT TYPICALLY USES MANNING'S FORMULA FOR CANALS AND DITCHES)

**1. Is a gravity flow canal or ditch used to convey the water as part of the distribution system?**

YES  NO

If "NO", items 2 through 4 relating to this section may be deleted.

**2. Complete the table:**

CANAL OR DITCH TYPE (MATERIAL)	TOP WIDTH OF CANAL OR DITCH	BOTTOM WIDTH OF CANAL OR DITCH	DEPTH	"N" FACTOR	AMOUNT OF FALL	LENGTH OF CANAL/ DITCH	SLOPE	COMPUTED RATE (IN CFS)

**3. Provide calculations:**

**4. If an actual measurement was taken, provide the following:**

DATE OF MEASUREMENT	WHO MADE THE MEASUREMENT	MEASUREMENT METHOD	MEASURED QUANTITY OF WATER (IN CFS)

Attach measurement notes.

**E. Reservoir**

1. Does the reservoir require the submittal of as-built plans and specifications?

**YES**    **NO**

*If "YES", answer item 2; items 3 through 8 relating to this section may be deleted.*

*If "NO", skip items 2; answer items 3 through 8.*

**2. Complete the table:**

HAVE THE DOCUMENTS BEEN SUBMITTED? YES OR NO	WHEN WERE THE DOCUMENTS SUBMITTED?	HAVE THEY BEEN APPROVED BY THE DEPARTMENT?	NUMBER OF ACRE FEET STORED
Yes	7-14-16	Yes	75.9 AF

3. If the reservoir stores less than 9.2 acre-feet of water or if the dam is less than 10 feet in height, and as-built plans and specifications are not required, complete the table and items 4 through 8.

MAXIMUM DEPTH	AVERAGE DEPTH	SURFACE AREA (IN ACRES)	VOLUME (IN ACRE FEET)
25.5'	10.5'	7.71 ac	75.9 AF

**RECEIVED**

**DEC 30 2020**

**OWRD**

## 4. Provide reservoir volume calculations:

## POND VOLUME CLACs using as-built data

	EL	Area sf	Area ac	Δ EL	Vol cf	Vol acft	Vcum acft
top dam	758	468,392	10.753				127.953
				3.3	1,377,152	31.615	
Emerg. Spill	756	405,770	9.315				96.338
				1.30	487,976	11.202	
	754.70	366,245	8.408				85.135
normal pool				0.7	248,923	5.714	
	754	344,963	7.919				79.421
				0.45	153,265	3.518	
	753.55	336,216	7.718				75.902
				1.55	468,719	10.760	
	752	306,087	7.027				65.142
				2	574,670	13.193	
	750	268,583	6.166				51.950
				2	504,707	11.586	
	748	236,124	5.421				40.363
				2	441,126	10.127	
	746	205,002	4.706				30.236
				2	376,823	8.651	
	744	171,821	3.944				21.586
				2	307,311	7.055	
	742	135,490	3.110				14.531
				2	235,318	5.402	
740	99,828	2.292				9.128	
			2	171,202	3.930		
738	71,374	1.639				5.198	
			2	116,298	2.670		
736	44,924	1.031				2.528	
			2	66,291	1.522		
734	21,367	0.491				1.007	
			2	30,728	0.705		
732	9,361	0.215				0.301	
			2	11,239	0.258		
est. low outlet	730	1,878	0.043				0.043
dead pool				2	1,878	0.043	

See stage – storage curve on sheet 1 of the attached drawings of record.


RECEIVED

DEC 30 2020

5. Provide the following information concerning the physical characteristics of the dam:

CREST WIDTH (W)	DAM HEIGHT AT CENTERLINE (H)	DISTANCE FROM DOWNSTREAM TOP OF DAM TO DOWNSTREAM TOE (L)	DISTANCE FROM UPSTREAM TOP OF DAM TO UPSTREAM TOE (U)	WATER LEVEL AT INSPECTION	DOWN-STREAM SLOPE	UP-STREAM SLOPE
16'	33.54'	130'	105'	753.55'	3:1	3.5:1

Example Dam Profile This box may be deleted from the form

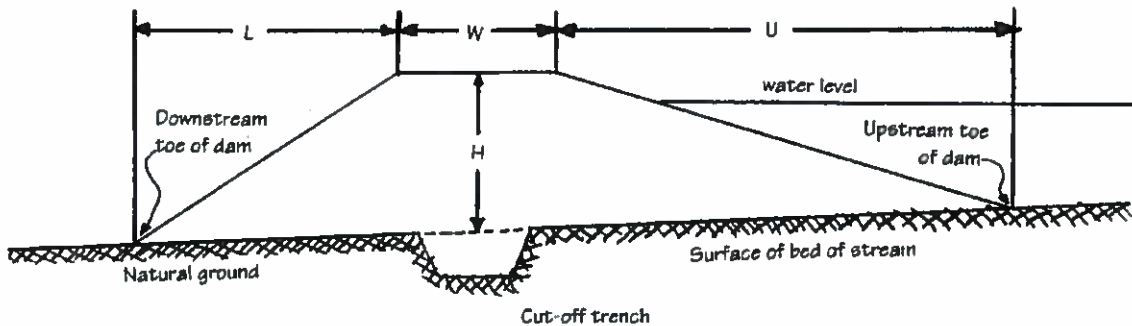

RECEIVED  
DEC 30 2020  
OWRD

6. Provide a drawing showing the cross section of the dam at the maximum section indicating details and dimensions. The drawing should be drawn at a standard even scale.

See attached drawings of record submitted to Dam Safety in 2016, sheet 2 of 4.


7. Describe the outlet works (size and type of the outlet conduit and location):

The primary outlet pipe is a 24" cmp encased in concrete, this runs from the stand pipe under the embankment out to the toe of the embankment at -4.53% slope. The stand pipe is a 30" cmp with the joint of the pipes encased in concrete with reinforcing rebar. The drain pipe is a 8" cmp that runs from the 8" gate valve at the upstream toe down through the embankment to the base of the stand pipe at 1.0% slope. See attached drawings of record, sheet 2 of 4.

The emergency spillway starts with a 10' wide grass lined trench with 3 to 1 cut side slopes. The start cimbs at 2.5% then levels off for a 30 foot long earthen weir, then drops at -1% where it enters a system of three 24" cmp culverts at a slope of -1.7% under the all season road that goes across the dam. The spillway below the dam has a 13 foot rip-rap pad at a slope of -2.1% then 32 feet at 0% slope. The final spillway length is at -6% and to daylight and is clear of the dam toe. See attached drawings of record, sheet 3 of 4.

**8. Describe the emergency spillway (dimensions and location):**

BOTTOM WIDTH (W)	TOP WIDTH (L)	SPILLWAY DEPTH (H)
10'	10'-40'	0'-4'

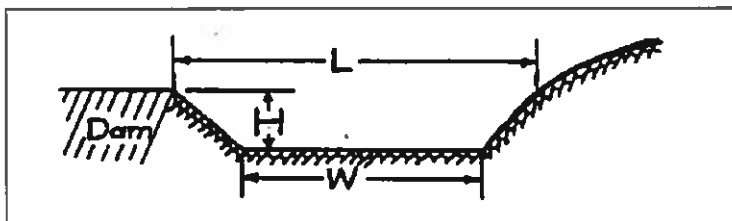

RECEIVED

DEC 30 2020

OWRD

**SECTION 5  
CONDITIONS**

**RECEIV**

**DEC 30 20**

**OWRC**

All conditions contained in the permit, permit amendment, or any extension final order shall be addressed. Reports that do not address all performance related conditions will be returned.

**1. Time Limits:**

Permits and any extension final orders contain any or all of the following dates; the date when the actual construction work was to begin, the date when the construction was to be completed, and the date when the complete application of water to the proposed was to be completed. These dates may be referred to as ABC dates. Describe how the water user has complied with each of the development timelines established in the permit or extension final order:

	DATE FROM PERMIT	DATE ACCOMPLISHED*	DESCRIPTION OF AGTIONS TAKEN BY WATER USER TO COMPLY WITH THE TIME LIMITS
ISSUANCE DATE	12-14-2016		
BEGIN CONSTRUCTION (A)	12-14-2021	8-29-2016	The owners complied with the condition by constructing the dam.
COMPLETE CONSTRUCTION (B)	N/A	11-17-2016	Dam Safety final inspection, the owners complied with condition.
COMPLETE APPLICATION OF WATER (C)	12-14-2021	2-6-2017	The owners complied with the condition by storing water.

\* must be within period between permit or any extension final order issuance and the date to completely apply water

**2. Is there an extension final order(s)?**

YES  NO

**3. Measurement Conditions:**

a. Does the permit, permit amendment, or any extension final order require the installation of a meter or approved measuring device?

YES  NO

*If "NO", items b through f relating to this section may be deleted.*

Reminder: If a meter or approved measuring device was required, the COBU map must indicate the location of the device in relation to the point of diversion or appropriation.

b. Has a meter been installed?

YES  NO

c. Meter Information

POD/POA NAME OR #	MANUFACTURER	SERIAL #	CONDITION (WORKING OR NOT)	CURRENT METER READING	DATE INSTALLED

*If a meter has been installed, items d through f relating to this section may be deleted.*

d. If a meter has not been installed, has a suitable measuring device been installed and approved by the Department?

YES  NO

e. If "YES", provide a copy of the letter approving the device, if available. If the letter is not available provide the name and title of the Water Resources Department employee approving the measuring device, and the approximate date of the approval:

NAME	TITLE	APPROXIMATE DATE
Joel Plahn	Water Master	6-6-2016

f. Measurement Device Description

DEVICE DESCRIPTION	CONDITION (WORKING OR NOT)	DATE INSTALLED
Gate valve stem support elevations	Working	11-8-2017

**Note: The first fill was done while using the approved gate valve stem as the staff gage, the owners later installed a typical staff gage.**

4. Recording and reporting conditions

a. Is the water user required to report the water use to the Department?  YES  NO

*If "NO", item b relating to this section may be deleted.*

b. Have the reports been submitted?  YES  NO

*If the reports have not been submitted, attach a copy of the reports if available.*

5. Outlet Pipe

a. Is the water user required to install a minimum 8" outlet pipe/conduit?  YES  NO

*If "NO", items b through c relating to this section may be deleted.*

b. Has the outlet pipe been installed?  YES  NO

*If "YES", items c relating to this section may be deleted.*

c. Does the water user have other means to evacuate the reservoir?  YES  NO

DESCRIBE HOW THE WATER USER PLANS TO EVACUATE THE RESERVOIR	HAS THIS PLAN BEEN APPROVED BY THE DEPARTMENT?	BY WHOM?
	YES NO	

6. Fish Screening

a. Are any points of diversion required to be screened to prevent fish from entering the point of diversion?  YES  NO

*If "NO", items b through e relating to this section may be deleted.*

**Reminder: If fish screening devices were required, the COBU map must indicate their location in relation to the point of diversion.**

b. Has the fish screening been installed?  YES  NO

RECEIVED

DEC 30 2020

OWRD



c. When was the fish screening installed?

DATE	BY WHOM

**Reminder: If the permit or transfer final order was issued on or after February 1, 2011, the fish screen is required to be approved by the Oregon Department of Fish and Wildlife regardless of the rate of diversion.**

d. If the diversion involves a pump and the total diversion rate of all rights at the point of diversion is less than 225 gpm (0.5 cfs):

Has the self-certification form previously been submitted to the Department?  NA  YES  NO

- If not, go to <https://www.oregon.gov/OWRD/Forms/Pages/default.aspx> (search for ODFW Small Pump Screen Self Certification), complete and attach a copy of the self-certification form to this claim, and send a copy of it to the Oregon Department of Fish and Wildlife (ODFW).

**Reminder: Failure to submit evidence of a timely installed fish screen may result in an unfavorable determination. The ODFW self certification form needs to have been previously submitted or be attached to this form.**

e. If the diversion does not involve a pump or the total diversion rate of all rights at the point of diversion is 225 gpm (0.5 cfs) or greater:

- Has the ODFW approval been previously submitted?  NA  YES  NO
- If not, contact and work with ODFW to ensure compliance. To demonstrate compliance, provide signed documentation from ODFW. A form is available at <https://www.oregon.gov/OWRD/Forms/Pages/default.aspx>

**Reminder: Failure to submit evidence of a timely installed fish screen may result in an unfavorable determination. In order to receive a favorable approval, the ODFW/WRD "Fish Screen Inspection" form needs to have been previously submitted or be attached to this form.**

**7. By-pass Devices**

a. Are any points of diversion required to have a by-pass device to prevent fish from entering the point of diversion? YES  NO

*If "NO", items b and c relating to this section may be deleted.*

**Reminder: If by-pass devices were required, the COBU map must indicate their location in relation to the point of diversion.**

b. Have by-pass device been installed? YES  NO

c. Describe the diversion works as related to whether a by-pass device is installed or unnecessary:

(Provide a letter from ODFW indicating the device is approved or is unnecessary. If there is no letter from ODFW, explain whether or not a by-pass device is necessary.)

**RECEIVED**  
**DEC 30 2020**  
**OWRD**

DESCRIPTION (E.G. "ODFW HAS APPROVED THE BY-PASS DEVICE" OR "NO BY-PASS DEVICE IS NECESSARY BECAUSE THERE IS A DIRECT DIVERSION FROM THE STREAM VIA A PUMP ON RIVER LEFT STREAM BANK WITH FOOT VALVE DESCENDING DIRECTLY INTO NATURAL POOL.") IN ADDITION, YOU MAY ATTACH PHOTOS TO THIS CLAIM.	IF INSTALLED (DATE)	IF INSTALLED, BY WHOM
<b>No by-pass device required. Direct runoff into reservoir.</b>		

**8. Other conditions required by permit, permit amendment final order, or extension final order**

- a. Was the water user required to restore the riparian area if it was disturbed?  YES  NO
- b. Was a fishway required?  YES  NO
- c. Was submittal of a letter from an engineer required prior to storage of water?  YES  NO
- d. Was submittal of a water management and conservation plan required?  YES  NO
- e. Other conditions?  YES  NO

If "YES" to any of the above, identify the condition and describe the water user's actions to comply with the condition(s):

- a) **The riparian area disturbance was restored. In addition the owners are working with other agencies to improve stream habitat.**
- b) **The permit required a fishway unless the ODFW granted a fish passage waiver. See attached document signed by Tom Murtagh of ODFW on February 3<sup>rd</sup> 2014.**
- c) **The letter from the engineer was submitted. See attached copy of 'Report of Record'.**
- d) **Other conditions, The permittee shall maintain the grass-lined channel for the spillway. The owners are aware of this condition and aware that this is important in the event of a major rain event.**

**SECTION 6**

**ATTACHMENTS**

**RECEIVED**

**DEC 30 2020**

**OWRD**

Provide a list of any additional documents you are attaching to this report:

ATTACHMENT NAME	DESCRIPTION

**SECTION 7****CLAIM OF BENEFICIAL USE MAP**

The Claim of Beneficial Use Map must be submitted with this claim. Claims submitted without the Claim of Beneficial Use map will be returned. The map shall be submitted on poly film at a scale of 1" = 1320 feet, 1" = 400 feet, or the original full-size scale of the county assessor map for the location.

Provide a general description of the survey method used to prepare the map. Examples of possible methods include, but are not limited to, a traverse survey, GPS, or the use of aerial photos. If the basis of the survey is an aerial photo, provide the source, date, series and the aerial photo identification number.

**The map was started with a survey of the boundary of the Hollis property. The boundary was copied into an Autocad drawing. The tax maps were inserted into the drawing and scaled to match the perimeter survey. Google air photos were downloaded, inserted and scaled to match the tax maps. USGS topo maps were downloaded, inserted and scaled to match the tax maps. The location of the dam and the shape of the reservoir were determined by the air photo.**

**Map Checklist****RECEIVED**

Please be sure that the map you submit includes ALL the items listed below.  
(Reminder: Incomplete maps and/or claims may be returned.)



**DEC 30 2020****OWRD**

- Map on polyester film.
- Appropriate scale (1" = 400 feet, 1" = 1320 feet, or the original full-size scale of the county assessor map)
- Township, Range, Section, Donation Land Claims, and Government Lots
- If irrigation, number of acres irrigated within each projected Donation Land Claims, Government Lots, Quarter-Quarters
- Locations of fish screens and/or fish by-pass devices in relationship to point of diversion
- Locations of meters and/or measuring devices in relationship to point of diversion
- Conveyance structures illustrated (pumps, reservoirs, pipelines, ditches, etc.)
- Point(s) of diversion or appropriation (illustrated and coordinates)
- Tax lot boundaries and numbers
- Source illustrated if surface water
- Disclaimer ("This map is not intended to provide legal dimensions or locations of property ownership lines")
- Application and permit number or transfer number
- North arrow
- Legend
- CWRE stamp and signature

# CLAIM OF BENEFICIAL USE MAP


TL3400, S26; TL 1300, 1301, 1200 S35; T2S, R3W, WM  
YAMHILL COUNTY, OREGON. WILLAMETTE RIVER BASIN

APPLICATION R-87985,  
PERMIT R-15182,  
IN THE NAME OF  
HOLLIS LAND AND TIMBER LLC

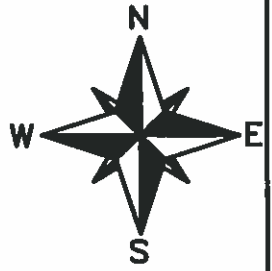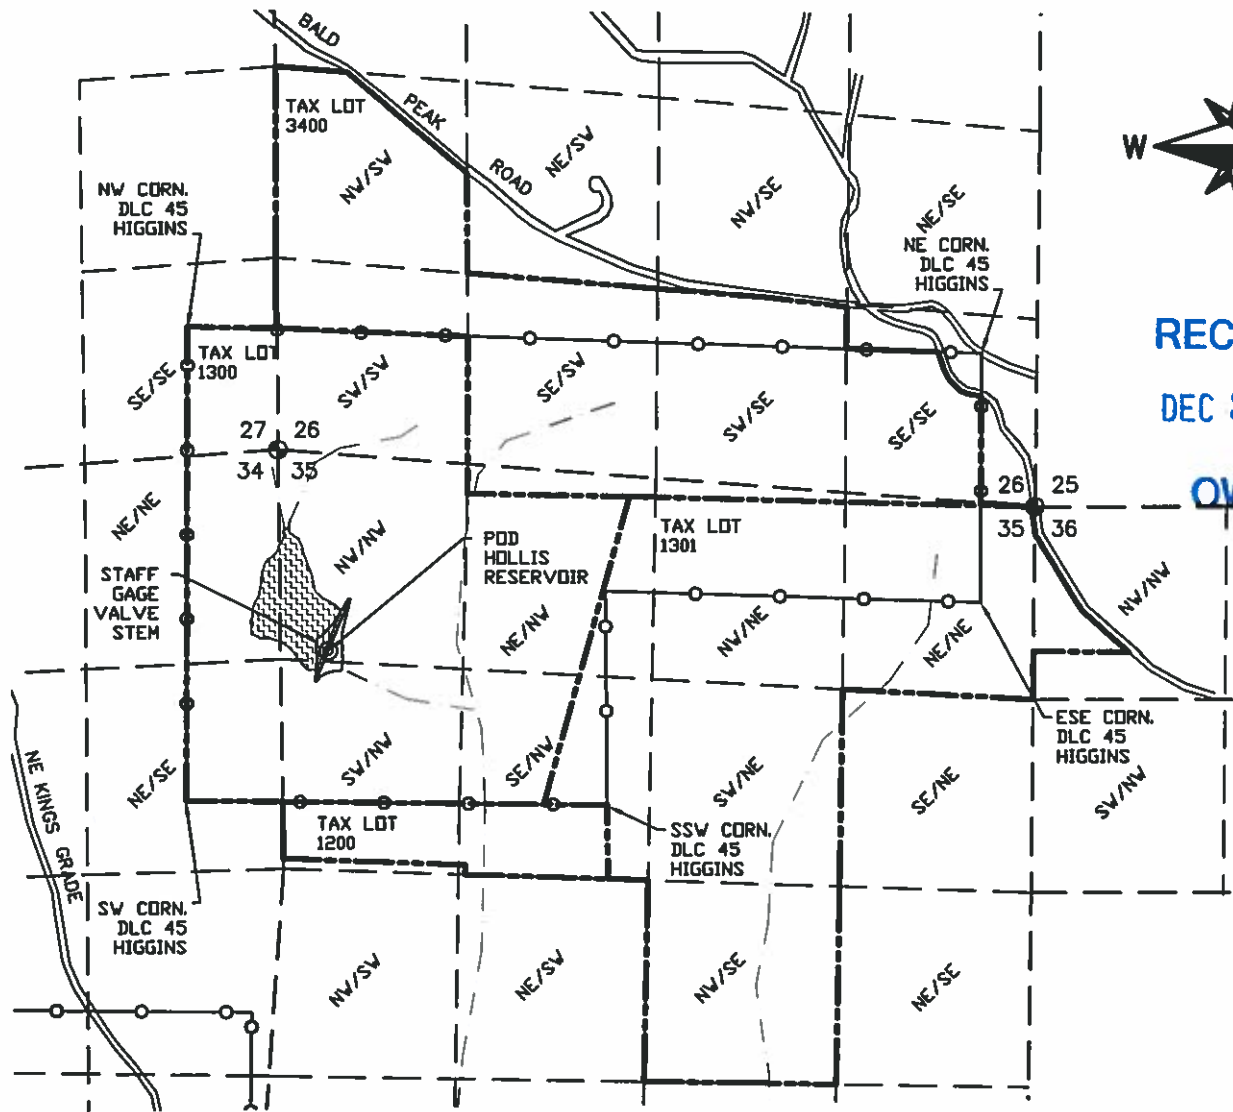

RECEIVED  
DEC 30 2020

OWRD

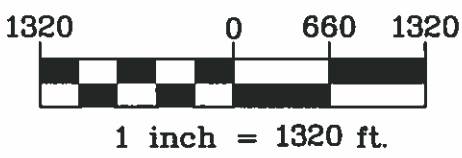


POD HOLLIS DAM LOCATED  
345' WEST AND 1380' SOUTH  
OF NW CORN. SEC. 35

LEGEND	
POD	⊙
GOV. CORNER	⊕
PROPERTY LINE	— — — — —
DLC LINE	○ — ○ — ○ — ○
1/4-1/4 LINES	- - - - -
CREEK LINES	~ ~ ~ ~ ~
ROAD LINES	⎓ ⎓ ⎓

THIS MAP WAS PREPARED FOR THE PURPOSE OF IDENTIFYING THE LOCATION OF A WATER RIGHT ONLY AND IS NOT INTENDED TO PROVIDE LEGAL DIMENSIONS OR LOCATION OF PROPERTY OWNERSHIP LINES.

2318-B PACIFIC AVENUE  
FOREST GROVE, OR 97116  
PHONE: 503-357-5717

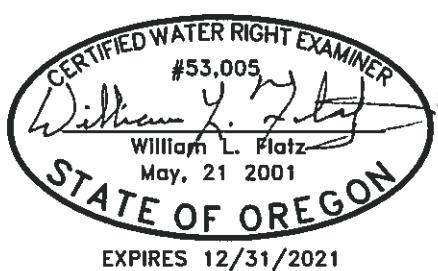

MAP BASE:  
TAX MAPS; 2-3-35, 2-3-26  
AND 2-3-34.  
GOOGLE EARTH AERIAL PHOTO





Project: 320-022  
Drawing: Hollis Res COBU.dwg  
By: WLF  
Checked by: WLF  
Date: 11-13-20


# CLAIM OF BENEFICIAL USE MAP

TL3400, S26; TL 1300, 1301, 1200 S35; T2S, R3W, WM  
YAMHILL COUNTY, OREGON. WILLAMETTE RIVER BASIN

APPLICATION R-87985,  
PERMIT R-15182,  
IN THE NAME OF  
HOLLIS LAND AND TIMBER LLC

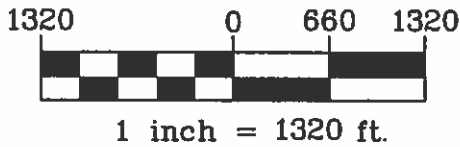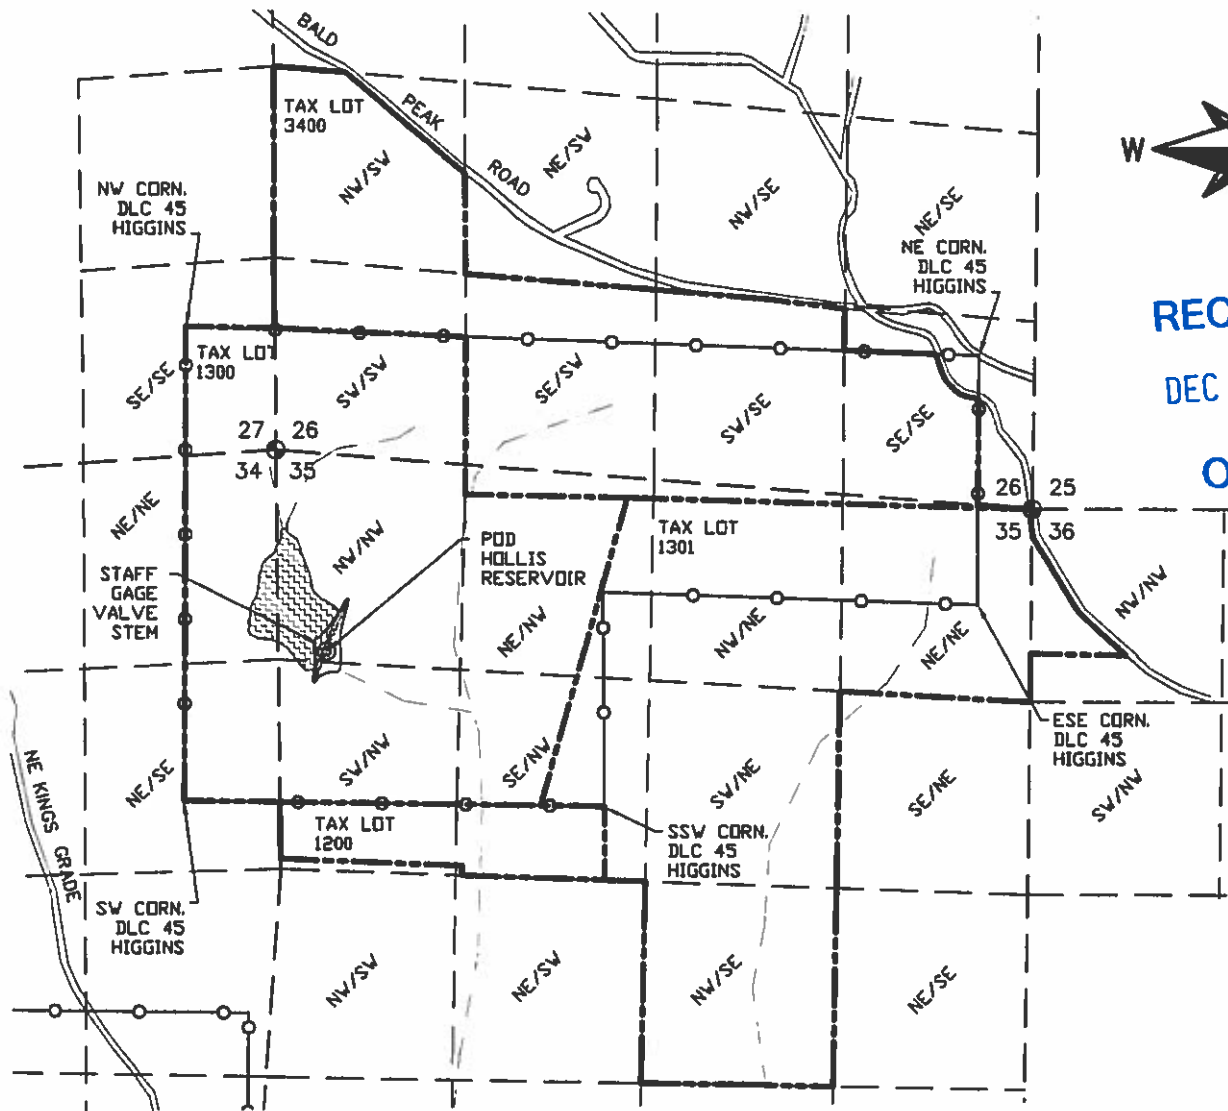

POD HOLLIS DAM LOCATED  
345' WEST AND 1380' SOUTH  
OF NW CORN. SEC. 35

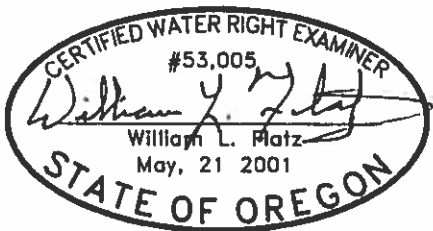

LEGEND	
POD	⊙
GOV. CORNER	⊕
PROPERTY LINE	-----
DLC LINE	○-----○
1/4-1/4 LINES	- - - - -
CREEK LINES	- - - - -
ROAD LINES	~~~~~

MAP BASE:  
TAX MAPS; 2-3-35, 2-3-26  
AND 2-3-34.  
GOOGLE EARTH AERIAL PHOTO

THIS MAP WAS PREPARED FOR  
THE PURPOSE OF IDENTIFYING  
THE LOCATION OF A WATER  
RIGHT ONLY AND IS NOT  
INTENDED TO PROVIDE LEGAL  
DIMENSIONS OR LOCATION OF  
PROPERTY OWNERSHIP LINES.

2318-B PACIFIC AVENUE  
FOREST GROVE, OR 97116  
PHONE: 503-357-5717





Project: 320-022  
Drawing: Hollis Res COBU.dwg  
By: WLF  
Checked by: WLF  
Date: 11-13-20


# CLAIM OF BENEFICIAL USE MAP

TL3400, S26; TL 1300, 1301, 1200 S35; T2S, R3W, WM  
YAMHILL COUNTY, OREGON. WILLAMETTE RIVER BASIN

APPLICATION R-87985,  
PERMIT R-15182,  
IN THE NAME OF  
HOLLIS LAND AND TIMBER LLC

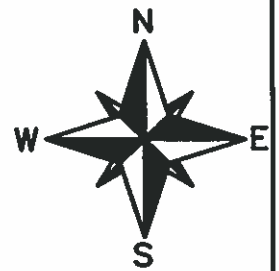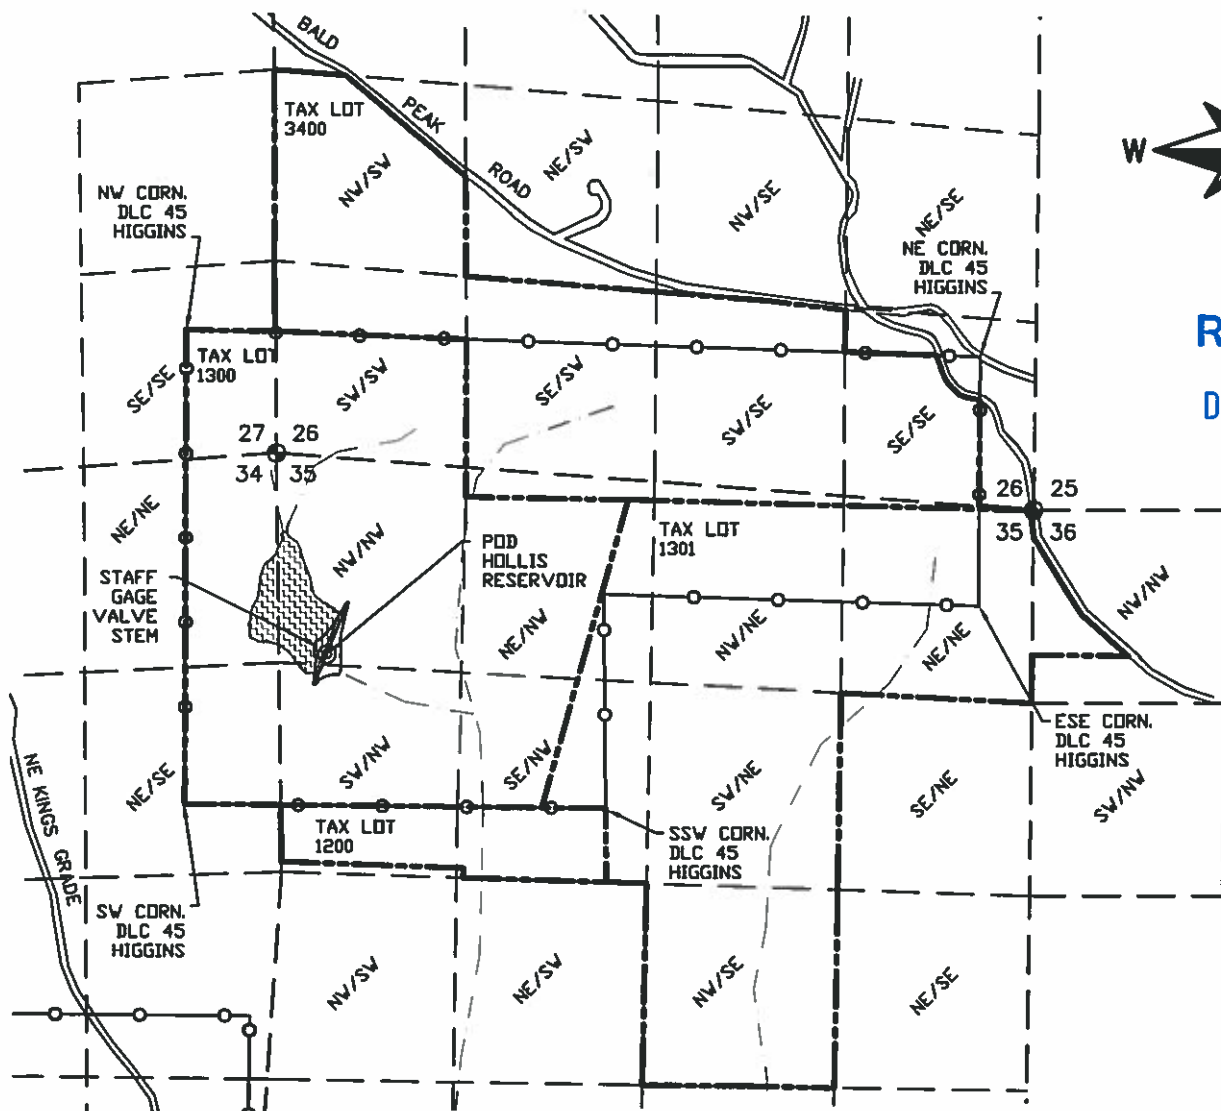


RECEIVED  
DEC 30 2020  
OWRD

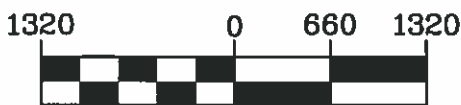

1 inch = 1320 ft.

POD HOLLIS DAM LOCATED  
345' WEST AND 1380' SOUTH  
OF NW CORN. SEC. 35

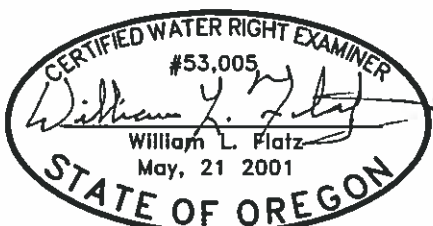

EXPIRES 12/31/2021

LEGEND	
POD	⊗
GOV. CORNER	⊕
PROPERTY LINE	— — — — —
DLC LINE	○ — ○ — ○ — ○
1/4-1/4 LINES	- - - - -
CREEK LINES	~ ~ ~ ~ ~
ROAD LINES	— — — — —

MAP BASE:  
TAX MAPS; 2-3-35, 2-3-26  
AND 2-3-34.  
GOOGLE EARTH AERIAL PHOTO

THIS MAP WAS PREPARED FOR  
THE PURPOSE OF IDENTIFYING  
THE LOCATION OF A WATER  
RIGHT ONLY AND IS NOT  
INTENDED TO PROVIDE LEGAL  
DIMENSIONS OR LOCATION OF  
PROPERTY OWNERSHIP LINES.

2318-B PACIFIC AVENUE  
FOREST GROVE, OR 97116  
PHONE: 503-357-5717



Project: 320-022  
Drawing: Hollis Res COBU.dwg  
By: WLF  
Checked by: WLF  
Date: 11-13-20

**RECEIVED**

**DEC 30 2020**

**OWRD**

## **Attachments for:**

**Claim of Beneficial Use  
Application R-87985, Permit R-15182**

### **INDEX**

**Paper copy of COBU Map, pages 1, page 1**

**Paper copy of Permit, pages 5, page 2**

**Permit Map, 1 pages, page 7**

**ODFW Field Evaluation, 2 pages, page 8**

**Hollis Reservoir Engineers letter, 3 pages, page 10**

**Copy of email from Watermaster approving valve stem, 1 pages, page 13**

**Copy of water use reporting, 1 pages, page 14**



**Paper copy of 'Drawings of Record', 4 pages, page 15**

**Prepared for Hollis Land & Timber by:  
Stutzner Engineering & Forestry  
2318-B Pacific Avenue  
Forest Grove, OR 97116  
Office phone 503-357-5717  
billflatz@stutzner.com**


# CLAIM OF BENEFICIAL USE MAP

TL3400, S26; TL 1300, 1301, 1200 S35; T2S, R3W, WM  
YAMHILL COUNTY, OREGON. WILLAMETTE RIVER BASIN

APPLICATION R-87985,  
PERMIT R-15182,  
IN THE NAME OF  
HOLLIS LAND AND TIMBER LLC

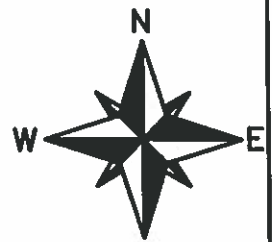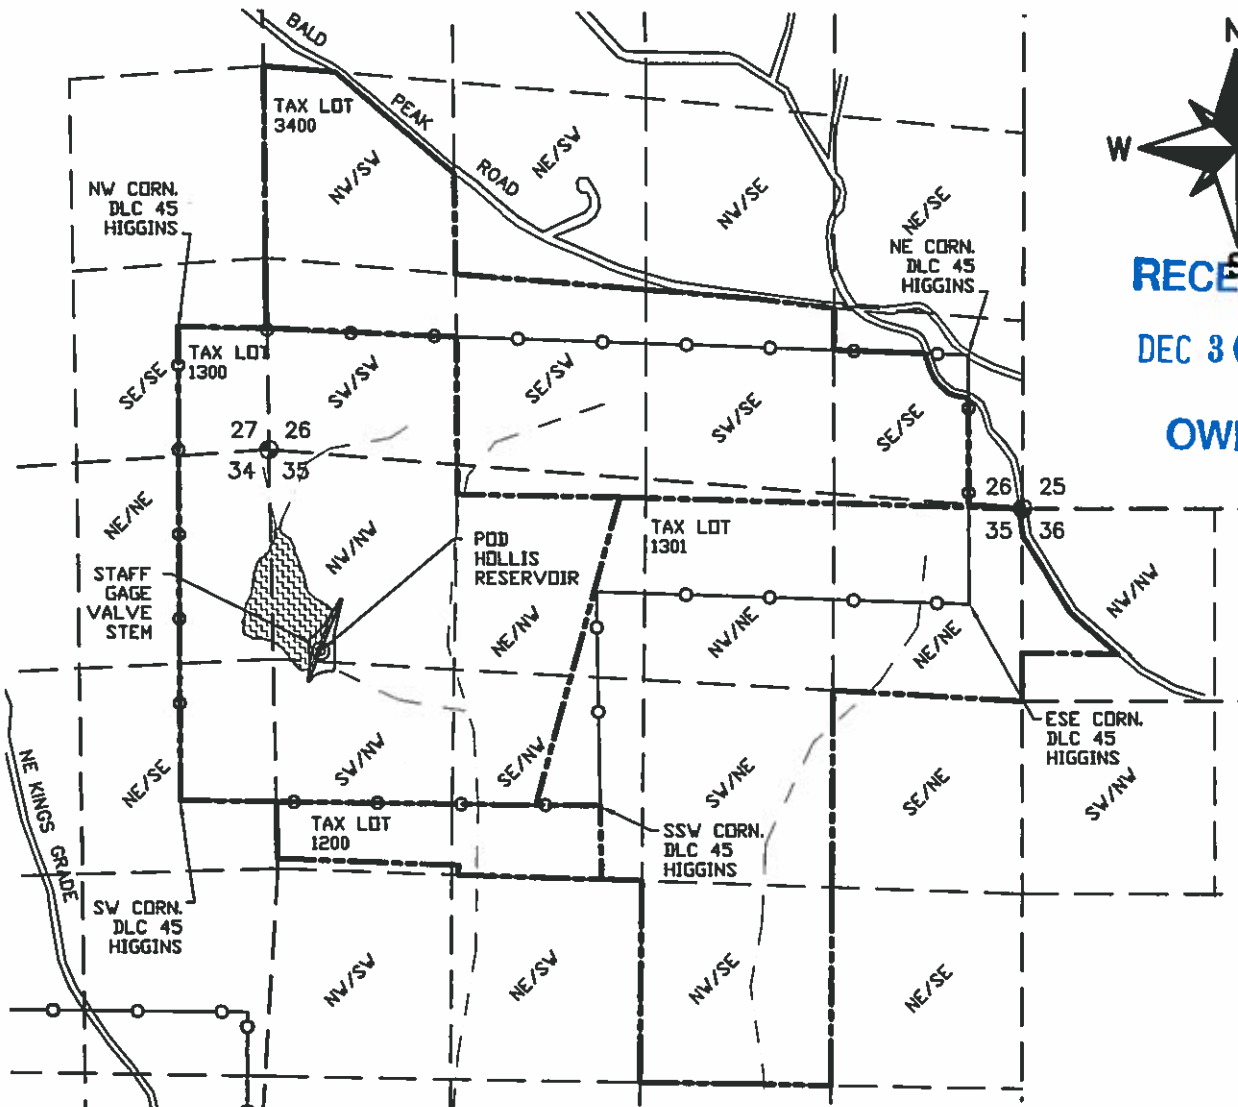

**RECEIVED**  
**DEC 30 2020**  
**OWRD**

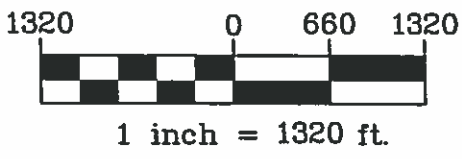


LEGEND	
POD	⊙
GOV. CORNER	⊕
PROPERTY LINE	---
DLC LINE	—○—○—○—
1/4-1/4 LINES	- - -
CREEK LINES	~ ~ ~
ROAD LINES	—

THIS MAP WAS PREPARED FOR THE PURPOSE OF IDENTIFYING THE LOCATION OF A WATER RIGHT ONLY AND IS NOT INTENDED TO PROVIDE LEGAL DIMENSIONS OR LOCATION OF PROPERTY OWNERSHIP LINES.

POD HOLLIS DAM LOCATED 345' WEST AND 1380' SOUTH OF NW CORN. SEC. 35

2318-B PACIFIC AVENUE  
FOREST GROVE, OR 97116  
PHONE: 503-357-5717

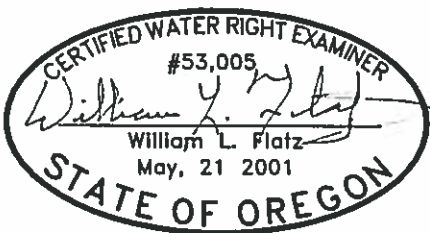

MAP BASE:  
TAX MAPS; 2-3-35, 2-3-26  
AND 2-3-34.  
GOOGLE EARTH AERIAL PHOTO

Project: 320-022  
Drawing: Hollis Res COBU.dwg  
By: WLF  
Checked by: WLF  
Date: 11-13-20

EXPIRES 12/31/2021



RECEIVED

DEC 30 2020

STATE OF OREGON

COUNTY OF YAMHILL

OWRD

PERMIT TO CONSTRUCT A RESERVOIR AND STORE THE PUBLIC WATERS

THIS PERMIT IS HEREBY ISSUED TO

HOLLIS LAND AND TIMBER LLC  
13984 CHELSEA DR  
LAKE OSWEGO, OR 97035

The specific limits and conditions of the use are listed below.

APPLICATION FILE NUMBER: R-87985

SOURCE OF WATER: UNNAMED STREAM, A TRIBUTARY OF BRYAN CREEK

STORAGE FACILITY: HOLLIS RESERVOIR

PURPOSE OR USE OF THE STORED WATER: STORAGE FOR IRRIGATION,  
AESTHETICS, FIRE PROTECTION, RECREATION, AND WILDLIFE

MAXIMUM VOLUME: 100.0 ACRE FEET

WATER MAY BE APPROPRIATED FOR STORAGE DURING THE PERIOD: NOVEMBER 1  
THROUGH JUNE 30

DATE OF PRIORITY: JUNE 11, 2014

THE MAXIMUM HEIGHT OF THE DAM SHALL NOT EXCEED 38.0 FEET

DAM LOCATION: SW  $\frac{1}{4}$  NW  $\frac{1}{4}$ , SECTION 35, T2S, R3W, W.M.; 1370 FEET SOUTH AND  
340 FEET EAST FROM NW CORNER, SECTION 35

THE AREA TO BE SUBMERGED BY THE RESERVOIR IS LOCATED AS FOLLOWS:

NE  $\frac{1}{4}$  NE  $\frac{1}{4}$   
SECTION 34

NW  $\frac{1}{4}$  NW  $\frac{1}{4}$   
SW  $\frac{1}{4}$  NW  $\frac{1}{4}$   
SECTION 35

TOWNSHIP 2 SOUTH, RANGE 3 WEST, W.M.

Application R-87985 Water Resources Department

PERMIT R-15182

RECEIVED

DEC 30 2020

OWRD

Page 2

Measurement devices, and recording/reporting of annual water storage conditions:

- A. Before water use may begin under this permit, a staff gage that measures the entire range and stage between full reservoir level and dead-pool storage must be installed in the reservoir. If no dead-pool, the gage must measure the full depth of the reservoir. The permittee shall maintain the device in good working order.
- B. The permittee shall allow the watermaster access to the device; provided however, where any device is located within a private structure, the watermaster shall request access upon reasonable notice.
- C. The permittee shall keep a complete record of the volume of water stored each month, and shall submit a report which includes water-storage measurements to the Department annually or more frequently as may be required by the Director. Further, the Director may require the permittee to report general water-use information, including the place and nature of use of water under the permit.
- D. The Director may provide an opportunity for the permittee to submit alternative measuring and reporting procedures for review and approval.

The storage of water allowed herein is subject to the installation and maintenance of an outlet pipe (with a minimum diameter of 8" for any in-channel reservoir). This requirement may be waived if the Department determines other means have been provided to evacuate water when necessary.

The permittee shall pass all live flow outside the storage season described above.

The Director may require the user to measure inflow and outflow, above and below the reservoir respectively, to ensure that live flow is not impeded outside the storage season. Measurement devices and their implementation must be acceptable to the Director, and the Director may require that data be recorded on a specified periodic basis and reported to the Department annually or more frequently.

This permit allows an annual appropriation (not to exceed the specified volume). This permit does not provide for the appropriation of water for out-of-reservoir uses, the maintenance of the water level, or

DEC 30 2020

OWRD

Page 3

maintaining a suitable freshwater condition. If any water is to be used for out-of-reservoir purposes, a secondary water right is required. If any additional live flow is to be appropriated to maintain either the water level or a suitable freshwater condition, an additional water right is required.

The permittee shall not construct, operate or maintain any dam or artificial obstruction to fish passage in the channel of the subject stream without providing a fishway to ensure adequate upstream and downstream passage for fish, unless the permittee has requested and been granted a fish passage waiver by the Oregon Fish and Wildlife Commission. The permittee is hereby directed to contact an Oregon Department of Fish and Wildlife Fish Passage Coordinator, before beginning construction of any in-channel obstruction.

Notwithstanding that Oregon Department of Fish and Wildlife has made a determination that fish screens are not necessary at the time of permit issuance, the permittee may be required in the future to install, maintain, and operate fish-screening devices to prevent fish from entering the proposed diversion.

The permittee shall maintain the grass-lined channel for the spillway.

If reservoir construction is greater to or equal to 1.0 acre in extent, permittee must contact Department of Environmental Quality (DEQ) (Kristy Sewell 541-686-7858) to determine if a DEQ 1200 C permit is required.

#### DAM CONDITIONS

All construction shall be performed under the supervision of the engineer of record. If the engineer of record cannot supervise construction, the Water Resources Department Dam Safety Engineer must be notified in writing, prior to construction activity, with the name of the engineer supervising construction.

No embankment fill shall be placed until preparation of the foundation and the excavation of the core trench has been completed and examined in entirety by the engineer of record, or by the Water Resources Dam Safety Engineer, or both.

The constructed works shall conform to the approved plans and specifications on file with the Water Resources Dam Safety Program. The engineer of record shall notify the Water Resources Dam Safety Program before making any significant change to the approved design prior to or during construction.

RECEIVED

DEC 30 2020

OWRD

Page 4

No water shall be stored until the Water Resources Department receives written confirmation from the engineer of record that construction has been completed as demonstrated by "as-built" drawings submitted by the engineer of record. A revised reservoir capacity graph must accompany the engineer's letter of completion.

Routine maintenance shall be completed as described 690-020-0250. This includes, but is not limited to, brush and tree removal and mowing or other control of other vegetation on the embankment and spillway; removal of burrowing animals and filling burrows; control of surface erosion; maintenance of freeboard and adequate crest width; ensuring nothing reduces spillway capacity; at least annual cycling of all valves, with lubrication as necessary; and ensuring cracked concrete structures have been properly patched, sealed, caulked, or replaced to prevent deterioration.

The spillway shall not be altered without written approval from the State Engineer.

Routine repair or replacement of defective or worn out equipment (including but not limited to gates, valves, and conduits) shall be completed when operation of gates or valves becomes difficult, or if there is potential for water leakage, or other condition affecting the safety of the structure.

The dam shall not be modified to increase water storage or reduce safety of the dam. Any modification that would increase storage shall require a new water right, design by an engineer, and approval by the State Engineer.

No valve shall be installed at the downstream end of the low level conduit, and the low level conduit shall not be operated in a pressurized condition unless approved plans and specifications include specifics for pressurized operations, including an operations manual and special inspections as necessary, of pressurized conduits for the dam.

Any new or muddy leakage, overtopping of the dam, or other emergency condition shall be immediately reported to the State Engineer.

#### STANDARD CONDITIONS

Failure to comply with any of the provisions of this permit may result in action including, but not limited to, restrictions on the use, civil penalties, or cancellation of the permit.

DEC 30 2020

OWRD

Page 5

If the riparian area is disturbed in the process of developing a point of diversion, the permittee shall be responsible for restoration and enhancement of such riparian area in accordance with ODFW's Fish and Wildlife Habitat Mitigation Policy OAR 635-415. For purposes of mitigation, the ODFW Fish and Wildlife Habitat Mitigation Goals and Standards, OAR 635-415, shall be followed.

The use may be restricted if the quality of the source stream or downstream waters decreases to the point that those waters no longer meet state or federal water quality standards due to reduced flows.

This permit is for the beneficial use of water without waste. The water user is advised that new regulations may require the use of best practical technologies or conservation practices to achieve this end.

By law, the land use associated with this water use must be in compliance with statewide land-use goals and any local acknowledged land-use plan.


The use of water allowed herein may be made only at times when sufficient water is available to satisfy all prior rights, including prior rights for maintaining instream flows.

Construction of the water system shall begin within five years of the date of permit issuance. The deadline to begin construction may not be extended. This permit is subject to cancellation proceedings if the begin construction deadline is missed.

The permitted volume of water shall be stored within five years of the date of permit issuance. If additional time is needed, the permittee may submit an application for extension of time, which may be approved based upon the merit of the application.

Within one year after storage of water, the permittee shall submit a claim of beneficial use, which includes a map and report, prepared by a Certified Water Rights Examiner.

Issued *DECEMBER 14 2016*



E. Timothy Wallin, Water Rights Program Manager  
for Thomas M. Byler, Director

Application R-87985  
Basin 2

Water Resources Department  
Volume 18 SPRING CR & MISC


PERMIT R-15182  
16

# WATER RIGHTS APPLICATION MAP

TAXLOTS: 3400, SECTION 26; &  
 1300, 1301 & 1200 SECTION 35; T2S, R3W, WM  
 YAMHILL COUNTY, OREGON  
 WILLAMETTE RIVER BASIN

RECEIVED

DEC 30 2020

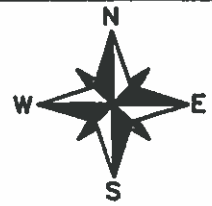


OWRD

RECEIVED BY OWRD

JUN 11 2014

SALEM, OR

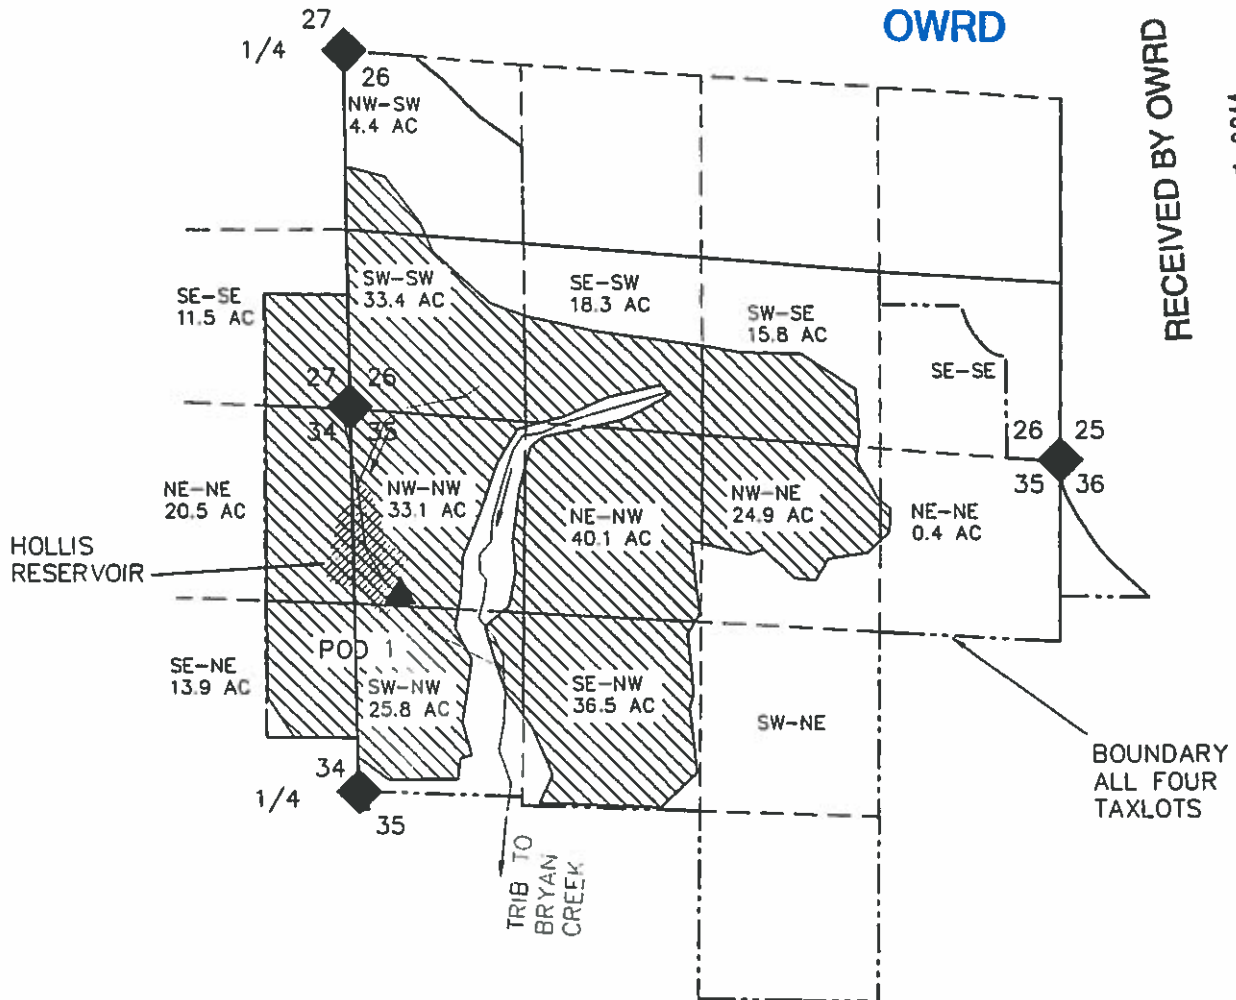

## LEGEND:

◆ SECTION CORNER or 1/4 CORNER

▲ POINT OF DIVERSION (POD)

--- PROPERTY LINE

- - - 1/16TH LINE

 PROPOSED IRRIGATION AREAS

POD 1 IS 1370 FT SOUTH AND 340 FEET EAST OF NE CORNER S35

MAP BASE:  
 COUNTY SURVEY RECORD CSP-10277 AND SITE SPECIFIC AERIAL PHOTO

PREPARED FOR:  
 HOLLIS LAND & TIMBER



Project: 313081  
 Drawing: 3130811J-WRAppl.dwg  
 By: EAU  
 Checked by: EAU  
 Date: 27MAY2014



1 inch = 1320 ft.

THIS MAP WAS PREPARED FOR THE PURPOSE OF IDENTIFYING THE LOCATION OF A WATER RIGHT ONLY AND IS NOT INTENDED TO PROVIDE LEGAL DIMENSIONS OR LOCATION OF PROPERTY OWNERSHIP LINES.

R-07985

LAND SURVEYING PLANNING ENGINEERING WATER RIGHTS FORESTRY GPS & GIS



TELEPHONE (503) 357-5717  
FAX (503) 357-5698  
EMAIL: firstnamelastname@stuntzner.com  
2137 19<sup>th</sup> Avenue  
Forest Grove, OR 97116

RECEIVED

DEC 30 2020

OWRD

COOS BAY - FOREST GROVE - DALLAS - BROOKINGS

ODFW & STUNTZNER FISH PRESENCE FIELD VISIT NOTES

PROJECT NAME: Hollis Lower Dam

OWNER NAME: Hollis Land & Timber, LLC

LATITUDE: 45-21-28.7

LONGITUDE: 123-01-47.5

WGS 84

TAXLOT LOCATION: SECTION 35, T2S, R3W, TAX LOT 1300

WATER RIGHT APPLICATION NUMBERS: N/A

WATER RIGHT PERMIT NUMBERS: N/A

PROJECT DESCRIPTION: Proposed Dam

ATTACHED: WATER RIGHT MAP      USGS MAP  X  PHOTOS  X

RESULTS:

DAM: PASSAGE NEEDED? YES or NO MORE INFO NEEDED? No

DIVERSION: PASSAGE NEEDED? YES or NO MORE INFO NEEDED? No

ODFW COMMENTS & NOTES: Based on a site survey of the project area as defined above, on February 3, 2014, ODFW confirms that native migratory fish are not present in the reach of stream at and above the proposed dam site. Therefore, fish passage will not be required ~~should~~ in association with construction and development of the proposed dam and impoundment.


by Tom Muryag  
ODFW Representative

date 3 Feb 2014  
Field visit

RECEIVED

DEC 30 2020

OWRD

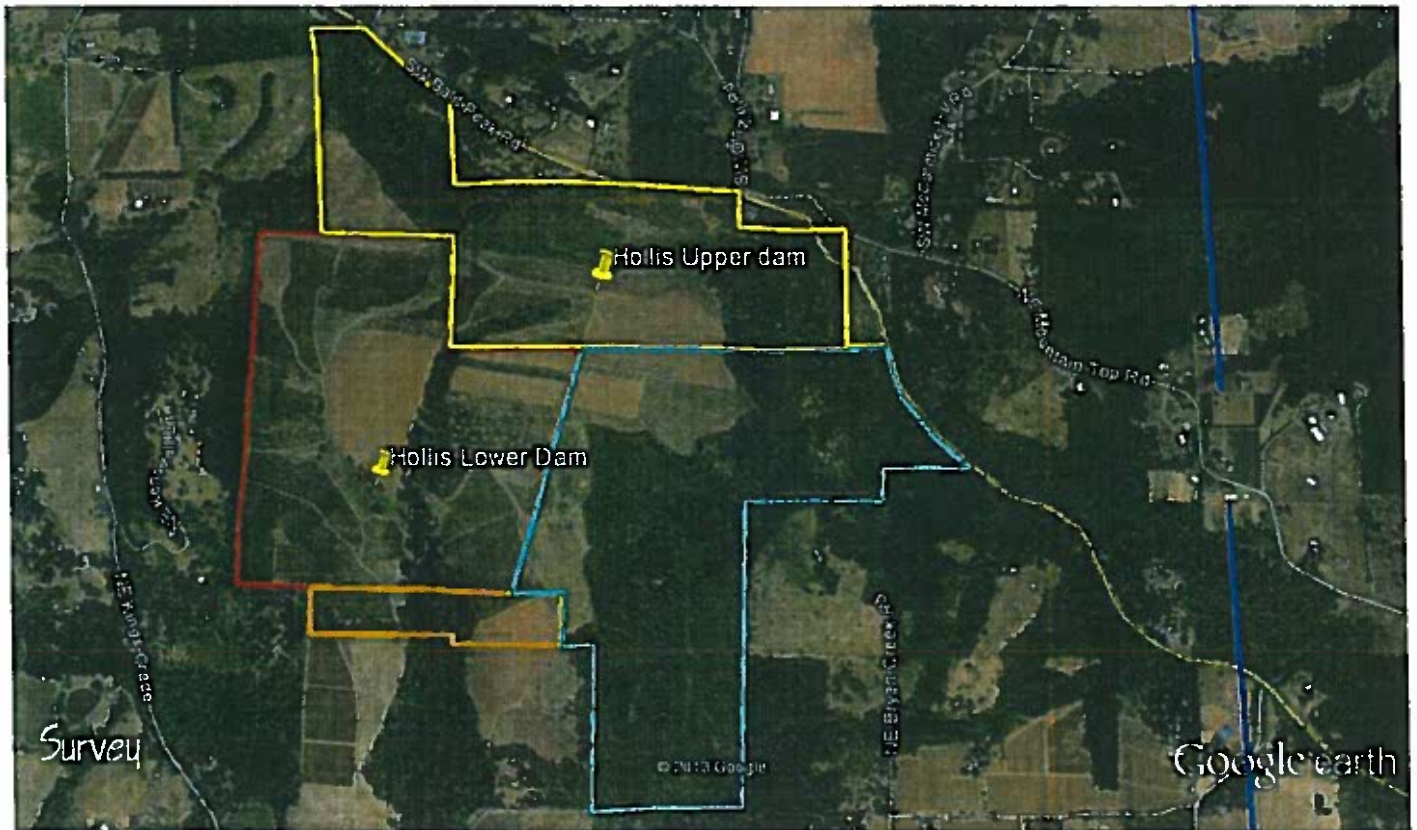

Google earth

miles  
km







TELEPHONE (503) 357-5717  
 CELL (503) 939-8381  
 FAX (503) 357-5698  
 billflatz@stuntzner.com

2137 19<sup>TH</sup> Avenue  
 FOREST GROVE, OREGON 97118

COOS BAY - FOREST GROVE - DALLAS - JUNCTION CITY

## REPORT OF RECORD

### HOLLIS RESERVOIR


for

Hollis Land & Timber, LLC  
 13894 Chelsea Drive  
 Lake Oswego, OR 97035

Property Address:  
 17940 Kings Grade Road  
 Newberg, OR 97132

Property Location:  
 Township 2 South, Range 3 West,  
 Section 26, Tax Lot 1300, W.M.

11-21-16

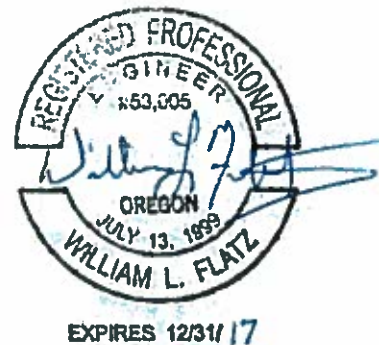

RECEIVED

DEC 30 2020

OWRD

The drawings and specifications for the dam were prepared by Stuntzner Engineering and Forestry, the Forest Grove, Oregon office. The topographic site map for the site drawings was prepared by 3Di, Geoterra Mapping Group. Stuntzner Engineering & Forestry provided the construction stakeout for the dam, construction observation, soil testing, erosion control monitoring and the record drawing topographic survey after the construction work was completed.

The water right Application number for the reservoir is: File # R-87985.  
 The final order was issued approving the permit on September 11<sup>th</sup> 2015.

The construction drawings for this project were revised July 14<sup>th</sup>, 2016, and submitted to Dam Safety, they consist of four 22"x 34" sheets. The drawings and specifications were approved prior to the construction on July 25<sup>th</sup>, 2016 by Oregon Water Resources Department (OWRD) Dam Safety as required for a dam of this height and storage capacity.

The contractor for the project was Pihl Excavating, 41660 NW Sunset Highway, Banks, OR 97106, CCB#121460. Construction observation, field moisture and density testing, and construction staking were provided by Stuntzner Engineering & Forestry.

Construction began on August 29<sup>th</sup>, 2016. On September 2<sup>nd</sup>, 2016 Stuntzner met on site with OWRD's Dam Safety engineer, Keith Mills, and Dam Safety coordinator Tony Janicek. The owner Zach Kramer. From, Kane Environmental in Portland geologist David Rankin. From Pihl Excavating, Matt Pihl, Stuart Wurdinger and Randy Landers. The purpose of this meeting was to inspect the over excavated creek line referred to as the 'muck trench' and the core trench before any material was compacted. Both the core trench and muck trench were approved verbally by OWRD for backfill.

The contractor was experienced in earth moving, grading, and construction of earthen dams. This experience was helpful for this project and the contractor was able to successfully complete the project in a short period of time. The contractor's crew was good to work with and we worked together to monitor the moisture in the borrow material.

The contractor had three self-loading rubber tired scrapers to haul fill. Compaction was performed with two roller compactors, a Cat CP-563E pad foot roller and a Cat 825B sheepsfoot compactor. Also utilized on site were two excavators, two cats, a tractor with a disc, multiple small tractors and a grader. A water truck was utilized for dust control.

Site visits were made every day by the engineer or as requested by the contractor or owner during the embankment construction. A total of 27 site visits were made during 30 day embankment construction period. During the site visits, 53 density and/or moisture tests were performed by the engineer.

Laboratory sampling completed during the design phase adequately reflected most of the borrow materials encountered. There was a small amount of slightly different material within the borrow area. The embankment was constructed with a mix of the materials. I was on site daily and monitored the moisture content and density. The embankment was generally so hard that it was difficult to dig and scrape more than three inches to take a sample. At the end of the construction I started carrying a hand pick to help to dig for the samples.

All of the borrow material for construction of the dam was removed from within the reservoir area. Foundation and borrow area stripping materials were placed in a location west of the reservoir area, on the owner's property.

On November 8<sup>th</sup>, 2016 the installation of the gate valve was completed. The valve is ready to be closed to store water. On November 17<sup>th</sup>, we met on site with the owner Zach Kramer and Tony Janicek with Dam Safety for a final inspection.

The dam was constructed essentially as shown on the drawings and specifications with changes noted below. Drawings of record have been prepared to show the changes made during construction. These drawings are dated 11/21/2016 and labeled 'Drawings of Record'. They consist of four 22"x 34" sheets.

#### CONSTRUCTION CHANGES:

1. While stripping the top soil, multiple wet patches developed along the old drainage channel under the dam footprint. The wet channel was found to have a weak saturated soil that we determined was inadequate to build a dam over. After consulting with David Rankin of Kane Environmental and notifying Dam Safety, we over excavated the weak soils along the channel.
2. The conduits for this dam were not manufactured to the exact specifications. The result is an additional foot of 8" drain conduit, an additional foot of 24" outlet conduit and the normal pool is elevation 753.55' up 0.1' from design.
3. Due to a very long manufacturing and shipping time the specified 8" Waterman gate valve was replaced with an equivalent Fresno 8" gate valve.
4. The contractor forgot to place the specified geotextile fabric under the rip rap at the outlet plunge pool. I did not have them remove the rip rap and place the fabric for the following reasons. First, most of the plunge pool was excavated out then backfilled and compacted with the embankment material we believe that this will not erode. Second, they did such a good job placing the rip rap that I did not want to risk that the second attempt would be as well done. Third, if there is any problem it would be easy to add some smaller rock or place a layer of grout in between the rip rap. We will monitor the first fill of the reservoir and make changes only if needed.

5. The contractors became concerned with the possibility of excessive runoff down a natural chute on the West side of the dam. In order to avoid possible erosion along the toe of the dam we added a diversion ditch above the southwest end of the dam to redirect any runoff from above into the pool side of the dam.

The as-built storage at normal pool elevation 753.55' is 75.90 acre-feet, the pool area is 7.65 acres.

Prepared by,  
*Stuntzner Engineering & Forestry, LLC*

RECEIVED

DEC 30 2020

OWRD



Bill Flatz, PE, GE, CWRE, CESCL

**Nick Blundon**

---

**From:** PLAHN Joel M <joel.m.plahn@state.or.us>  
**Sent:** Monday, June 06, 2016 3:18 PM  
**To:** Nick Blundon  
**Cc:** Bill Flatz  
**Subject:** RE: Hollis Reservoir Staff Gauge - App #s R-87985 & S-87986

RECEIVED  
DEC 30 2020  
OWRD

Using the gate stem support as the staff guage will work for Application R-87985.

Thanks, Joel Plahn

District 16 Watermaster  
503-986-0889 Office  
503-508-2394 Cell  
725 Summer St NE, Suite A  
Salem, OR 97301

---

**From:** Nick Blundon [mailto:nblundon@stuntzner.com]  
**Sent:** Friday, June 03, 2016 11:16 AM  
**To:** PLAHN Joel M  
**Cc:** Bill Flatz  
**Subject:** Hollis Reservoir Staff Gauge - App #s R-87985 & S-87986

Joel –

After our phone conversation, we are requesting an alternative staff gauge from the typical standing staff gauge plate.

We are requesting to use the dam's gate stem supports as the staff gauge. We are required to survey the dam for as-built after it is constructed. While conducting this survey, we will tie the base and tops of each gate stem support along the upstream centerline of the dam. We will attach weather-resistant labels to each gate stem support, and provide a key to the owner so they are capable of determining the amount of storage related to the water surface level.

This alternative staff gauge was accepted for our previous earthen dam per App R-86731 at 17155 NE Woodland Loop Road, Yamhill Oregon.

I have attached two photos to provide you with a visual. Please provide confirmation that this is an acceptable staff gauge. We will include this in our report to Oregon Dam Safety.

Thanks,

**Nick Blundon**



Office: 503-357-5717  
Fax: 503-357-5698  
2137 19<sup>th</sup> Ave.  
Forest Grove, Or. 97116

# Water Use Report Based on Water Right



Permit: R 15182 \*  
 HOLLIS LAND AND TIMBER LLC 3 MONROE PARKWAY P-425 LAKE OSWEGO,  
 OR 97035

**RECEIVED**  
**DEC 30 2020**

Records per page: 10 [View All](#)

**OWRD**


Acre-feet (AF) of Water Used

Water Year*	Report ID	Facility	Oct	Nov	Dec	Jan	Feb	Mar	Apr	May	Jun	Jul	Aug	Sep	Total Water Used	Irrigated Acres
2020	<a href="#">67559</a>	HOLLIS RESERVOIR (STORAGE)	22.00	28.00	32.00										32.00	
2019	<a href="#">67559</a>	HOLLIS RESERVOIR (STORAGE)	0.00	10.00	51.00	68.00	74.00	74.00	74.00	73.00	72.00	51.00	36.00	24.00	74.00	
2018	<a href="#">67559</a>	HOLLIS RESERVOIR (STORAGE)	24.00	74.00	74.00	74.00	73.00	74.00	73.00	70.00	66.00	8.00	0.00	0.00	74.00	
2017	<a href="#">67559</a>	HOLLIS RESERVOIR (STORAGE)	0.00	0.00	0.00	75.00	75.00	75.00	75.00	75.00	64.00	50.00	38.00	31.00	75.00	

\*The water year is named for the calendar year in which it ends. Example: the 2018 water year begins Oct. 1, 2017 and ends Sep. 30, 2018.

- The Water Resources Department makes reasonable efforts to screen the data for quality control; however, the Department cannot accept responsibility for errors, omissions, or accuracy of the information. Notification of any errors is appreciated. Send notifications to [wateruse@wrdd.state.or.us](mailto:wateruse@wrdd.state.or.us) or call (503) 986-0905.
- Water use is reported by point of diversion (POD), rather than by water right.
- If a POD is shared with multiple water rights, it is not feasible to separate out the amount used under the water right being queried from water used by other rights using this same POD.
- Monthly amounts indicate:
  - For diverted rights, the total amount diverted during the month;
  - For storage rights, the amount generally stored in the reservoir/pond during the month, as represented by the volume of water impounded on approximately the same day each month.
- Water use amounts have all been converted to "acre-feet" (AF), regardless of the original measurement unit reported. One AF is the volume of water that will cover an acre of ground one foot deep = 325,850 gallons.
- Zeroes indicate that a report was received stating that no water was used during those months; if a year is not listed, no report of water use was received for that year.


# HOLLIS RESERVOIR - DRAWINGS OF RECORD COVER SHEET & SITE PLAN

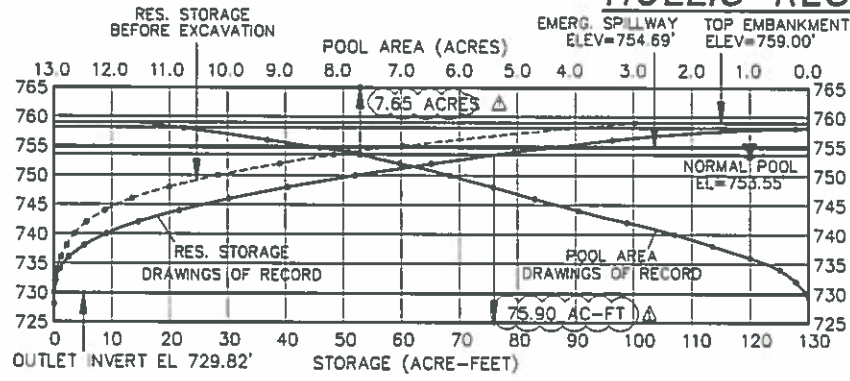

### Hollis Reservoir Hydrology Summary


Watershed area = 180 ac (0.281 sq.mi.) Weighted RCN = 71 Stand pipe = 30" cmp  
Storm distribution = Type IA Time of concentration = 24 min Outlet pipe = 24" cmp

Storm Freq. Years	Precip. in	AMC #	Peak Inflow cfs	Peak Riser Flow cfs	Head in Riser ft	Peak Spillway cfs	Spillway CMP Peak Depth ft	Spillway CMP Ave Vel fps	Total Outflow cfs	Dam Ftebrd ft	Max. Pool EL ft
5	2.0	2	3.35	2.84	0.00	0.00	-1.03	0.00	2.84	6.24	753.78
10	3.4	2	28.86	9.73	0.45	0.00	-0.83	0.00	9.73	4.93	754.07
25	3.8	2	37.44	12.13	0.80	0.00	-0.54	0.00	12.13	4.84	754.18
50	4.4	2	54.87	18.36	1.10	0.00	-0.41	0.00	18.36	4.71	754.28
100	4.7	2	64.18	19.00	1.86	0.00	-0.23	0.00	19.00	4.83	754.32
500	9.3	2	83.78	24.06	2.55	0.00	-0.11	0.00	24.06	4.41	754.99
100	4.7	3	133.73	39.71	3.50	7.63	0.58	3.76	37.31	3.87	755.13
500	8.3	3	188.82	31.88	4.40	14.97	0.79	3.16	48.93	3.82	755.38
100	4.7	4	184.57	35.81	5.80	31.25	1.31	3.47	66.86	3.18	755.82
500	9.3	4	208.52	37.28	8.10	40.88	1.47	3.83	78.16	2.96	759.04

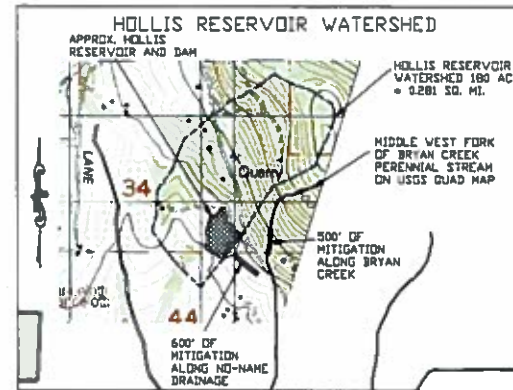

BASIN MAP  
SCALE: NTS

- ### LEGEND
- SECTION LINE
  - 1/16TH SECTION LINE
  - PROPERTY LINE
  - MINOR CONTOUR (2' INTERVAL)
  - MAJOR CONTOUR (10' INTERVAL)
  - THIN SPREAD AREA / WASTE AREA
  - SET CONTROL POINT
  - 25' WIDE CONIFEROUS TREE PLANTING AREA
  - 10' WIDE GRASS PLANTING STRIP
  - PROPOSED MITIGATION AREA
  - EXISTING TREE / STUMP
  - TEST PIT
  - EXISTING GRAVEL ROAD
  - STRAW BALE DIKE
  - TOE DRAIN
  - EXISTING DIRT ROAD
  - RIPRAP / PLUNGE POOL

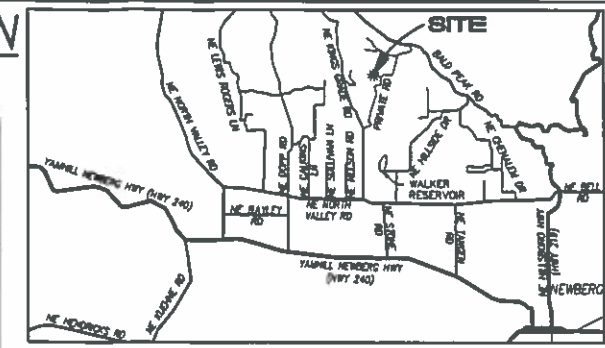

CONTACTS VICINITY MAP  
SCALE: NTS

OWNER/APPLICANT  
HOLLIS LAND AND TIMBER, LLC.  
13984 CHELSEA DR.  
LAKE OSWEGO, OR 97035  
CONTACT: DAVID ANDERSON; ZACH KRAMER  
(805) 680-7741; (503) 385-3639

CONTRACTOR  
PIHL, INC.  
41660 NW SUNSET HWY  
BANKS, OR 97106  
CONTACT: STUART WURDINGER  
FOREST GROVE, OREGON 97116  
(503) 357-5717 OFFICE  
(503) 357-5698 FAX  
CCB#: 121460

CIVIL ENGINEER / GEOTECHNICAL ENGINEER / SURVEYOR  
STUNTNER ENGINEERING AND FORESTRY, LLC  
ATTN: BILL FLATZ - PE, CWRE, CESCL; NICK BLUNDON - PE, CESCL  
2137 19TH AVENUE  
FOREST GROVE, OREGON 97116  
(503) 357-5717 OFFICE  
(503) 357-5698 FAX

BENCHMARK  
HORIZONTAL DATUM: OCRS PORTLAND ZONE  
VERTICAL DATUM: NAVD 1988

ELEVATIONS ON THIS MAP HAVE BEEN PHOTOGRAMMETRICALLY COMPILED FROM 9.838CM/0.32FT GSD 100.500 MM C.F.L. DIGITAL AERIAL PHOTOS TO MEET NATIONAL MAP ACCURACY STANDARDS (NMAS) AT 1"=100' SCALE BY 301 GEOTERRA MAPPING GROUP.

THE BENCHMARK ELEVATION IS THE NORTHWEST CORNER OF SECTION 35 LOCATED AT A BEARING AND DISTANCE OF N15°20'39"W 1,371.58' FROM THE CENTERLINE OF THE PROPOSED DAM.  
ELEVATION = 775.17'


THE PROPOSED DAM IS LOCATED AT APPROXIMATELY:  
LATITUDE 45°21'29.56"N  
LONGITUDE 123°01'50.48"W

### SUMMARY OF DESIGN QUANTITIES



- ACTUAL AREA OF DISTURBANCE 18.7 AC
  - ACTUAL STRIPPING WASTE AREA 3.0 AC
  - DESIGN STRIPPING OF DAM FOUNDATION AND POOL 14,250 CY\*
  - DESIGN STRIPPING OF ACCESS ROAD 350 CY\*
  - DESIGN CUTOFF TRENCH EXCAVATION 1,850 CY\*
  - DESIGN "NAKED TRENCH" EXCAVATION 1,700 CY\*
  - DESIGN DAM EMBANKMENT EARTHWORK 28,850 CY\*
  - DESIGN EMERGENCY SPILLWAY EARTHWORK 750 CY\*
  - DESIGN SEDIMENT SETTLING POOL EARTHWORK 80 CY\*
  - ACTUAL 8" CMP DRAIN CONDUIT 60 LF
  - ACTUAL 24" CMP PRIMARY OUTLET CONDUIT 197 LF
  - ACTUAL 24" CMP SPILLWAY PIPE 120 LF
  - ACTUAL 30" CMP STAND PIPE 28.55 LF
  - ACTUAL 8" PERFORATED HEAVY DUTY PVC 440 LF
  - ACTUAL 8" SCHED. 40 PVC 136 LF
  - DESIGN 1,000 PSI CONCRETE 95 CY
  - DESIGN ASTM C-33 (CONCRETE) SAND 110 CY
  - DESIGN ODOT CLASS 50 RIPRAP 10 CY
  - DESIGN ODOT CLASS 100 RIPRAP 15 CY
  - DESIGN DITCH/CREEK MITIGATION 1,100 LF
  - FOR ROAD:
  - DESIGN 3/4"-0" CRUSHED ROCK (ROAD) 55 CY
  - DESIGN 3/4"-0" CRUSHED ROCK (PIPE BACKFILL) 30 CY
  - DESIGN 1-1/2"-0" CRUSHED ROCK (ROAD) 280 CY
  - DESIGN 1-1/2"-3/4" DRAIN ROCK, NO FINES 100 CY
  - DESIGN NON-WOVEN GEOTEXTILE FABRIC (TOE DRAINS) 630 SQ YD
  - DESIGN NON-WOVEN GEOTEXTILE FABRIC (RIPRAP) 65 SQ YD
  - DESIGN WOVEN GEOTEXTILE FABRIC (DAM ACCESS ROAD) 930 SQ YD
  - FOR ROAD:
  - DESIGN 3/4"-0" CRUSHED ROCK 50 CY
  - DESIGN 1-1/2"-0" CRUSHED ROCK 250 CY
  - DESIGN WOVEN GEOTEXTILE FABRIC 900 SQ YD
  - TOTAL DAM + ROAD:
  - DESIGN 3/4"-0" CRUSHED ROCK 135 CY
  - DESIGN 1-1/2"-0" CRUSHED ROCK 610 CY
  - DESIGN NON-WOVEN GEOTEXTILE FABRIC 630 SQ YD
  - DESIGN WOVEN GEOTEXTILE FABRIC 1,830 SQ YD
- \*GRADING QUANTITIES APPROXIMATE THAT THE TOP 1' OF TOPSOIL WAS REMOVED AND SPREAD ON THE AREA INDICATED ON THESE PLANS. THE SOIL USED IN THE DAM EMBANKMENT WAS BORROWED FROM THE RESERVOIR INUNDATION AREA.  
\*\*SATURATED SOIL WAS DISCOVERED DURING EXCAVATION OF THE RESERVOIR SITE. THIS AREA WAS EXCAVATED TO WEATHERED BEDROCK AND BACKFILLED WITH SUITABLE COMPACTED NATIVE SOIL.

### SHEET INDEX

- DRAWINGS OF RECORD COVER SHEET & SITE PLAN
- DRAWINGS OF RECORD CROSS SECTIONS, PROFILES, AND PLAN VIEW
- DRAWINGS OF RECORD DETAILS
- DRAWINGS OF RECORD PLANS, PROFILES, AND DETAILS

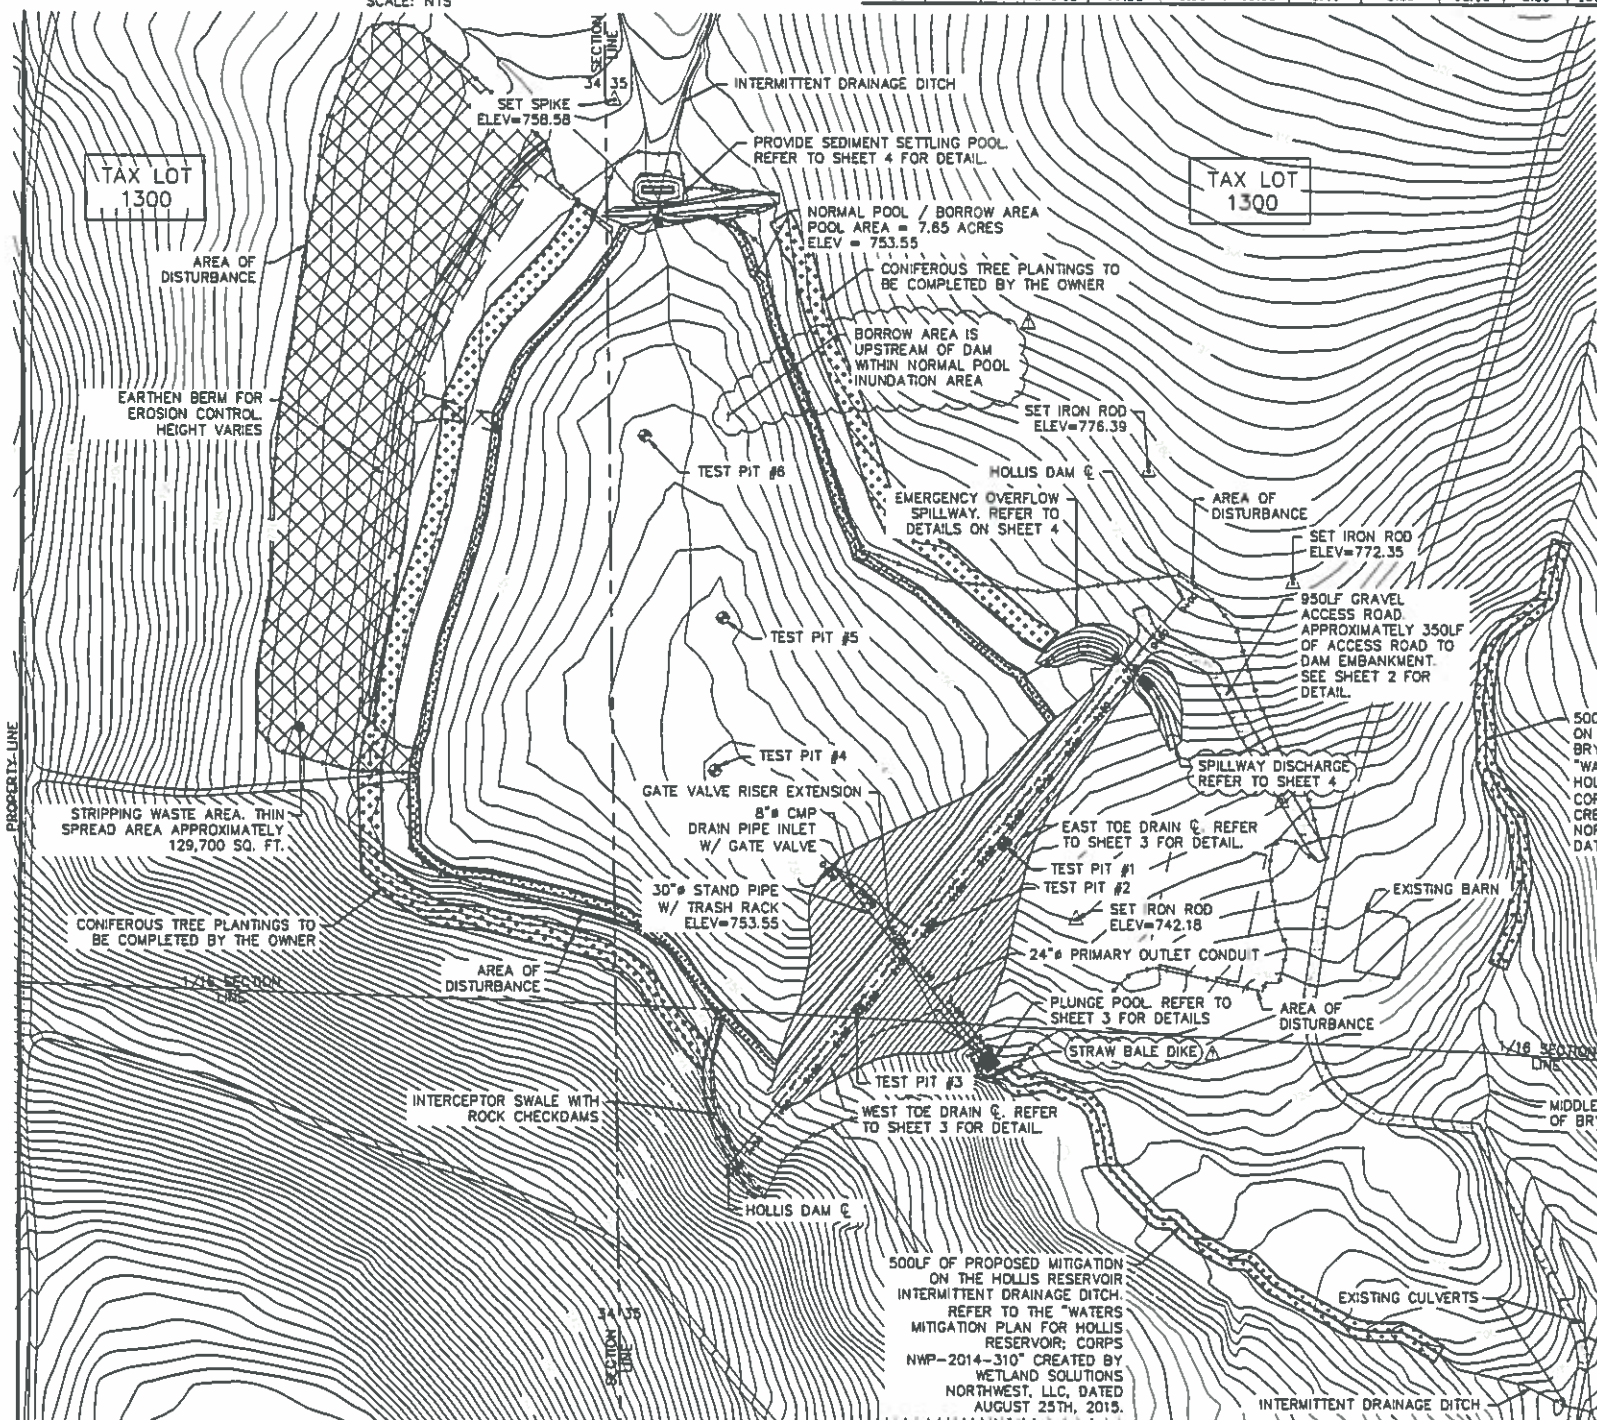

HOLLIS RESERVOIR - SITE PLAN  
SCALE: 1"=100'

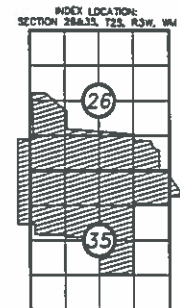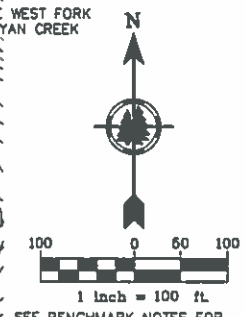

1 - DRAWINGS OF RECORD COVER SHEET & SITE PLAN  
HOLLIS LAND AND TIMBER, LLC.  
13984 CHELSEA DR.  
LAKE OSWEGO, OR 97035

RECEIVED  
DEC 30 2020  
OWRD

STUNTNER Engineering & Forestry, LLC  
ENGINEERING • LAND SURVEYING • FORESTRY  
PLANNING • WATER RIGHTS

2137 19th Avenue  
Forest Grove, Oregon 97116  
TEL: (503) 357-5717  
FAX: (503) 357-5698



REGISTERED PROFESSIONAL ENGINEER  
#93,723  
NICHOLAS G. BLUNDON  
EXPIRES 12/31/17

REGISTERED PROFESSIONAL ENGINEER  
#93,005  
WILLIAM L. FLATZ  
EXPIRES 12/31/17


DRAWINGS OF RECORD  
DESIGNED BY WLF/NCB  
DRAWN BY WLF/NCB  
CHECKED BY WLF/NCB  
DATE: 6-22-2018  
REVISION 11-21-2018  
JOB NAME: HOLLIS RESERVOIR  
JOB NO.: 313081 SHEET 1 OF 4

USACE PERMIT No.: NWP-2014-310  
ESL PERMIT No.: 54702-NP  
OWRD APPLICATION No.: R-87965, S-87966  
DRAWINGS OF RECORD

# HOLLIS RESERVOIR - DRAWINGS OF RECORD CROSS SECTIONS, PROFILES, AND PLAN VIEW

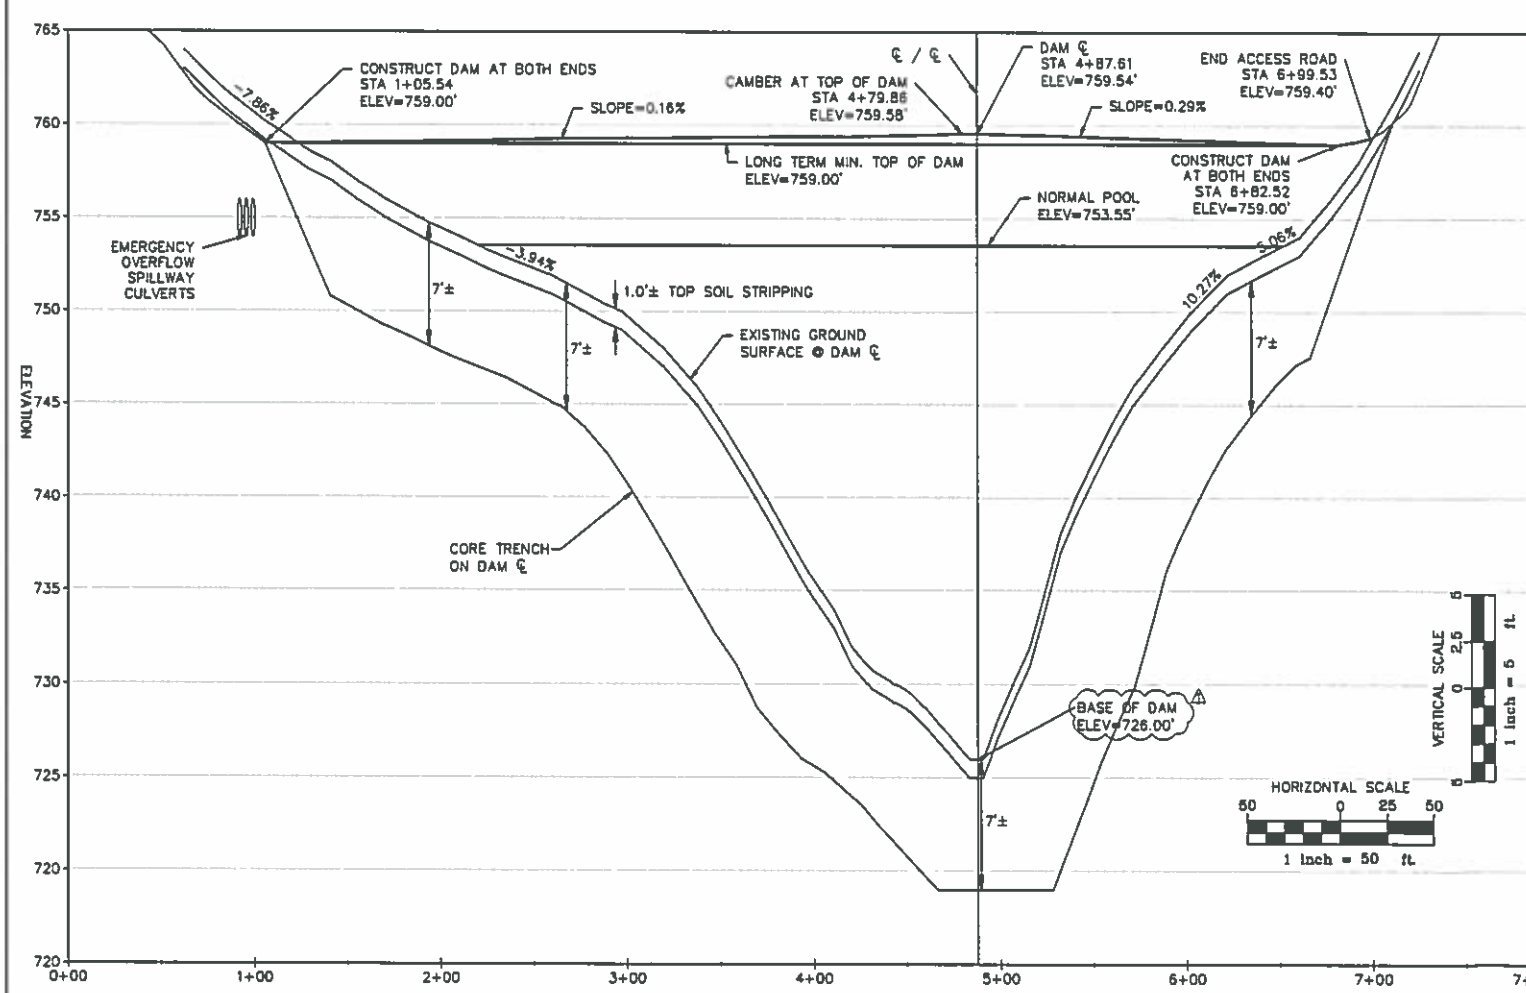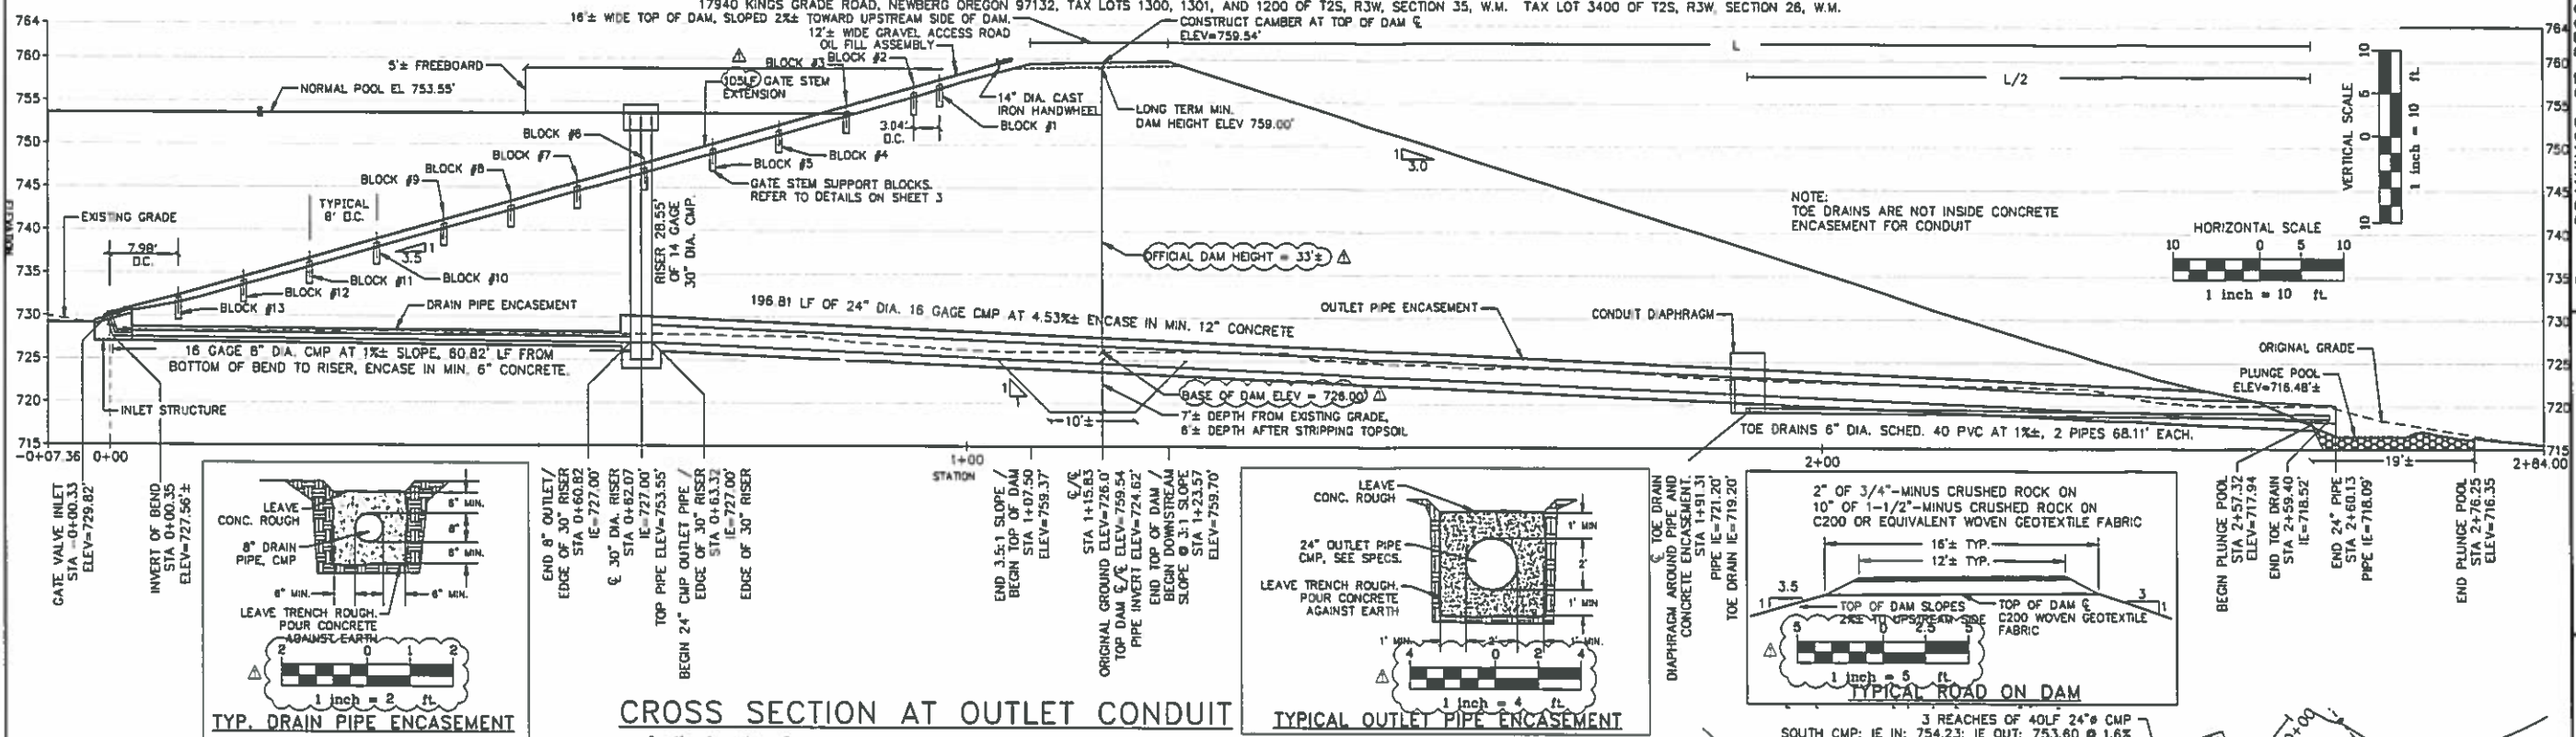

PROFILE ON CL DAM LOOKING DOWNSTREAM

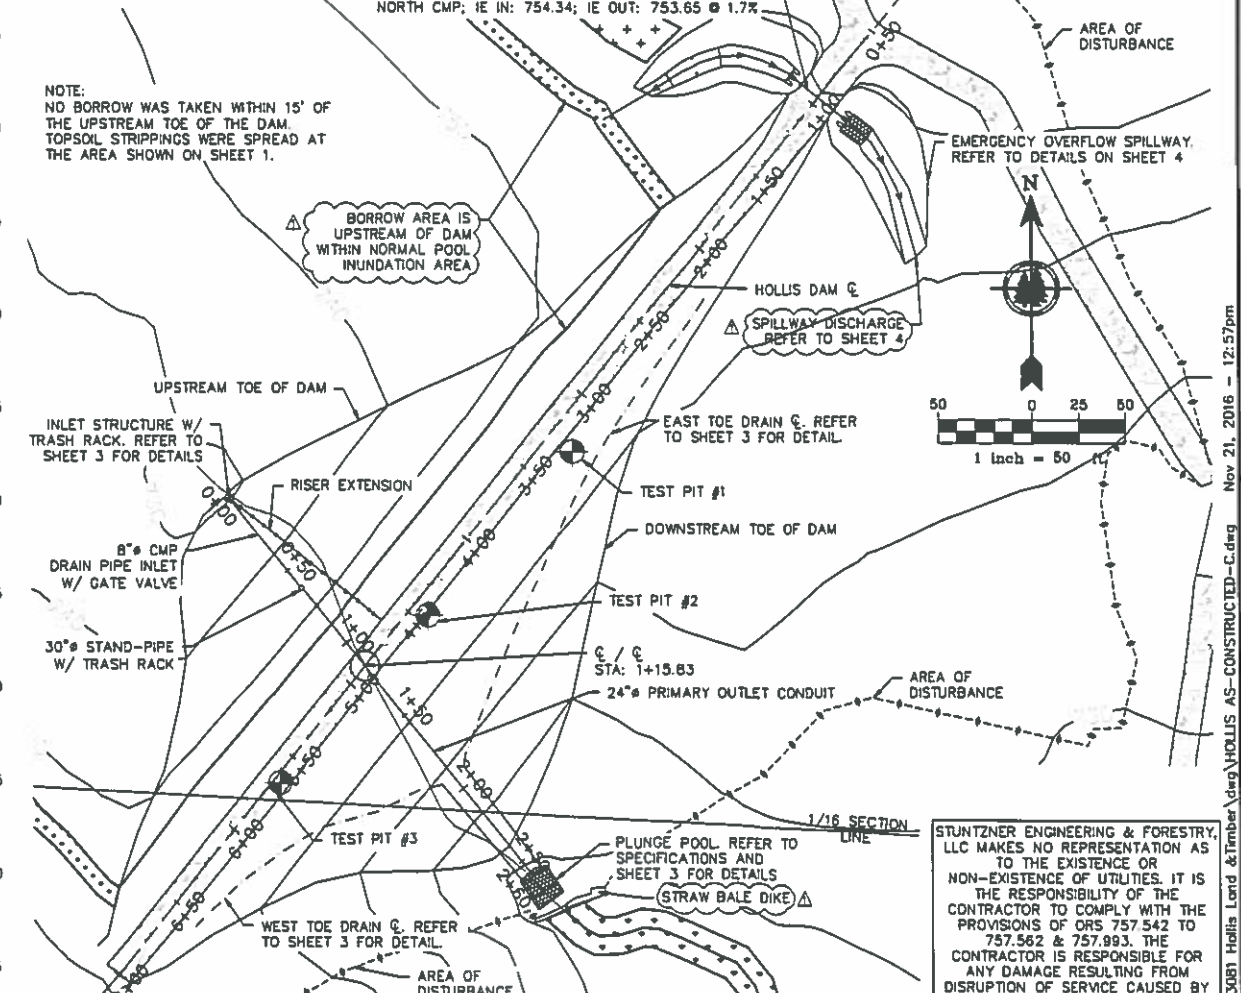

PLAN VIEW OF DAM

STUNTZNER ENGINEERING & FORESTRY, LLC MAKES NO REPRESENTATION AS TO THE EXISTENCE OR NON-EXISTENCE OF UTILITIES. IT IS THE RESPONSIBILITY OF THE CONTRACTOR TO COMPLY WITH THE PROVISIONS OF ORS 757.542 TO 757.562 & 757.993. THE CONTRACTOR IS RESPONSIBLE FOR ANY DAMAGE RESULTING FROM DISRUPTION OF SERVICE CAUSED BY CONSTRUCTION ACTIVITIES.

USACE PERMIT No.: NWP-2014-310  
OSL PERMIT No.: 58702-NP  
OWRD APPLICATION No.: P-87985, S-87986

**2 - DRAWINGS OF RECORD CROSS SECTIONS, PROFILES, AND PLAN VIEW**

BY: TML  
DATE: 7-11-16  
DESCRIPTION: OREGON DAM SAFETY TML  
REV: 9-4-16  
DATE: 11-21-16  
DESCRIPTION: PIPE & RIPRAP  
DRAWINGS OF RECORD

**RECEIVED**  
DEC 8 2020

HOLLIS LAND AND TIMBER, LLC.  
13984 CHELSEA DR.  
LAKE OSWEGO, OR 97035

**Stuntzner Engineering & Forestry, LLC**  
ENGINEERING • LAND SURVEYING • FORESTRY  
PLANNING • WATER RIGHTS  
• COOS BAY • DALLAS • PORTLAND • ROSEBURG  
2137 1945 AVENUE  
FOREST GROVE, OREGON 97116  
TEL: (503) 357-5717  
FAX: (503) 357-5688

Nov 21, 2016 - 12:57pm  
AS-CONSTRUCTED-C.dwg

REGISTERED PROFESSIONAL ENGINEER #83,725  
NICHOLAS G. BLUNTON  
EXPIRES 12/31/17

REGISTERED PROFESSIONAL ENGINEER #53,005  
WILLIAM L. FLATZ  
EXPIRES 12/31/17

ENGINEER OF RECORD  
DESIGNED BY: WLF/WCB  
DRAWN BY: WLF/WCB  
CHECKED BY: WLF/WCB  
DATE: 6-22-2018  
REVISED 11-21-2018




















JOB NAME: HOLLIS RESERVOIR  
JOB No.: J13081  
SHEET 2 OF 4

OWRD

**HOLLIS RESERVOIR - DRAWINGS OF RECORD DETAILS**

17940 KINGS GRADE ROAD, NEWBERG OREGON 97132  
 TAX LOTS 1300, 1301, AND 1200 OF T2S, R3W, SECTION 35, W.M.  
 TAX LOT 3400 OF T2S, R3W, SECTION 26, W.M.

Gate Stem Support Block #	Location (Station)	Elevation (ft)	Pool Area (Acres)	Storage (Acres-feet)	#7 - Top of Concrete	#8 - Top of Concrete	#9 - Top of Concrete	#10 - Top of Concrete	#11 - Top of Concrete	#12 - Top of Concrete	#13 - Top of Concrete	#14 - Top of Concrete
1	Station 1	719.50	11.53	1.00	747.79	747.71	747.59	747.46	747.33	747.20	747.07	746.94
2	Station 2	758.30	20.99	1.00	785.71	785.63	785.51	785.38	785.25	785.12	784.99	784.86
3	Station 3	758.17	20.99	1.00	785.71	785.63	785.51	785.38	785.25	785.12	784.99	784.86
4	Station 4	757.53	20.97	1.00	785.71	785.63	785.51	785.38	785.25	785.12	784.99	784.86
5	Station 5	757.39	20.97	1.00	785.71	785.63	785.51	785.38	785.25	785.12	784.99	784.86
6	Station 6	757.39	20.97	1.00	785.71	785.63	785.51	785.38	785.25	785.12	784.99	784.86
7	Station 7	757.07	20.70	0.85	785.07	784.99	784.86	784.73	784.60	784.47	784.34	784.21
8	Station 8	757.00	20.65	0.75	785.00	784.92	784.79	784.66	784.53	784.40	784.27	784.14
9	Station 9	756.86	20.55	0.66	784.86	784.78	784.65	784.52	784.39	784.26	784.13	784.00
10	Station 10	756.78	20.41	0.60	784.78	784.70	784.57	784.44	784.31	784.18	784.05	783.92
11	Station 11	756.55	20.25	0.50	784.55	784.47	784.34	784.21	784.08	783.95	783.82	783.69
12	Station 12	756.32	20.07	0.40	784.32	784.24	784.11	783.98	783.85	783.72	783.59	783.46
13	Station 13	756.17	19.85	0.30	784.17	784.09	783.96	783.83	783.70	783.57	783.44	783.31
14	Station 14	756.00	19.60	0.25	784.00	783.92	783.79	783.66	783.53	783.40	783.27	783.14
15	Station 15	755.83	19.33	0.20	783.83	783.75	783.62	783.49	783.36	783.23	783.10	782.97
16	Station 16	755.66	19.03	0.15	783.66	783.58	783.45	783.32	783.19	783.06	782.93	782.80
17	Station 17	755.50	18.69	0.10	783.50	783.42	783.29	783.16	783.03	782.90	782.77	782.64
18	Station 18	755.33	18.31	0.05	783.33	783.25	783.12	782.99	782.86	782.73	782.60	782.47
19	Station 19	755.17	17.89	0.02	783.17	783.09	782.96	782.83	782.70	782.57	782.44	782.31

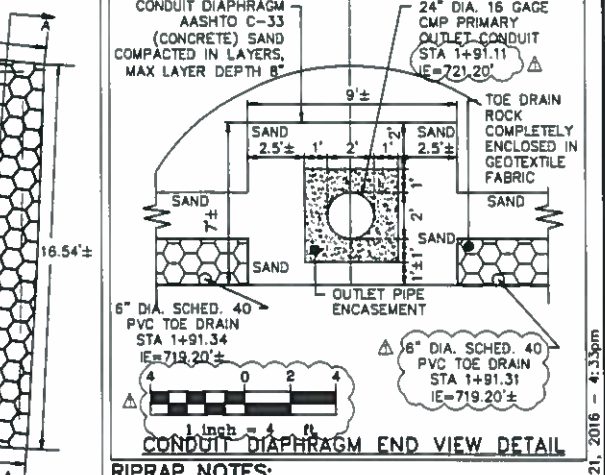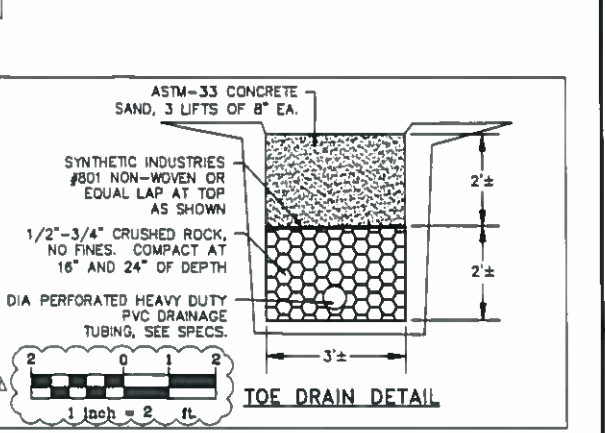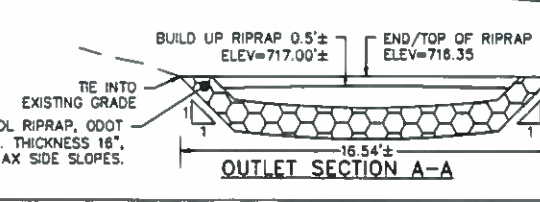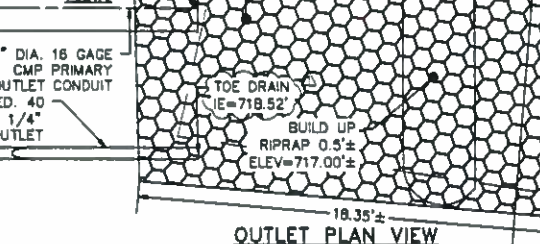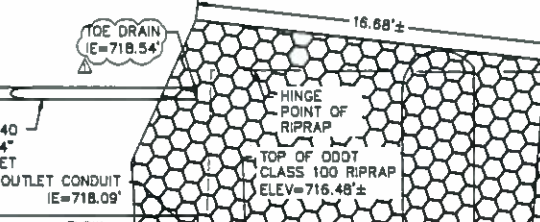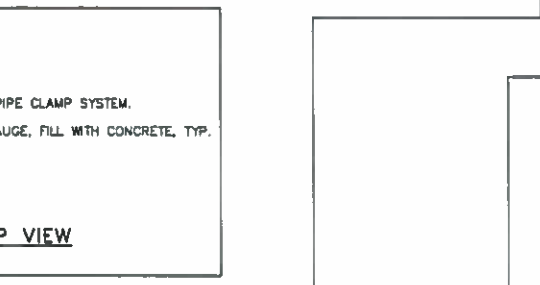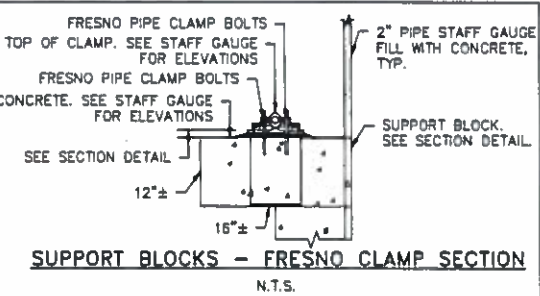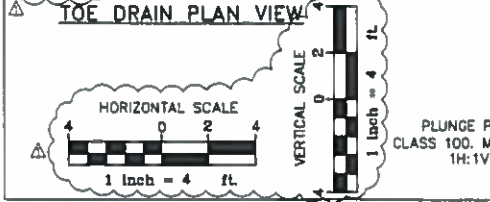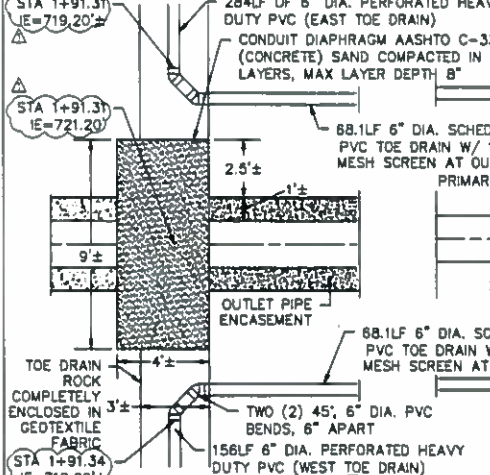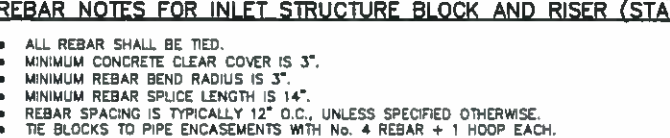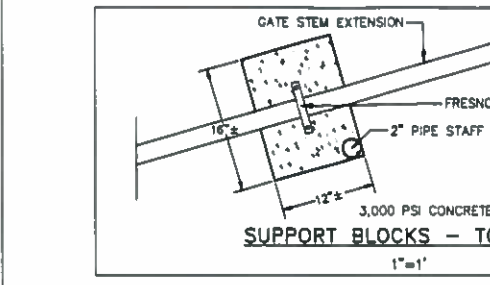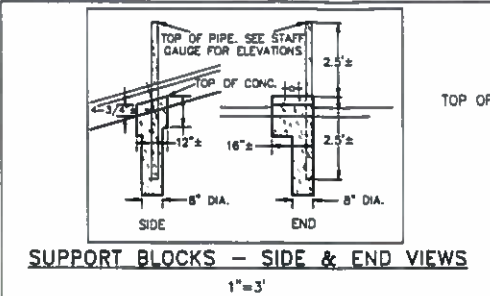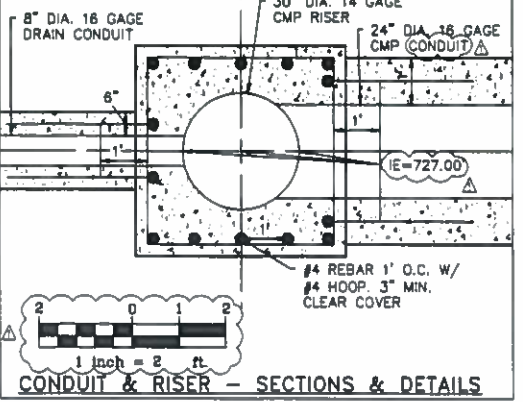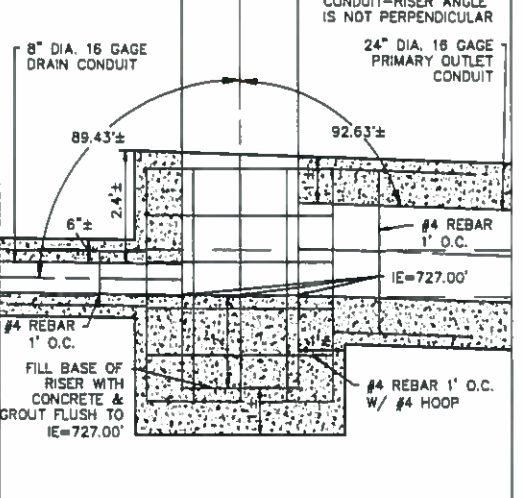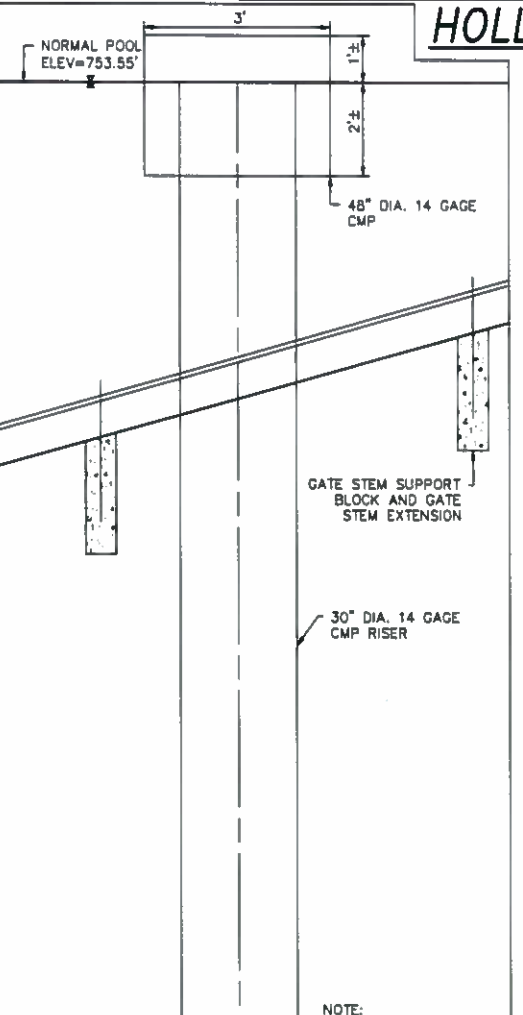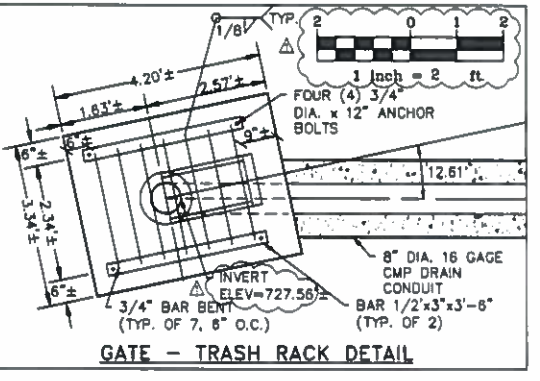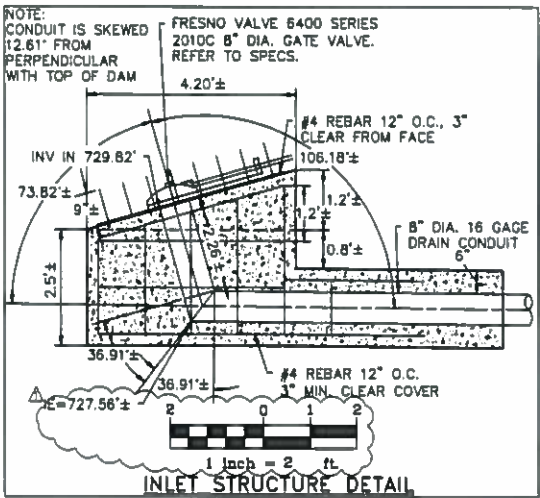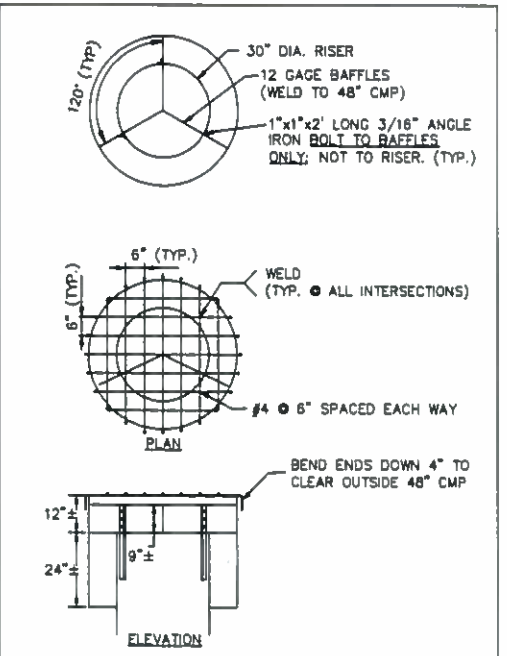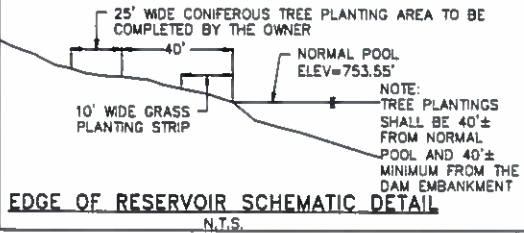

- REBAR NOTES FOR INLET STRUCTURE BLOCK AND RISER (STAND PIPE) BLOCK:**
- ALL REBAR SHALL BE TIED.
  - MINIMUM CONCRETE CLEAR COVER IS 3".
  - MINIMUM REBAR BEND RADIUS IS 3".
  - MINIMUM REBAR SPLICE LENGTH IS 14".
  - REBAR SPACING IS TYPICALLY 12" O.C., UNLESS SPECIFIED OTHERWISE.
  - THE BLOCKS TO PIPE ENCASUREMENTS WITH No. 4 REBAR + 1 HOOP EACH.

REV	DATE	DESCRIPTION	BY	CHKD
1	7-11-16	OREGON DAM SAFETY T&I	TJH	WLF
2	9-4-16	24" PIPE & RIPRAP W&F	TJH	WLF
3	11-21-16	DRAWINGS OF RECORD	TJH	WLF

**Stuntzner Engineering & Forestry, LLC**  
 ENGINEERING • LAND SURVEYING • FORESTRY  
 PLANNING • WATER RIGHTS

2157 18th AVENUE, OREGON 97116  
 TEL: (503) 357-5717  
 FAX: (503) 357-5688

Nov 21, 2016 - 4:30pm

REGISTERED PROFESSIONAL ENGINEER  
 833,725  
 WILLIAM L. FLETCHER  
 EXPIRES 12/31/17

REGISTERED PROFESSIONAL ENGINEER  
 833,005  
 EXPIRES 12/31/17

ENGINEER OF RECORD

**DRAWINGS OF RECORD**

APPROVED BY: WLF/WGB  
 CHECKED BY: WLF/WGB  
 DATE: 6-22-2016  
 REVISION: 11-21-2016

JOB NAME: HOLLIS RESERVOIR  
 JOB NO.: 1313081  
 SHEET 3 OF 4

RECEIVED  
 DEC 30 2020  
 CWRD

STUNTZNER ENGINEERING & FORESTRY, LLC MAKES NO REPRESENTATION AS TO THE EXISTENCE OR NON-EXISTENCE OF UTILITIES. IT IS THE RESPONSIBILITY OF THE CONTRACTOR TO COMPLY WITH THE PROVISIONS OF ORS 757.542 TO 757.562 & 757.993. THE CONTRACTOR IS RESPONSIBLE FOR ANY DAMAGE RESULTING FROM DISRUPTION OF SERVICE CAUSED BY CONSTRUCTION ACTIVITIES.


USACE PERMIT No.: NWP-2016-310  
 DISL PERMIT No.: 56702-NP  
 CWRD APPLICATION No.: R-87985; S-87986

**DRAWINGS OF RECORD**




# HOLLIS RESERVOIR - DRAWINGS OF RECORD PLANS, PROFILES, AND DETAILS


17940 KINGS GRADE ROAD, NEWBERG OREGON 97132  
TAX LOTS 1300, 1301, AND 1200 OF T2S, R3W, SECTION 35, W.M.  
TAX LOT 3400 OF T2S, R3W, SECTION 26, W.M.

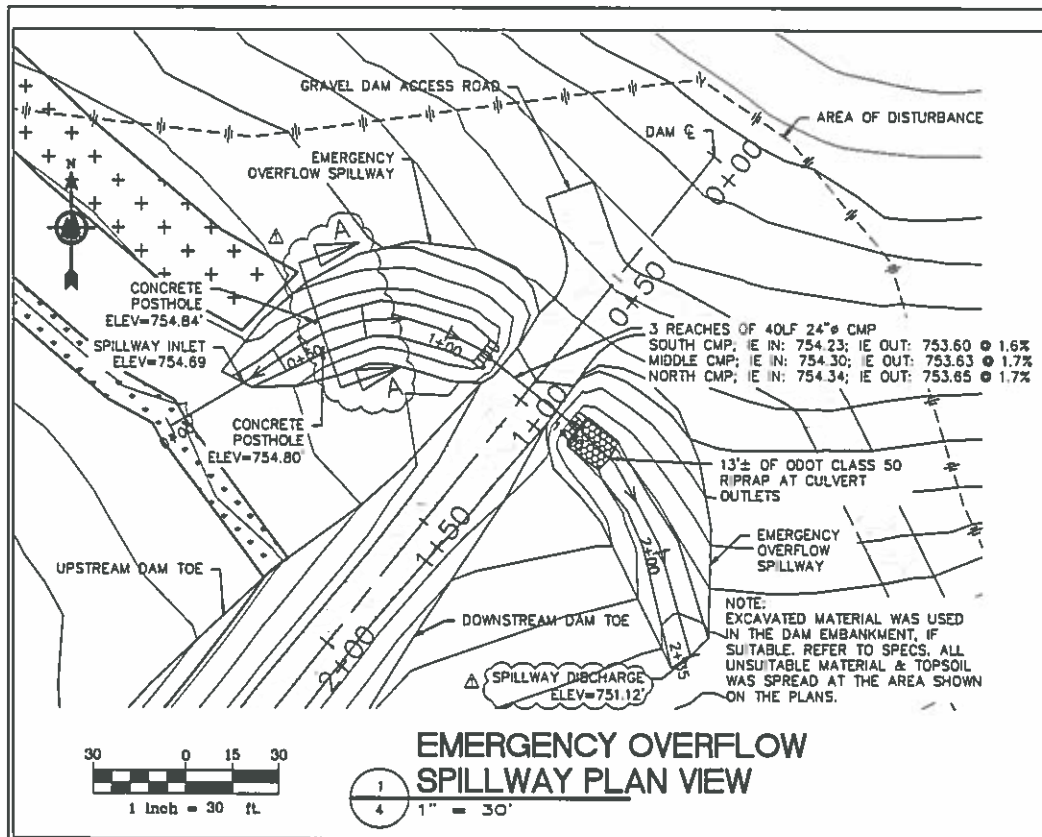


**EMERGENCY OVERFLOW SPILLWAY PLAN VIEW**

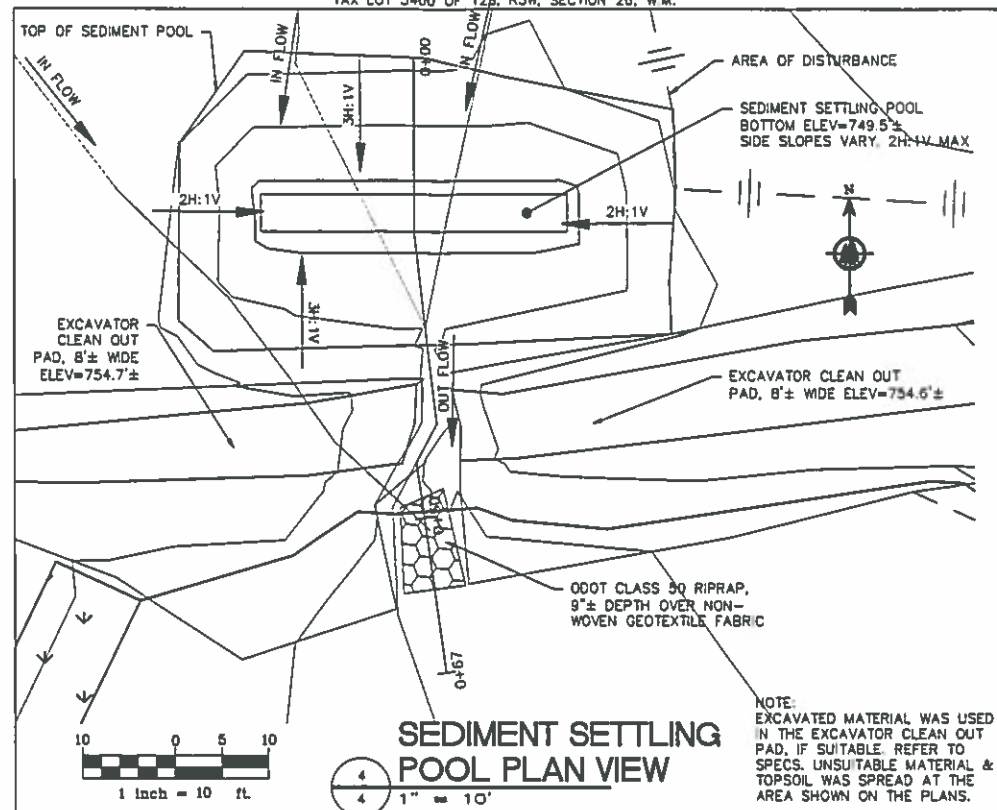


**SEDIMENT SETTLING POOL PLAN VIEW**

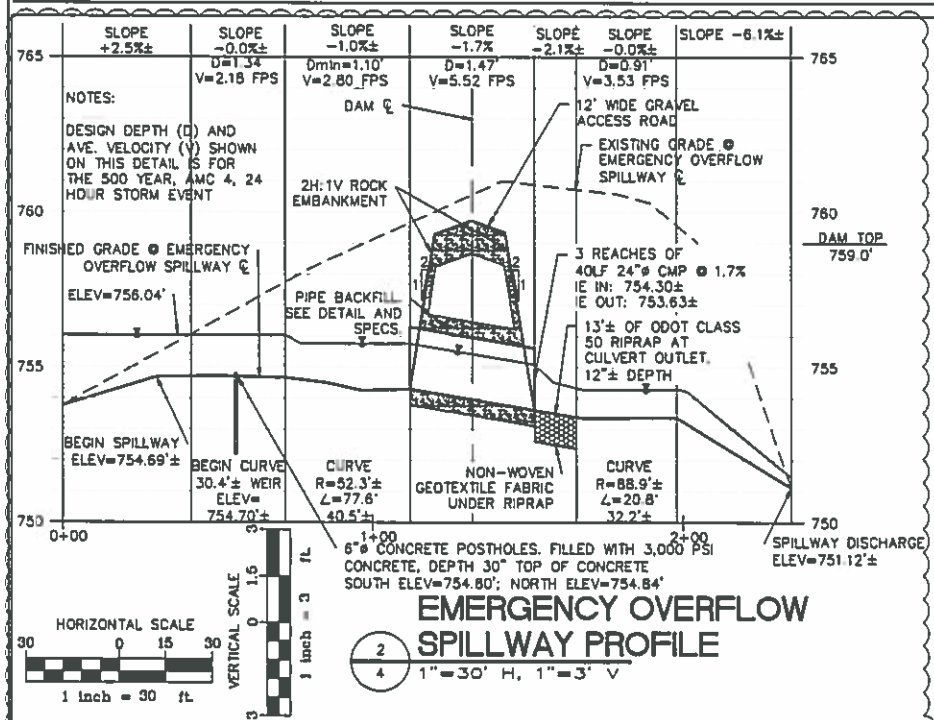


**EMERGENCY OVERFLOW SPILLWAY PROFILE**

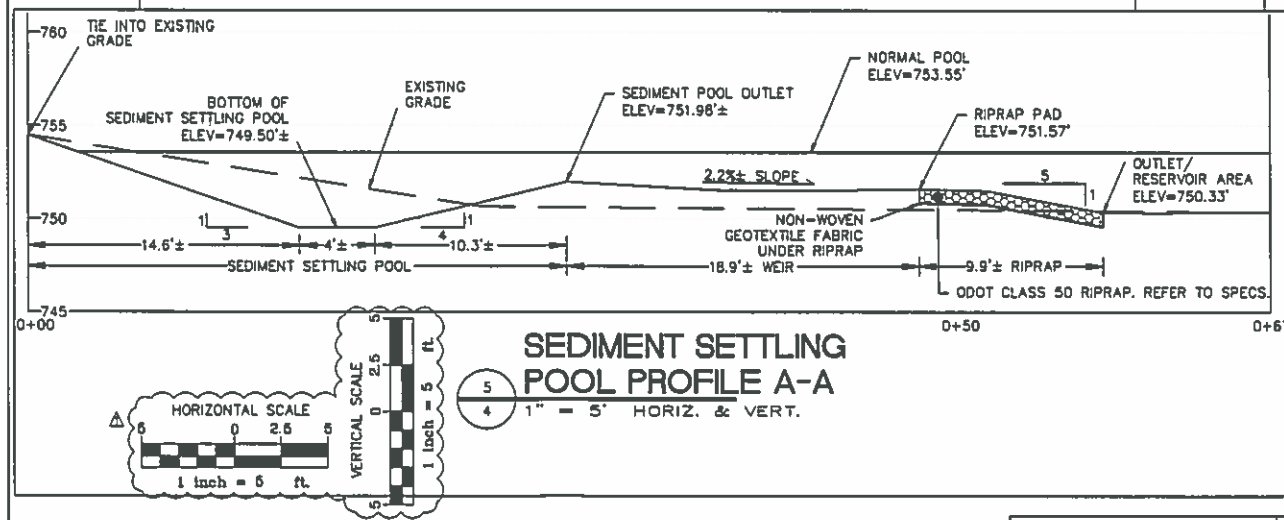


**SEDIMENT SETTLING POOL PROFILE A-A**

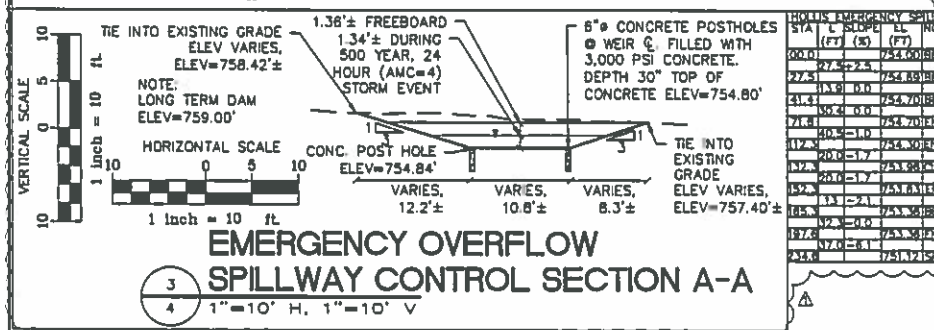


**EMERGENCY OVERFLOW SPILLWAY CONTROL SECTION A-A**

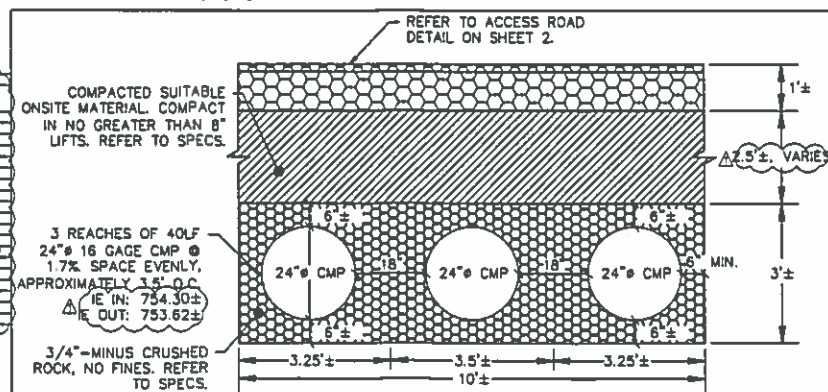

**EMERGENCY OVERFLOW SPILLWAY BACKFILL DETAIL**

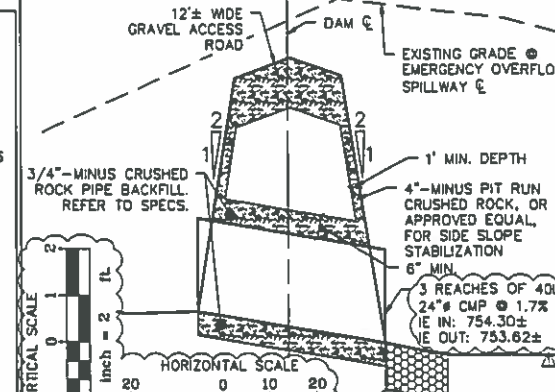

**EMERGENCY OVERFLOW SPILLWAY SIDE SLOPES**

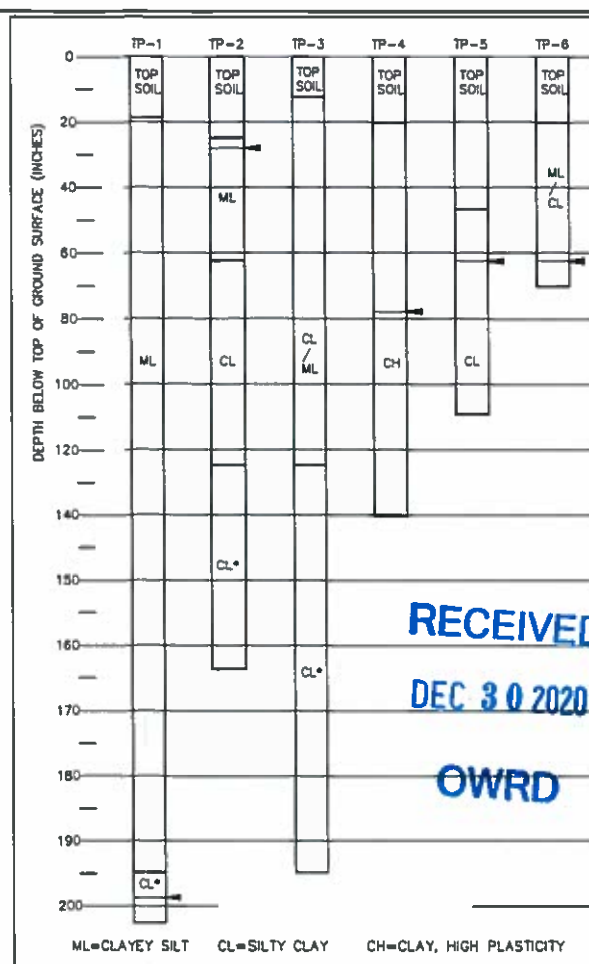

RECEIVED

DEC 30 2020



OWRD

ML=CLAYEY SILT CL=SILTY CLAY CH=CLAY, HIGH PLASTICITY

NOTES:  
DENOTES HIGHLY WEATHERED BEDROCK FRAGMENTS ENCOUNTERED ON 03/06/03  
DENOTES WATER SEEPAGE INTO TEST PIT ON 03/11/2014

CLASSIFIED BY THE UNIFIED CLASSIFICATION SYSTEM ASTM D-2487. CLASSIFICATIONS ARE GEOLOGIST FIELD CLASSIFICATION (OR FROM LABORATORY TEST DATA WHERE AVAILABLE). A COMPLETE COPY OF THE GEOLOGIST REPORT AND LAB TEST DATA IS AVAILABLE BY REQUEST THROUGH STUNTZNER ENGINEERING & FORESTRY, LLC.

**TEST PIT LOGS**

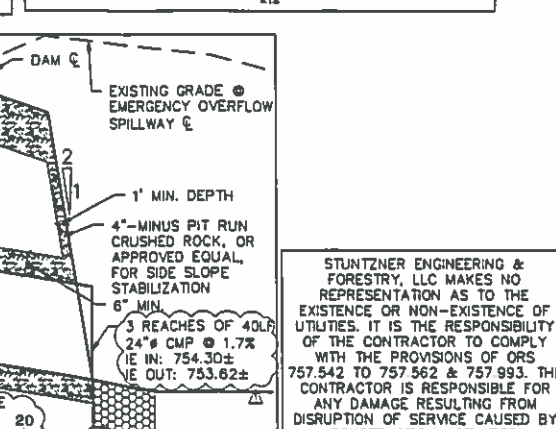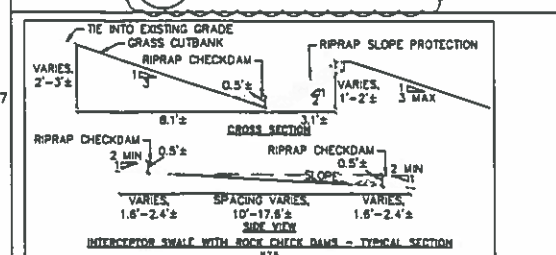

STUNTZNER ENGINEERING & FORESTRY, LLC MAKES NO REPRESENTATION AS TO THE EXISTENCE OR NON-EXISTENCE OF UTILITIES. IT IS THE RESPONSIBILITY OF THE CONTRACTOR TO COMPLY WITH THE PROVISIONS OF ORS 757.542 TO 757.562 & 757.993. THE CONTRACTOR IS RESPONSIBLE FOR ANY DAMAGE RESULTING FROM DISRUPTION OF SERVICE CAUSED BY CONSTRUCTION ACTIVITIES.

USACE PERMIT No.: NWP-2014-310  
DSL PERMIT No.: 56703-10  
OWRD APPLICATION No.: R-57983; 5-67988

STA.	L	SLOPE	EL	NOTES
00+00	(77)	(8)	759.00	24" CMP BEGIN ALIGNMENT
00+25	2.5	2.5	758.84	24" CMP BEGIN SPILLWAY
01+00	0.0	0.0	758.84	24" CMP BEGIN CURVE
01+25	2.5	2.5	758.84	24" CMP END CURVE
02+00	0.0	0.0	758.84	24" CMP END SPILLWAY
02+25	2.5	2.5	758.84	24" CMP END ALIGNMENT
03+00	0.0	0.0	758.84	24" CMP BEGIN CURVE
03+25	2.5	2.5	758.84	24" CMP END CURVE
04+00	0.0	0.0	758.84	24" CMP END SPILLWAY
04+25	2.5	2.5	758.84	24" CMP END ALIGNMENT

**4 - DRAWINGS OF RECORD  
PLANS, PROFILES, AND  
DETAILS**

**Stuntzner Engineering & Forestry, LLC**  
ENGINEERING • LAND SURVEYING • FORESTRY  
PLANNING • WATER RIGHTS

13984 CHELSEA DR.  
LAKE OSWEGO, OR 97035

2157 19th AVENUE  
FOREST GROVE, OREGON 97116

TEL: (503) 557-5717  
FAX: (503) 557-5698

Nov 21, 2016 - 12:56pm

REGISTERED PROFESSIONAL ENGINEER  
No. 83,723  
WILLIAM L. PLATT  
EXPIRES 12/31/17

REGISTERED PROFESSIONAL ENGINEER  
No. 83,005  
WILLIAM L. PLATT  
EXPIRES 12/31/17

DRAWINGS OF RECORD  
DESIGNED BY: WJL/HCB  
DRAWN BY: WJL/HCB  
CHECKED BY: WJL/HCB  
DATE: 6-22-2016  
REVISED: 11-21-2016

JOB NAME: HOLLIS RESERVOIR  
JOB No.: 312081 SHEET 4 OF 4



TELEPHONE (503) 357-5717  
CELL (503) 939-8381  
FAX (503) 357-5698  
billflatz@stuntzner.com

2318-B Pacific Avenue  
FOREST GROVE, OREGON 97116

COOS BAY - FOREST GROVE - DALLAS - JUNCTION CITY

**TO:** Oregon Water Resources Department  
725 Summer Street NE, Suite A  
Salem, OR 97301-1266

**RECEIVED**

**DEC 30 2020**

**OWRD**

**SUBJECT:** Claim of Beneficial Use Submittal.

December 28, 2020

To Whom it may concern:

Please find enclosed:

- A completed Claim of Beneficial Use form.
- A completed Claim of Beneficial Use map
- Claim of Beneficial Use attachments.
- A check for \$200 for the statutory review fee.

Please call if you have any questions or need any further information.

Sincerely,  
*Stuntzner Engineering & Forestry, LLC*

Bill Flatz, PE, CWRE

A handwritten signature in blue ink, appearing to read "Bill Flatz", is written over the typed name.