

AS BUILT MAP OF MOSQUITO CREEK PIT #3 (48-2056) RESERVOIR

SE 1/4 SW 1/4 SEC 11, T. 23S., R. 38 E., W.M.
U.S.G.S. QUAD - MOSQUITO MOUNTAIN, OREG. - 7 1/2'

LEGEND


- 88 CONTOUR & ELEV
- HIGH WATER LINE ELEV. 90.9
- CHANNEL
- MONUMENT

GRAPHIC SCALE



(IN FEET)
1 inch = 60 ft.

CONTOUR INTERVAL = 1 FOOT

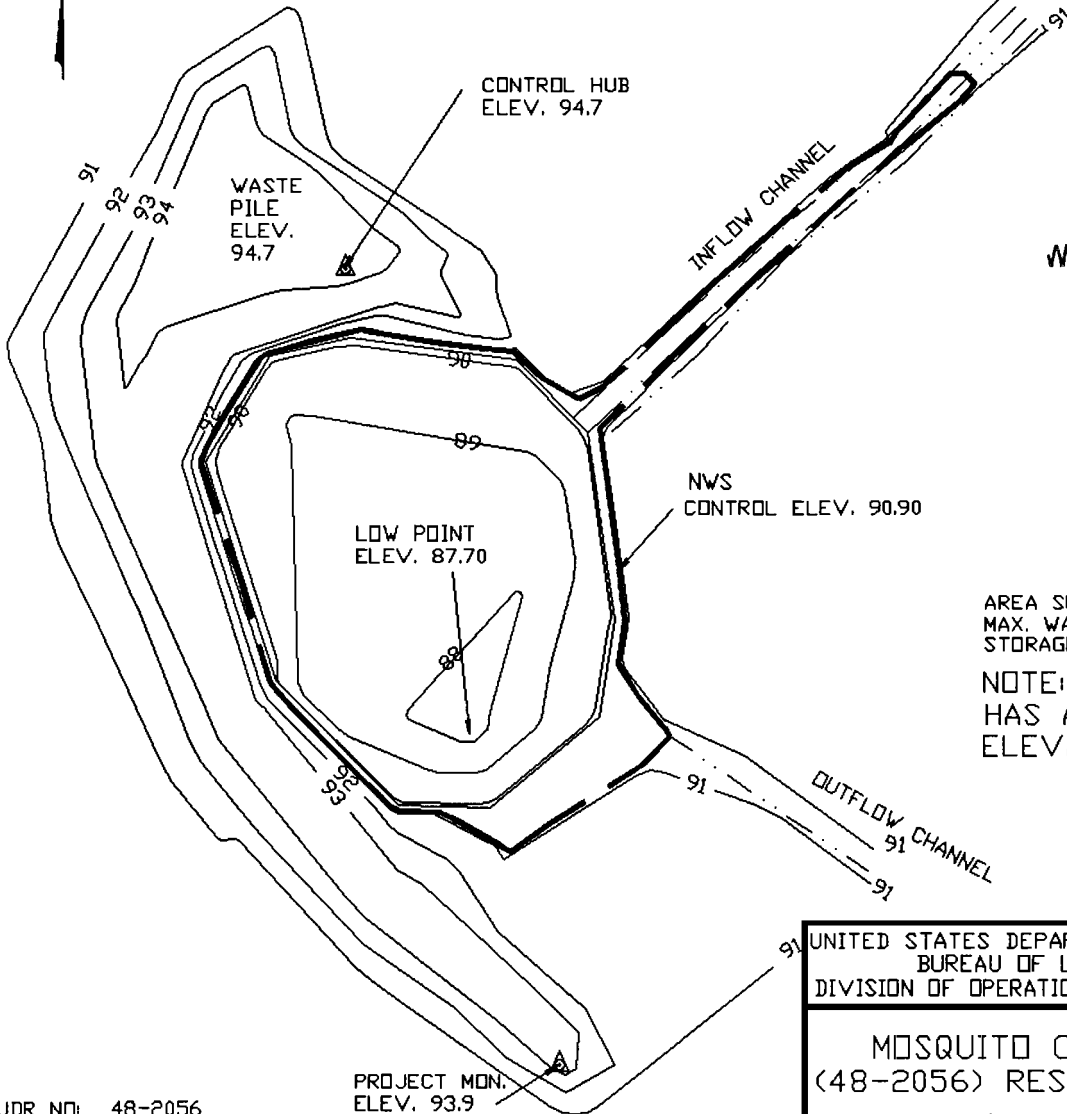

RECEIVED

OCT 04 1993

WATER RESOURCES DEPT.
SALEM, OREGON

AREA SUBMERGED 0.27 AC.
MAX. WATER DEPTH 3.2'
STORAGE CAPACITY 0.70 AC.FT.

NOTE: CONTROL HUB
HAS AN ASSUMED
ELEVATION OF 94.7

JDR NO: 48-2056
WATER RIGHTS
APP. NO:
PERMIT NO.
CERTIFICATE NO.

PROJECT MON.
ELEV. 93.9



ACAD 11/DCA
MOSQUITO3.DWG

FAILURE OF THIS STRUCTURE WOULD NOT
POSE A THREAT TO LIFE OR PROPERTY.

UNITED STATES DEPARTMENT OF THE INTERIOR
BUREAU OF LAND MANAGEMENT
DIVISION OF OPERATIONS VALE DISTRICT

MOSQUITO CREEK PIT #3
(48-2056) RESERVOIR AS BUILT

DESIGNED FIELD SURVEY 04/06/88 MARTIN & HYDE

REVIEWED *Vernon R. Pritchard*

APPROVED *George D. House*
CHIEF, BRANCH OF ENGINEERING

DRAWN: C.G. SCALE: 1"=50'

DATE: 11/27/92 SHEET 1 OF 1

DRAWING NO. DR-03-9172.45-139

CERTIFICATE NO.

03028

NO. R-73725